



Received Waste Permits Division: 12/13/2024  
Tracking No.: 30168338 (30564690)

Sustainability in Action

December 12, 2024

Mr. Gordon Shields  
MC 124  
Municipal Solid Waste Permits Section  
Texas Commission on Environmental Quality  
P.O. Box 13087  
Austin, Texas 78711-3087

Re: Response to Comments  
Permit Modification – Final Contour Plan Improvements  
McCarty Road Landfill – Permit No. MSW-261B  
Harris County, Texas  
Tracking No. 30168338

Dear Mr. Shields:

On behalf of McCarty Road Landfill TX, LP, please find attached one original and three copies of the replacement pages for the referenced permit modification. The attached replacement pages and comment responses below were developed to incorporate comments included in your email dated November 12, 2024. This response letter contains each comment identified by the TCEQ (in bold) and a response to each.

1. **Digital format mailing labels for adjacent property owner names and mailing addresses in Avery 5160 format are missing. Provide digital format mailing labels for adjacent property owner names and mailing addresses in Avery 5160 format (see bottom of page 11, TCEQ-00650-instr).**

**Response:**

Names and mailing addresses in Avery 5160 format have been provided in Attachment 3.

2. **Appendix B, table of SDP replacement pages, page B-1 lists Attachment 2 as including a table of contents but only a cover sheet is provided. Remove “and Table of Contents” and change “Pages were” to “Page was” in the explanation column.**

**Response:**

SDP Replacement Page was updated to exclude the Table of Contents.

3. **The cover page for Attachment 6 is missing several previous revision dates, namely October 2009, August 2010, December 2010, and October 2014. Revise the cover page to include these previous revision dates and confirm that the proposed revisions are being made based the most recent version, with all these previous revisions incorporated.**

**Response:**

The Attachment 6 cover page has been updated to incorporate the missing revision dates, and the most recent version of the document is being revised with this modification.

4. **The cover page for Attachment 6A is missing the title "DRAINAGE DESIGN REPORT." Add "DRAINAGE DESIGN REPORT" to the cover page.**

**Response:**

The cover page has been updated to include missing title and add a revision date of March 2024.

5. **Throughout the permit, show the previous version dates and revision numbers redlined in the footers along with the new entries that will be used in the clean copy. For example, page 6A-13 should show "1/23/2012" and "Rev. 1" in the footer, along with the new entries of "9/2024" and "Rev. 2" that will be used in the clean copy.**

**Response:**

Redlining the footers, as suggested, is not a consistent practice used in the development of permit modifications in the past. As of this resubmittal, the footers have not been redlined.

6. **Page 6A-17 appears to be missing. Please provide this page, or confirm that this page is not missing, renumber 6A-18 as 6A-17, and update the table of contents and entry in table at top of page B-2.**

**Response:**

Page 6A-18 has been renumbered to 6A-17.

7. **Attachment 6A, Figure 4.7 the curves for the higher flow appear to be mislabeled as Q25 PEAK (colored blue) whereas it should be Q100. Also, the new results of 60,138 and 41,756 cubic feet per second (cfs) are much higher than the Rev. 1, 08/2006 results of 37,768 and 31,186 cfs for Q100 and Q25, respectively. Thirdly, the new figure has a Rev. 1 date of 10/2010. Please make changes where necessary and address each of these instances in the narrative.**



**Response:**

The hydrograph has been relabeled as requested, and the revision dates have been updated. Peak flow rates in Greens Bayou significantly increase based on the latest hydrologic data and guidance provided by HCFCD. In most locations, the new 100-year peak flow rates are almost double the values in the permitted condition. This is due to significantly less-efficient detention and less hydrograph routing throughout the entire system.

- 8. Attachment 6A.2 has Rev. 1 as 10/2010 whereas the permit has Rev. 1 as 01/2012. Confirm Attachment 6A.2 can be replaced as submitted or state the revision dates need additional review, to be sure the revisions have been made using the most recent version.**

**Response:**

All of Attachment 6A revisions have been reviewed and updated accordingly, including Attachment 6A.2.

- 9. Page 6A-A-109 is incorrectly listed in table of SDP Replacement Pages on page B-2. Change 6A-A-109 to 6A-A-110 on the 15th row in the table on page B-2.**

**Response:**

SDP Replacement Page numbering was revised per the comment.

- 10. Pages 6A-B.2A-5 through 6A-B.2A-7 have no changes. Change "6A-B.2A-7" to "6A-B.2A-4" in table of SDP Replacement Pages on page B-2 in the 20th row.**

**Response:**

The same charts were used for apron calculations, however interpolation lines used have been updated. Results from previous and updated information are reported on page 6A-B.2A-4. No additional revisions were made. No revision was made to the SDP Replacement Pages.

- 11. Page 6A-B.2B1-3 hydrograph for discharge point DCP-1 has tenfold decrease in flow from 2012 (to 77 from 1101 cfs). Explain this difference.**

**Response:**

At DCP-1 the only flow in P116-00-00 is that from Basin P0001, which has a peak flow of 77 cfs. In previous submittals, the flow in P116-00-00 at DCP-1 was incorrectly selected as the flow at the junction "NDCP" which has a much higher flow rate. This mistake has been corrected.

- 12. Page 6A-B.2B1-4 table of hydraulic calculations is missing a title that it is for discharge point DCP-1. Add a title similar to the current version that clarifies this is “At the outfall of DCP-1”.**

**Response:**

The table in question provides hydraulic calculations for all of P116-00-00, not just at DCP-1. DCP-1 is located at station 36+55 and DCP-3 occurs at station 23+50. No revisions were made to this table.

- 13. Appendix 6A-B.2B1 does not have a new hydrograph and table of hydraulic calculations for discharge point BSD-2. Confirm there are no changes for BSD-2.**

**Response:**

The table on 6A-B.2B1 contains information for discharge point DCP-3. BSD-2 was converted to “DCP-3” as a part of a 2012 modification.

- 14. Page 6A-B.2B1-5 hydrograph as proposed has the same discharge point (DCP-3) and previous peak flow (1,103 cfs) that are listed on page 6A-B.2B1-7 in the permit. Change the page number to remain as 6A-B.2B1-7 (no red-line).**

**Response:**

Pages 6A-B.2B1-4 and 6 from the permit are being removed and replaced with the table on new 6A-B.2B1-4, causing 6A-B.2B1-7 to change to 6A-B.2B1-5. The removed pages have been redlined and included in this resubmittal, for clarity.

- 15. Appendix 6A-B.2B1 does not have a new table of hydraulic calculations to accompany the new hydrograph and new peak flow rate for DCP-3. Provide a new table of hydraulic calculations “At the outfall of DCP-3.”**

**Response:**

The conditions in P116-00-00 at DCP-3 are summarized on 6A-B.2B1-4. DCP-3 occurs at station 23+50.

- 16. Pages 6A-B.2B1-45 through 6A-B.2B1-82 are present in the current permit concerning P114-00-00 (South Ditch), whereas the pages provided for the proposed modification end at 6A-B.2B1-44. Provide clarification on whether pages 45 through 82 are intended to be removed from the permit or if these are still relevant to Appendix 6A-B.2B1 and should be retained with no changes.**

**Response:**

Pages 6A-B.2B1-45 through 6A-B.2B1-82 are not intended to be removed, as they are still relevant.

- 17. Reference to page “6A-B.2B2-3 through” in table of SDP Replacement Pages on page B-3, row 7, is a typographical error. Remove this entry.**

**Response:**

Page B-3 was revised as requested.

- 18. Pages 6A-C-21 through 6A-C-27 have redline changes that do not match the text in the current permit (revision date in 2004). Revise the revision date or clarify the proposed revisions have been made using the most recent and cumulative version.**

**Response:**

Redlined values for DA1/Chute 1 on 6A-C-21 and 6A-C-24 were updated to match permitted values. The example calculations on 6A-C-25 and 26 were also updated. All other redlined values match the permitted values.

- 19. Reference to Sheet 12-3 in table of SDP Replacement Pages, page B-5, is out of order. Move reference to Sheet 12-3 (page 3) to after “Figure 12.1” (page 2).**

**Response:**

The order of the revision for Sheet 12-3 is consistent with the existing permit.

- 20. Incorrect references to “Attachment 12A” in table of SDP Replacement Pages, page B-5, last three rows. Change “Attachment 12A” to “Appendix 12A” in table of SDP Replacement Pages and on the cover sheet in redline and replacement pages of the application.**

**Response:**

SDP Replacement Page summary was revised per the comment.

- 21. Cover sheet for Appendix 12A-A is missing. Provide cover sheet for Appendix 12A-A.**

**Response:**

Cover sheet has been included, as requested.

- 22. Pages 12A-A.1, 12A-A.2, 12A-A.5, and 12A-A.6 do not appear to have any changes from the corresponding pages in the permit revisions from 2004. Confirm these pages do not have any changes and remove them from the application and references in table of SDP Replacement Pages, page B-5.**

December 12, 2024

Page 6

**Response:**

SDP Replacement Page 12A-A.1, 12A-A.2, 12A-A.5, and 12A-A.6 have been removed. Values changed, however the changes made were within rounding error of the values shown.

If you have any questions or require further information, please call.

Sincerely,

**McCarty Road Landfill TX, LP**

*Raymond P. Whitlock*


Raymond Whitlock  
Environmental Manager

Attachments: Attachment 1 – Replacement Pages (Redline/Strikeout Version)  
Attachment 2 – Replacement Pages (Clean Version)  
Attachment 3 – TCEQ-20650 Form

cc: TCEQ Region 12 Office  
Scott Trebus, McCarty Road Landfill TX, LP  
Kyle D Gould, P.E., Weaver Consultants Group

**ATTACHMENT 1**

**REPLACEMENT PAGES**  
**(REDLINE/STRIKEOUT VERSION)**

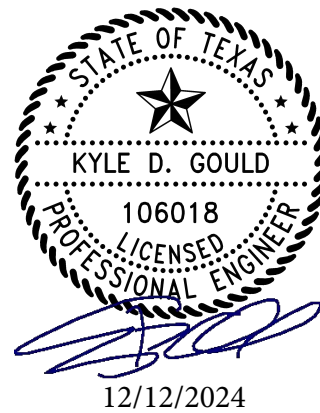

## INTRODUCTION

The following replacement pages have been developed to replace applicable sections of the permitted Site Development Plan. The following table summarizes the proposed replacement pages for the currently approved plans.

### Site Development Plan Replacement Pages

Replacement or Additional Page Number	Explanation
SDP – Part III Cover Page	Page provided for updated engineer seal and signature.
SDP – Part III, Page III-13	Updated text. Updated revision number.
Attachment 1 – Cover Sheet	Page provided for updated engineer seal and signature. Added revision dates.
Attachment 1, Attachment 1C – Typical Section A	Updated final cover contours.
Attachment 1, Attachment 1D – Sector Development Plan	Updated final cover contours.
Attachment 1, Attachment 1E – Sector Development Plan	Updated final cover contours.
Attachment 1, Attachment 1F – Sector Development Plan	Updated final cover contours.
Attachment 1, Attachment 1G – Sector Development Plan	Updated final cover contours.
Attachment 1, Attachment 1H – Sector Development Plan	Updated final cover contours.
Attachment 2 – Cover Sheet and Table of Contents	Pages were was provided for updated engineer seal and signature. Added revision dates.
Attachment 2, Attachment 2A – Typical Section Plan	Updated final cover contours. Added revision dates.
Attachment 2, Attachment 2B – Typical Fill Cross Sections	Updated final cover contours.
Attachment 2, Attachment 2C – Typical Fill Cross Sections	Updated final cover contours.
Attachment 2, Attachment 2D – Typical Fill Cross Sections	Updated final cover contours.
Attachment 2, Attachment 2E – Typical Fill Cross Sections	Updated final cover contours.
Attachment 2, Attachment 2F – Typical Fill Cross Sections	Updated final cover contours. Added revision date.
Attachment 2, Attachment 2G – Typical Fill Cross Sections	Updated final cover contours.
Attachment 6 – Cover Sheet and Table of Contents	Page provided for updated engineer seal and signature. Added revision dates.
Attachment 6, Attachment 6A – Cover Sheet and Table of Contents	Page provided for updated engineer seal and signature. Added revision dates and updated title.

## Site Development Plan Replacement Pages (Continued)

Replacement or Additional Page Number	Explanation
Attachment 6, Attachment 6A – Sheet 6A-13 through Sheet 6A-16 and Sheet 6A-18	Updated final contours, drainage areas, and discharge information. Updated revision number on all sheets. Revised page number 6A-18 to 6A-17.
Attachment 6, Attachment 6A – Figures 4.2, 4.3, 4.4, 4.5, 4.6, and 4.7	Updated hydrographs. Added and revised revision dates to all figures.
Attachment 6, Attachment 6A, Attachment 6A.1 – Drainage Structure Plan	Revised final contours. Revisions listed in the Title Block. Added revision dates.
Attachment 6, Attachment 6A, Attachment 6A.2 – Drainage Area Plan	Revised final contours and drainage areas. Revisions listed in the Title Block. Revised revision date.
Attachment 6, Attachment 6A, Attachment 6A.3 - Perimeter Drainage Plan	Revised channel outfall information. Revised revision date.
Attachment 6, Attachment 6A, Attachments 6A.4 through 6A.12	Revised channel information tables. Revised revision date on 6A-4 through 6A-6. Updated revision number on 6A-7 through 6A-12.
Attachment 6, Attachment 6A, Attachment 6A.14 – Drainage Details	Revised detail. Added revision date.
Attachment 6, Attachment 6A, Attachment 6A.17 – Energy Dissapator Details	Revised detail.
Attachment 6, Attachment 6A, Attachment 6A.17J – Letdown Details	Revised detail. Revised revision date
Attachment 6, Attachment 6A, Attachments 6A.20, 6A.21, 6A.22, 6A.24, and 6A.25	Revised storm stages. Updated revision number on 6A-21, 6A-22, 6A-24, and 6A-25.
Attachment 6, Attachment 6A, Attachments 6A.26, 6A.27, 6A.28, 6A.29, and 6A.30	Revised discharge information. Updated revision number on 6A.28, 6A.29, and 6A.30.
Attachment 6, Attachment 6A, Appendix 6A-A – Cover Sheet	Page provided for updated engineer seal and signature.
Attachment 6, Attachment 6A, Appendix 6A-A – Sheet 6A-A-2	Hypothetical storm data updated.
Attachment 6, Attachment 6A, Appendix 6A-A – Sheet 6A-A-12	Text on hypothetical storm data updated.
Attachment 6, Attachment 6A, Appendix 6A-A – Sheets 6A-A-13 through 6A-A-108 and 6A-A-109 <del>110</del> through 6A-A-125	HEC-HMS post development storm for 25-year and 100-year event reproduced.
Attachment 6, Attachment 6A, Appendix 6A-B – Cover Sheet	Page provided for updated engineer seal and signature.
Attachment 6, Attachment 6A, Appendix 6A-B, Appendix 6A-B.1 – Sheet 6A-B.1-1	Updated content reference.
Attachment 6, Attachment 6A, Appendix 6A-B, Appendix 6A-B.1 – Sheet 6A-B.1-2, 6A-B.1-3, 6A-B.1-4, 6A-B.1-5, 6A-B.1-6, 6A-B.1-7, 6A-B.1-8, 6A-B.1-9, and 6A-B.1-10	Revised channel calculations based on revisions to final contours. Updated revision number on , 6A-B.1-4, and 6A-B.1-5.
Attachment 6, Attachment 6A, Appendix 6A-B, Appendix 6A-B.2 – Sheets 6A-B.2-2 and 6A-B.2-3	Revised tailwater depth summary table.
Attachment 6, Attachment 6A, Appendix 6A-B, Appendix 6A-B.2A – Sheets 6A-B.2A-2 through 6A-B.2A-7	Revised detention pond design.
Attachment 6, Attachment 6A, Appendix 6A-B, Appendix 6A-B.2B1 – Sheets 6A-B.2B1-3 through 6A-B.2B1-5 <del>6</del>	Revised tailwater depth determination. Sheets 6A-B.2B1-4 and 6A-B.2B1-6 are included to indicate removal from permit.
Attachment 6, Attachment 6A, Appendix 6A-B, Appendix 6A-B.2B1 – Sheet 6A-B.2B1-10A	Updated South Ditch flow elevations.

## Site Development Plan Replacement Pages (Continued)

Replacement or Additional Page Number	Explanation
Attachment 6, Attachment 6A, Appendix 6A-B, Appendix 6A-B.2B1 – Sheets 6A-B.2B1-11 through 6A-B.2B1-26 and 6A-B.2B1-26A through 6A-B.2B1- 26O	Included HEC-RAS report for South Ditch.
Attachment 6, Attachment 6A, Appendix 6A-B, Appendix 6A-B.2B1 – Sheet 6A-B.2B1-28	Updated Greens Bayou flow elevations.
Attachment 6, Attachment 6A, Appendix 6A-B, Appendix 6A-B.2B1 – Sheets 6A-B.2B1-29 through 6A-B.2B1-36, 6A-B.2B1-37A, and 6A-B.2B1-37B	Included HEC-RAS report for Greens Bayou.
Attachment 6, Attachment 6A, Appendix 6A-B, Appendix 6A-B.2B1 – Sheet 6A-B.2B1-39	Updated hydraulic calculations for P116-00-00.
Attachment 6, Attachment 6A, Appendix 6A-B, Appendix 6A-B.2B1 – Sheets 6A-B.2B1-41, 6A- B.2B1-42, 6A-B.2B1-42A, 6A-B.2B1-43, and 6A- B.2B1-44	Revised tailwater and normal depth determination.
Attachment 6, Attachment 6A, Appendix 6A-B, Appendix 6A-B.2B2 – Sheets 6A-B.2B2-3 through 6A-B.2B2-10 and 6A-B.2B2-13 through 6A-B.2B2-20	Revised outlet structure design.
Attachment 6, Attachment 6A, Appendix 6A-B, Appendix 6A-B.2B2 – Sheets <del>6A-B.2B2-3 through</del> 6A-B.2B2-47 through 6A-B.2B2-82 and 6A-B.2B2- 82A	Included HEC-RAS report for P114-00-00.
Attachment 6, Attachment 6A, Appendix 6A-C – Cover Sheet	Page provided for updated engineer seal and signature.
Attachment 6, Attachment 6A, Appendix 6A-C – Sheet 6A-C-1	Revised text for swales.
Attachment 6, Attachment 6A, Appendix 6A-C – Sheet 6A-C-2 - Swale Drainage Areas	Revised swale drainage areas.
Attachment 6, Attachment 6A, Appendix 6A-C – Sheets 6A-C-3 through 6A-C-12	Revised swale analysis for final cover modification and updated precipitation information.
Attachment 6, Attachment 6A, Appendix 6A-C – Sheets 6A-C-14 through 6A-C-16	Revised chute analysis for final cover modification and updated precipitation information.
Attachment 6, Attachment 6A, Appendix 6A-C – Sheet 6A-C-17 - Chute Drainage Areas	Revised chute drainage areas.
Attachment 6, Attachment 6A, Appendix 6A-C – Sheet 6A-C-18	Revised chute peak flows.
Attachment 6, Attachment 6A, Appendix 6A-C – Sheet 6A-C-21 through 6A-C-27 and 6A-C-30 through 6A-C-32	Updated chute design. Sheets 6A-C-21, 6A-C-24, 6A-C-25, and 6A-C-26 current permit information revised.
Attachment 6, Attachment 6A, Appendix 6A-C-A – Cover Sheet	Page provided for updated engineer seal and signature.
Attachment 6, Attachment 6A, Appendix 6A-C-A – Sheets 6A-C-A-2 through 6A-C-A-5	Updated FML letdown design.
Attachment 6, Attachment 6A, Appendix 6A-C-A – Sheets 6A-C-A-8 through 6A-C-A-10	Updated FML letdown design.
Attachment 6, Attachment 6A, Appendix 6A-C-A – Sheets 6A-C-A-13 through 6A-C-A-16	Updated FML letdown design.
Attachment 6, Attachment 6A, Appendix 6A-C-A – Sheet 6A-C-A-19	Updated FML letdown design.
Attachment 6, Attachment 6A, Appendix 6A-C-B – Cover Sheet	Page provided for updated engineer seal and signature.



## Site Development Plan Replacement Pages (Continued)

Replacement or Additional Page Number	Explanation
Attachment 6, Attachment 6A, Appendix 6A-C-B – Sheets 6A-C-B-2 through 6A-C-B-5	Updated Flexamat letdown design.
Attachment 6, Attachment 6A, Appendix 6A-C-B – Sheets 6A-C-B-8 through 6A-C-B-10	Updated Flexamat letdown design.
Attachment 6, Attachment 6A, Appendix 6A-D – Cover Sheet	Page provided for updated engineer seal and signature.
Attachment 6, Attachment 6A, Appendix 6A-D – Sheets 6A-D-3 through 6A-D-5	Re-evaluated erosion layer.
Attachment 6, Attachment 6A, Appendix 6A-D – Sheet 6A-D-5a - Erosion Layer Analysis Section Locations	Revised final contours and swale locations. Revisions listed in the Title Block.
Attachment 6, Attachment 6A, Appendix 6A-D – Sheets 6A-D-14, 6A-D-15, 6A-D-18 through 6A-D-24	Re-evaluated erosion layer and updated precipitation data.
Attachment 6, Attachment 6A, Appendix 6A-E – Cover Sheet and Table of Contents	Page provided for updated engineer seal and signature.
Attachment 6, Attachment 6A, Appendix 6A-E – Sheet 6A-E-2	Hypothetical storm data updated.
Attachment 6, Attachment 6A, Appendix 6A-E – Figure 6A-E-12a - Permitted Drainage Areas	Updated figure to latest permitted condition. Revisions listed in the Title Block.
Attachment 6, Attachment 6A, Appendix 6A-E – Sheet 6A-E-16 through 6A-E-86	Replaced previous permit HEC-1 report with latest permit HEC-HMS report.
Attachment 6, Attachment 6A, Appendix 6A-G – Cover Sheet	Page provided for updated engineer seal and signature.
Attachment 6, Attachment 6A, Appendix 6A-G – Figure 2 - Swale Design Summary	Updated temporary add-on swale summary. <b>Added revision date.</b>
Attachment 6, Attachment 6A, Appendix 6A-G – Figure 3 - Letdown Design Summary	Revised letdown calculations. <b>Added revision dates.</b>
Attachment 6, Attachment 6A, Appendix 6A-G – Figure 4 - Sediment Control Pond Plan	Revised pond calculations. <b>Added revision dates.</b>
Attachment 6, Attachment 6A, Appendix 6A-G, Appendix 6A-G-1 – Cover Sheet	Page provided for updated engineer seal and signature.
Attachment 6, Attachment 6A, Appendix 6A-G, Appendix 6A-G-1 – Sheets 6A-G-1-2 through 6A-G-1- 7 and 6A-G-1-10 through 6A-G-1-12	Updated temporary add-on swale design and precipitation data.
Attachment 6, Attachment 6A, Appendix 6A-G, Appendix 6A-G-2 – Cover Sheet	Page provided for updated engineer seal and signature.
Attachment 6, Attachment 6A, Appendix 6A-G, Appendix 6A-G-2 – Sheets 6A-G-2-2 through 6A-G-2- 5, 6A-G-2-5A, and 6A-G-2-18	Updated temporary letdown design and precipitation data.
Attachment 6, Attachment 6A, Appendix 6A-G, Appendix 6A-G-3 – Cover Sheet	Page provided for updated engineer seal and signature.
Attachment 6, Attachment 6A, Appendix 6A-G, Appendix 6A-G-3 – Sheets 6A-G-3-2 through 6A-G-3- 6	Updated temporary sediment control pond design and precipitation data.
Attachment 6, Attachment 6D – Cover Sheet	Page provided for updated engineer seal and signature.
Attachment 6, Attachment 6D – Attachment 6D.1C – GCL Completion Plan	Updated final cover contours.
Attachment 6, Attachment 6D – Attachment 6D.2 – Final Cover Details Subtitle D Area	Updated detail references.

## Site Development Plan Replacement Pages (Continued)

Replacement or Additional Page Number	Explanation
Attachment 6, Attachment 6D – Attachment 6D.3 – Final Cover Details Pre-Subtitle D Area	Updated detail references.
Attachment 6, Attachment 6D – Attachment 6D.4 – Final Cover Tie-In Details	Updated detail references.
Attachment 6, Attachment 6D – Attachment 6D.4A – Alternative Final Cover Details Subtitle D Area	Updated detail references.
Attachment 6, Attachment 6D – Attachment 6D.4B – Alternative Final Cover Details Pre-Subtitle D Area	Updated detail references.
Attachment 6, Attachment 6D – Attachment 6D.4C – Alternative Final Cover Tie-In Details	Updated detail references.
Attachment 6, Attachment 6D – Attachment 6D.4D – Alternative Final Cover Transition	Updated detail references.
Attachment 7 – Cover Sheet	Page provided for updated engineer seal and signature.
Attachment 7, Attachment 7A – Landfill Completion Plan	Updated for final cover contours. Added revision dates.
Attachment 7, Attachment 7B – Post development Drainage Plan	Updated for final cover contours. Updated hydrographs.
Attachment 12 – Cover Sheet	Page provided for updated engineer seal and signature.
Attachment 12 – Figure 12.1	Updated final cover contours.
Attachment 12 – Figure 12.1A	Updated expedited final cover area.
Attachment 12 – Figure 12.2	Updated final cover contours.
Attachment 12 – Sheet 12-3	Updated text.
Attachment 12, Attachment Appendix 12A – Cover Sheet	Page provided for updated engineer seal and signature. Updated title.
Attachment 12, Appendix 12A, Appendix 12A-A – Cover Sheet	Page provided for updated engineer seal and signature.
Attachment 12, Appendix 12A Attachment Appendix 12A-A – Sheets 12A-A.43 through and 12A-A.64	Updated calculations. Removed No Change sheets from this permit mod.
Attachment 12, Appendix 12A Attachment Appendix 12A-A – Sheet 12A-A-7 – Drainage Pipe Layout	Updated final cover contours.

**McCARTY ROAD LANDFILL  
CITY OF HOUSTON, HARRIS COUNTY, TEXAS  
TCEQ PERMIT NO. MSW-261B**

**PART III – SITE DEVELOPMENT PLAN  
SITE DEVELOPMENT PLAN NARRATIVE**

Prepared for

McCarty Road Landfill TX, LP

Approved Site Development Plan August 2008

Revised June 2009

Revised October 2009

Revised February 2010


Revised December 2010

Revised January 2012

Revised October 2014

Revised March 2024

Revised December 2024

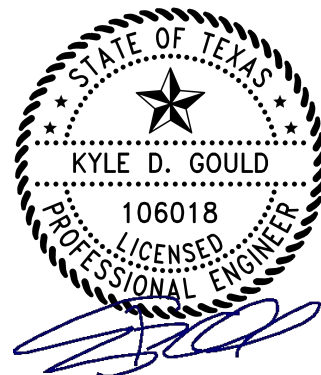

12/12/2024

Prepared by

**Weaver Consultants Group, LLC**  
TBPE Registration No. F-3727  
6420 Southwest Boulevard, Suite 206  
Fort Worth, Texas 76109  
817-735-9770

WCG Project No. 0120-439-11-259

south of the site). The floodplain elevation in Greens Bayou ranges from approximately 30.5 ft-msl near US Highway 90 to 32 ft-msl near the northeast corner of the site. Over 4 feet of freeboard exists between the 100-year flood elevation in Greens Bayou and the limits of waste. As discussed in Attachment 6A, the proposed vertical expansion does not impact stormwater flow in Greens Bayou.

The entire waste fill footprint is located outside the 100-year floodplain as defined on the FIRM. The 100-year water surface profile for P116-00-00 and P114-00-00 are also presented in Attachment 6C. As shown in Attachment 6C, the 100-year storm event is contained within the channel banks of these two HCFCD channels.

Refer to Attachment 6C – Floodplain Information for additional information.

The Subtitle D Location Restriction Certification of Compliance for floodplains is included in Parts I/II, Appendix I/IIB.

### **3.8 Cover System Design**

The final cover system will consist of a soil only (pre-Subtitle D areas) and composite (Subtitle D areas) cover system, as well as a GCL alternative final cover for both pre-Subtitle D and Subtitle D areas. The GCL alternative final cover includes replacing the compacted clay infiltration layer with a GCL. As discussed in Attachment 6D, the site will either select the compacted clay infiltration layer option or the GCL infiltration layer option for the remaining footprint that has not received final cover (i.e., only one of the final cover options will be used for the remaining footprint unless a subsequent permit modification is submitted). The final cover system will provide a low maintenance cover, protect against erosion, reduce rainfall percolation through the cover system, and subsequently minimize leachate generation within the landfill. As depicted on Attachment 7A – Landfill Completion Plan, a maximum of 5 3.5 percent top slopes and 4H:1V sideslopes are provided to minimize erosion and facilitate drainage of the landfill. A composite final cover system will be constructed over the Subtitle D waste disposal areas. Components of the multi-layer final cover system for both pre-Subtitle D and Subtitle D areas include (from top to bottom):

#### Subtitle D Area

- An erosion layer consisting of a 24-inch-thick layer of earthen material (top 6 inches capable of sustaining plant growth). The vegetation layer will consist of native or introduced grasses capable of providing 90 percent coverage over the cover system.
- A drainage geocomposite will be used as the drainage layer.
- A 40-mil, smooth (topslope) and textured (sideslope), linear low-density polyethylene (LLDPE), geomembrane liner or other equivalent geomembrane liner material may be used.

An 18-inch-thick compacted clay infiltration layer with a coefficient of permeability of less than or equal to  $1 \times 10^{-5}$  cm/sec or a geosynthetic clay layer (GCL) with a coefficient of permeability of less than or equal to  $3 \times 10^{-9}$  cm/s. Unreinforced GCL will be used on the topslopes and reinforced GCL will be used on the sideslopes.

**McCARTY ROAD LANDFILL  
CITY OF HOUSTON, HARRIS COUNTY, TEXAS  
TCEQ PERMIT NO. MSW-261B**

**PART III - SITE DEVELOPMENT PLAN  
ATTACHMENT 1  
SITE LAYOUT PLANS**

Prepared for

McCarty Road Landfill TX, LP

Approved Site Development Plan  
August 2008

Revised June 2009

Revised October 2009


Revised December 2010

Revised January 2011

Revised January 2012

Revised October 2014

Revised December 2024

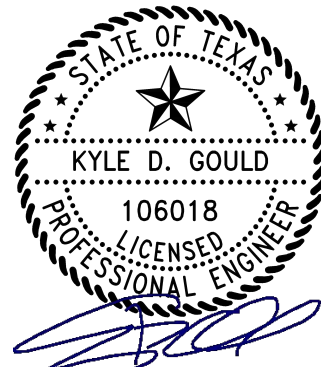

12/12/2024

**Weaver Consultants Group, LLC**  
TBPE Registration No. F-3727  
6420 Southwest Boulevard, Suite 206  
Fort Worth, Texas 76109  
817-735-9770

WCG Project No.0120-439-11-259

**McCARTY ROAD LANDFILL  
CITY OF HOUSTON, HARRIS COUNTY, TEXAS  
TCEQ PERMIT NO. MSW-261B**

**PART III - SITE DEVELOPMENT PLAN  
ATTACHMENT 2  
FILL CROSS SECTIONS**

Prepared for

McCarty Road Landfill TX, LP

Approved Site Development Plan  
August 2008

Revised October 2009


Revised December 2010

Revised January 2011

Revised January 2012

Revised October 2014

Revised December 2024


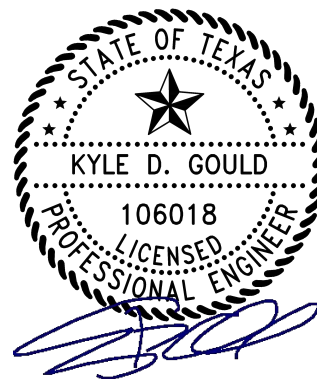


12/12/2024

**Weaver Consultants Group, LLC**  
TBPE Registration No. F-3727  
6420 Southwest Boulevard, Suite 206  
Fort Worth, Texas 76109  
817-735-9770

WCG Project No.0120-439-11-259



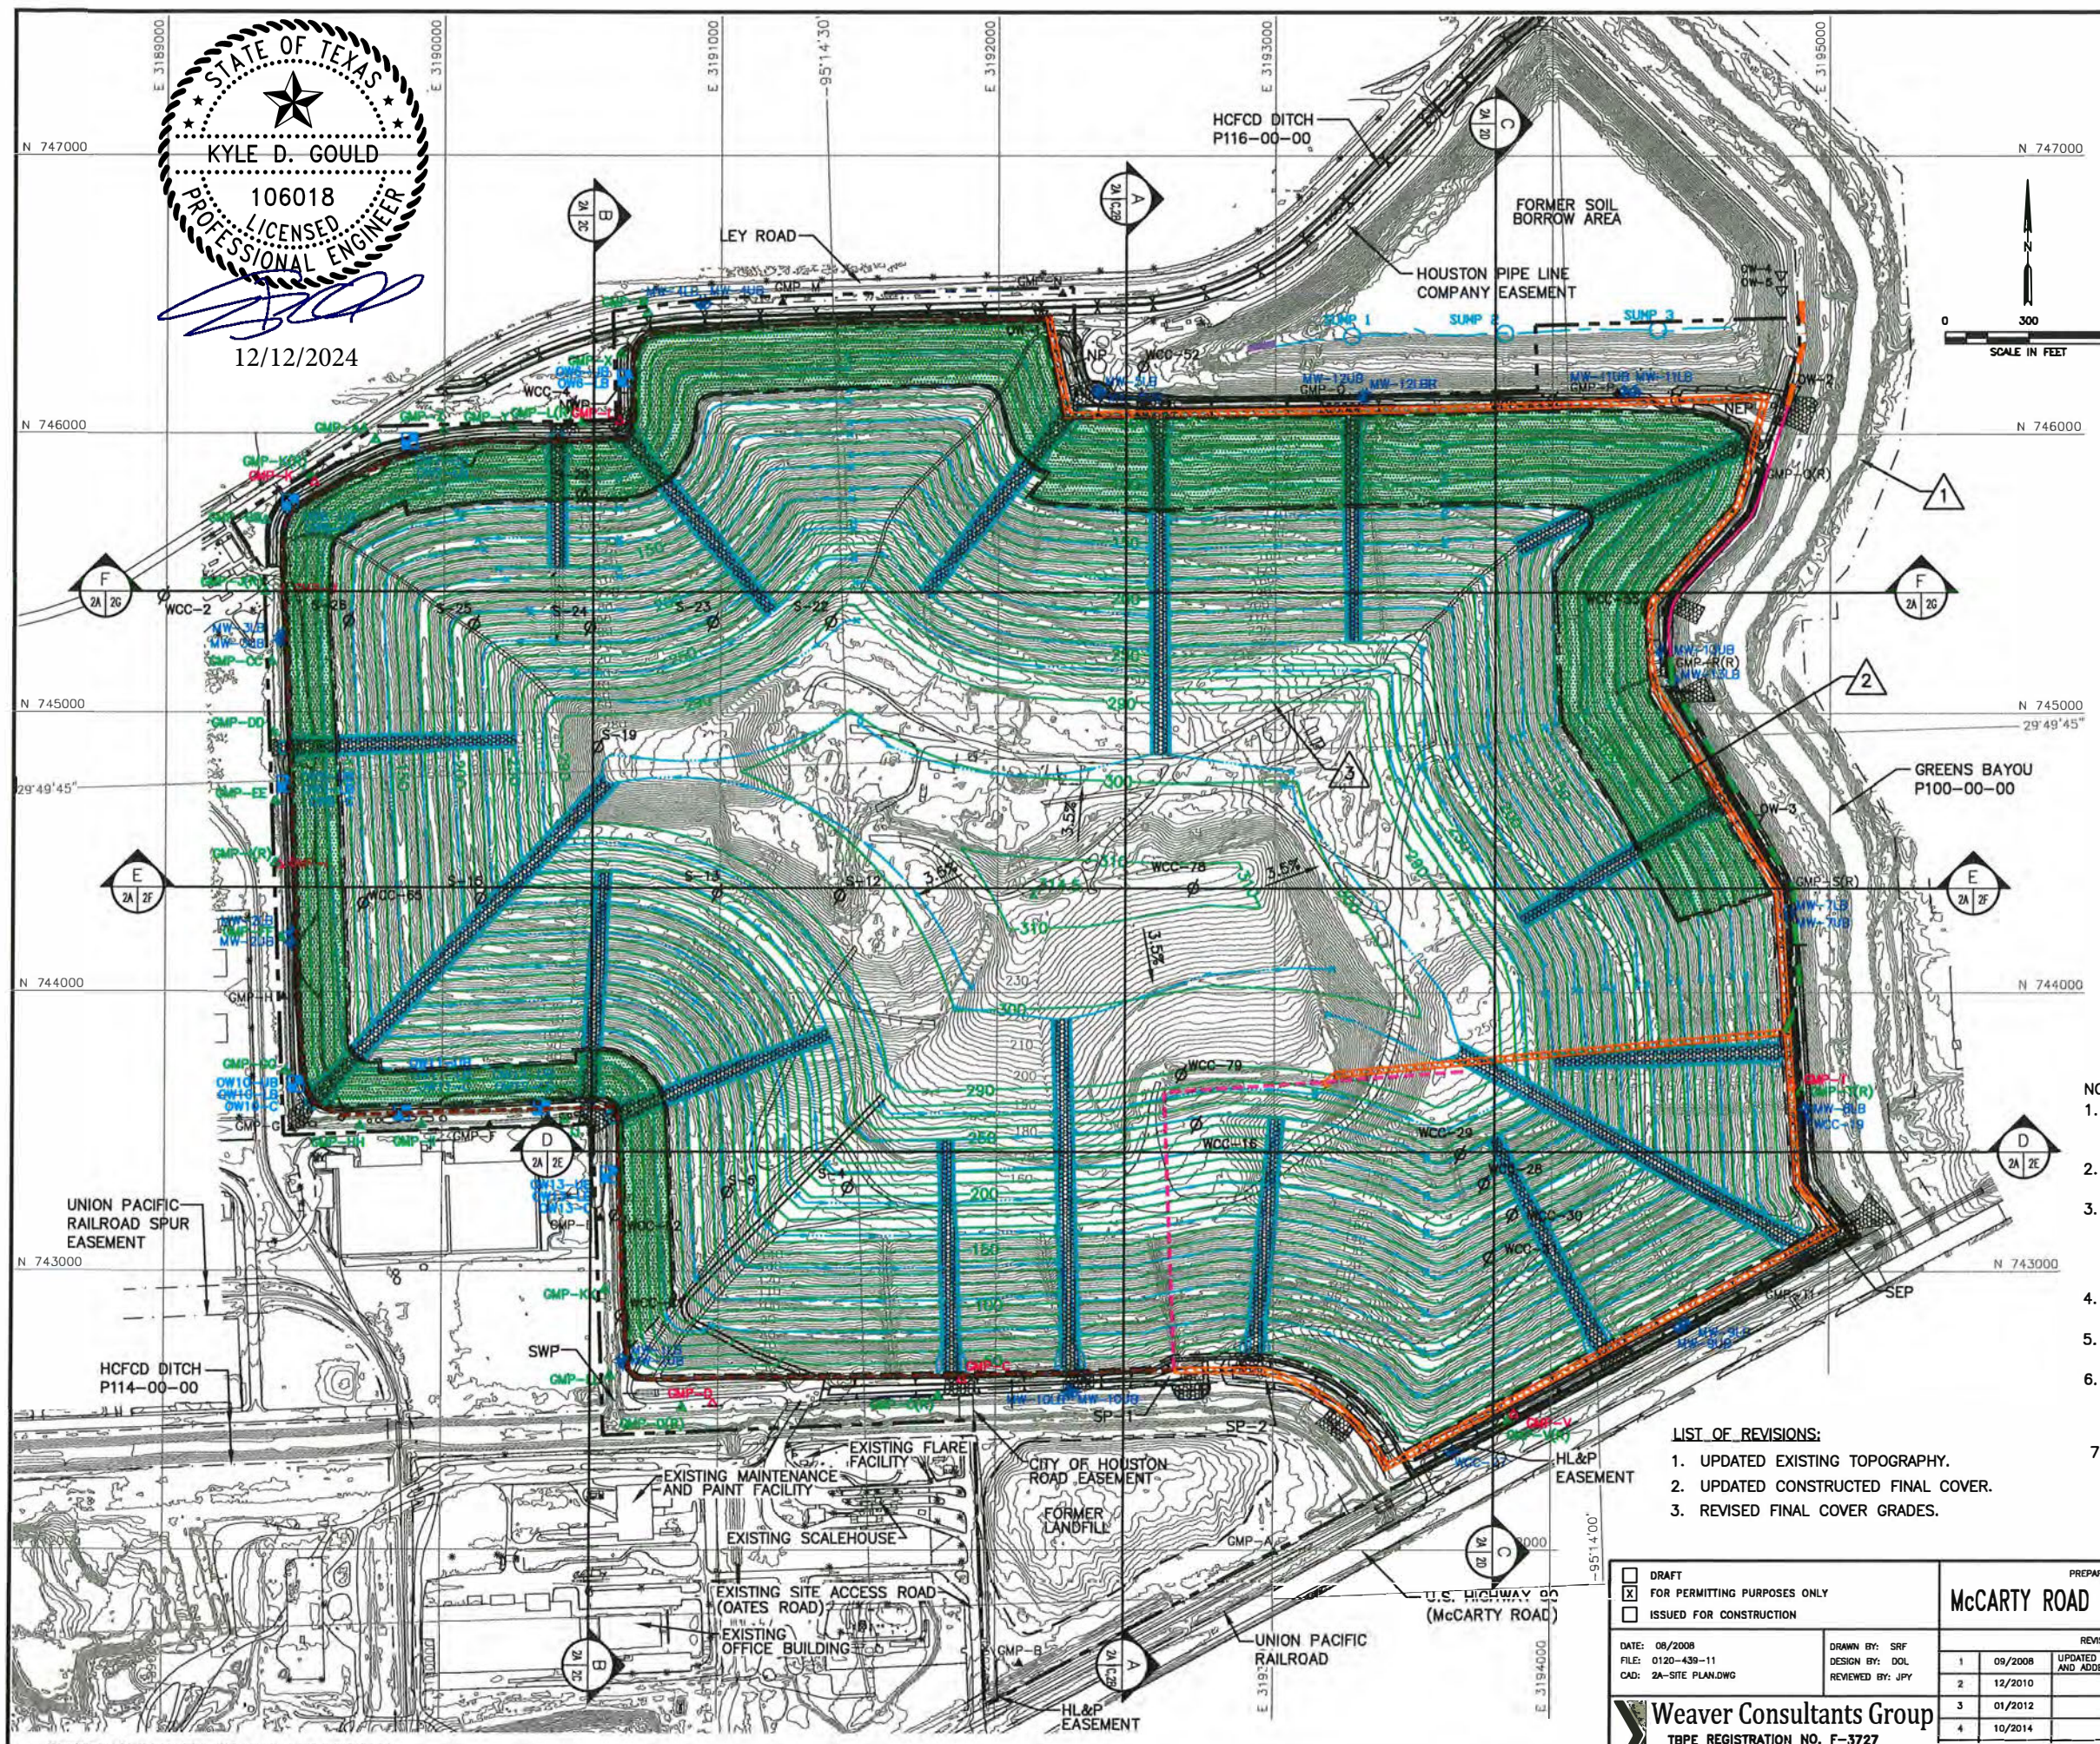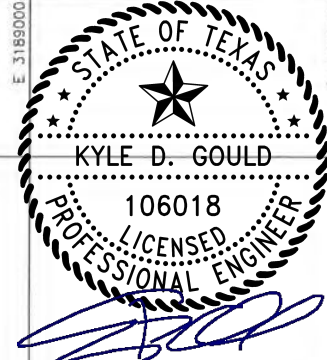


**LEGEND**

- PERMIT BOUNDARY
- LIMITS OF WASTE
- DEED RESTRICTION BOUNDARY (SEE NOTE 5)
- N 746000
- 29°49'45"
- EXISTING CONTOUR
- 200
- FINAL CONTOURS
- COMPACTED CLAY SLOPE LINER
- CLAY CUTOFF WALL
- SLURRY WALL
- DEEP SLURRY WALL
- NORTHERN EAST SLURRY WALL EXTENSION (REFER TO ATT. 6D)
- EAST SLURRY WALL EXTENSION (REFER TO ATT. 6D)
- SLURRY WALL EXTENSION OF GWRT (REFER TO ATT. 6D)
- EXISTING DETECTION GROUNDWATER MONITORING WELL
- PROPOSED OBSERVATION WELL CLUSTERS (SEE NOTE 7)
- EXISTING OBSERVATION WELL (SEE NOTE 7)
- EXISTING LANDFILL GAS MONITORING PROBE
- EXISTING LANDFILL GAS MONITORING PROBE TO BE DECOMMISSIONED
- PROPOSED LANDFILL GAS MONITORING PROBE (SEE NOTE 6)
- EASEMENT BOUNDARY
- S-5
- WCC-51
- GABIONS
- PROPOSED DRAINAGE SWALE
- PROPOSED DRAINAGE LETDOWN
- GROUND WATER RECOVERY TRENCH
- GROUND WATER RECOVERY TRENCH SUMP
- CONSTRUCTED FINAL COVER
- INDICATES REVISION (SEE LIST OF REVISIONS)

- NOTES:**
- TOPOGRAPHIC MAPPING PREPARED BY FIRMATEK FROM AERIAL PHOTOGRAPHY FLOWN 11-17-2023. THE GRID SYSTEM IS TIED TO THE TEXAS STATE PLANE COORDINATE SYSTEM SOUTH CENTRAL ZONE NAD 1927.
  - PERMIT BOUNDARY AND EASEMENTS WERE REPRODUCED FROM COSTELLO, INC. STANDARD LAND SURVEY DRAWING, DATED MARCH 2004.
  - BORING LOCATIONS HAVE BEEN REPRODUCED FROM VARIOUS SUBSURFACE INVESTIGATIONS PREVIOUSLY COMPLETED AND ARE APPROXIMATE. ONLY BORINGS SHOWN ON SECTIONS ARE PRESENTED ON THIS DRAWING. PLEASE REFER TO ATTACHMENT 4, FIGURE 4B.2 FOR A FIGURE THAT SHOWS ALL THE BORINGS COMPLETED AT THE SITE.
  - REFER TO ATTACHMENT 1H FOR THE FINAL CONTOUR PLAN AND 1I FOR THE BOTTOM OF WASTE PLAN.
  - REFER TO ATTACHMENT 6, APPENDIX 6A-F FOR DEED RESTRICTION INFORMATION.
  - PROPOSED PROBES DESIGNATED WITH "(R)" ARE REPLACEMENT PROBES. PROPOSED PROBES GMP-W THROUGH GMP-LL WERE ADDED ALONG THE WESTERN PERIMETER OF THE LANDFILL AS PART OF THE AAWWE SETTLEMENT AGREEMENT.
  - GROUNDWATER OBSERVATION WELLS OW-1, OW-2, OW-3, OW-4 AND OW-5 WERE ADDED ALONG THE NORTHERN AND EASTERN PERIMETER OF THE LANDFILL AS PART OF THE HARRIS COUNTY SETTLEMENT AGREEMENT. ADDITIONAL PROPOSED OBSERVATION WELLS WERE ADDED ALONG THE WESTERN PERIMETER OF THE LANDFILL AS PART OF THE AAWWE SETTLEMENT AGREEMENT.


- LIST OF REVISIONS:**
- UPDATED EXISTING TOPOGRAPHY.
  - UPDATED CONSTRUCTED FINAL COVER.
  - REVISED FINAL COVER GRADES.

<input type="checkbox"/> DRAFT <input checked="" type="checkbox"/> FOR PERMITTING PURPOSES ONLY <input type="checkbox"/> ISSUED FOR CONSTRUCTION		PREPARED FOR <b>McCARTY ROAD LANDFILL TX, LP</b>		<b>TYPICAL SECTION SITE PLAN</b>		
DATE: 08/2008 FILE: 0120-439-11 CAD: 2A-SITE PLAN.DWG		DRAWN BY: SRF DESIGN BY: DOL REVIEWED BY: JPY				
 <b>Weaver Consultants Group</b> TBPE REGISTRATION NO. F-3727		REVISIONS		<b>McCARTY ROAD LANDFILL HARRIS COUNTY, TEXAS</b>		
		1	09/2008			UPDATED LANDFILL GAS MONITORING PROBES AND ADDED EAST SLURRY WALL.
		2	12/2010			PERMIT MODIFICATION
		3	01/2012			PERMIT MODIFICATION
		4	10/2014			PERMIT MODIFICATION
		5	12/2024	SEE LIST OF REVISIONS	<b>WWW.WCGRP.COM</b>	<b>ATTACHMENT 2A</b>

O:\0120\439\FLIP MOD 2024\ATT 2A-TYPICAL SECTION SITE PLAN.dwg, rarrington, 1:2




C:\0120\439\PLP MOD 2024\ATT 2F-SEC-E.dwg, rarrington, 1:2

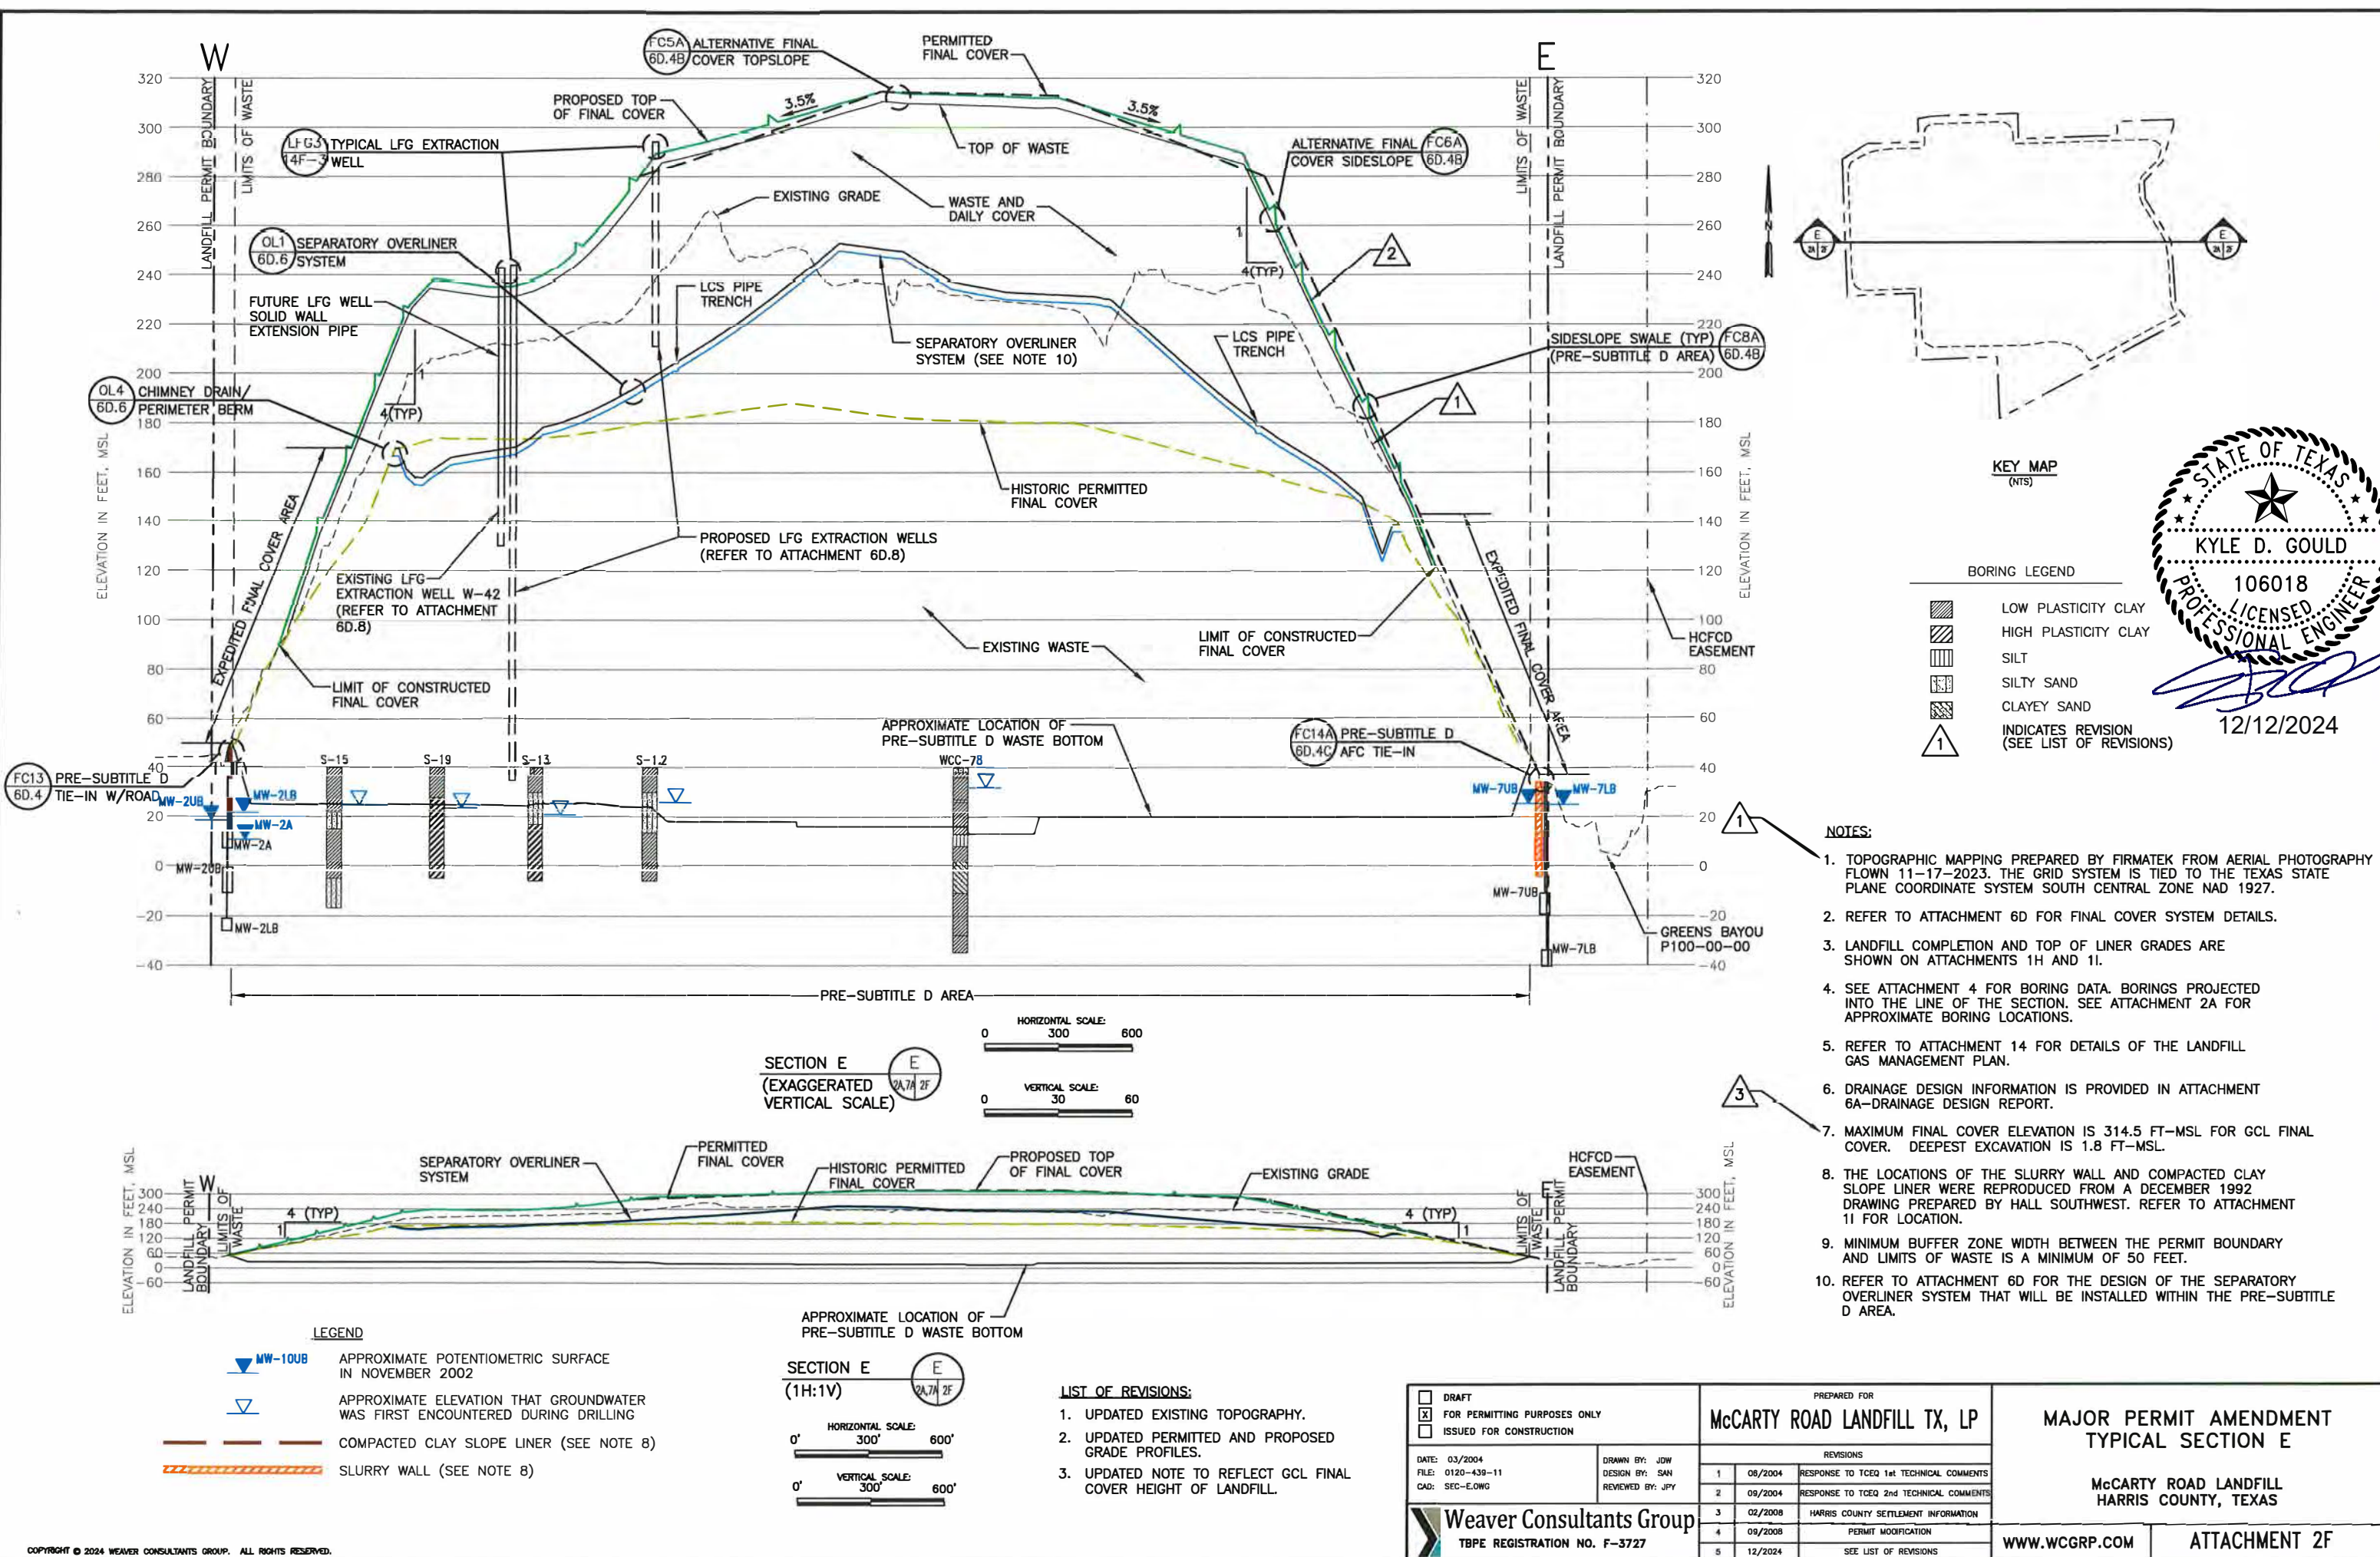

STATE OF TEXAS  
KYLE D. GOULD  
106018  
LICENSED PROFESSIONAL ENGINEER  
12/12/2024

- NOTES:**
1. TOPOGRAPHIC MAPPING PREPARED BY FIRMA TEK FROM AERIAL PHOTOGRAPHY FLOWN 11-17-2023. THE GRID SYSTEM IS TIED TO THE TEXAS STATE PLANE COORDINATE SYSTEM SOUTH CENTRAL ZONE NAD 1927.
  2. REFER TO ATTACHMENT 6D FOR FINAL COVER SYSTEM DETAILS.
  3. LANDFILL COMPLETION AND TOP OF LINER GRADES ARE SHOWN ON ATTACHMENTS 1H AND 1I.
  4. SEE ATTACHMENT 4 FOR BORING DATA. BORINGS PROJECTED INTO THE LINE OF THE SECTION. SEE ATTACHMENT 2A FOR APPROXIMATE BORING LOCATIONS.
  5. REFER TO ATTACHMENT 14 FOR DETAILS OF THE LANDFILL GAS MANAGEMENT PLAN.
  6. DRAINAGE DESIGN INFORMATION IS PROVIDED IN ATTACHMENT 6A-DRAINAGE DESIGN REPORT.
  7. MAXIMUM FINAL COVER ELEVATION IS 314.5 FT-MSL FOR GCL FINAL COVER. DEEPEST EXCAVATION IS 1.8 FT-MSL.
  8. THE LOCATIONS OF THE SLURRY WALL AND COMPACTED CLAY SLOPE LINER WERE REPRODUCED FROM A DECEMBER 1992 DRAWING PREPARED BY HALL SOUTHWEST. REFER TO ATTACHMENT 1I FOR LOCATION.
  9. MINIMUM BUFFER ZONE WIDTH BETWEEN THE PERMIT BOUNDARY AND LIMITS OF WASTE IS A MINIMUM OF 50 FEET.
  10. REFER TO ATTACHMENT 6D FOR THE DESIGN OF THE SEPARATORY OVERLINER SYSTEM THAT WILL BE INSTALLED WITHIN THE PRE-SUBTITLE D AREA.

- LIST OF REVISIONS:**
1. UPDATED EXISTING TOPOGRAPHY.
  2. UPDATED PERMITTED AND PROPOSED GRADE PROFILES.
  3. UPDATED NOTE TO REFLECT GCL FINAL COVER HEIGHT OF LANDFILL.

<input type="checkbox"/> DRAFT <input checked="" type="checkbox"/> FOR PERMITTING PURPOSES ONLY <input type="checkbox"/> ISSUED FOR CONSTRUCTION		PREPARED FOR <b>McCARTY ROAD LANDFILL TX, LP</b>		<b>MAJOR PERMIT AMENDMENT TYPICAL SECTION E</b>		
DATE: 03/2004 FILE: 0120-439-11 CAD: SEC-E.OWG		DRAWN BY: JOW DESIGN BY: SAN REVIEWED BY: JPY				
 <b>Weaver Consultants Group</b> TBP REGISTRATION NO. F-3727		REVISIONS		<b>McCARTY ROAD LANDFILL HARRIS COUNTY, TEXAS</b>		
		1	08/2004			RESPONSE TO TCEQ 1st TECHNICAL COMMENTS
		2	09/2004			RESPONSE TO TCEQ 2nd TECHNICAL COMMENTS
		3	02/2008			HARRIS COUNTY SETTLEMENT INFORMATION
		4	09/2008			PERMIT MODIFICATION
		5	12/2024	SEE LIST OF REVISIONS	<b>WWW.WCGRP.COM</b>	<b>ATTACHMENT 2F</b>



**McCARTY ROAD LANDFILL  
CITY OF HOUSTON, HARRIS COUNTY, TEXAS  
TCEQ PERMIT NO. MSW-261B**

**PART III – SITE DEVELOPMENT PLAN  
ATTACHMENT 6  
GROUNDWATER AND SURFACE WATER  
PROTECTION PLAN**

Prepared for

McCarty Road Landfill TX, LP

Approved Site Development Plan

August 2008

Revised October 2009


Revised August 2010

Revised December 2010

Revised January 2011

Revised October 2014

Revised December 2024

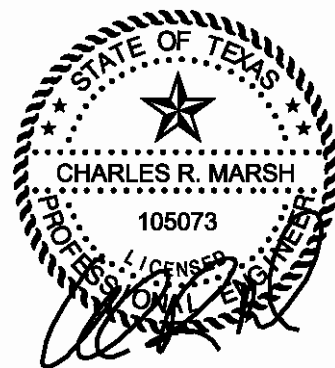

12/12/2024

**Weaver Consultants Group, LLC**  
TBPE Registration No. F-3727  
6420 Southwest Boulevard, Suite 206  
Fort Worth, Texas 76109  
817-735-9770

WCG Project No.0120-439-11-259

**McCARTY ROAD LANDFILL  
CITY OF HOUSTON, HARRIS COUNTY, TEXAS  
TCEQ PERMIT NO. MSW-261B**

**MAJOR PERMIT AMENDMENT APPLICATION**

**PART III - SITE DEVELOPMENT PLAN  
ATTACHMENT 6A  
DRAINAGE DESIGN REPORT**

Prepared for

McCarty Road Landfill TX, LP

Approved Site Development Plan


August 2008

Revised October 2010

Revised January 2012

Revised March 2024

Revised December 2024

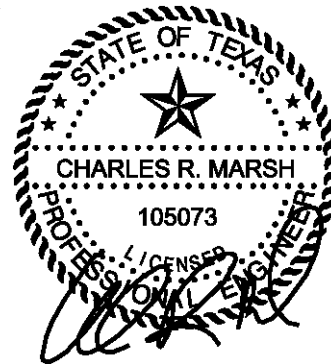

12/12/2024

**Weaver Consultants Group, LLC**  
TBPE Registration No. F-3727  
6420 Southwest Boulevard, Suite 206  
Fort Worth, Texas 76109  
817-735-9770

WCG Project No.0120-439-11-259

- HCFCD P100-00-00. This unit description belongs to Greens Bayou, which is located east of the site.

The peak flow generated from the area within the solid waste fill area will increase with this vertical expansion because the 4H:1V sideslope area has increased, the topdeck of the landfill has decreased, and the hydrologic modeling (e.g., precipitation model and modeling program) has been updated. Thus, drainage flowing from the landfill area will be conveyed to the perimeter channels faster than the currently permitted landfill configuration. To offset this increase in the peak flows, additional detention ponds and upgrades to the existing perimeter channels (and their outlet structures) have been incorporated into the design for the vertical expansion to attenuate the peak flows leaving the site. These drainage improvements are detailed in Attachments 6A.1 through 6A.30.

In addition, Table 6.1 has been developed to facilitate a comparison of flow rates and volumes entering the three downstream HCFCD drainage structures. A summary of peak flows and volumes is listed below.

- Peak Flow. As shown on Table 6.1, for each of these three discharges the peak flow for the landfill expansion condition is ~~not significantly changed from~~ **consistent with** the peak flow for the existing permitted landfill condition. The perimeter channel improvements and new detention ponds adequately attenuate the increase in peak flow generated by expanding the landfill vertically. In addition, the shape of the hydrographs in each case is similar. In general, for the expansion case the hydrograph peaks are reduced and the tail end of the hydrograph is slightly higher due to the additional detention that is added to the expansion drainage design.

**Table 6.1**  
**Flow Rates and Runoff Volumes for the Design Storm Event**

Stormwater Discharge Point	Existing Permitted Conditions				Postdevelopment Conditions			
	Flow Rate (cfs)		Runoff Volume (ac-ft)		Flow Rate (cfs)		Runoff Volume (ac-ft)	
	25 year	100 year	25 year	100 year	25 year	100 year	25 year	100 year
North (P116-00-00)	646 1,077	1,021 1,456	94 146	124 241	883 1,068	858 1,451	125 148	160 240
East (P100-00-00)	674 776	810 1,027	78 68	103 136	674 745	810 1,002	78 82	103 132
South (P114-00-00)	530 2,537	1,401 3,842	138 123	183 240	1,041 2,530	1,405 3,822	128	181 256
Total	1,711	2,605	309	410	2,367	3,254	326	459

- Volumes. As shown in Table 6.1, the volumes of flow entering each HCFCD channel for both the existing permitted condition and the proposed vertical

expansion condition are very similar. As discussed in Attachment 6A-A, the curve numbers used to represent the landfill final cover in both cases is 88. No change to the final cover system design is proposed. Therefore, the main reason for the additional volume (~~less than 10% increase~~) for the postdevelopment condition is the changes to the hydrologic model provided by HCFCD. The pond areas are modeled with a curve number of 100 (i.e., the decrease in infiltration due to the detention ponds results in a slightly increased total volume of runoff generated from the site).

Also shown in the Table 6.1, postdevelopment runoff volumes generated from the landfill's three drainage basins do not significantly alter the existing permitted conditions. This demonstration was submitted to the HCFCD in July 2011. Excerpts from the HCFCD submittal and their September 15, 2011 approval letter is included in Attachment 6B.

#### **4.4 Effect of Vertical Expansion on Peak Flows, Volumes, and Velocities Entering and Exiting the Landfill Permit Boundary**

The purpose of this section is to provide a demonstration that the peak flows, volumes, and velocities are not significantly altered at the landfill permit boundary. To complete this analysis, the HEC-HMS models for both the existing permitted and proposed vertical expansion cases were incorporated into the Greens Bayou model obtained from the HCFCD in ~~April 2011~~ February 2024. The resulting model, which is included in Appendix 6A-A, assesses the impact of the proposed vertical expansion on the local and regional drainage patterns.

The results of this demonstration are provided on Table 6-2 and Figures 4.3 through 4.6. Each discharge point is discussed in the following subsections.

##### **4.4.1 HCFCD Channel P116-00-00 (North)**

As shown in Attachment 6A.1, the permit boundary encompasses P116-00-00 on the north portion of the site. The hydrographs for stormwater entering and exiting the permit boundary are shown on Figure 4.4 for the 25-year and 100-year storm events. As Figure 4.4 shows, the hydrographs entering the site are similar for each storm event. ~~The peak flow leaving the permit boundary in P116-00-00 is increased slightly for the vertical expansion case. However, the minimal increase in flow rate results in minimal (e.g., less than 0.10 foot)~~The proposed condition results in no increases in discharge rate nor increases in the water surface elevation in P116-00-00. Additionally, the increased flow rates do not cause erosive flow velocities in P116-00-00.

As shown in Table 6-2, the volume of flow entering and exiting the permit boundary is ~~decreased slightly~~ consistent. The ~~decrease~~ changes in volume is due to the changes made to the HCFCD hydrologic model.

The velocities entering and exiting the permit boundary in the channel are similar, as shown on Table 6-2. This is to be expected given that the flow rates are similar and the channel cross-sections are the same. As demonstrated in the approved HCFCD analysis

(see Appendix B), the increase in flow rate, volume, and velocity in P116-00-00 has no adverse impact on Greens Bayou downstream of the permit boundary.

#### **4.4.2 HCFC Channel P114-00-00 (South)**

The permit boundary encompasses P114-00-00 on the southern portion of the site. The hydrographs entering and exiting the site are shown on Figure 4.5 for the 25-year and 100-year storm events. As with HCFC channel P116-00-00, the hydrographs entering the permit boundary are similar for each storm event. The peak flow leaving the permit boundary for this channel is ~~increased due to the changes to the South Pond decreased~~ slightly.

As shown on Table 6-2 the volume of flow entering the permit boundary is ~~lower for~~ unchanged by the expansion condition. The volume exiting the permit boundary is ~~higher~~ lower for the expansion condition. This result occurs because the differences between the drainage areas under the ~~existing~~ permitted and proposed conditions (refer to Figure 4.2) and the hydrologic model differences.

The differences in velocities in the channel entering and exiting the permit boundary are similar to the differences in flow rates for the permitted expansion conditions, as shown on Table 6-2. This is to be expected given that the flow rate and channel cross-section is the same. In both cases, the velocities are well below an erosive velocity (i.e., 5 ft/sec).

As demonstrated in the approved HCFC analysis (see Appendix B), the increase in flow rate, volume, and velocity in P114-00-00 has no adverse impact on Greens Bayou downstream of the permit boundary.

#### **4.4.3 Greens Bayou (P100-00-00 located east of the site)**

As shown on Figures 4.2 and 4.3, the location of the permitted outfalls will not be modified with the vertical expansion of the landfill along the eastern portion of the site. As shown on Figure 4.6, and listed in Table 6-2, the combined peak flow leaving the permit boundary on the eastern portion of the site for the vertical expansion is less than the permitted condition, due to the updates to the hydrologic model.

Also, the volume of flow has been ~~decreased by a small percentage~~ increased, as shown in Table 6-2. This is due to the changes in the hydrologic modeling method and ~~drainage area delineations~~.

A velocity comparison is not applicable to this portion of the site since the outfall locations and design have not been modified and the flow rates have slightly decreased (i.e., the velocities will be less). However, as demonstrated in Appendix 6A-B the outfall structures have been designed to manage the incremental velocities created at each outfall structure. Each outfall structure includes a low-water outlet and emergency spillway which is lined with gabions to protect the underlying soil from erosive velocities. In addition, the design of these outfalls, which are located within the HCFC easement, have been approved by HCFC (refer to Attachment 6B).

**TABLE 6-2  
FLOW RATE, VOLUME, AND VELOCITY COMPARISON AT PERMIT BOUNDARY**

COMPARISON POINT	EXISTING PERMITTED CONDITION						VERTICAL EXPANSION CONDITION					
	FLOW RATE (cfs)		RUN-OFF VOLUME (ac-ft)		VELOCITY (ft/sec)		FLOW RATE (cfs)		RUN-OFF VOLUME (ac-ft)		VELOCITY (ft/sec)	
	25 year	100 year	25 year	100 year	25 year	100 year	25 year	100 year	25 year	100 year	25 year	100 year
ENTERING P116-00-00 (North)	112 51	148 77	103 50	141 81	2.81 1.91	3.02 2.55	40 51	55 77	41 50	56 81	2.14 1.91	2.33 2.55
LEAVING P116-00-00	677 1,077	1,063 1,456	197 146	265 241	3.73 4.57	4.18 3.00	883 1,068	58 1,451	125 148	160 240	3.99 4.51	3.96 4.98
ENTERING P114-00-00 (South)	752 733	1,000 1,080	863 379	1,168 634	3.38 2.52	3.43 3.63	582 733	793 1,080	296 379	430 634	1.32 2.52	1.56 3.63
LEAVING P114-00-00	1,150 2,537	1,673 3,842	1,019 1,374	1,376 2,314	2.65 2.94	2.37 3.08	1,910 2,530	2,798 3,822	1,111 1,379	1,598 2,300	2.75 2.94	2.94 3.07
Leaving Eastern Permit Boundary to Greens Bayou	674 776	810 1,027	78 68	103 136	N/A <sup>1</sup>	N/A <sup>1</sup>	674 745	810 1,002	78 82	103 132	N/A <sup>1</sup>	N/A <sup>1</sup>

1 A velocity comparison is not applicable to this portion of the site.

## 4.5 Effect of Vertical Expansion on Greens Bayou

Sections 4.3 and 4.4 demonstrated that the vertical expansion will not adversely alter existing drainage patterns. The purpose of this Section is to provide a final demonstration that shows the flow in Greens Bayou downstream of the site is also not adversely impacted by the proposed vertical expansion of the landfill.

Figure 4.1 shows the Greens Bayou watershed in the area of the site. This figure also shows the individual drainage areas, as reproduced from previous HCFCD studies. Note that flow from the northern and eastern portion of the landfill discharges to Greens Bayou at a location adjacent to the site. Flow from the southern portion of the site drains to P114-00-00, which flows beneath US Highway 90 before discharging to Greens Bayou approximately 3,000 feet south of the site.

To demonstrate that the proposed vertical expansion does not adversely alter the existing drainage patterns of Greens Bayou, both the HEC-HMS analysis for the permitted and proposed conditions were incorporated into the regional study obtained from the HCFCD. Hydrographs for both conditions were developed at the downstream point of Area P100 T, as shown on Figure 4.1. The resulting hydrographs for both the 25-year and 100-year storm events are presented on Figure 4.7. As shown on Figure 4.7, the hydrographs for both the permitted and proposed vertical expansion conditions are similar in shape and scale. ~~However, the higher peak flow rate for the postdevelopment condition is due to the higher flow rates in Greens Bayou from contributing drainage basins upstream of the permit boundary.~~ As shown in Appendix 6B, when the permit boundary is incorporated into the existing HCFCD hydrologic model, the peak flow rates downstream of the permit boundary are decreased due to the timing of the hydrographs in Greens Bayou.


## 4.6 Summary

The updated detention pond designs will result in increased flow rates discharged from this permit boundary; however, the regional drainage patterns (e.g., flow rates in Greens Bayou downstream of the permit boundary) are not adversely impacted.

From the hydrological evaluations of the existing permitted and postdevelopment conditions, the drainage conditions at the permit boundary will not be adversely altered by the proposed development. Given that: (1) drainage patterns are not adversely altered and (2) stormwater discharge outfall locations are consistent with the permitted and existing configurations, it is concluded that the proposed landfill development will not significantly alter existing permitted drainage patterns consistent with §330.56 (f)(4)(A)(iv) and §330.55(b)(5)(D).



D:\0120\439\PLP MOD 2024\ATT 6\FIGURES\FIG-4.2 DRAIN AREA.DWG, PAPER FIGURE, 1:2

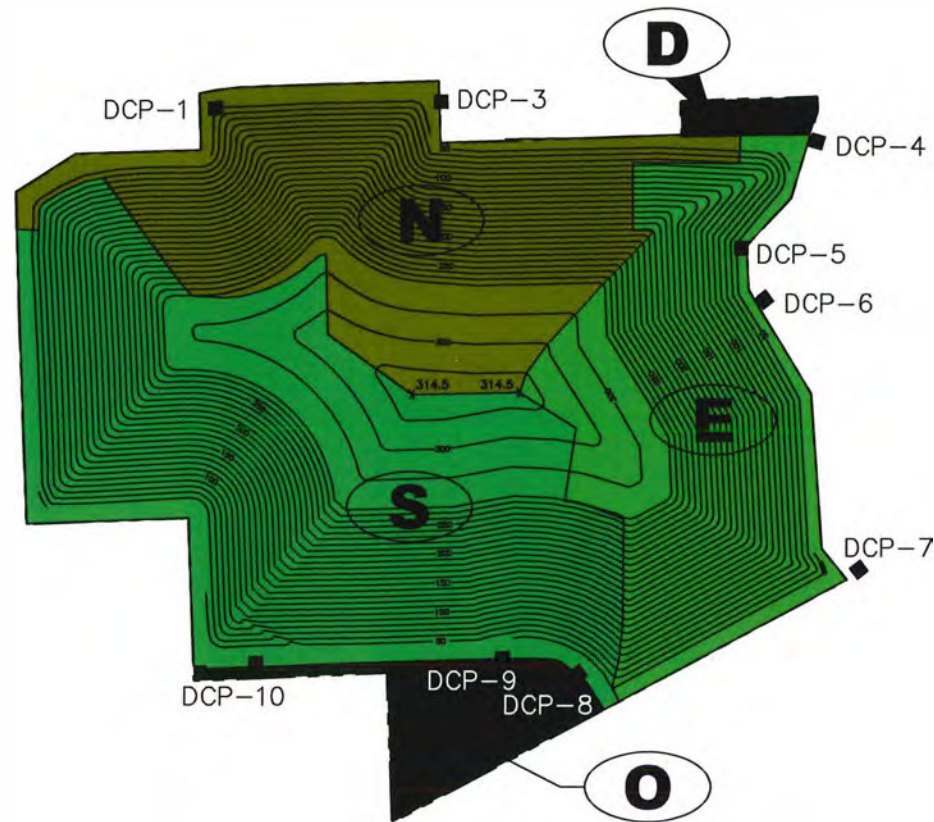



CURRENTLY PERMITTED CONDITION  
DRAINAGE AREAS

N= 125.99 ACRES  
S= 195.10 ACRES  
E= 105.41 ACRES  
D= 5.49 ACRES  
O= 26.26 ACRES

NOTES:

1. DRAINAGE AREA D FLOWS INTO THE NORTHERN SOIL BORROW AREA.
2. DRAINAGE AREA O IS MOSTLY COMPRISED OF THE OLD LANDFILL.
3. SEE ATTACHMENT 7 FOR PROPOSED FINAL COMPLETION PLAN.
4. FLOW FROM DRAINAGE AREA S SHEET FLOWS TO AN AREA WEST OF THE SITE.

LEGEND

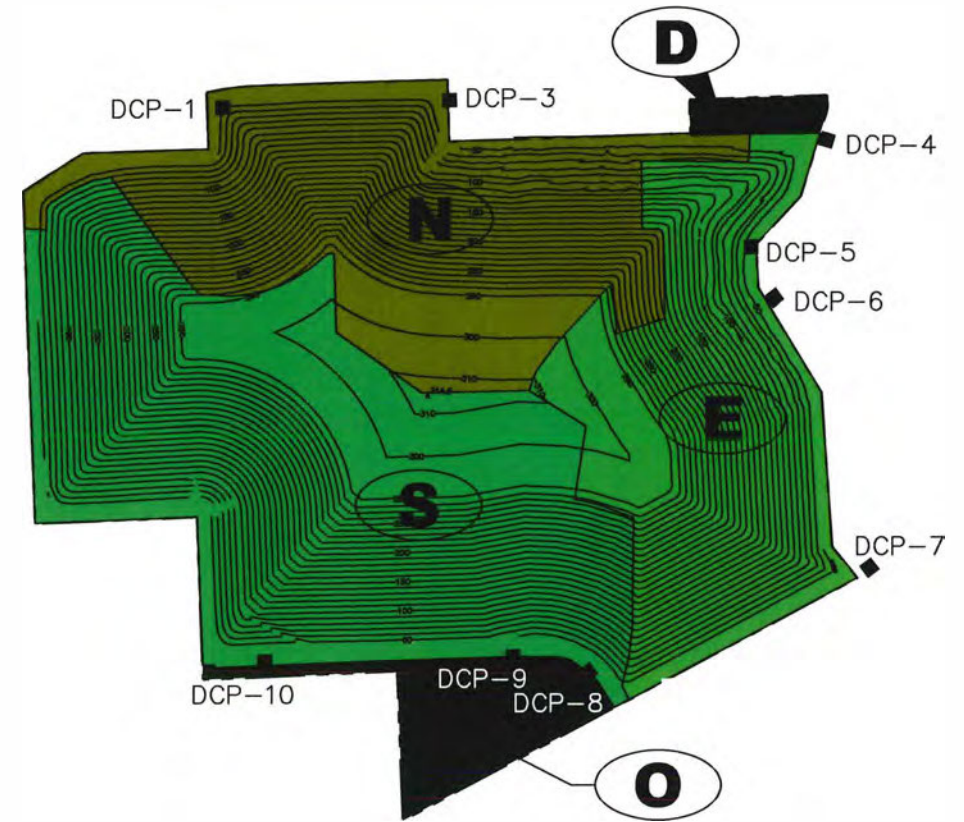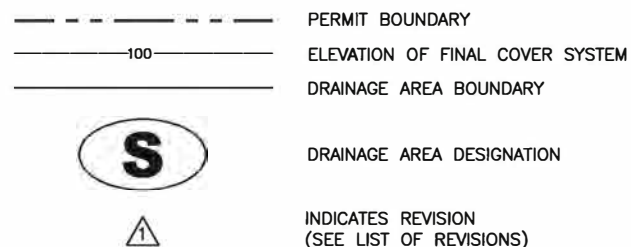


PROPOSED FINAL CONTOUR IMPROVEMENTS  
DRAINAGE AREAS

N= 124.69 ACRES  
S= 195.10 ACRES  
E= 106.71 ACRES  
D= 5.49 ACRES  
O= 26.26 ACRES

LIST OF REVISIONS:

1. UPDATED AREA DELINEATIONS.

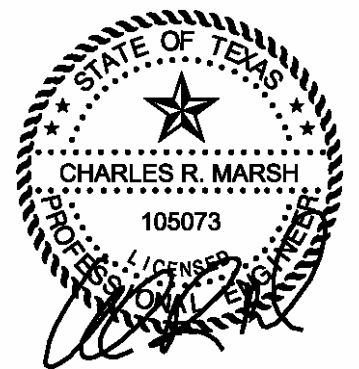

12/12/2024


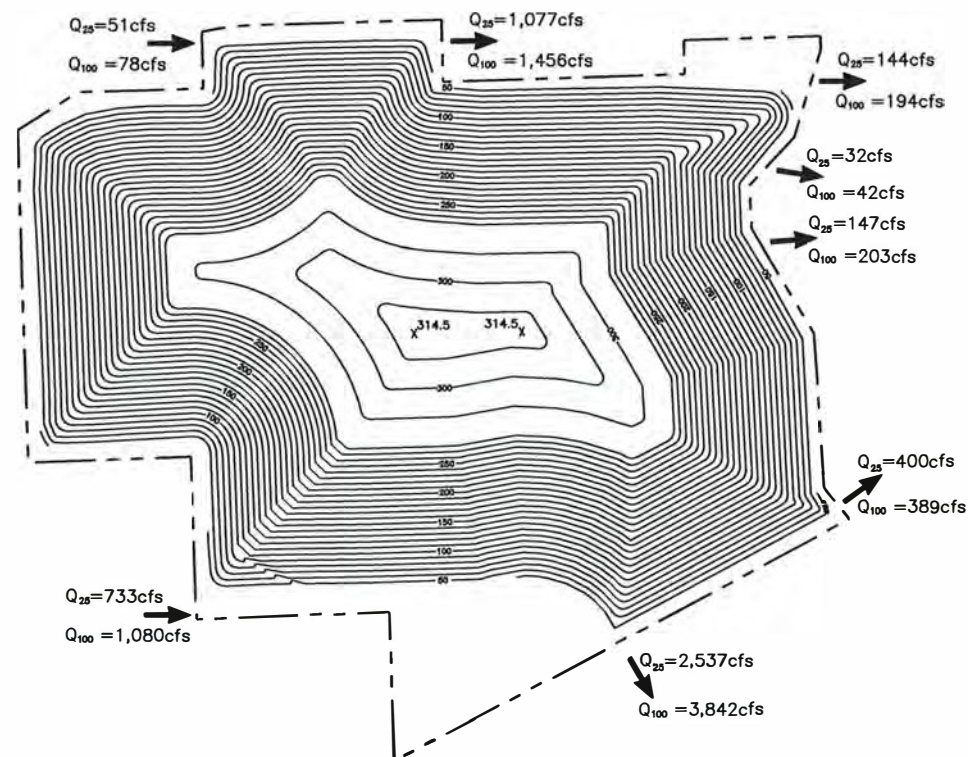
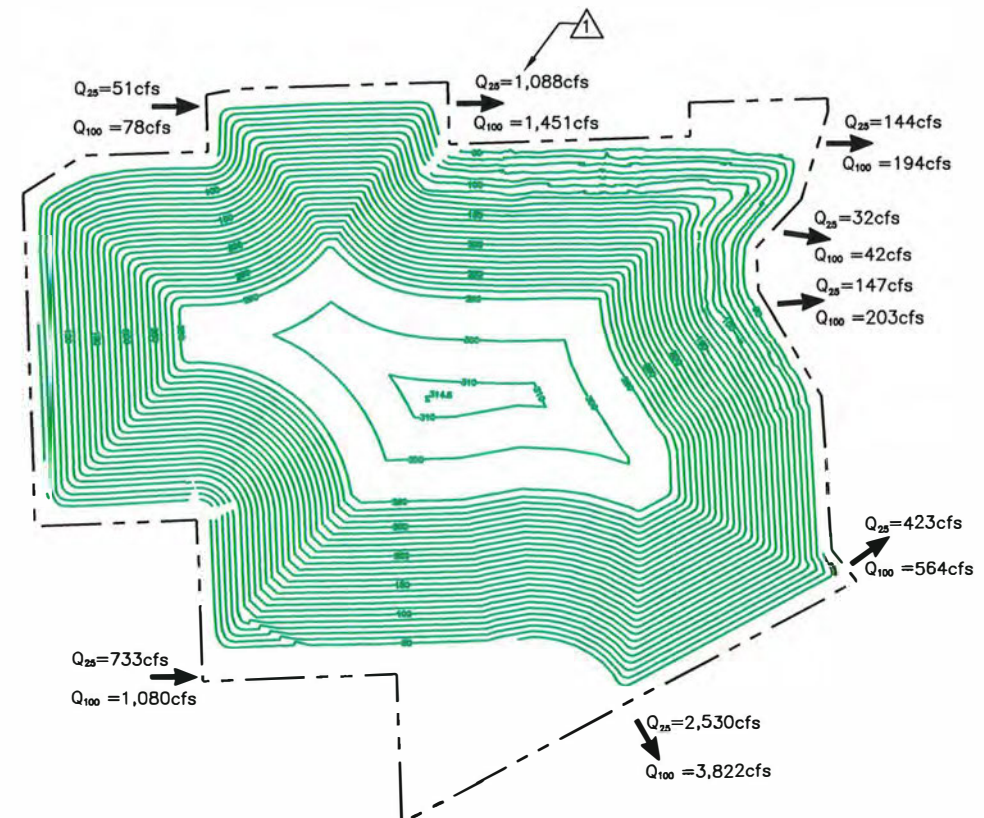
<div><input type="checkbox"/> DRAFT</div> <div><input checked="" type="checkbox"/> FOR PERMITTING PURPOSES ONLY</div> <div><input type="checkbox"/> ISSUED FOR CONSTRUCTION</div>		PREPARED FOR		MAJOR PERMIT AMENDMENT SITE DRAINAGE PATTERNS			
		McCARTY ROAD LANDFILL TX, LP					
DATE: 03/2004 FILE: 0120-439-11 CAD: FIG-4.2DRAIN AREA.DWG		DRAWN BY: JDW DESIGN BY: SAN/ALD REVIEWED BY: JPY		McCARTY ROAD LANDFILL HARRIS COUNTY, TEXAS			
REVISIONS							
NO.		DATE				DESCRIPTION	
1		08/2006				PERMIT MODIFICATION UPDATE	
2		12/2024				SEE LIST OF REVISIONS	
<div> Weaver Consultants Group</div> <div>TBPE REGISTRATION NO. F-3727</div>				WWW.WCGRP.COM			
				FIGURE 4.2			

FIGURE 4.2





CURRENTLY PERMITTED CONDITION



PROPOSED FINAL CONTOUR IMPROVEMENTS


LEGEND

- PERMIT BOUNDARY
- 100--- ELEVATION OF FINAL COVER SYSTEM
- △ INDICATES REVISION (SEE LIST OF REVISIONS)

LIST OF REVISIONS:  
1. UPDATED FLOW RATES.

NOTES:


1. SEE ATTACHMENT 6A-A FOR POST DEVELOPMENT HYDROLOGIC INFORMATION.
2. SEE ATTACHMENT 6A-E FOR CURRENTLY PERMITTED HYDROLOGIC INFORMATION.

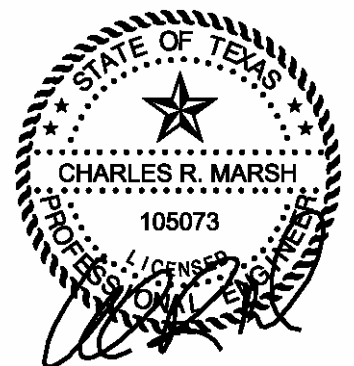


12/12/2024

<div><input type="checkbox"/> DRAFT</div> <div><input checked="" type="checkbox"/> FOR PERMITTING PURPOSES ONLY</div> <div><input type="checkbox"/> ISSUED FOR CONSTRUCTION</div>		PREPARED FOR		MAJOR PERMIT AMENDMENT SITE DRAINAGE PATTERNS	
		McCARTY ROAD LANDFILL TX, LP			
DATE: 03/2004 FILE: 0120-439-11 CAD: FIG-4.3 PATTERNS.DWG		DRAWN BY: JDW DESIGN BY: SAN REVIEWED BY: JPY		McCARTY ROAD LANDFILL HARRIS COUNTY, TEXAS	
REVISIONS					
NO.		DATE		DESCRIPTION	
1		08/2006		PERMIT MODIFICATION UPDATE	
2		01/2012		PERMIT MODIFICATION	
3		12/2024		SEE LIST OF REVISIONS	
<div><div></div>Weaver Consultants Group</div> <div>TBPE REGISTRATION NO. F-3727</div>				WWW.WCGRP.COM	
				FIGURE 4.3	

PEAK FLOW ENTERING NORTHWEST PERMIT BOUNDARY  
HCFCD DITCH P116-00-00

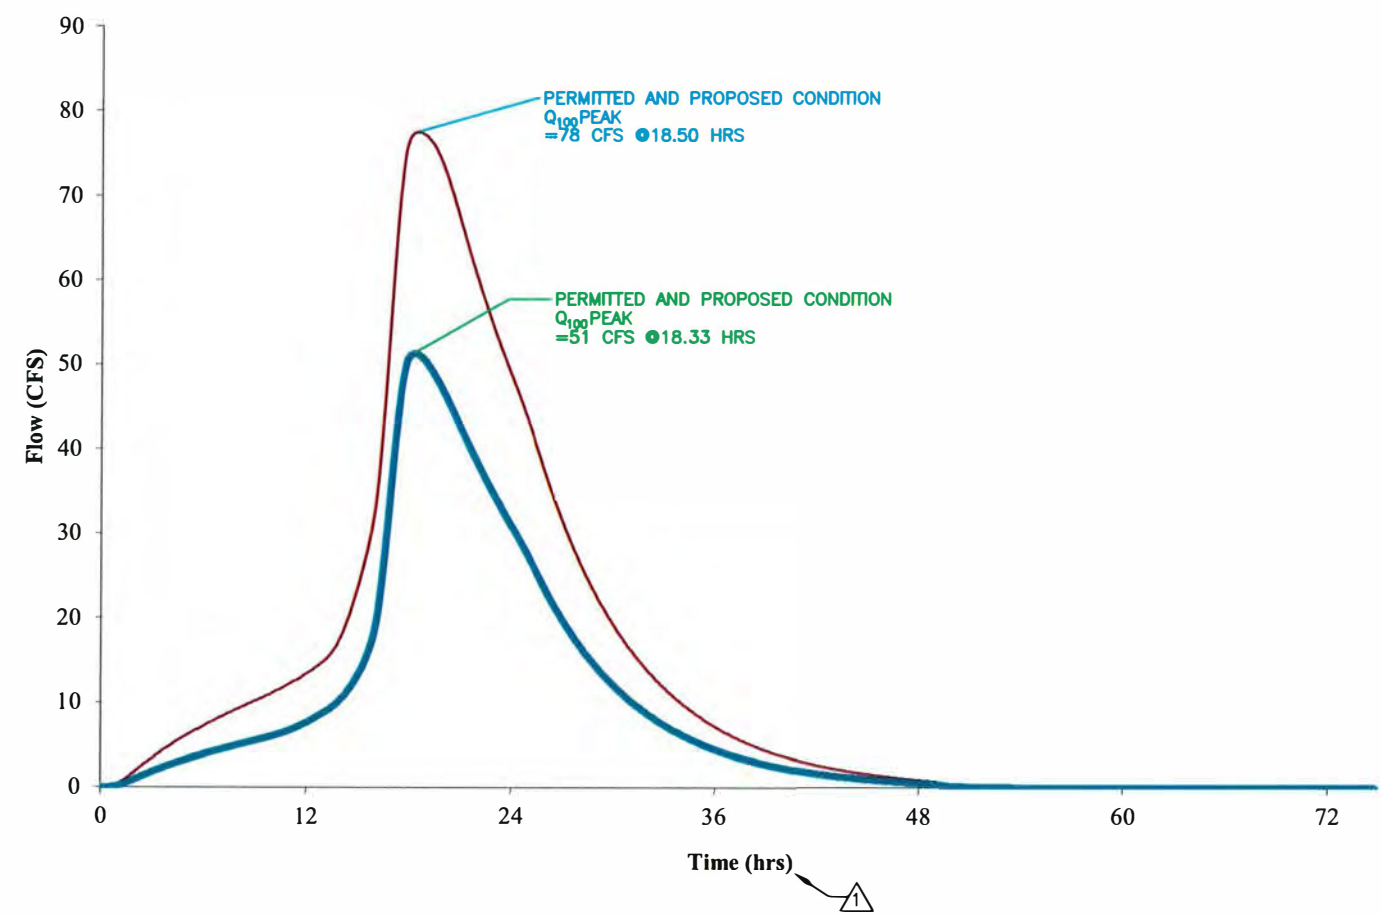


PEAK FLOW LEAVING NORTHEAST PERMIT BOUNDARY  
HCFCD DITCH P116-00-00

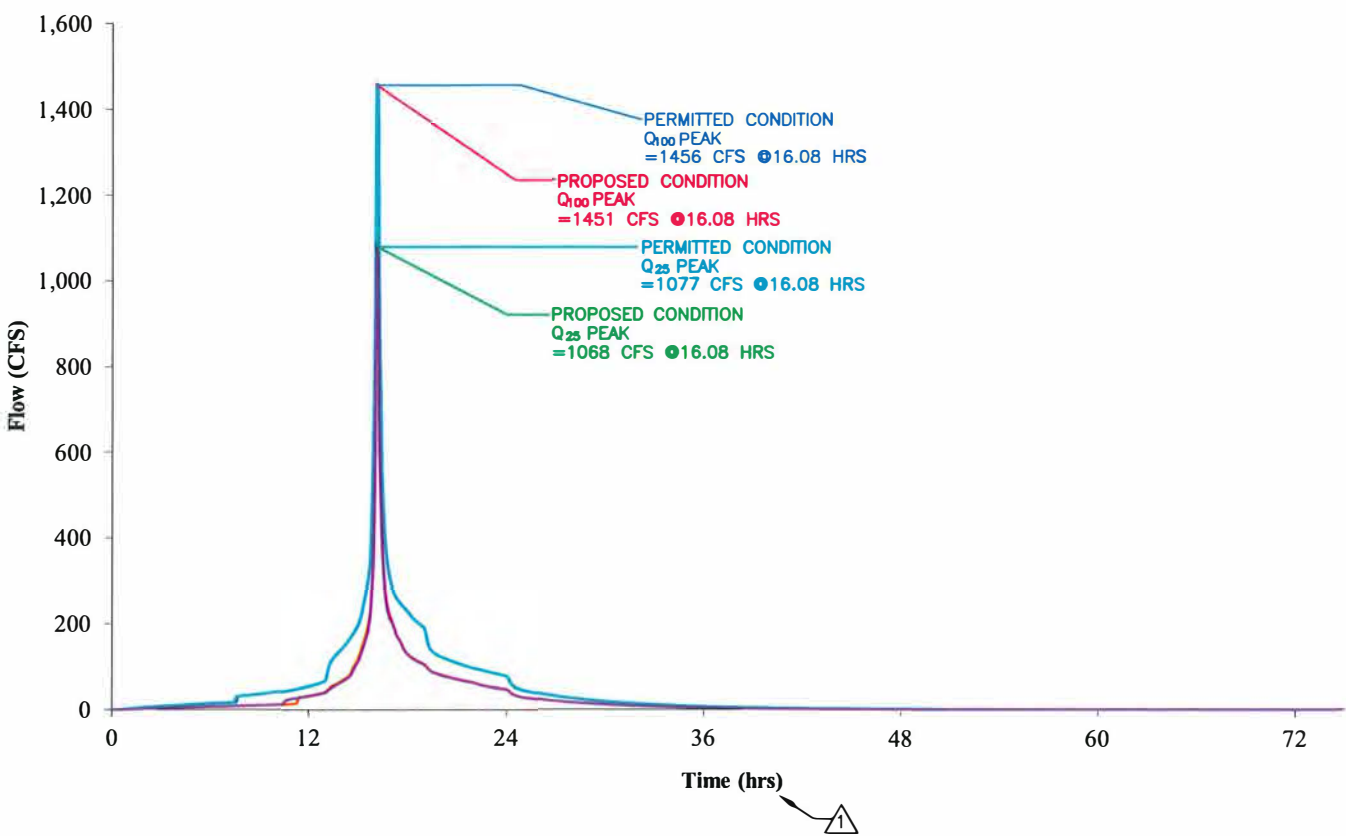

1 INDICATES REVISION  
(SEE LIST OF REVISIONS)

LIST OF REVISIONS:  
1. UPDATED FLOW RATES.

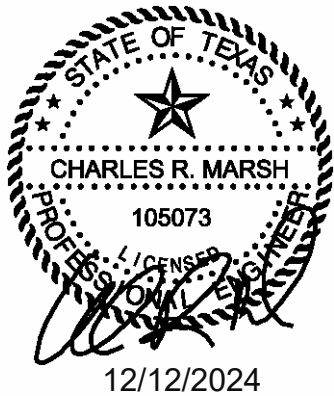

<input type="checkbox"/> DRAFT <input checked="" type="checkbox"/> FOR PERMITTING PURPOSES ONLY <input type="checkbox"/> ISSUED FOR CONSTRUCTION	PREPARED FOR <b>McCARTY ROAD LANDFILL TX, LP</b>	<b>MAJOR PERMIT AMENDMENT PEAK FLOW COMPARISON HCFCD DITCH P116-00-00 (NORTH)</b>  McCARTY ROAD LANDFILL HARRIS COUNTY, TEXAS				
DATE: 03/2004 FILE: 0120-439-11 CAD: FIG-4.4 PEAK.DWG	DRAWN BY: JDW DESIGN BY: SAN REVIEWED BY: JPY			REVISIONS		
				NO.	DATE	DESCRIPTION
				1	08/2006	PERMIT MODIFICATION UPDATE
		2	01/2012	PERMIT MODIFICATION		
		3	12/2024	SEE LIST OF REVISIONS		
<b>Weaver Consultants Group</b> TBPE REGISTRATION NO. F-3727		WWW.WCGRP.COM		FIGURE 4.4		

Flow (CFS)

Time (hrs)

PERMITTED AND PROPOSED CONDITION  
 $Q_{100}$  PEAK  
 = 1080 CFS @ 16.75 HRS

PERMITTED AND PROPOSED CONDITION  
 $Q_{100}$  PEAK  
 = 733 CFS @ 16.75 HRS

 INDICATES REVISION  
(SEE LIST OF REVISIONS)


LIST OF REVISIONS:

- ### 1. UPDATED FLOW RATES.


The graph displays the flow (CFS) over time (hrs) for four different conditions. The Y-axis represents Flow (CFS) from 0 to 4,500, and the X-axis represents Time (hrs) from 0 to 72. The legend indicates the following data points:

- PERMITTED CONDITION  $Q_{100}$  PEAK**: 3842 CFS @ 16.08 HRS (Red line)
- PROPOSED CONDITION  $Q_{100}$  PEAK**: 3822 CFS @ 17.42 HRS (Blue line)
- PERMITTED CONDITION  $Q_{25}$  PEAK**: 2537 CFS @ 17.50 HRS (Green line)
- PROPOSED CONDITION  $Q_{25}$  PEAK**: 2530 CFS @ 17.50 HRS (Cyan line)

The graph shows that the proposed conditions result in lower peak flows and later peak times compared to the permitted conditions. The proposed  $Q_{100}$  peak is slightly lower and occurs later than the permitted  $Q_{100}$  peak. The proposed  $Q_{25}$  peak is slightly lower and occurs at the same time as the permitted  $Q_{25}$  peak.

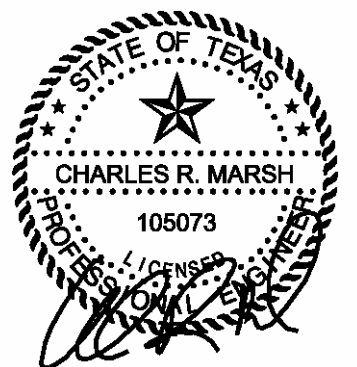


12/12/2024

<input type="checkbox"/> DRAFT <input checked="" type="checkbox"/> FOR PERMITTING PURPOSES ONLY <input type="checkbox"/> ISSUED FOR CONSTRUCTION		PREPARED FOR <b>McCARTY ROAD LANDFILL TX, LP</b>		<b>MAJOR PERMIT AMENDMENT</b> <b>PEAK FLOW COMPARISON HCFCD</b> <b>DITCH P114-00-00 (SOUTH)</b>													
DATE: 03/2004 FILE: 0120-439-11 CAD: FIG-4.5 PEAK.DWG		DRAWN BY: JDW DESIGN BY: SAN REVIEWED BY: JPY		REVISIONS													
				<table border="1"> <thead> <tr> <th>NO.</th> <th>DATE</th> <th>DESCRIPTION</th> </tr> </thead> <tbody> <tr> <td>1</td> <td>08/2006</td> <td>PERMIT MODIFICATION UPDATE</td> </tr> <tr> <td>2</td> <td>01/2012</td> <td>PERMIT MODIFICATION</td> </tr> <tr> <td>3</td> <td>12/2024</td> <td>SEE LIST OF REVISIONS</td> </tr> </tbody> </table>		NO.	DATE	DESCRIPTION	1	08/2006	PERMIT MODIFICATION UPDATE	2	01/2012	PERMIT MODIFICATION	3	12/2024	SEE LIST OF REVISIONS
NO.	DATE	DESCRIPTION															
1	08/2006	PERMIT MODIFICATION UPDATE															
2	01/2012	PERMIT MODIFICATION															
3	12/2024	SEE LIST OF REVISIONS															
 <b>Weaver Consultants Group</b> TBPE REGISTRATION NO. F-3727				<b>McCARTY ROAD LANDFILL</b> <b>HARRIS COUNTY, TEXAS</b>													
				WWW.WCGRP.COM													
				FIGURE 4.5													



O:\0120\439\FLIP MOD 2024\ATT 0\FIGURES\FIG-4.6 PEAK.dwg, rnr.rington, 1:2

COMBINED FLOW INTO GREENS BAYOU (EAST)

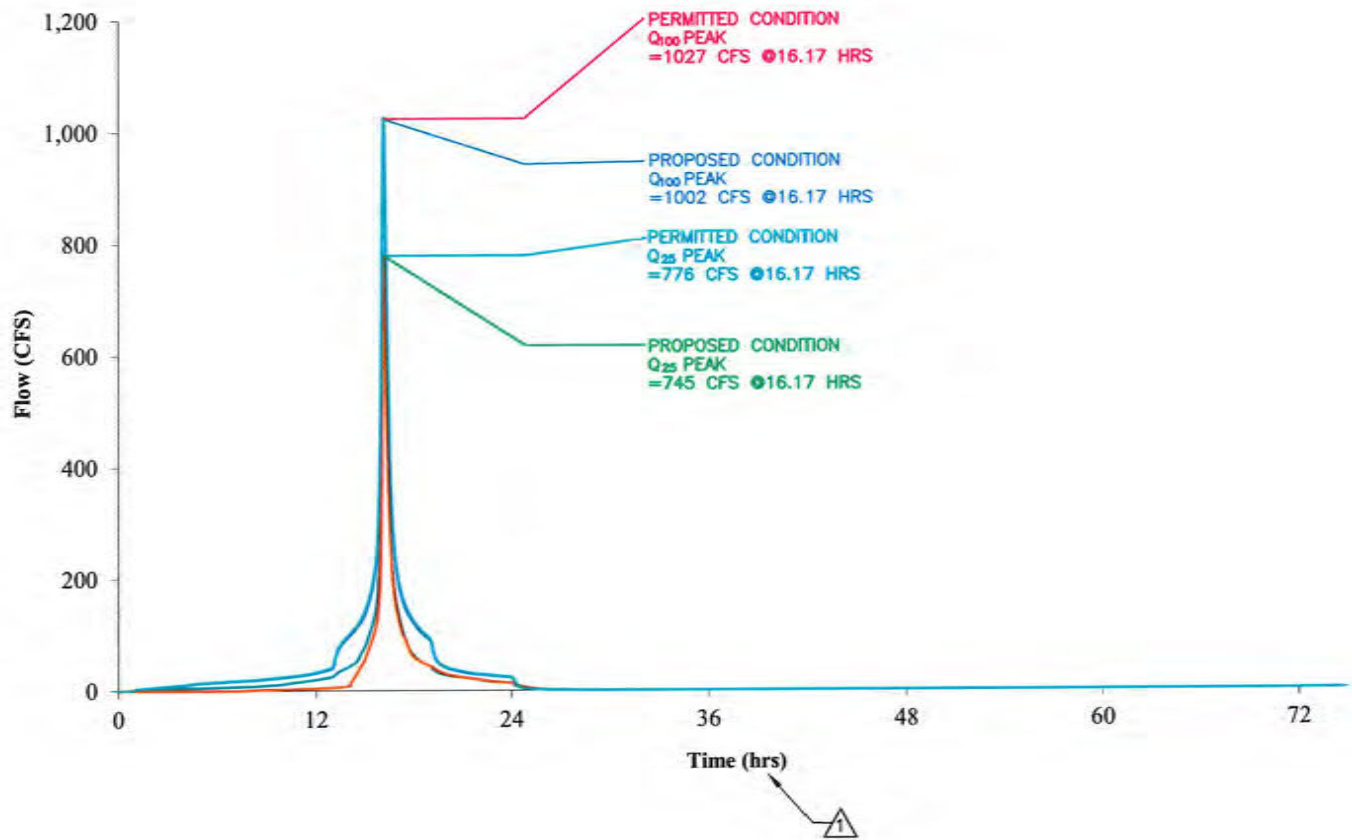

△ INDICATES REVISION  
(SEE LIST OF REVISIONS)


LIST OF REVISIONS:  
1. UPDATED FLOW RATES.

STATE OF TEXAS  
★  
CHARLES R. MARSH  
105073  
PROFESSIONAL ENGINEER  
12/12/2024

<input type="checkbox"/> DRAFT <input checked="" type="checkbox"/> FOR PERMITTING PURPOSES ONLY <input type="checkbox"/> ISSUED FOR CONSTRUCTION	PREPARED FOR <b>McCARTY ROAD LANDFILL TX, LP</b>		<b>MAJOR PERMIT AMENDMENT COMBINED FLOW INTO GREENS BAYOU (EAST)</b>  McCARTY ROAD LANDFILL HARRIS COUNTY, TEXAS			
	DATE: 03/2004 FILE: 0120-439-11 CAD: FIG-4.6 PEAK.DWG				REVISIONS	
	DRAWN BY: JOW DESIGN BY: SAN REVIEWED BY: JPY					
<b>Weaver Consultants Group</b> TBPE REGISTRATION NO. F-3727	1	08/2008	PERMIT MODIFICATION UPDATE			
	2	12/2024	SEE LIST OF REVISIONS			
WWW.WCGRP.COM			FIGURE 4.6			


0:\0120\430\FUP\_M00\_2024\ATT 6\FIGURES\FIG-4.7 PEAK.dwg, Furrington, 1:2

PEAK FLOW FOR COMBINED FLOW IN GREENS BAYOU  
HCFCD CHANNEL P100-00-00

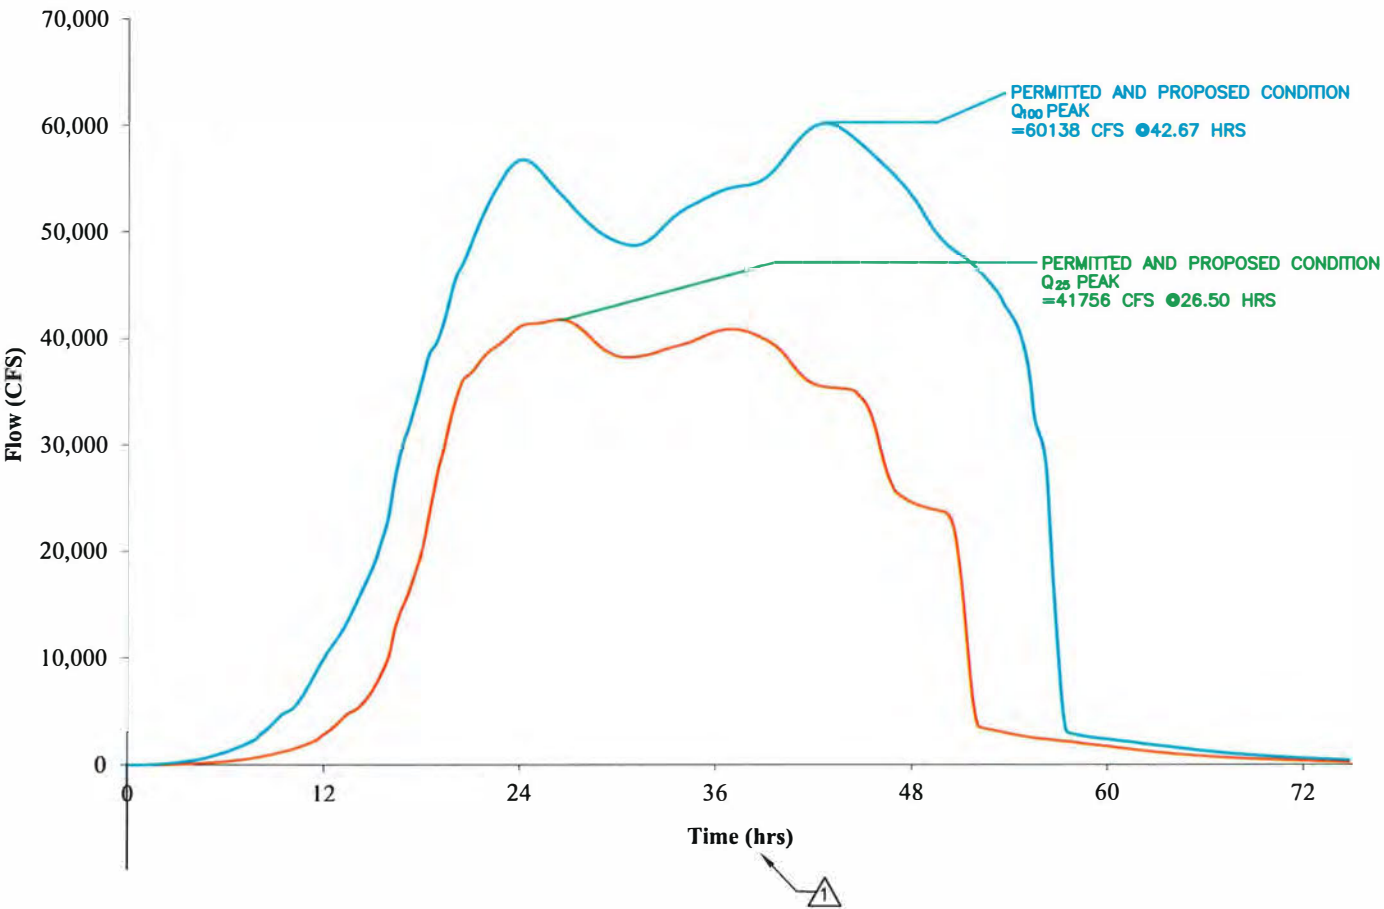

INDICATES REVISION  
(SEE LIST OF REVISIONS)

LIST OF REVISIONS:  
1. UPDATED FLOW RATES.

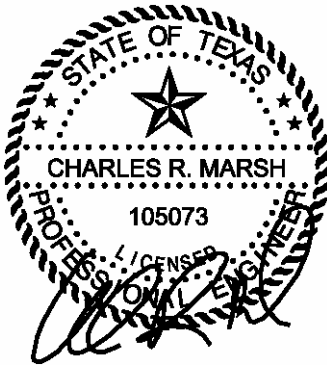


12/12/2024

<input type="checkbox"/> DRAFT <input checked="" type="checkbox"/> FOR PERMITTING PURPOSES ONLY <input type="checkbox"/> ISSUED FOR CONSTRUCTION		PREPARED FOR <b>McCARTY ROAD LANDFILL TX, LP</b>		<b>MAJOR PERMIT AMENDMENT COMBINED FLOW COMPARISON FOR GREENS BAYOU</b>  McCARTY ROAD LANDFILL HARRIS COUNTY, TEXAS			
DATE: 03/2004 FILE: 0120-439-11 CAD: FIG-4.7 PEAK.DWG		DRAWN BY: JDW DESIGN BY: SAN REVIEWED BY: JPY				REVISIONS	
						NO. DATE DESCRIPTION	
						1 08/2006 PERMIT MODIFICATION UPDATE	
				2 01/2012 PERMIT MODIFICATION			
				3 12/2024 SEE LIST OF REVISIONS			
<b>Weaver Consultants Group</b> TBPE REGISTRATION NO. F-3727				WWW.WCGRP.COM			

FIGURE 4.7



0:\0120\439\FLIP MOD 2024\ATT 6\6A.1-DR-STRUC-PLAN.dwg, rarrington, 1:2

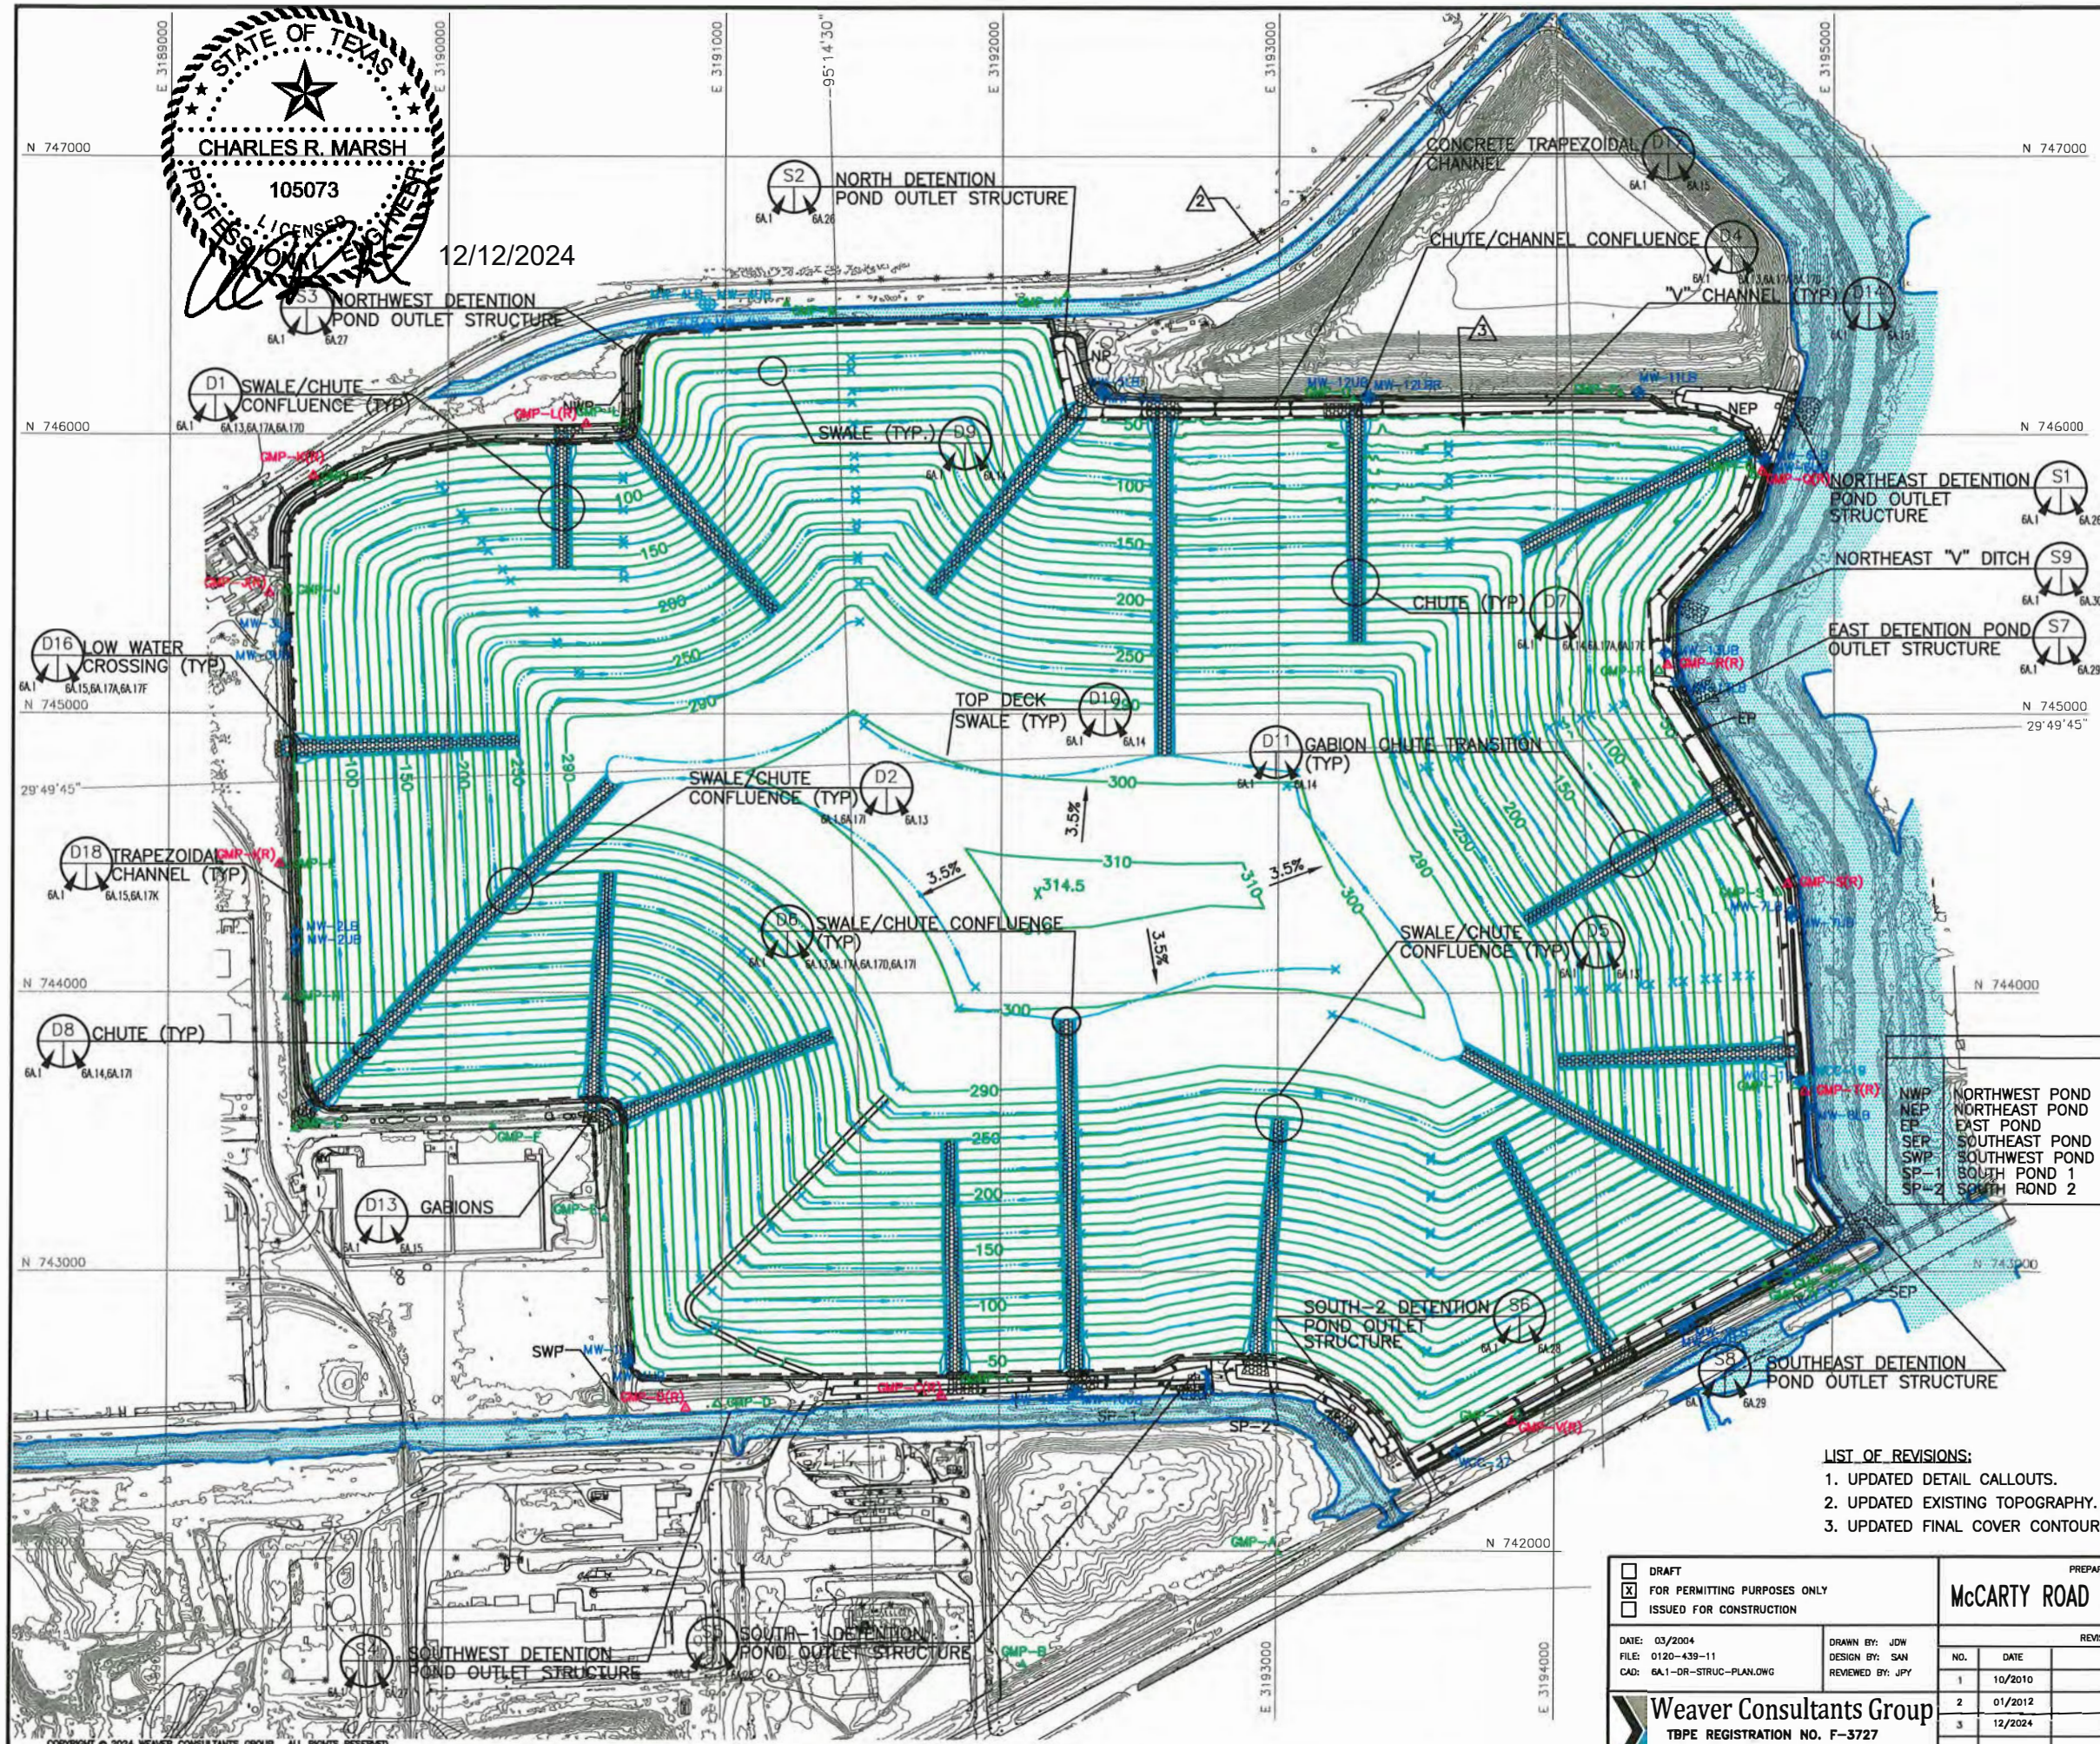

**LEGEND**


--- PERMIT BOUNDARY  
--- LIMITS OF WASTE  
--- DEED RESTRICTION BOUNDARY (SEE NOTE 7)  
--- 200 --- FINAL CONTOUR  
--- 745000 N --- STATE PLANE COORDINATE SYSTEM  
--- 29°49'45" --- GEODETIC COORDINATE SYSTEM  
--- EXISTING GROUND CONTOUR  
--- PROPOSED DRAINAGE SWALE  
--- PROPOSED DRAINAGE LETDOWN (SEE NOTE 9)  
--- MW-4UB --- EXISTING DETECTION GROUNDWATER MONITORING WELL  
--- MW-4UB --- EXISTING DETECTION GROUNDWATER MONITORING WELL TO BE DECOMMISSIONED  
--- GMP-M --- PROPOSED DETECTION REPLACEMENT MONITORING WELL  
--- GMP-M --- EXISTING LANDFILL GAS MONITORING PROBE (SEE NOTE 8)  
--- GMP-M --- EXISTING LANDFILL GAS MONITORING PROBE TO BE DECOMMISSIONED (SEE NOTE 8)  
--- GMP-M --- PROPOSED REPLACEMENT LANDFILL GAS MONITORING PROBE (SEE NOTE 8)  
--- EASEMENT BOUNDARY  
--- GABIONS  
--- 100-YR FLOODPLAIN (REFER TO ATTACHMENT 6C)  
--- INDICATES REVISION (SEE LIST OF REVISIONS)









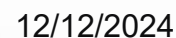











- NOTES:**
- TOPOGRAPHIC MAPPING PREPARED BY FIRMATEK FROM AERIAL PHOTOGRAPHY FLOWN 11-17-2023. THE GRID SYSTEM IS TIED TO THE TEXAS STATE PLANE COORDINATE SYSTEM SOUTH CENTRAL ZONE NAD 1927.
  - PERMIT BOUNDARY AND EASEMENTS WERE REPRODUCED FROM COSTELLO, INC. STANDARD LAND SURVEY DRAWING, DATED MARCH 2004.
  - REFER TO ATTACHMENT 7B FOR POST DEVELOPMENT DRAINAGE INFORMATION.
  - COVER DETAILS ARE PROVIDED IN ATTACHMENT 6D-FINAL COVER DETAILS.
  - TYPICAL SIDESLOPES ARE 4H:1V, TYPICAL TOPSLOPE IS 3.5%.
  - DETENTION POND INFORMATION IS PROVIDED ON ATTACHMENTS 6A.18 THROUGH 6A.25.
  - REFER TO ATTACHMENT 6, APPENDIX 6A-F FOR DEED RESTRICTION INFORMATION.
  - GAS MONITORING PROBES GMP-Q, GMP-R, AND GMP-S ARE BEING DECOMMISSIONED AND RELOCATED AS DOCUMENTED IN A PERMIT MODIFICATION SUBMITTED BY WEAVER BOOS CONSULTANTS (WBC) IN APRIL 2004. GMP-T5 AND GMP-U ARE BEING DECOMMISSIONED IN A PERMIT MODIFICATION SUBMITTED BY WBC IN APRIL 2004. GMP-T1 WILL BECOME A PERMANENT GAS MONITORING PROBE FOR THIS AREA. REFER TO ATTACHMENT 14 FOR ADDITIONAL INFORMATION.
  - GABION-LINED LETDOWN DETAILS ARE INCLUDED ON ATTACHMENTS 6A.13 THROUGH 6A.17. FLEXIBLE MEMBRANE LINED (FML) LETDOWN DETAILS ARE INCLUDED ON ATTACHMENTS 6A.17A THROUGH 6A.17C. FLEXAMAT LETDOWN DETAILS ARE INCLUDED ON ATTACHMENTS 6A.17D THROUGH 6A.17H. ARTICULATED BLOCK LETDOWN DETAILS ARE INCLUDED ON ATTACHMENTS 6A.17I THROUGH 6A.17L.

- LIST OF REVISIONS:**
- UPDATED DETAIL CALLOUTS.
  - UPDATED EXISTING TOPOGRAPHY.
  - UPDATED FINAL COVER CONTOURS.

<input type="checkbox"/> DRAFT <input checked="" type="checkbox"/> FOR PERMITTING PURPOSES ONLY <input type="checkbox"/> ISSUED FOR CONSTRUCTION		PREPARED FOR <b>MCCARTY ROAD LANDFILL TX, LP</b>		<b>MAJOR PERMIT AMENDMENT DRAINAGE STRUCTURE PLAN</b>	
DATE: 03/2004 FILE: 0120-439-11 CAD: 6A.1-DR-STRUC-PLAN.DWG		DRAWN BY: JOW DESIGN BY: SAN REVIEWED BY: JPY		McCARTY ROAD LANDFILL HARRIS COUNTY, TEXAS	
Weaver Consultants Group TBE REGISTRATION NO. F-3727		REVISIONS		WWW.WCGRP.COM	
		NO. DATE DESCRIPTION		ATTACHMENT 6A.1	
		1 10/2010 PERMIT MODIFICATION			
		2 01/2012 PERMIT MODIFICATION			
		3 12/2024 SEE LIST OF REVISIONS			





- |   |  |
|---|--|
|  | PERMIT BOUNDARY  |
|  | LIMITS OF WASTE  |
|  | DEED RESTRICTION BOUNDARY (SEE NOTE 4)                                   |
|  | FINAL CONTOUR  |
|  | STATE PLANE COORDINATE SYSTEM  |
|  | GEODETIC COORDINATE SYSTEM   |
|  | EXISTING CONTOUR   |
|  | PROPOSED DRAINAGE SWALE  |
|  | PROPOSED DRAINAGE LETDOWN  |
|  | EXISTING DETECTION GROUNDWATER MONITORING WELL                           |
|  | EXISTING DETECTION GROUNDWATER MONITORING WELL TO BE DECOMMISSIONED      |
|  | PROPOSED DETECTION REPLACEMENT MONITORING WELL                           |
|  | EXISTING LANDFILL GAS MONITORING PROBE (SEE NOTE 5)                      |
|  | EXISTING LANDFILL GAS MONITORING PROBE TO BE DECOMMISSIONED (SEE NOTE 5) |
|  | PROPOSED REPLACEMENT LANDFILL GAS MONITORING ROBE (SEE NOTE 5)           |
|  | EASEMENT BOUNDARY  |
|  | GABIONS  |
|  | 100-YR FLOODPLAIN (REFER TO ATTACHMENT 6C)                               |
|  | DRAINAGE AREA DESIGNATION  |
|  | DRAINAGE AREA BOUNDARY   |


NOTES:

1. TOPOGRAPHIC MAPPING PREPARED BY FIRMATEK FROM AERIAL PHOTOGRAPHY FLOWN 11-17-2023. THE GRID SYSTEM IS TIED TO THE TEXAS STATE PLANE COORDINATE SYSTEM SOUTH CENTRAL ZONE NAD 1927.
2. PERMIT BOUNDARY AND EASEMENTS WERE REPRODUCED FROM COSTELLO, INC. STANDARD LAND SURVEY DRAWING, DATED MARCH 2004.
3. REFER TO ATTACHMENT 7B FOR POST DEVELOPMENT DRAINAGE INFORMATION.
4. REFER TO ATTACHMENT 6, APPENDIX 6A-F FOR DEED RESTRICTION INFORMATION.
5. GAS MONITORING PROBES GMP-Q, GMP-R, AND GMP-S ARE BEING DECOMMISSIONED AND RELOCATED AS DOCUMENTED IN A PERMIT MODIFICATION SUBMITTED BY WEAVER BOOS CONSULTANTS (WBC) IN APRIL 2004. GMP-T5 AND GMP-U ARE BEING DECOMMISSIONED IN A PERMIT MODIFICATION SUBMITTED BY WBC IN APRIL 2004. GMP-T1 WILL BECOME A PERMANENT GAS MONITORING PROBE FOR THIS AREA. REFER TO ATTACHMENT 14 FOR ADDITIONAL INFORMATION.

LIST OF REVISIONS:

1. UPDATED DRAINAGE AREAS.
2. UPDATED EXISTING TOPOGRAPHY.
3. UPDATED FINAL COVER CONTOURS.



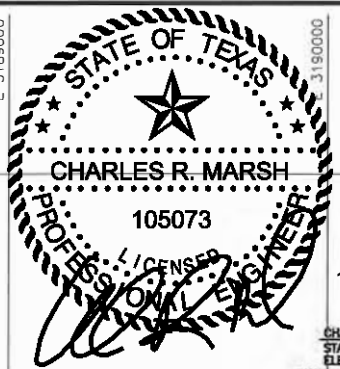

12/12/2024

**LEGEND**

- PERMIT BOUNDARY
- LIMITS OF WASTE
- DEED RESTRICTION BOUNDARY (SEE NOTE 4)
- STATE PLANE COORDINATE SYSTEM
- GEODETIC COORDINATE SYSTEM
- EXISTING CONTOUR
- EXISTING DETECTION GROUNDWATER MONITORING WELL
- EXISTING DETECTION GROUNDWATER MONITORING WELL TO BE DECOMMISSIONED
- PROPOSED DETECTION REPLACEMENT MONITORING WELL
- EXISTING LANDFILL GAS MONITORING PROBE (SEE NOTE 5)
- EXISTING LANDFILL GAS MONITORING PROBE TO BE DECOMMISSIONED (SEE NOTE 5)
- PROPOSED REPLACEMENT LANDFILL GAS MONITORING PROBE (SEE NOTE 5)
- EASEMENT BOUNDARY
- GABIONS
- CONCRETE

**POND LABELS**

NP	NORTH POND
NWP	NORTHWEST POND
NEP	NORTHEAST POND
EP	EAST POND
SEP	SOUTHEAST POND
SWP	SOUTHWEST POND
SP-1	SOUTH POND 1
SP-2	SOUTH POND 2

PI: POINT OF INTERSECTION  
PVI: POINT OF VERTICAL INTERSECTION  
STA: STATION (FT)  
ELEV: ELEVATION (FT-MSL)  
Q<sub>89</sub> cfs 25-YEAR PEAK FLOW RATE (CUBIC FEET PER SECOND)  
Q<sub>129</sub> cfs 100-YEAR PEAK FLOW RATE (CUBIC FEET PER SECOND)

- NOTES:**
- TOPOGRAPHIC MAPPING PREPARED BY FIRMATEK FROM AERIAL PHOTOGRAPHY FLOWN 11-17-2023. THE GRID SYSTEM IS TIED TO THE TEXAS STATE PLANE COORDINATE SYSTEM SOUTH CENTRAL ZONE NAD 1927.
  - PERMIT BOUNDARY AND EASEMENTS WERE REPRODUCED FROM COSTELLO, INC. STANDARD LAND SURVEY DRAWING, DATED MARCH 2004.
  - CHANNEL PROFILE INFORMATION PRESENTED ON ATTACHMENTS 6A.4 THROUGH 6A.13.
  - REFER TO ATTACHMENT 6, APPENDIX 6A-F FOR DEED RESTRICTION INFORMATION.
  - GAS MONITORING PROBES GMP-Q, GMP-R, AND GMP-S ARE BEING DECOMMISSIONED AND RELOCATED AS DOCUMENTED IN A PERMIT MODIFICATION SUBMITTED BY WEAVER BOOS CONSULTANTS (WBC) IN APRIL 2004. GMP-T5 AND GMP-U ARE BEING DECOMMISSIONED IN A PERMIT MODIFICATION SUBMITTED BY WBC IN APRIL 2004. GMP-T1 WILL BECOME A PERMANENT GAS MONITORING PROBE FOR THIS AREA.



- LIST OF REVISIONS:**
- UPDATED OUTFALL INFORMATION.
  - UPDATED EXISTING TOPOGRAPHY.

<input type="checkbox"/> DRAFT <input checked="" type="checkbox"/> FOR PERMITTING PURPOSES ONLY <input type="checkbox"/> ISSUED FOR CONSTRUCTION	PREPARED FOR <b>MCCARTY ROAD LANDFILL TX, LP</b>	<b>MAJOR PERMIT AMENDMENT PERIMETER DRAINAGE PLAN</b>													
	DATE: 03/2004 FILE: 0120-439-11 CAD: 6A.03-PR-STRUC-PLAN.DWG			DRAWN BY: JOW DESIGN BY: SAN REVIEWED BY: JPY											
	<b>Weaver Consultants Group</b> TBPB REGISTRATION NO. F-3727	<table><tr><th colspan="3">REVISIONS</th></tr><tr><th>NO.</th><th>DATE</th><th>DESCRIPTION</th></tr><tr><td>1</td><td>01/2012</td><td>PERMIT MODIFICATION</td></tr><tr><td>2</td><td>12/2024</td><td>SEE LIST OF REV. SONS</td></tr></table>		REVISIONS			NO.	DATE	DESCRIPTION	1	01/2012	PERMIT MODIFICATION	2	12/2024	SEE LIST OF REV. SONS
REVISIONS															
NO.	DATE	DESCRIPTION													
1	01/2012	PERMIT MODIFICATION													
2	12/2024	SEE LIST OF REV. SONS													

O:\0120\439\FLIP MOD 2024\ATT 6\6A.03-PER-STRUC-PLAN.DWG, RATTINGTON, 1:2



O:\0120\439\FLIP MOD 2024\ATT 6\6A\6A.04-PROA.dwg, rurrington, 1:200

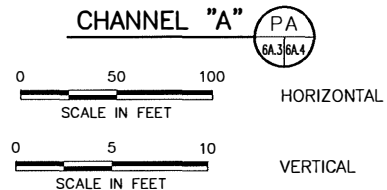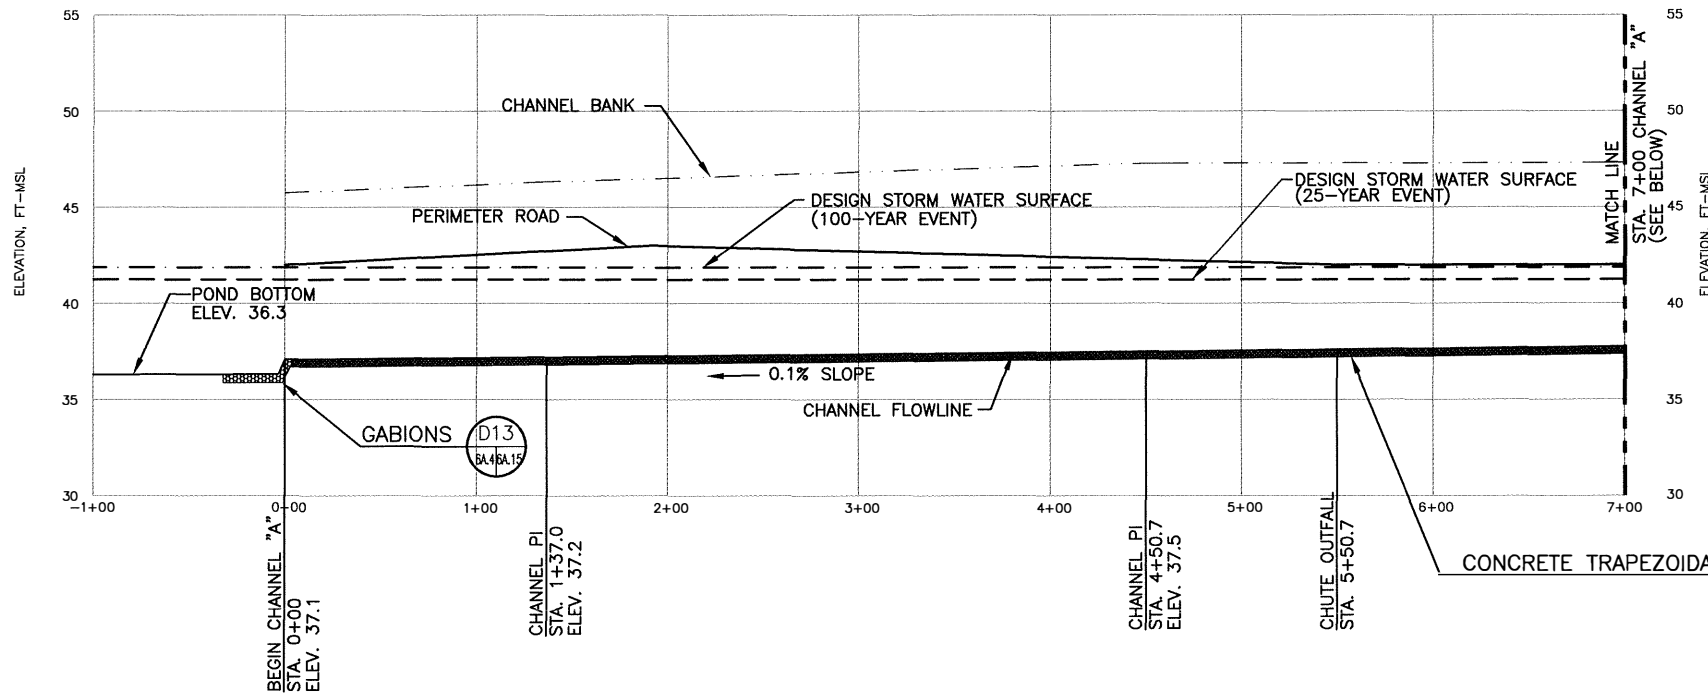


25-YEAR CHANNEL "A" INFORMATION						
CHANNEL FROM	STATION TO	BOTTOM WIDTH (FT)	PEAK INFLOW (CFS)	SLOPE (%)	FLOW DEPTH (FT.)	VELOCITY (FT/S)
0+00	1+37	12	315	0.1	2.99	5.02
1+37	4+50.7	12	315	0.1	2.99	5.02
4+50.7	7+68.1	12	315	0.1	2.99	5.02
7+68.1	16+89.6	0	34	0.1	2.82	1.43

NOTE: NORMAL DEPTH CALCULATION DOES NOT ACCOUNT FOR BACK WATER WHICH WILL INCREASE FLOW DEPTH (SEE PROFILE) AND DECREASE VELOCITY.

100-YEAR CHANNEL "A" INFORMATION						
CHANNEL FROM	STATION TO	BOTTOM WIDTH (FT)	PEAK INFLOW (CFS)	SLOPE (%)	FLOW DEPTH (FT.)	VELOCITY (FT/S)
0+00	1+37	12	432	0.1	3.50	5.47
1+37	4+50.7	12	432	0.1	3.50	5.47
4+50.7	7+68.1	12	432	0.1	3.50	5.47
7+68.1	16+89.6	0	48	0.1	3.21	1.55

NOTE: NORMAL DEPTH CALCULATION DOES NOT ACCOUNT FOR BACK WATER WHICH WILL INCREASE FLOW DEPTH (SEE PROFILE) AND DECREASE VELOCITY.


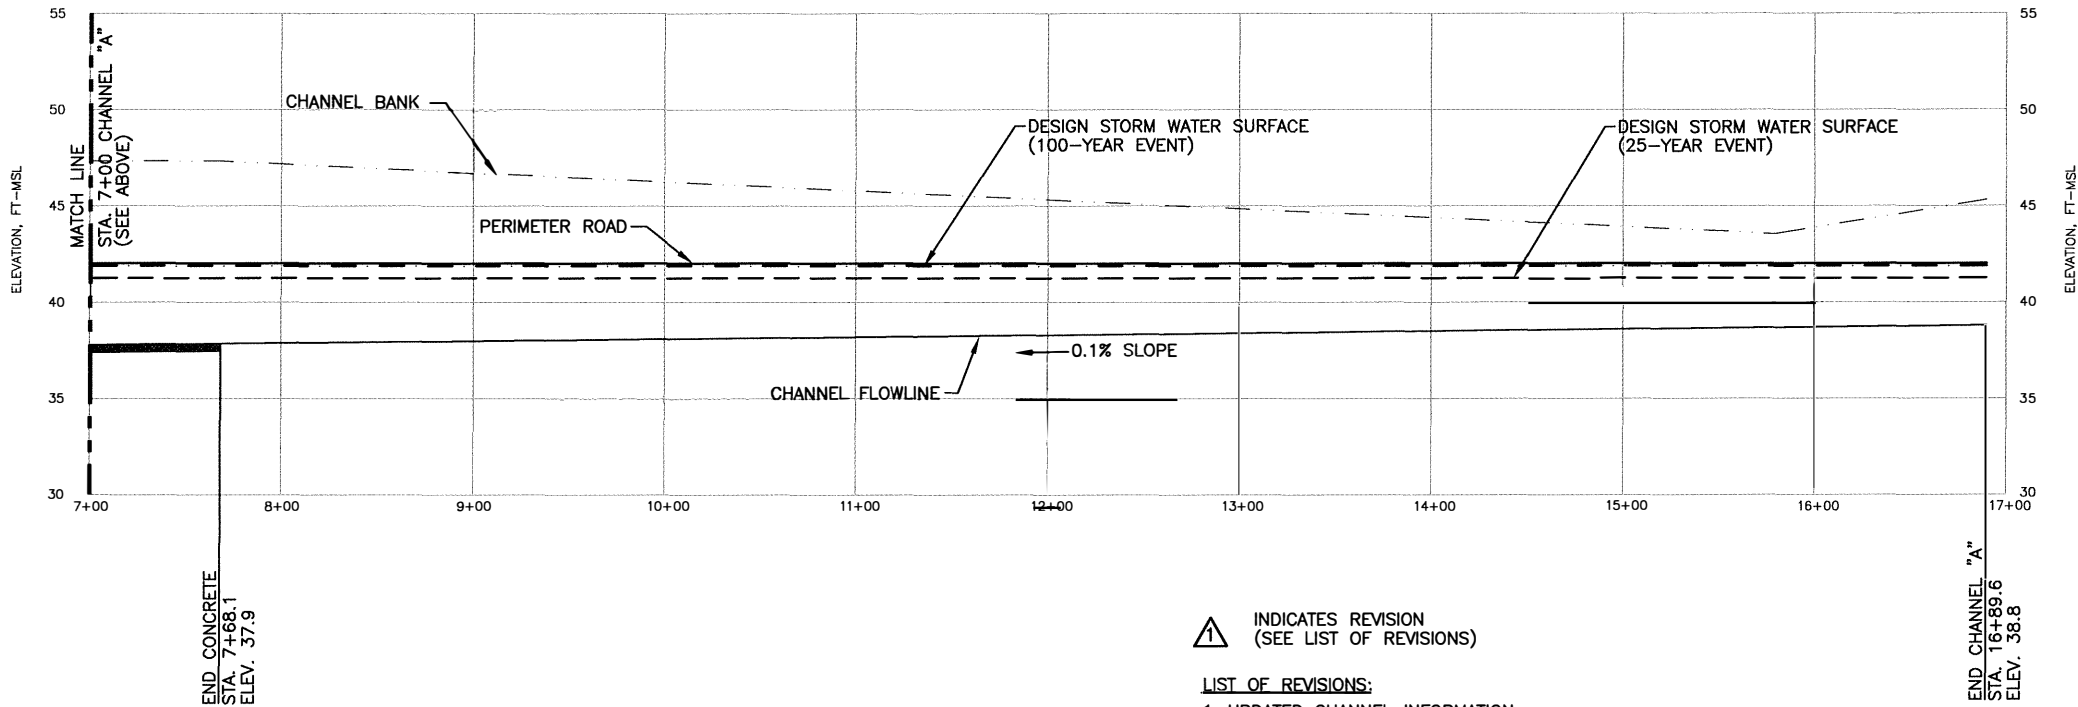


INDICATES REVISION (SEE LIST OF REVISIONS)

LIST OF REVISIONS:  
1. UPDATED CHANNEL INFORMATION.


NOTES:

- REFER TO ATTACHMENT 6A.3 FOR PROFILE LOCATIONS.
- CONTOURS AND ELEVATIONS DEVELOPED BY BASE MAPPING FROM AERIAL PHOTOGRAPHY FLOWN FEBRUARY 18, 2003. THE GRID SYSTEM IS TIED TO THE TEXAS STATE PLANE COORDINATE SYSTEM SOUTH CENTRAL ZONE NAD 1927.
- HYDRAULIC CALCULATIONS INCLUDED IN ATTACHMENT 6A-B.

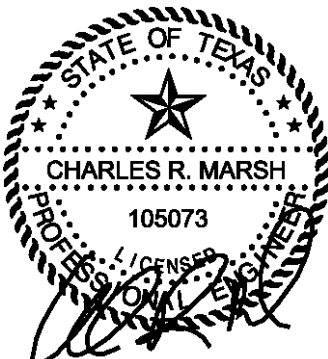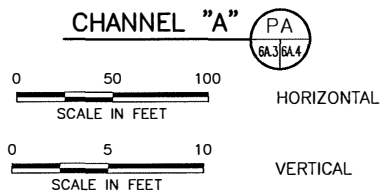


12/12/2024

<input type="checkbox"/> DRAFT <input checked="" type="checkbox"/> FOR PERMITTING PURPOSES ONLY <input type="checkbox"/> ISSUED FOR CONSTRUCTION	PREPARED FOR <b>McCARTY ROAD LANDFILL TX, LP</b>	MAJOR PERMIT AMENDMENT PERIMETER CHANNEL "A" PROFILE		
DATE: 03/2004 FILE: 0120-439-11 CAD: 6A.04-PROA.DWG	DRAWN BY: JDW DESIGN BY: SAN REVIEWED BY: JPY	REVISIONS		
		NO.	DATE	DESCRIPTION
		1	01/2012	PERMIT MODIFICATION
		2	12/2024	SEE LIST OF REVISIONS
<b>Weaver Consultants Group</b> TBPE REGISTRATION NO. F-3727		WWW.WCGRP.COM		ATTACHMENT 6A.4

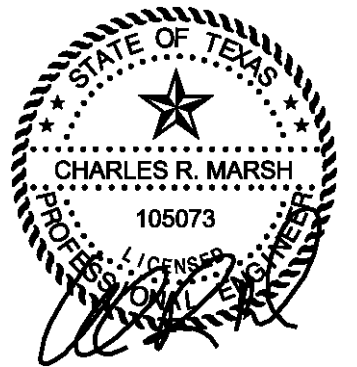


12/12/2024

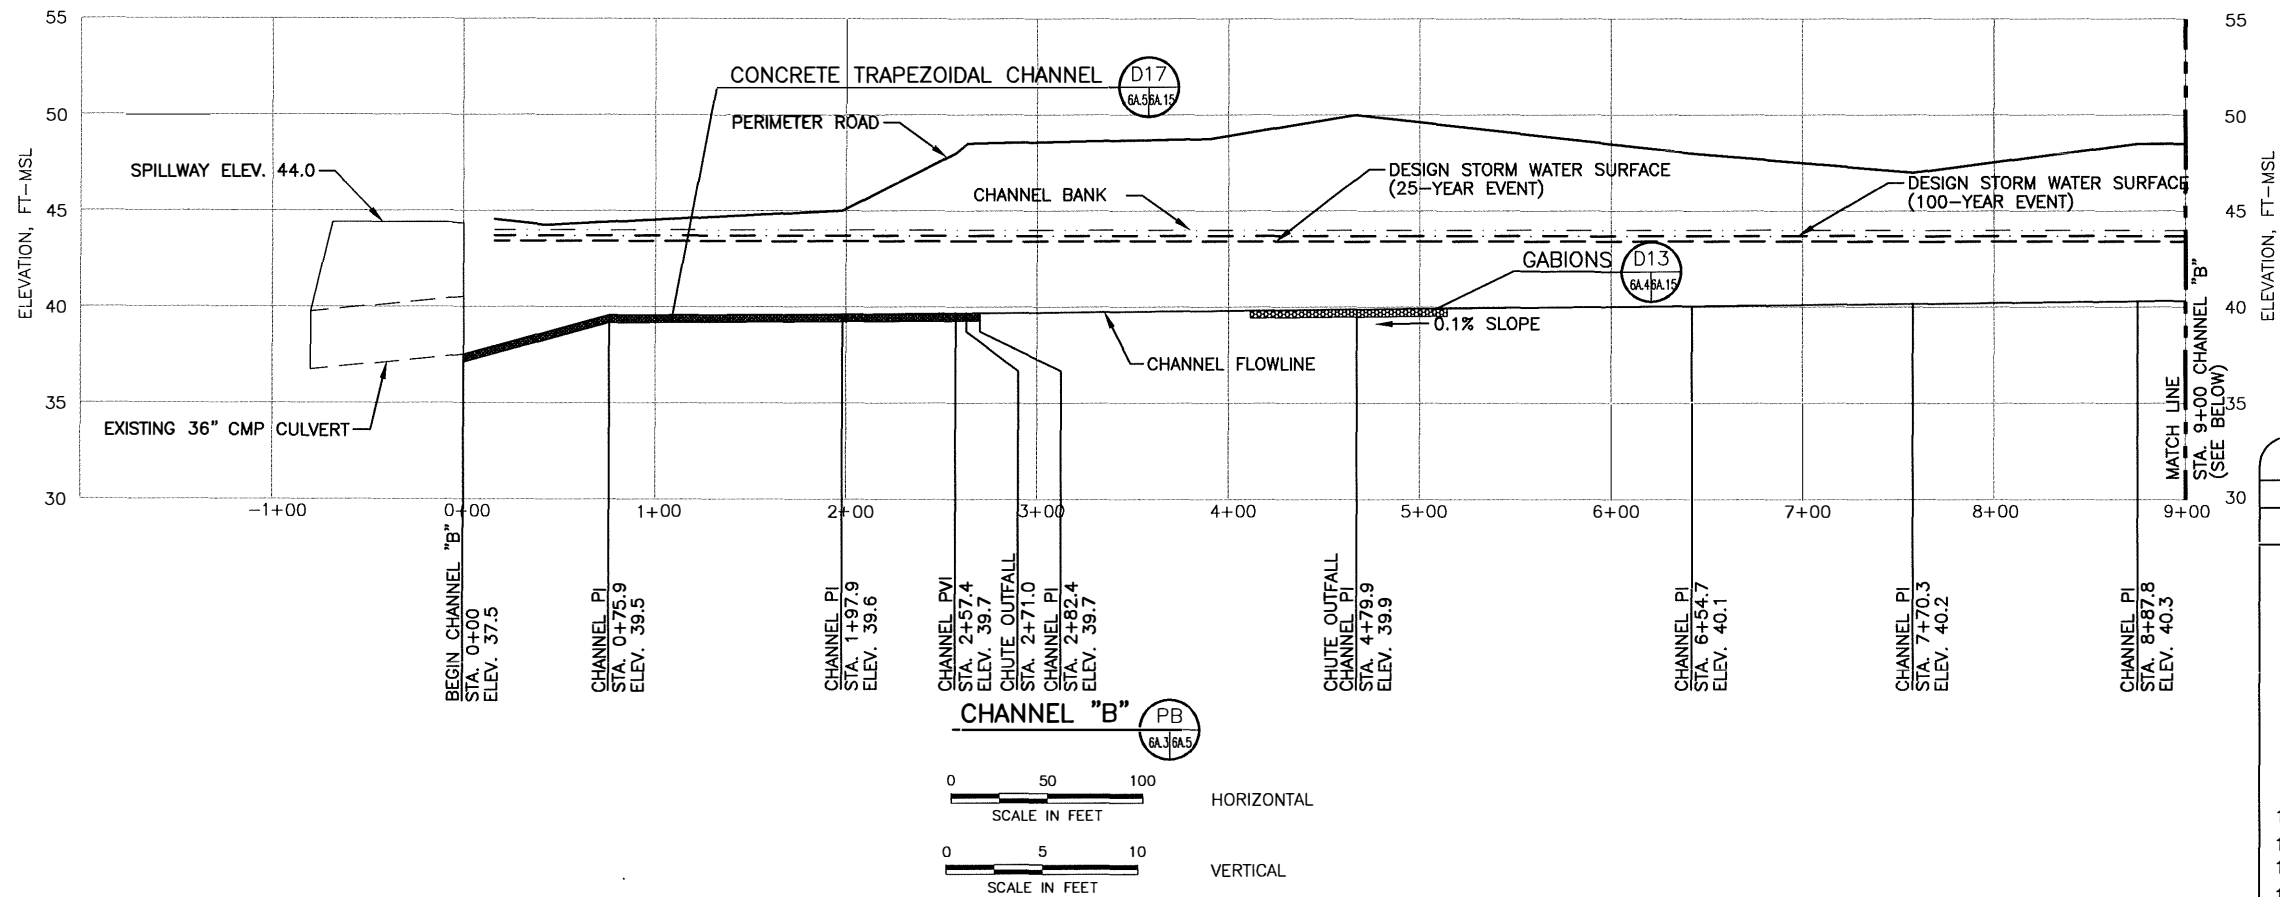

25-YEAR CHANNEL "B" INFORMATION							
CHANNEL	STATION	BOTTOM WIDTH (FT)	PEAK INFLOW (CFS)	SLOPE (%)	FLOW DEPTH (FT.)	VELOCITY (FT/S)	
	FROM TO						
	0+00	0+75.9	25	378	0.1	2.49	5.07
	0+75.9	1+97.9	25	378	0.1	2.49	5.07
	1+97.9	2+57.4	25	378	0.1	2.49	5.07
	2+57.4	2+82.4	25	113	0.1	1.23	3.35
	2+82.4	4+79.9	25	113	0.1	2.18	1.76
	4+79.9	6+54.7	25	37	0.1	1.13	1.20
	6+54.7	7+70.3	25	37	0.1	1.13	1.20
	7+70.3	8+87.8	25	37	0.1	1.13	1.20
	8+87.8	10+18.2	25	37	0.1	1.13	1.20
	10+18.2	11+30.4	25	37	0.1	1.13	1.20
	11+30.4	12+90.0	25	37	0.1	1.13	1.20
	12+90.0	14+68.0	25	37	0.1	1.13	1.20
	14+68.0	15+56.7	25	37	0.1	1.13	1.20
	15+56.7	16+46.5	25	37	0.1	1.13	1.20
	16+46.5	17+71.6	25	37	0.1	1.13	1.20

NOTE: NORMAL DEPTH CALCULATION DOES NOT ACCOUNT FOR BACK WATER WHICH WILL INCREASE FLOW DEPTH (SEE PROFILE) AND DECREASE VELOCITY.

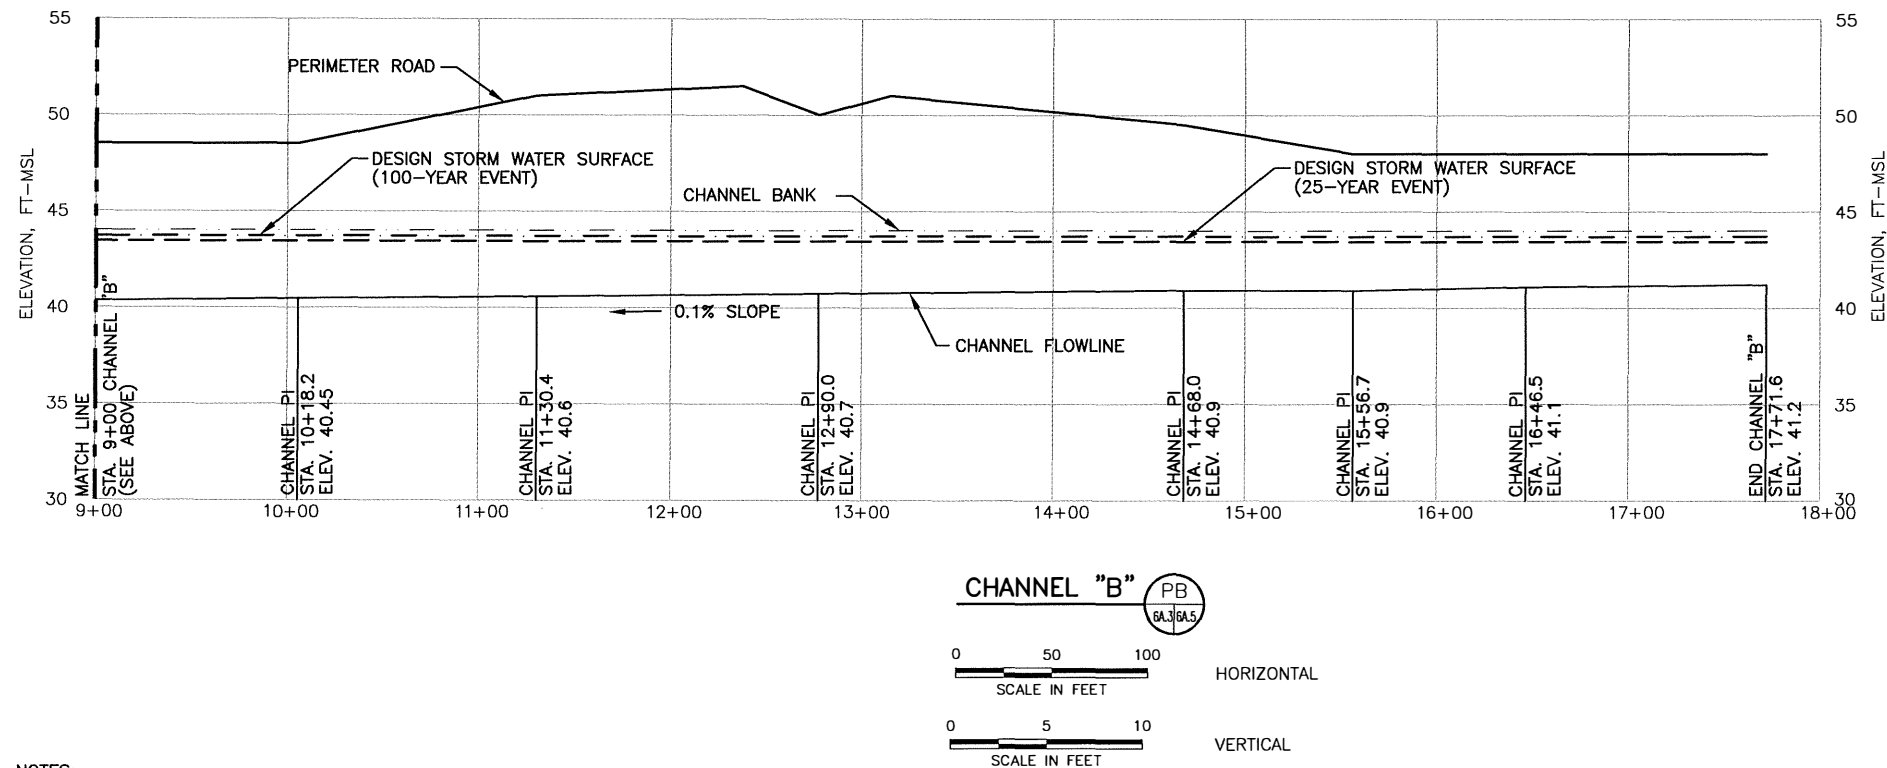

100-YEAR CHANNEL "B" INFORMATION						
CHANNEL STATION		BOTTOM WIDTH (FT)	PEAK INFLOW (CFS)	SLOPE (%)	FLOW DEPTH (FT.)	VELOCITY (FT/S)
FROM	TO					
0+00	0+75.9	25	525	0.1	3.00	5.65
0+75.9	1+97.9	25	525	0.1	3.00	5.65
1+97.9	2+57.4	25	525	0.1	3.00	5.65
2+57.4	2+82.4	25	159	0.1	1.50	3.78
2+82.4	4+79.9	25	159	0.1	2.66	1.98
4+79.9	6+54.7	25	54	0.1	1.42	1.37
6+54.7	7+70.3	25	54	0.1	1.42	1.37
7+70.3	8+87.8	25	54	0.1	1.42	1.37
8+87.8	10+18.2	25	54	0.1	1.42	1.37
10+18.2	11+30.4	25	54	0.1	1.42	1.37
11+30.4	12+90.0	25	54	0.1	1.42	1.37
12+90.0	14+68.0	25	54	0.1	1.42	1.37
14+68.0	15+56.7	25	54	0.1	1.42	1.37
15+56.7	16+46.5	25	54	0.1	1.42	1.37
16+46.5	17+71.6	25	54	0.1	1.42	1.37

NOTE: NORMAL DEPTH CALCULATION DOES NOT ACCOUNT FOR BACK WATER WHICH WILL INCREASE FLOW DEPTH (SEE PROFILE) AND DECREASE VELOCITY.




NOTES:

- REFER TO ATTACHMENT 6A.3 FOR PROFILE LOCATIONS.
- CONTOURS AND ELEVATIONS DEVELOPED BY BASE MAPPING FROM AERIAL PHOTOGRAPHY FLOWN FEBRUARY 18, 2003. THE GRID SYSTEM IS TIED TO THE TEXAS STATE PLANE COORDINATE SYSTEM SOUTH CENTRAL ZONE NAD 1927.
- HYDRAULIC CALCULATIONS INCLUDED IN ATTACHMENT 6A-B.

INDICATES REVISION (SEE LIST OF REVISIONS)

LIST OF REVISIONS:  
1. UPDATED CHANNEL INFORMATION.

<input type="checkbox"/> DRAFT <input checked="" type="checkbox"/> FOR PERMITTING PURPOSES ONLY <input type="checkbox"/> ISSUED FOR CONSTRUCTION	PREPARED FOR <b>McCARTY ROAD LANDFILL TX, LP</b>	MAJOR PERMIT AMENDMENT PERIMETER CHANNEL "B" PROFILE	
DATE: 03/2004 FILE: 0120-439-11 CAD: 6A.05-PROB.DWG	DRAWN BY: JDW DESIGN BY: SAN REVIEWED BY: JPY	McCARTY ROAD LANDFILL HARRIS COUNTY, TEXAS	
Weaver Consultants Group TBPE REGISTRATION NO. F-3727		WWW.WCGRP.COM	

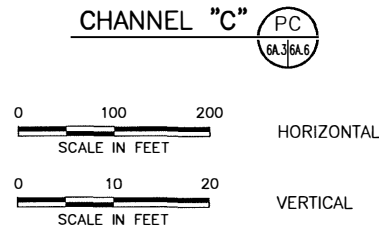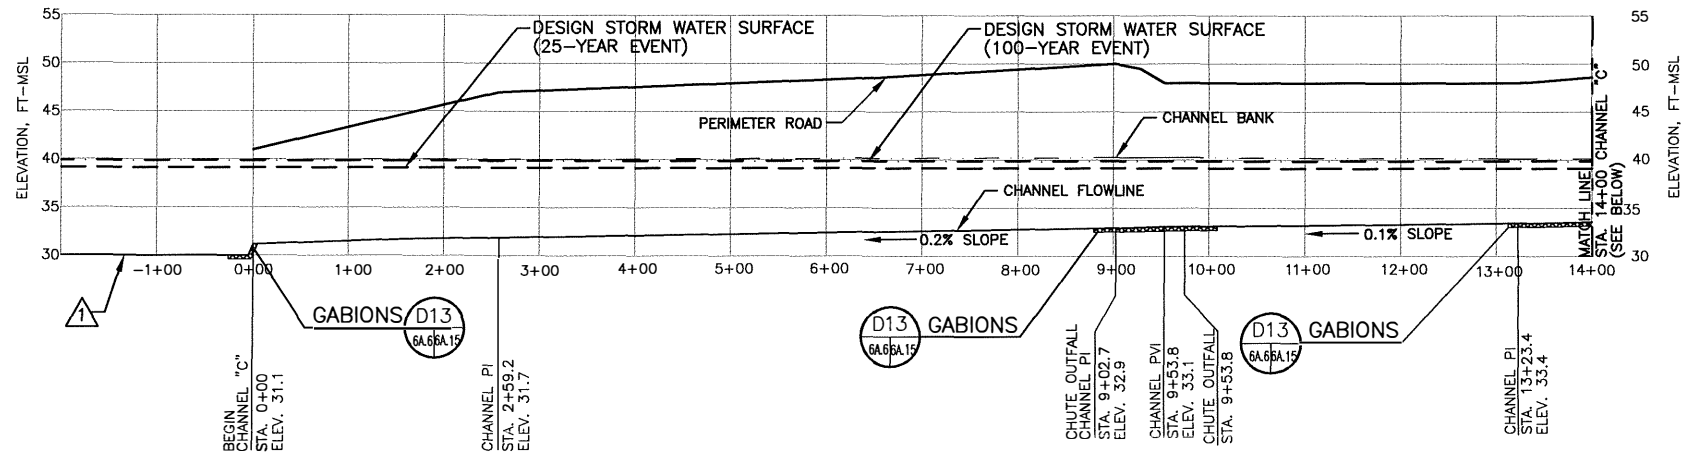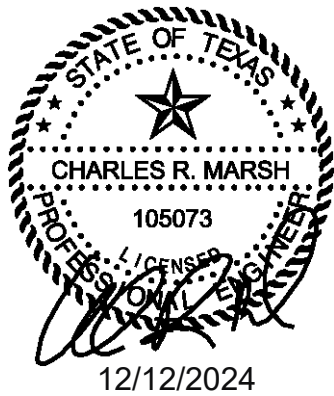

INDICATES REVISION  
(SEE LIST OF REVISIONS)



- LIST OF REVISIONS:
1. UPDATED POND DESIGNS.
  2. UPDATED CHANNEL INFORMATION.

25-YEAR CHANNEL "C" INFORMATION						
CHANNEL FROM	STATION TO	BOTTOM WIDTH (FT)	PEAK INFLOW (CFS)	SLOPE (%)	FLOW DEPTH (FT.)	VELOCITY (FT/S)
0+00	2+59.2	25	1090	0.2	6.38	4.53
2+59.2	9+02.7	25	1090	0.2	6.38	4.53
9+02.7	9+53.8	25	1090	0.2	6.38	4.53
9+53.8	13+23.4	25	654	0.1	5.84	3.05
13+23.4	15+88.8	15	654	0.1	4.29	6.46
15+88.8	18+16.4	15	654	0.1	4.29	6.46
18+16.4	19+38.4	15	654	0.1	4.29	6.46
19+38.4	20+20.0	15	654	0.1	4.29	6.46
20+20.0	20+92.2	15	375	0.1	5.35	2.72
20+92.2	21+86.1	15	375	0.1	5.35	2.72
21+86.1	33+48.8	15	375	0.1	5.35	2.72
33+48.8	39+47.8	15	29	0.1	1.31	1.26

NOTE: NORMAL DEPTH CALCULATION DOES NOT ACCOUNT FOR BACK WATER WHICH WILL INCREASE FLOW DEPTH (SEE PROFILE) AND DECREASE VELOCITY.

100-YEAR CHANNEL "C" INFORMATION						
CHANNEL FROM	STATION TO	BOTTOM WIDTH (FT)	PEAK INFLOW (CFS)	SLOPE (%)	FLOW DEPTH (FT.)	VELOCITY (FT/S)
0+00	2+59.2	25	1551	0.2	7.68	5.00
2+59.2	9+02.7	25	1551	0.2	7.68	5.00
9+02.7	9+53.8	25	1551	0.2	7.68	5.00
9+53.8	13+23.4	25	949	0.1	7.12	3.40
13+23.4	15+88.8	15	949	0.1	5.21	7.16
15+88.8	18+16.4	15	949	0.1	5.21	7.16
18+16.4	19+38.4	15	949	0.1	5.21	7.16
19+38.4	20+20.0	15	949	0.1	5.21	7.16
20+20.0	20+92.2	15	531	0.1	6.38	2.99
20+92.2	21+86.1	15	531	0.1	6.38	2.99
21+86.1	33+48.8	15	531	0.1	6.38	2.99
33+48.8	39+47.4	15	36	0.1	1.91	1.56

NOTE: NORMAL DEPTH CALCULATION DOES NOT ACCOUNT FOR BACK WATER WHICH WILL INCREASE FLOW DEPTH (SEE PROFILE) AND DECREASE VELOCITY.

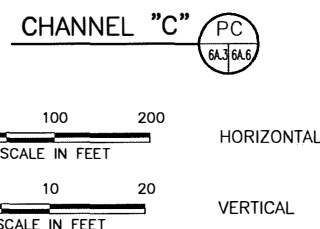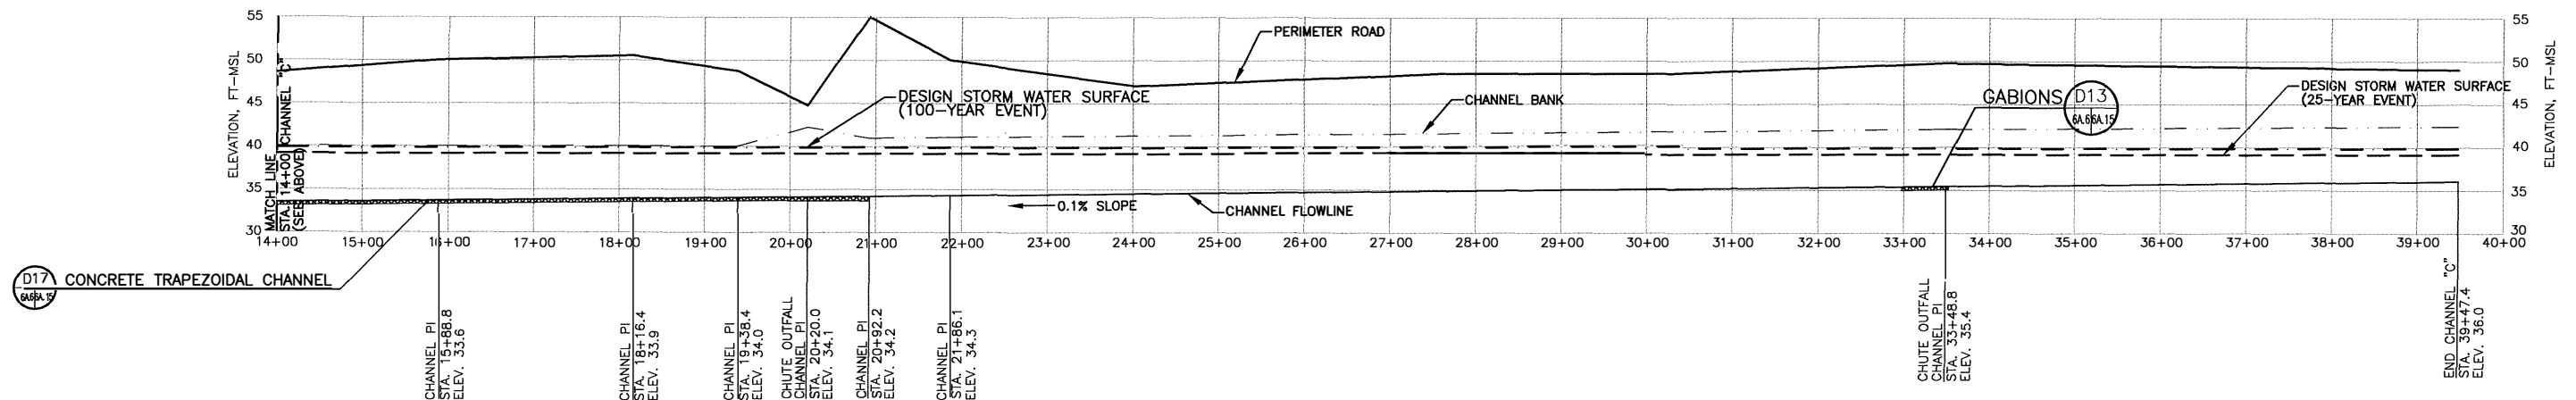

- NOTES:
1. REFER TO ATTACHMENT 6A.3 FOR PROFILE LOCATIONS.
  2. CONTOURS AND ELEVATIONS DEVELOPED BY BASE MAPPING FROM AERIAL PHOTOGRAPHY FLOWN FEBRUARY 18, 2003. THE GRID SYSTEM IS TIED TO THE TEXAS STATE PLANE COORDINATE SYSTEM SOUTH CENTRAL ZONE NAD 1927.
  3. HYDRAULIC CALCULATIONS INCLUDED IN ATTACHMENT 6A-B.


<input type="checkbox"/> DRAFT <input checked="" type="checkbox"/> FOR PERMITTING PURPOSES ONLY <input type="checkbox"/> ISSUED FOR CONSTRUCTION	PREPARED FOR <b>McCARTY ROAD LANDFILL TX, LP</b>	MAJOR PERMIT AMENDMENT PERIMETER CHANNEL "C" PROFILE	
DATE: 03/2004 FILE: 0120-439-11 CAD: 6A.06-PROC.DWG	DRAWN BY: JDW DESIGN BY: SAN REVIEWED BY: JPY	McCARTY ROAD LANDFILL HARRIS COUNTY, TEXAS	
Weaver Consultants Group TBPE REGISTRATION NO. F-3727		WWW.WCGRP.COM	

REVISIONS		
NO.	DATE	DESCRIPTION
1	01/2012	PERMIT MODIFICATION
2	12/2024	SEE LIST OF REVISIONS

ATTACHMENT 6A.6



0:\0120\439\FLIP MOD 2024\ATT 6\6A\6A.07-PROD.dwg, r.r.r.inglon, 1:200

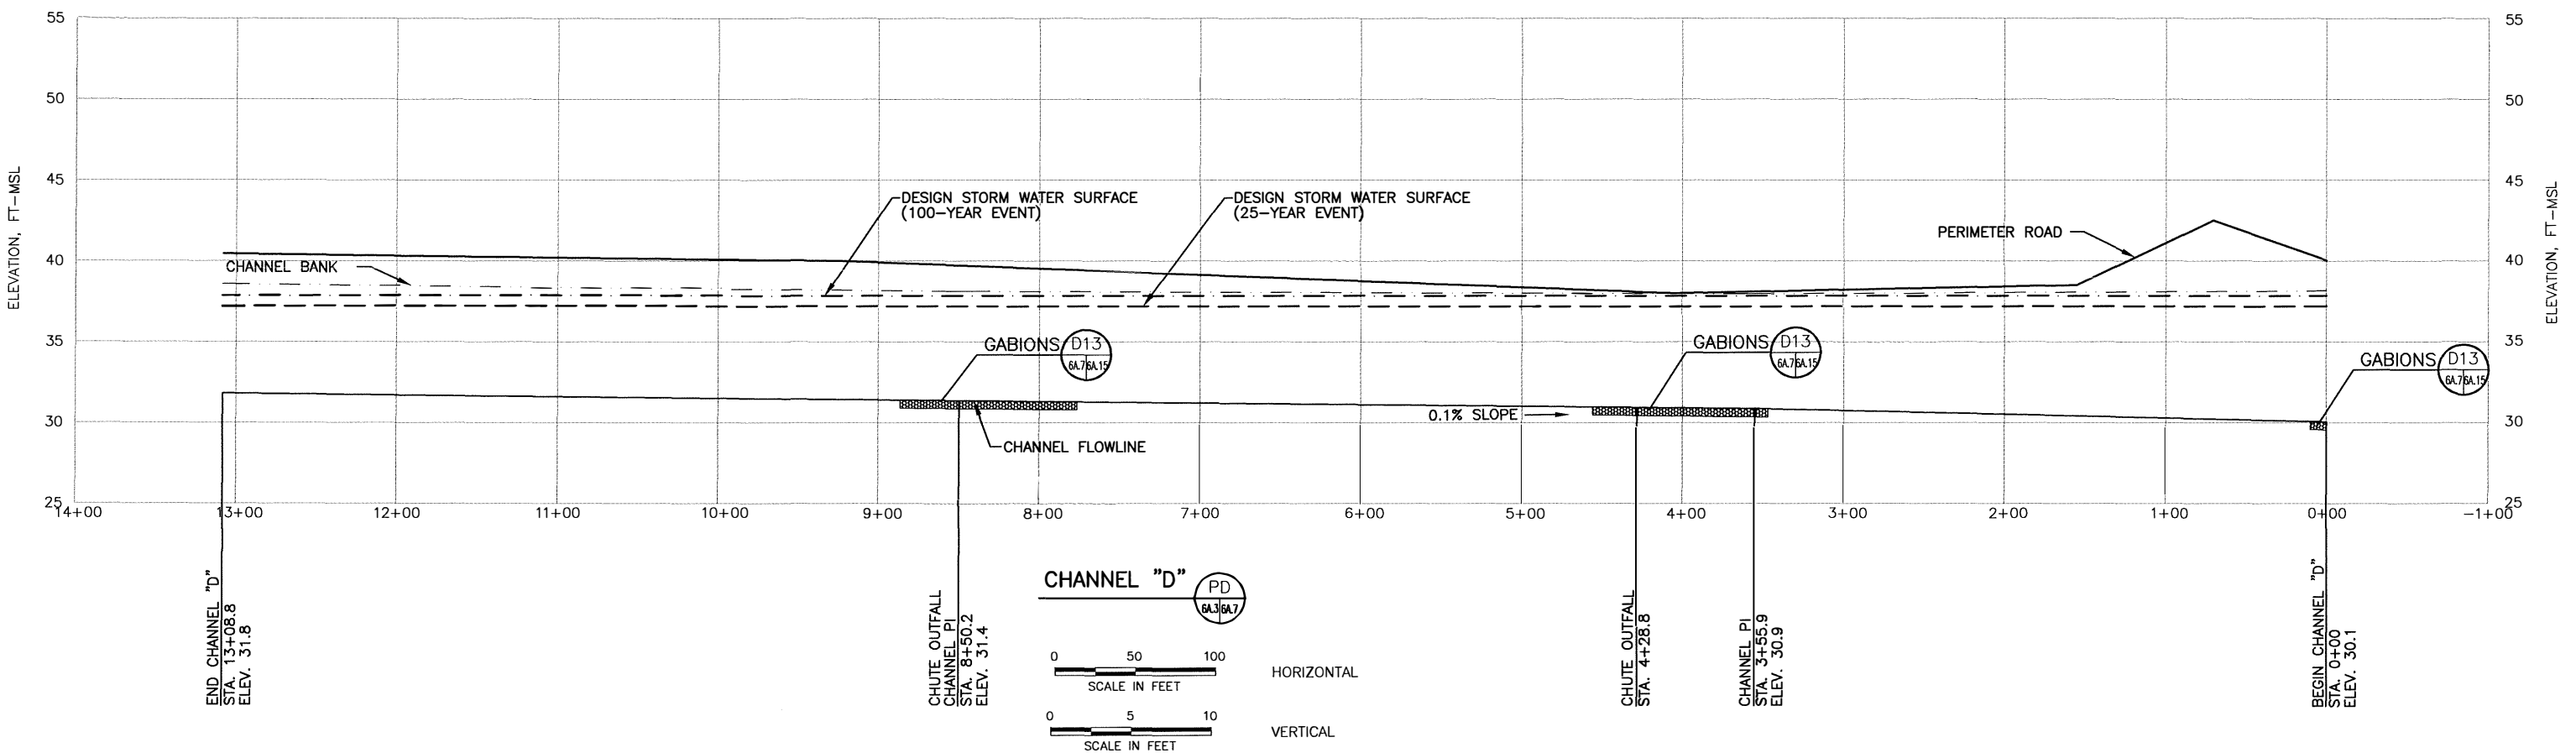

25-YEAR CHANNEL "D" INFORMATION						
CHANNEL STATION		BOTTOM WIDTH (FT)	PEAK INFLOW (CFS)	SLOPE (%)	FLOW DEPTH (FT.)	VELOCITY (FT/S)
FROM	TO					
0+00	3+55.9	15	452	0.1	5.41	2.67
3+55.9	8+50.2	10	265	0.1	4.68	2.36
8+50.2	13+08.8	15	29	0.1	1.28	1.21

NOTE: NORMAL DEPTH CALCULATION DOES NOT ACCOUNT FOR BACK WATER WHICH WILL INCREASE FLOW DEPTH (SEE PROFILE) AND DECREASE VELOCITY.


100-YEAR CHANNEL "D" INFORMATION						
CHANNEL STATION		BOTTOM WIDTH (FT)	PEAK INFLOW (CFS)	SLOPE (%)	FLOW DEPTH (FT.)	VELOCITY (FT/S)
FROM	TO					
0+00	3+55.9	15	649	0.1	6.43	2.94
3+55.9	8+50.2	10	371	0.1	5.47	2.57
8+50.2	13+08.8	15	40	0.1	1.53	1.34

NOTE: NORMAL DEPTH CALCULATION DOES NOT ACCOUNT FOR BACK WATER WHICH WILL INCREASE FLOW DEPTH (SEE PROFILE) AND DECREASE VELOCITY.



- NOTES:
- REFER TO ATTACHMENT 6A.3 FOR PROFILE LOCATIONS.
  - CONTOURS AND ELEVATIONS DEVELOPED BY BASE MAPPING FROM AERIAL PHOTOGRAPHY FLOWN FEBRUARY 18, 2003. THE GRID SYSTEM IS TIED TO THE TEXAS STATE PLANE COORDINATE SYSTEM SOUTH CENTRAL ZONE NAD 1927.
  - THE PEAK WATER SURFACE ELEVATION FOR PILOT CHANNEL "D" WAS TAKEN FROM THE PROPOSED HEC-1 ANALYSIS FOR SOUTH POND-2 IN ATTACHMENT 6A-B.
  - HYDRAULIC CALCULATIONS INCLUDED IN ATTACHMENT 6A-B.

INDICATES REVISION (SEE LIST OF REVISIONS)

- LIST OF REVISIONS:
- UPDATED CHANNEL INFORMATION.

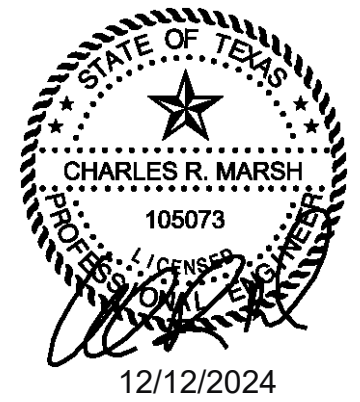

<input type="checkbox"/> DRAFT <input checked="" type="checkbox"/> FOR PERMITTING PURPOSES ONLY <input type="checkbox"/> ISSUED FOR CONSTRUCTION	PREPARED FOR <b>MCCARTY ROAD LANDFILL TX, LP</b>	MAJOR PERMIT AMENDMENT PERIMETER CHANNEL "D" PROFILE	
DATE: 03/2004 FILE: 0120-439-11 CAD: 6A.07-PROD.DWG	DRAWN BY: JDW DESIGN BY: SAN REVIEWED BY: JPY	McCARTY ROAD LANDFILL HARRIS COUNTY, TEXAS	
Weaver Consultants Group TBPE REGISTRATION NO. F-3727		REVISIONS NO. DATE DESCRIPTION 1 12/2024 SEE LIST OF REVISIONS	WWW.WCGRP.COM ATTACHMENT 6A.7

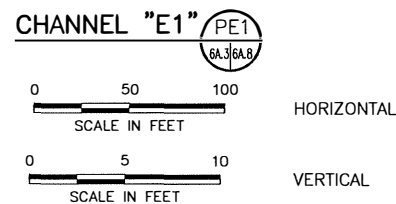
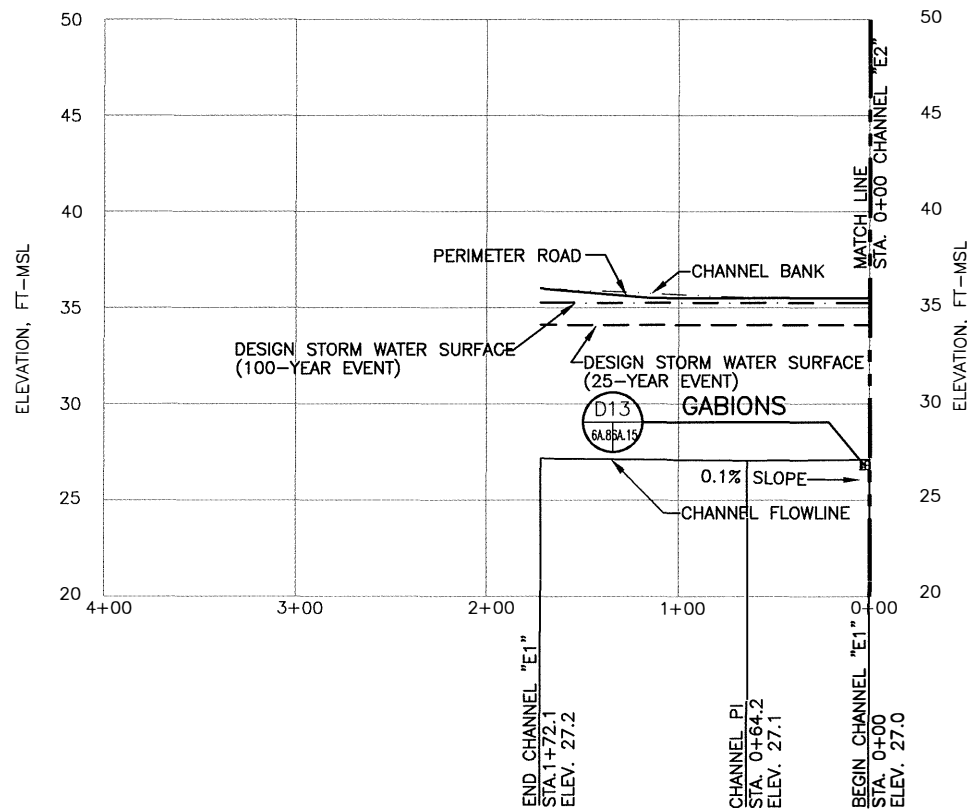


25-YEAR CHANNEL "E1" INFORMATION						
CHANNEL STATION		BOTTOM WIDTH (FT)	PEAK INFLOW (CFS)	SLOPE (%)	FLOW DEPTH (FT.)	VELOCITY (FT/S)
FROM	TO					
0+00	0+64.2	25	26	0.1	0.91	1.03
0+64.2	1+72.1	30	26	0.1	0.82	0.98

NOTE: NORMAL DEPTH CALCULATION DOES NOT ACCOUNT FOR BACK WATER WHICH WILL INCREASE FLOW DEPTH (SEE PROFILE) AND DECREASE VELOCITY.

100-YEAR CHANNEL "E1" INFORMATION						
CHANNEL STATION		BOTTOM WIDTH (FT)	PEAK INFLOW (CFS)	SLOPE (%)	FLOW DEPTH (FT.)	VELOCITY (FT/S)
FROM	TO					
0+00	0+64.2	25	37	0.1	1.12	1.17
0+64.2	1+72.1	30	37	0.1	1.01	1.11

NOTE: NORMAL DEPTH CALCULATION DOES NOT ACCOUNT FOR BACK WATER WHICH WILL INCREASE FLOW DEPTH (SEE PROFILE) AND DECREASE VELOCITY.

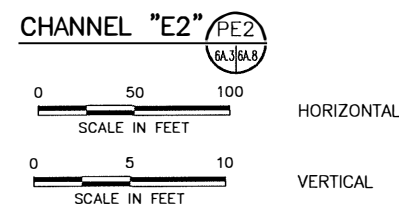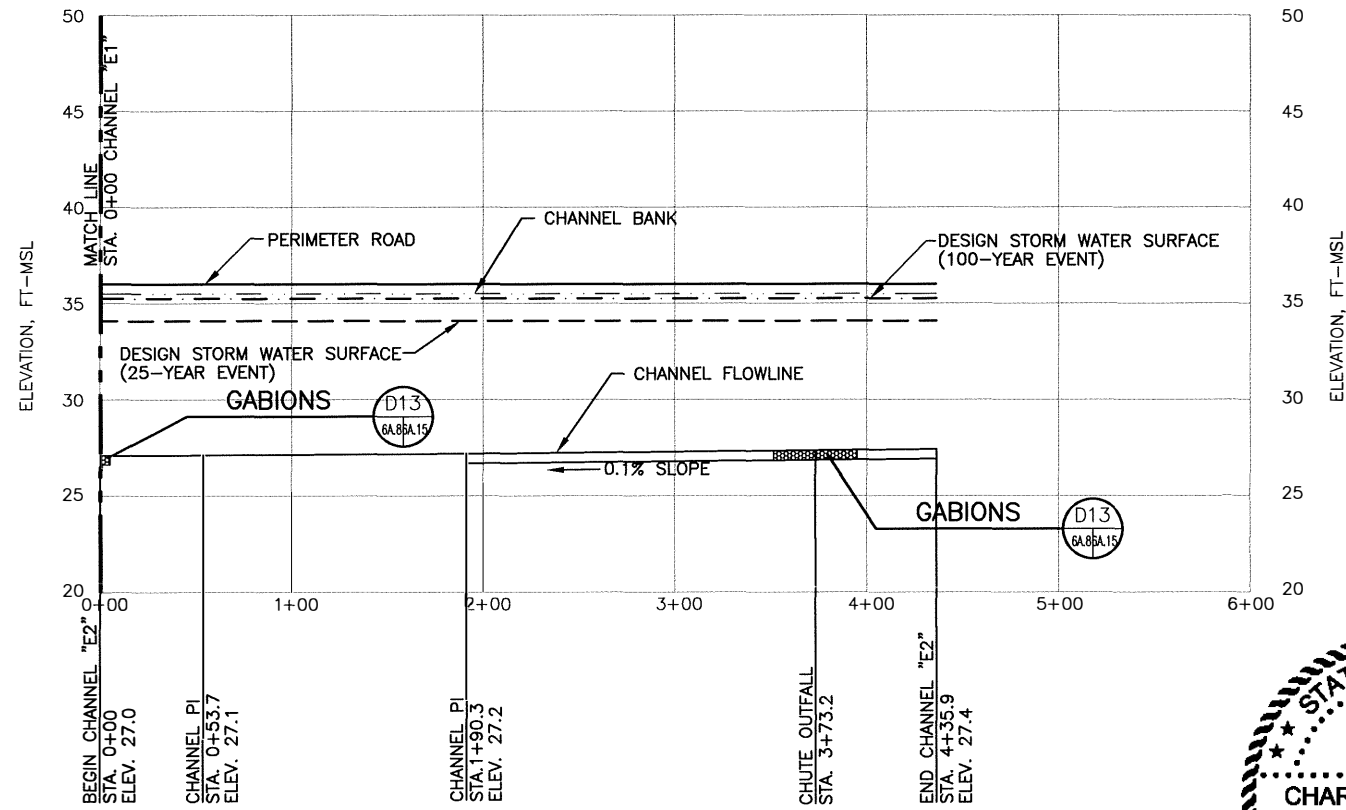


25-YEAR CHANNEL "E2" INFORMATION						
CHANNEL STATION		BOTTOM WIDTH (FT)	PEAK INFLOW (CFS)	SLOPE (%)	FLOW DEPTH (FT.)	VELOCITY (FT/S)
FROM	TO					
0+00	0+53.6	25	318	0.1	3.76	2.33
0+53.6	1+90.3	35	318	0.1	3.21	2.22
1+90.3	4+35.9	45	318	0.1	2.82	2.11

NOTE: NORMAL DEPTH CALCULATION DOES NOT ACCOUNT FOR BACK WATER WHICH WILL INCREASE FLOW DEPTH (SEE PROFILE) AND DECREASE VELOCITY.

100-YEAR CHANNEL "E2" INFORMATION						
CHANNEL STATION		BOTTOM WIDTH (FT)	PEAK INFLOW (CFS)	SLOPE (%)	FLOW DEPTH (FT.)	VELOCITY (FT/S)
FROM	TO					
0+00	0+53.6	25	442	0.1	4.48	2.57
0+53.6	1+90.3	35	442	0.1	3.86	2.46
1+90.3	4+35.9	45	442	0.1	3.41	2.35

NOTE: NORMAL DEPTH CALCULATION DOES NOT ACCOUNT FOR BACK WATER WHICH WILL INCREASE FLOW DEPTH (SEE PROFILE) AND DECREASE VELOCITY.

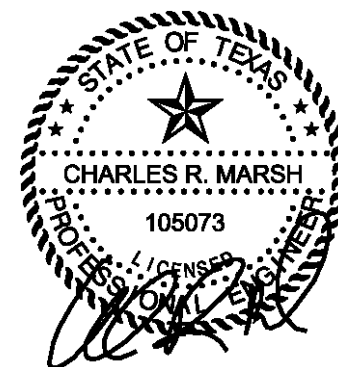

12/12/2024



INDICATES REVISION (SEE LIST OF REVISIONS)

LIST OF REVISIONS:  
1. UPDATED CHANNEL INFORMATION.

NOTES:


- REFER TO ATTACHMENT 6A.3 FOR PROFILE LOCATIONS.
- CONTOURS AND ELEVATIONS DEVELOPED BY BASE MAPPING FROM AERIAL PHOTOGRAPHY FLOWN FEBRUARY 18, 2003. THE GRID SYSTEM IS TIED TO THE TEXAS STATE PLANE COORDINATE SYSTEM SOUTH CENTRAL ZONE NAD 1927.
- HYDRAULIC CALCULATIONS INCLUDED IN ATTACHMENT 6A-B.

<input type="checkbox"/> DRAFT <input checked="" type="checkbox"/> FOR PERMITTING PURPOSES ONLY <input type="checkbox"/> ISSUED FOR CONSTRUCTION	PREPARED FOR <b>McCARTY ROAD LANDFILL TX, LP</b>	MAJOR PERMIT AMENDMENT PERIMETER CHANNEL "E" PROFILE	
DATE: 03/2004 FILE: 0120-439-11 CAD: 6A.08-PROE.DWG	DRAWN BY: JOW DESIGN BY: SAN REVIEWED BY: JPY	McCARTY ROAD LANDFILL HARRIS COUNTY, TEXAS	
Weaver Consultants Group TBPE REGISTRATION NO. F-3727		WWW.WCGRP.COM	

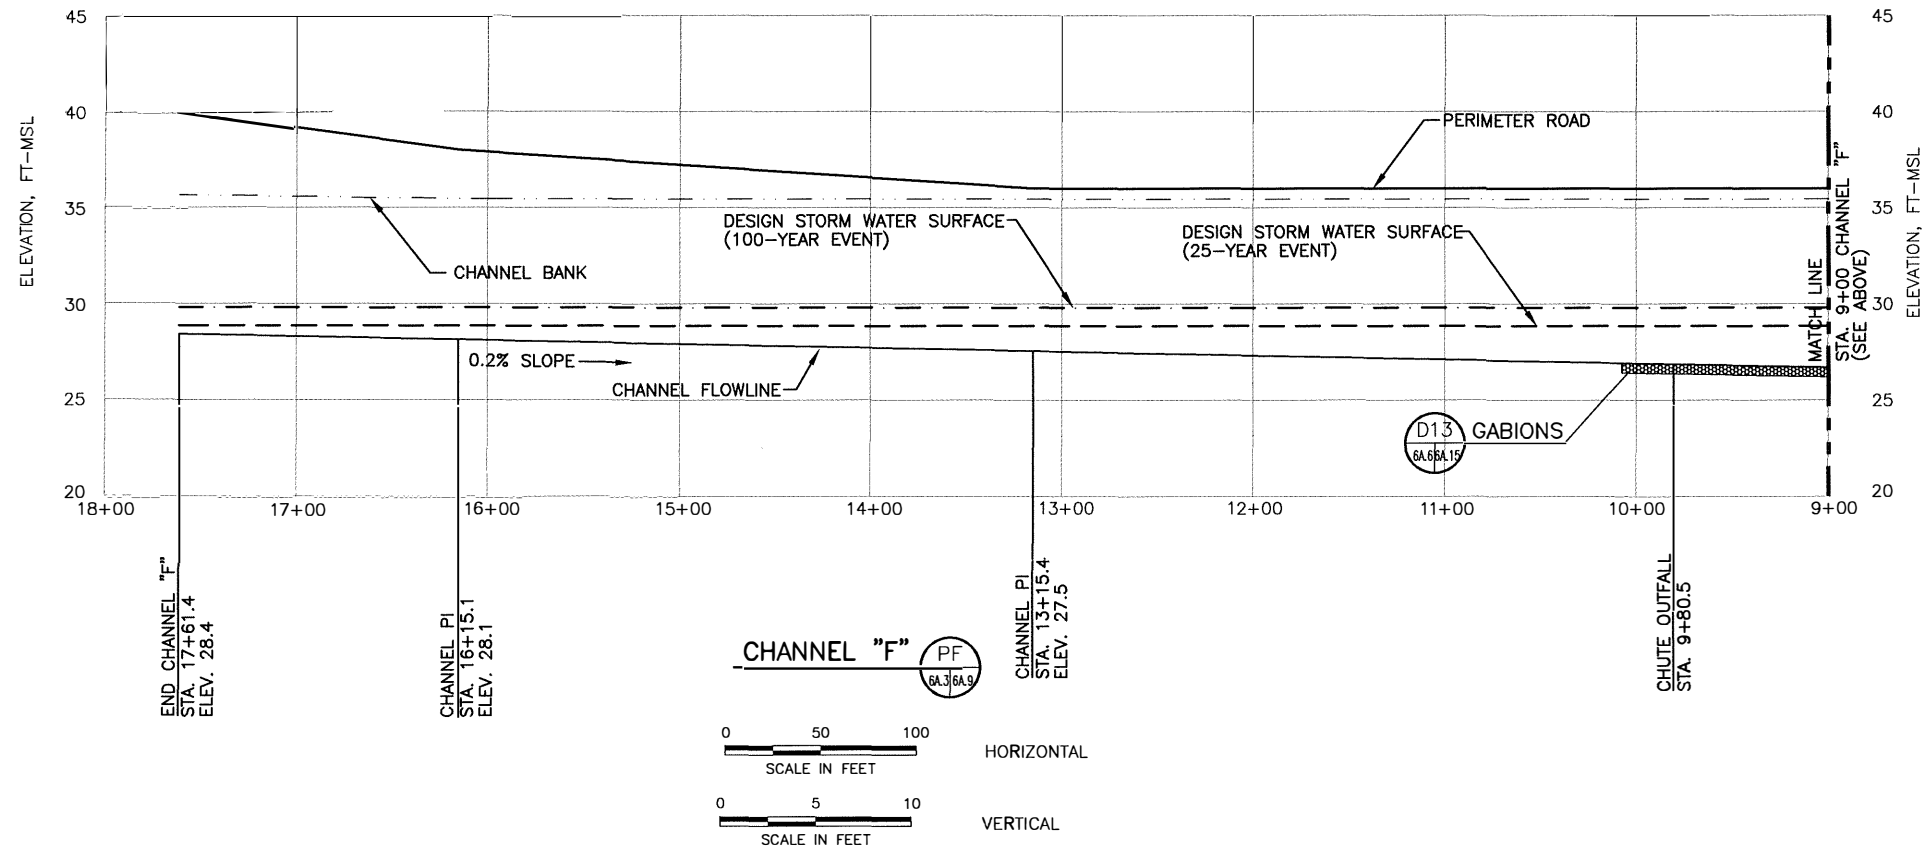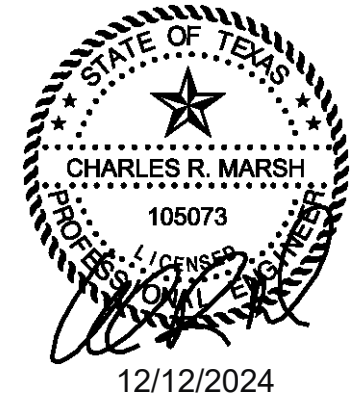

25-YEAR CHANNEL "F" INFORMATION						
CHANNEL STATION		BOTTOM WIDTH (FT)	PEAK INFLOW (CFS)	SLOPE (%)	FLOW DEPTH (FT.)	VELOCITY (FT/S)
FROM	TO					
0+00	1+39.9	35	594	0.2	3.81	3.50
1+39.9	3+65.4	20	221	0.2	2.88	2.82
3+65.4	6+33.8	15	221	0.2	3.27	2.91
6+33.8	13+15.4	15	35	0.2	1.18	1.65
13+15.4	16+15.1	12	35	0.2	1.32	1.73
16+15.1	17+61.4	12	35	0.2	1.32	1.73

NOTE: NORMAL DEPTH CALCULATION DOES NOT ACCOUNT FOR BACK WATER WHICH WILL INCREASE FLOW DEPTH (SEE PROFILE) AND DECREASE VELOCITY.

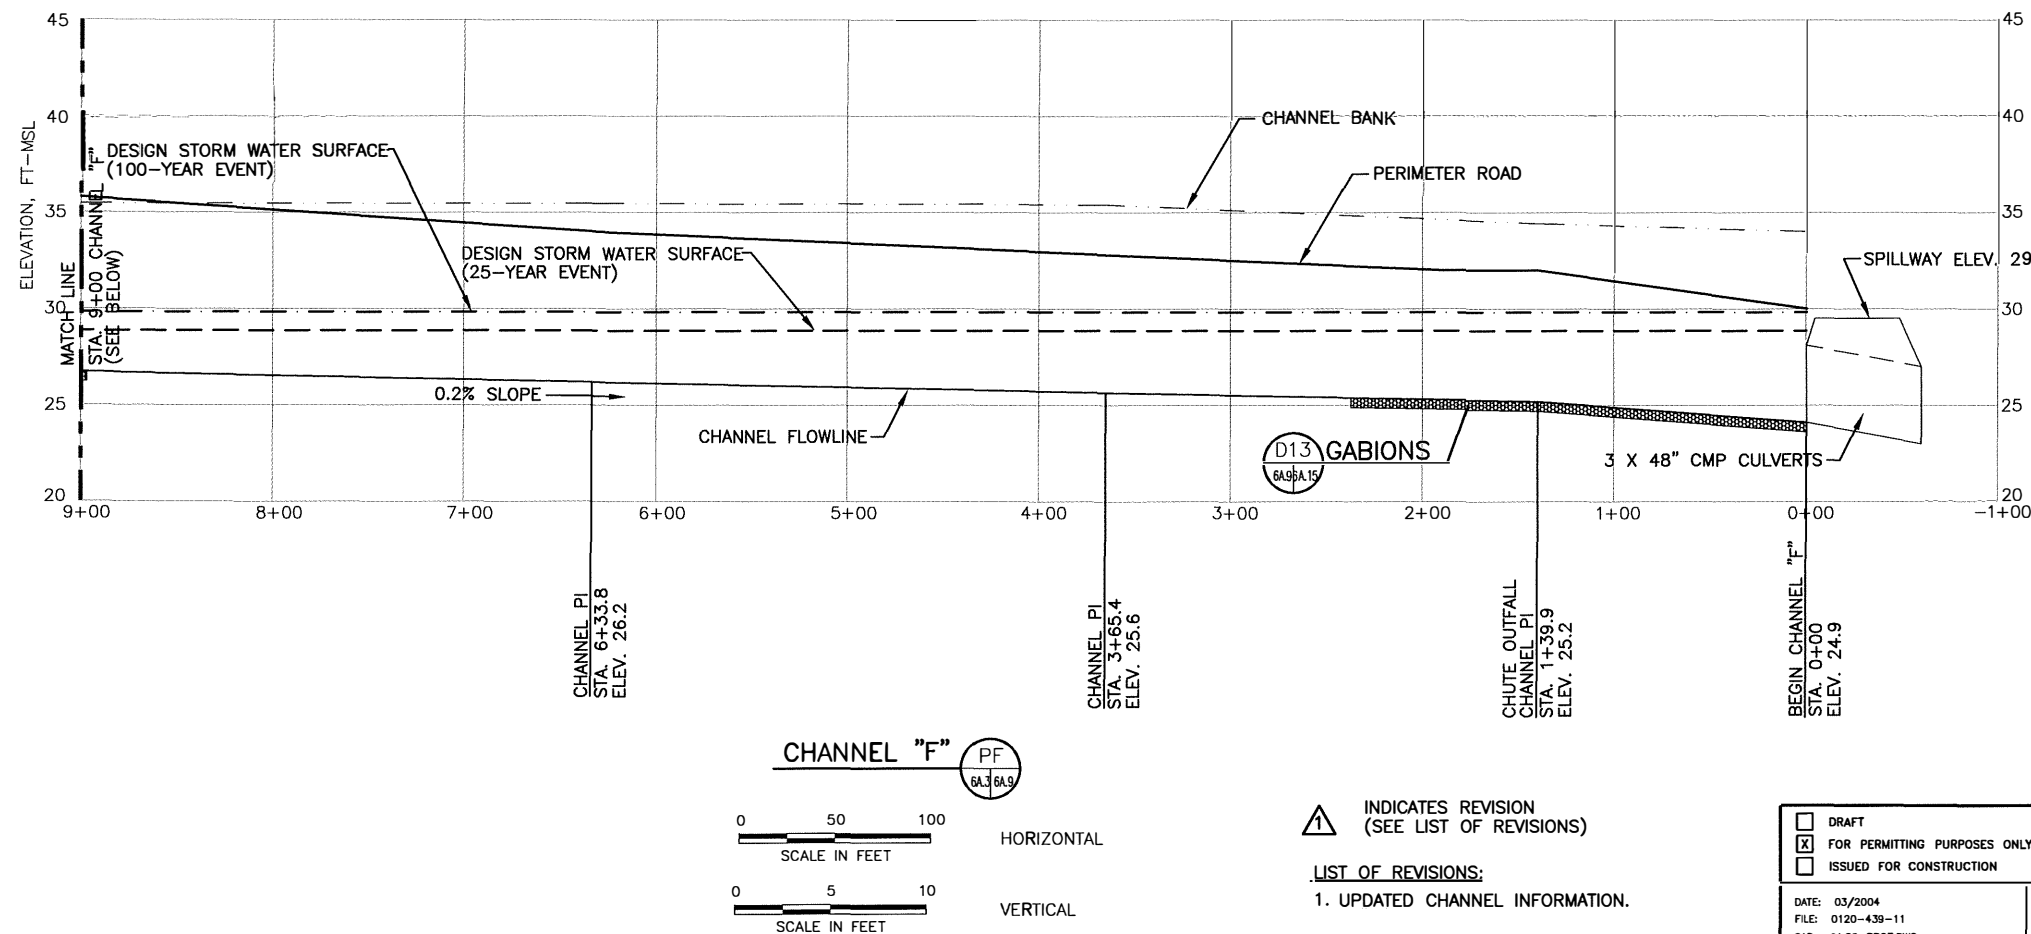

100-YEAR CHANNEL "F" INFORMATION						
CHANNEL STATION		BOTTOM WIDTH (FT)	PEAK INFLOW (CFS)	SLOPE (%)	FLOW DEPTH (FT.)	VELOCITY (FT/S)
FROM	TO					
0+00	1+39.9	35	817	0.2	4.56	3.86
1+39.9	3+65.4	20	817	0.2	5.78	4.11
3+65.4	6+33.8	15	817	0.2	6.35	3.20
6+33.8	13+15.4	15	50	0.2	1.45	1.85
13+15.4	16+15.1	12	50	0.2	1.62	1.93
16+15.1	17+61.4	12	50	0.2	1.62	1.93

NOTE: NORMAL DEPTH CALCULATION DOES NOT ACCOUNT FOR BACK WATER WHICH WILL INCREASE FLOW DEPTH (SEE PROFILE) AND DECREASE VELOCITY.

NOTES:

- REFER TO ATTACHMENT 6A.3 FOR PROFILE LOCATIONS.
- CONTOURS AND ELEVATIONS DEVELOPED BY BASE MAPPING FROM AERIAL PHOTOGRAPHY FLOWN FEBRUARY 18, 2003. THE GRID SYSTEM IS TIED TO THE TEXAS STATE PLANE COORDINATE SYSTEM SOUTH CENTRAL ZONE NAD 1927.
- HYDRAULIC CALCULATIONS INCLUDED IN ATTACHMENT 6A-B.


INDICATES REVISION (SEE LIST OF REVISIONS)

LIST OF REVISIONS:  
1. UPDATED CHANNEL INFORMATION.

<input type="checkbox"/> DRAFT <input checked="" type="checkbox"/> FOR PERMITTING PURPOSES ONLY <input type="checkbox"/> ISSUED FOR CONSTRUCTION	PREPARED FOR <b>McCARTY ROAD LANDFILL TX, LP</b>	MAJOR PERMIT AMENDMENT PERIMETER CHANNEL "F" PROFILE		
DATE: 03/2004 FILE: 0120-439-11 CAD: 6A.09-PROF.DWG	DRAWN BY: JDW DESIGN BY: SAN REVIEWED BY: JPY	REVISIONS		
		NO.	DATE	DESCRIPTION
		1	12/2024	SEE LIST OF REVISIONS
<b>Weaver Consultants Group</b> TBPE REGISTRATION NO. F-3727				
		WWW.WCGRP.COM		
		ATTACHMENT 6A.9		





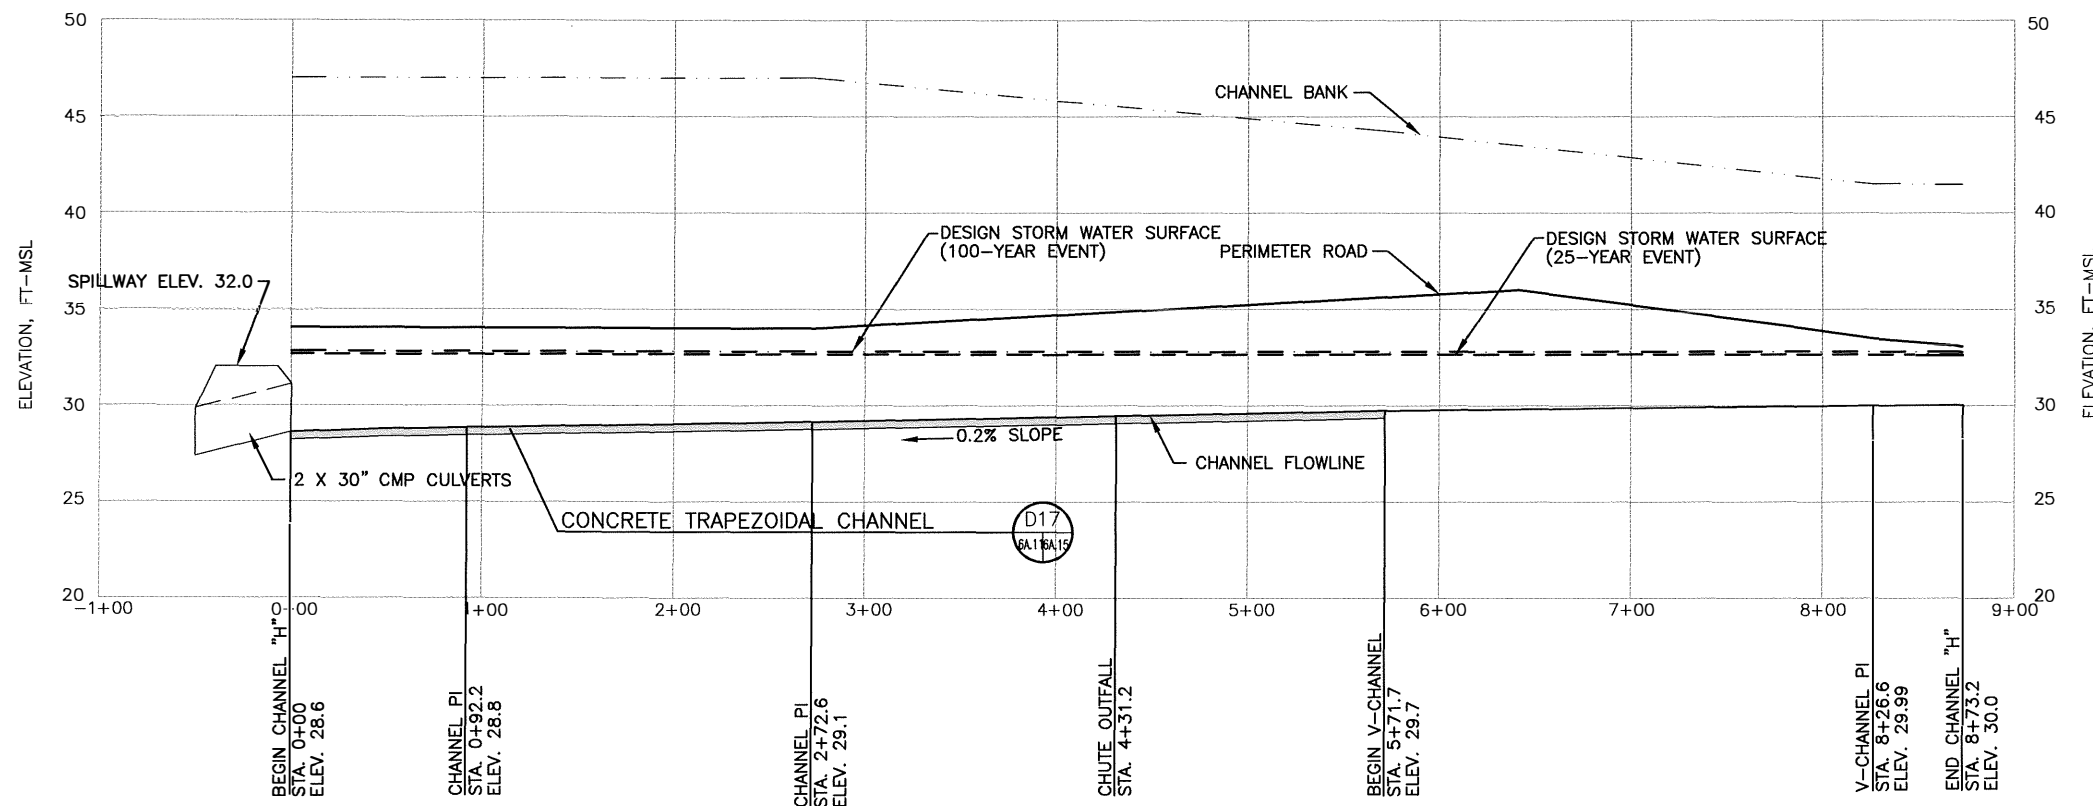

CHANNEL "H" PH  
6A.3FA11

0 50 100  
SCALE IN FEET  
HORIZONTAL

0 5 10  
SCALE IN FEET  
VERTICAL



INDICATES REVISION  
(SEE LIST OF REVISIONS)

LIST OF REVISIONS:  
1. UPDATED CHANNEL  
INFORMATION.

25-YEAR CHANNEL "H" INFORMATION						
CHANNEL STATION		BOTTOM WIDTH (FT)	PEAK INFLOW (CFS)	SLOPE (%)	FLOW DEPTH (FT.)	VELOCITY (FT/S)
FROM	TO					
0+00	0+48.6	12	270	0.2	2.31	6.17
0+48.6	2+72.9	12	270	0.2	2.31	6.17
2+72.9	5+71.7	12	270	0.2	2.31	6.17
5+71.7	8+26.6	0	25	0.2	2.21	1.71
8+26.6	8+73.2	0	25	0.2	2.21	1.71

NOTE: NORMAL DEPTH CALCULATION DOES NOT ACCOUNT FOR BACK WATER WHICH WILL INCREASE FLOW DEPTH (SEE PROFILE) AND DECREASE VELOCITY.

100-YEAR CHANNEL "H" INFORMATION						
CHANNEL STATION		BOTTOM WIDTH (FT)	PEAK INFLOW (CFS)	SLOPE (%)	FLOW DEPTH (FT.)	VELOCITY (FT/S)
FROM	TO					
0+00	0+48.6	12	374	0.2	2.74	6.76
0+48.6	2+72.6	12	374	0.2	2.74	6.76
2+72.6	5+71.7	12	374	0.2	2.74	6.76
5+71.7	8+26.6	0	35	0.2	2.50	1.86
8+26.6	8+73.2	0	35	0.2	2.50	1.86

NOTE: NORMAL DEPTH CALCULATION DOES NOT ACCOUNT FOR BACK WATER WHICH WILL INCREASE FLOW DEPTH (SEE PROFILE) AND DECREASE VELOCITY.

#### NOTES:

- REFER TO ATTACHMENT 6A.3 FOR PROFILE LOCATIONS.
- CONTOURS AND ELEVATIONS DEVELOPED BY BASE MAPPING FROM AERIAL PHOTOGRAPHY FLOWN FEBRUARY 18, 2003. THE GRID SYSTEM IS TIED TO THE TEXAS STATE PLANE COORDINATE SYSTEM SOUTH CENTRAL ZONE NAD 1927.
- HYDRAULIC CALCULATIONS INCLUDED IN ATTACHMENT 6A-B.

☐ DRAFT  
☒ FOR PERMITTING PURPOSES ONLY  
☐ ISSUED FOR CONSTRUCTION

DATE: 03/2004  
FILE: 0120-439-11  
CAD: 6A.11-PROH.DWG

DRAWN BY: JOW  
DESIGN BY: SAN  
REVIEWED BY: JPY

Weaver Consultants Group  
TBPE REGISTRATION NO. F-3727

PREPARED FOR  
McCARTY ROAD LANDFILL TX, LP

REVISIONS		
NO.	DATE	DESCRIPTION
1	12/2024	SEE LIST OF REVISIONS

MAJOR PERMIT AMENDMENT  
PERIMETER CHANNEL "H" PROFILE


McCARTY ROAD LANDFILL  
HARRIS COUNTY, TEXAS

WWW.WCGRP.COM

ATTACHMENT 6A.11



O:\0120\439\FLIP MOD 2024\ATT 6\6A\6A.12-PROJ.dwg, rarrington, 1:200

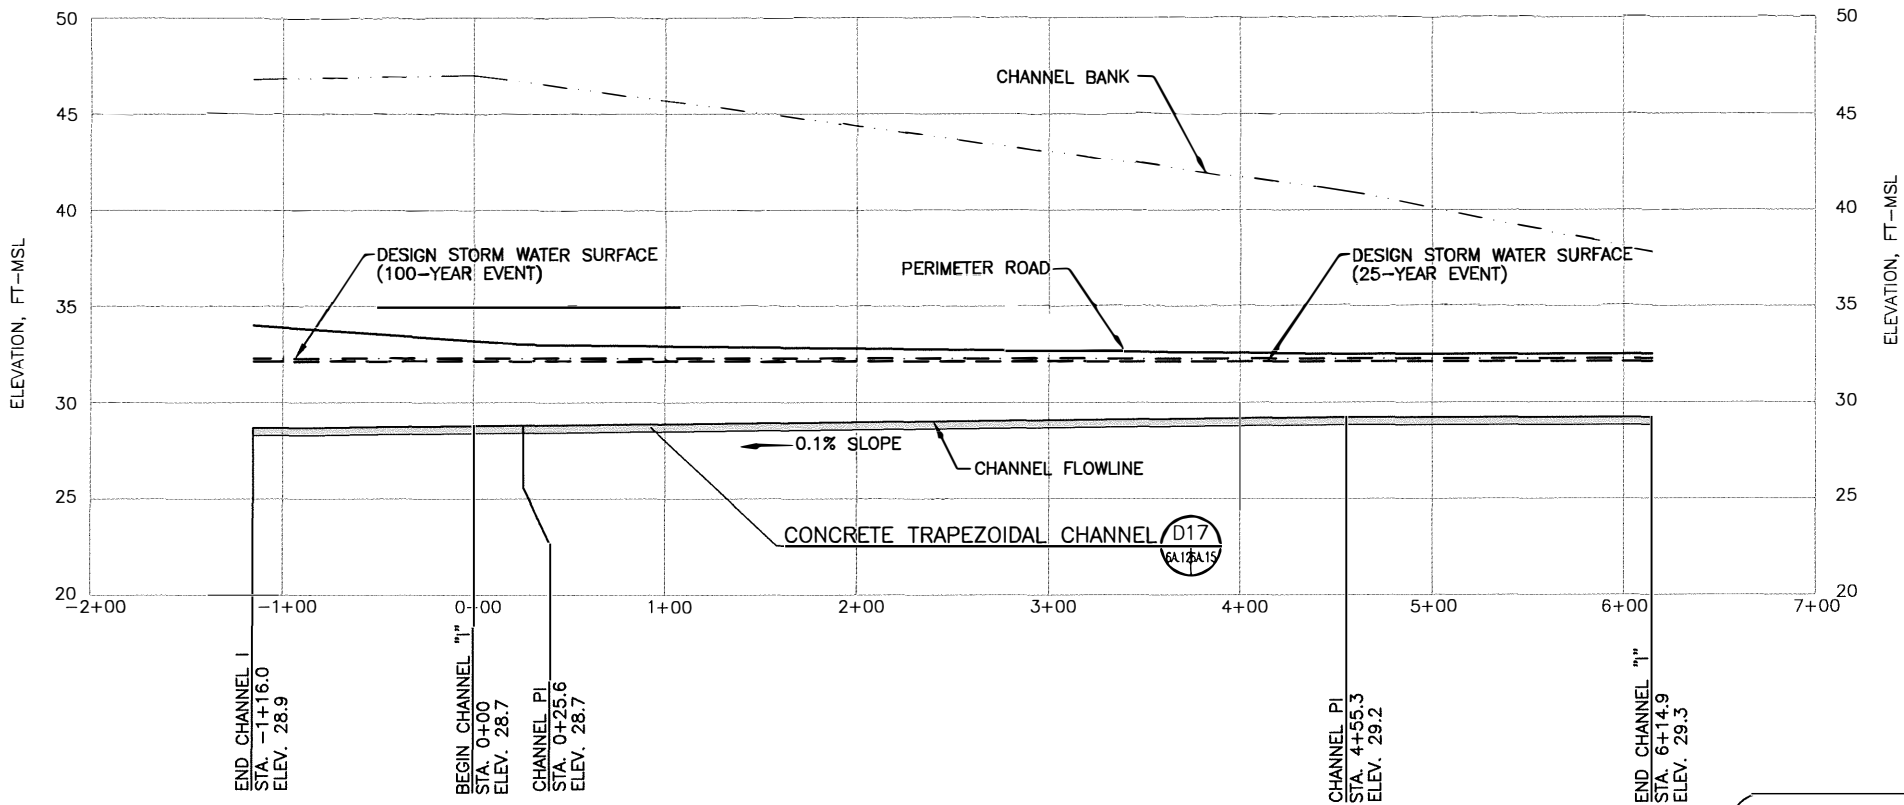

CHANNEL "I" PI  
6A.12A.15

0 50 100  
SCALE IN FEET

HORIZONTAL

0 5 10  
SCALE IN FEET

VERTICAL



INDICATES REVISION  
(SEE LIST OF REVISIONS)

LIST OF REVISIONS:

1. UPDATED CHANNEL  
INFORMATION.

25-YEAR CHANNEL "I" INFORMATION						
CHANNEL STATION		BOTTOM WIDTH (FT)	PEAK INFLOW 25-YEAR (CFS)	SLOPE (%)	FLOW DEPTH (FT.)	VELOCITY (FT/S)
FROM	TO					
-1+16.0	0+00	0	41	0.1	2.09	3.12
0+00	0+25.6	0	41	0.1	2.09	3.12
0+25.6	4+55.3	0	41	0.1	2.09	3.12
4+55.3	6+14.9	0	41	0.1	2.09	3.12

NOTE: NORMAL DEPTH CALCULATION DOES NOT ACCOUNT FOR BACK WATER WHICH  
WILL INCREASE FLOW DEPTH (SEE PROFILE) AND DECREASE VELOCITY.

100-YEAR CHANNEL "I" INFORMATION						
CHANNEL STATION		BOTTOM WIDTH (FT)	PEAK INFLOW 25-YEAR (CFS)	SLOPE (%)	FLOW DEPTH (FT.)	VELOCITY (FT/S)
FROM	TO					
-1+16.0	0+00	0	50	0.1	2.26	3.28
0+00	0+25.6	0	50	0.1	2.26	3.28
0+25.6	4+55.3	0	50	0.1	2.26	3.28
4+55.3	6+14.9	0	50	0.1	2.26	3.28



NOTE: NORMAL DEPTH CALCULATION DOES NOT ACCOUNT FOR BACK WATER WHICH  
WILL INCREASE FLOW DEPTH (SEE PROFILE) AND DECREASE VELOCITY.



NOTES:





- REFER TO ATTACHMENT 6A.3 FOR PROFILE LOCATIONS.
- CONTOURS AND ELEVATIONS DEVELOPED BY BASE  
MAPPING FROM AERIAL PHOTOGRAPHY FLOWN  
FEBRUARY 18, 2003. THE GRID SYSTEM IS  
TIED TO THE TEXAS STATE PLANE COORDINATE SYSTEM  
SOUTH CENTRAL ZONE NAD 1927.
- HYDRAULIC CALCULATIONS INCLUDED IN ATTACHMENT 6A-B.

<input type="checkbox"/> DRAFT <input checked="" type="checkbox"/> FOR PERMITTING PURPOSES ONLY <input type="checkbox"/> ISSUED FOR CONSTRUCTION	PREPARED FOR <b>McCARTY ROAD LANDFILL TX, LP</b>	MAJOR PERMIT AMENDMENT PERIMETER CHANNEL "I" PROFILE		
DATE: 03/2004 FILE: 0120-439-11 CAD: 6A.12-PROLDWG	DRAWN BY: JOW DESIGN BY: SAN REVIEWED BY: JPY	REVISIONS		
		NO.	DATE	DESCRIPTION
		1	12/2024	SEE LIST OF REVISIONS
<b>Weaver Consultants Group</b> TBPE REGISTRATION NO. F-3727				
		WWW.WCGRP.COM		ATTACHMENT 6A.12

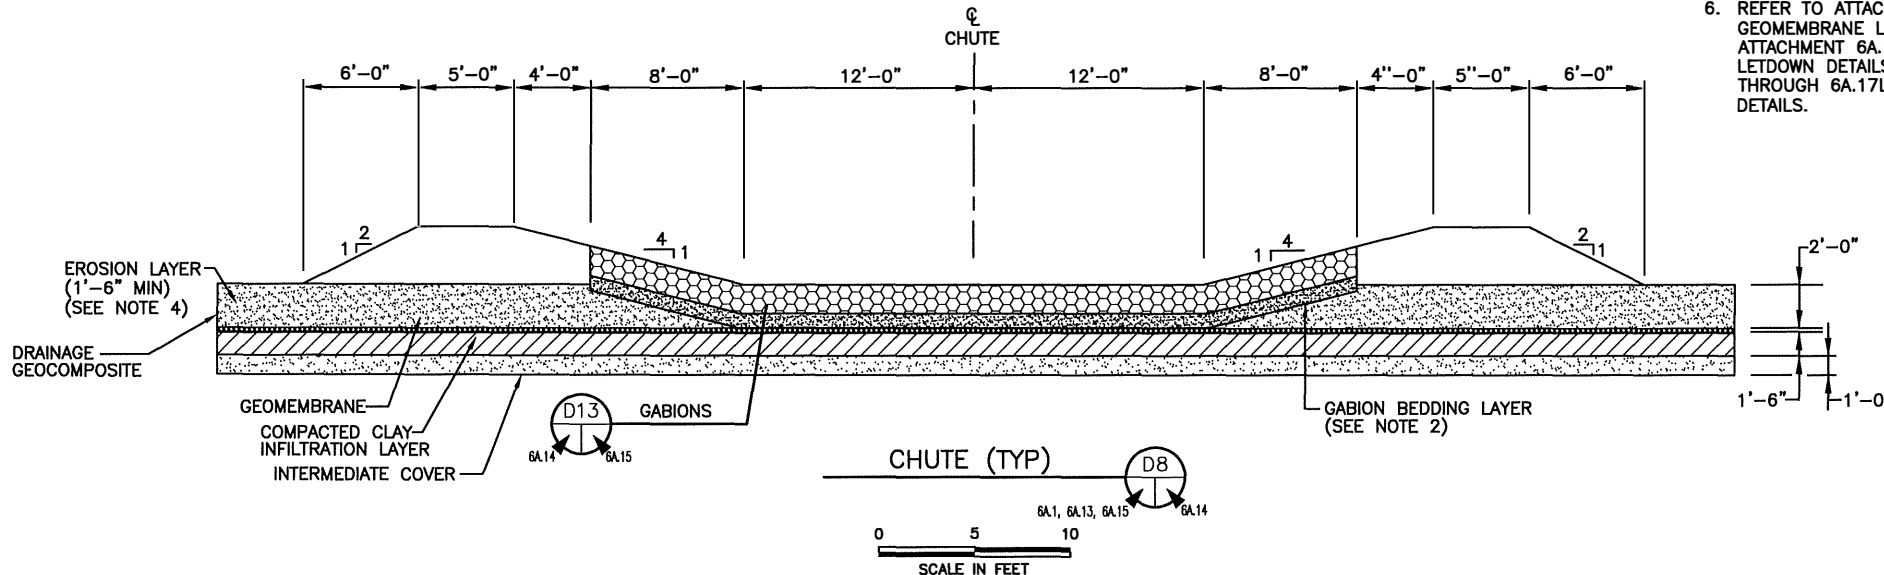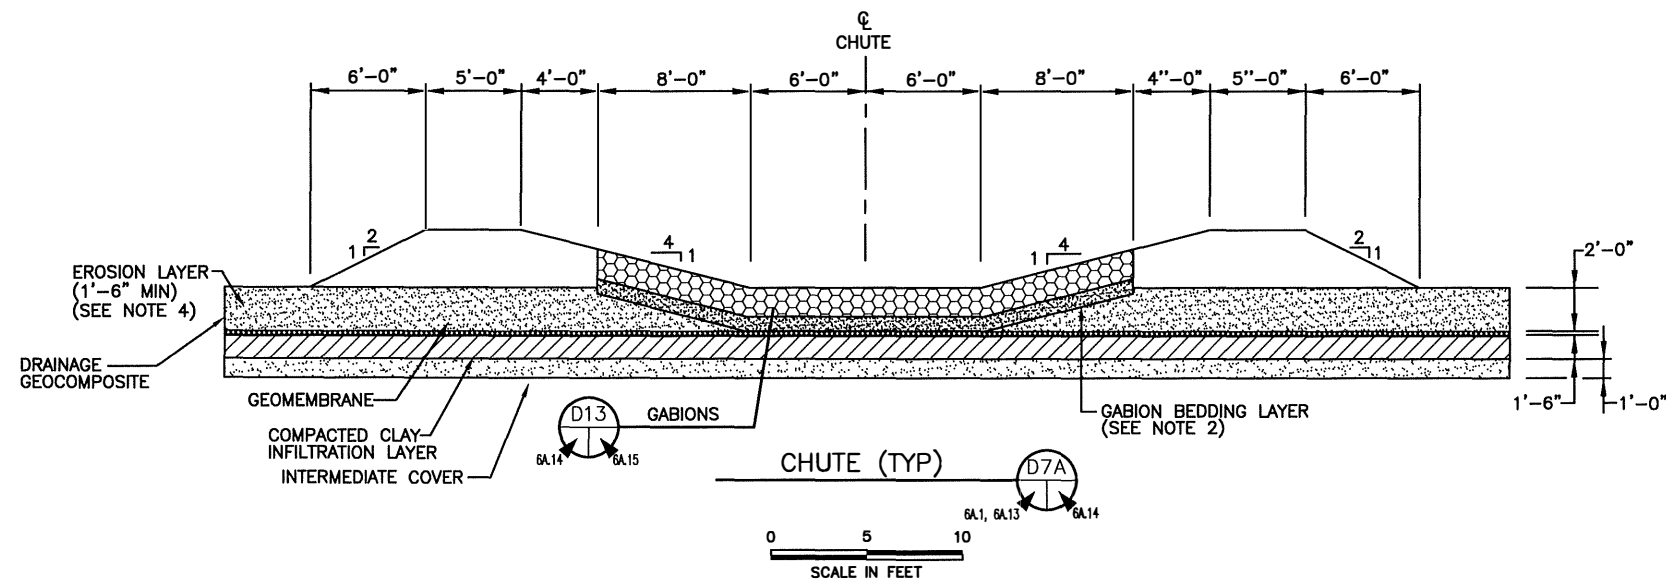

# NOTES:


1. REFER TO ATTACHMENT 6A.1-DRAINAGE STRUCTURE PLAN FOR LOCATION OF DETAILS.
2. BEDDING MATERIAL WILL CONSIST OF A SW OR SP MATERIAL AS DEFINED BY UNIFIED SOIL CLASSIFICATION SYSTEM. (USCS).
3. BOTTOM WIDTH OF CHUTES WILL VARY PER ENERGY DISSIPATOR CALCULATIONS (SEE APPENDIX 6A-C).
4. TOP 6 INCHES OF EROSION LAYER WILL BE CAPABLE OF SUSTAINING VEGETATIVE GROWTH.
5. DETAILS ARE SHOWN WITH SUBTITLE-D FINAL COVER CONFIGURATION.
6. REFER TO ATTACHMENT 6A.17A THROUGH 6A.17C FOR GEOMEMBRANE LETDOWN DETAILS. REFER TO ATTACHMENT 6A.17D THROUGH 6A.17H FOR FLEXAMAT LETDOWN DETAILS. REFER TO ATTACHMENT 6A.17I THROUGH 6A.17L FOR ARTICULATED BLOCK LETDOWN DETAILS.

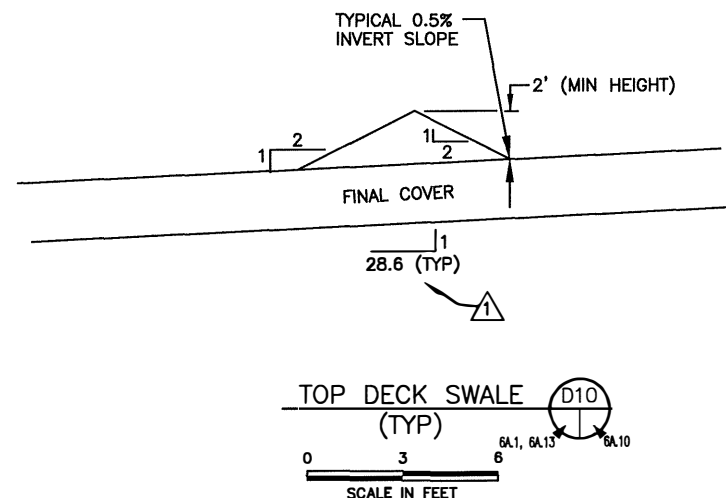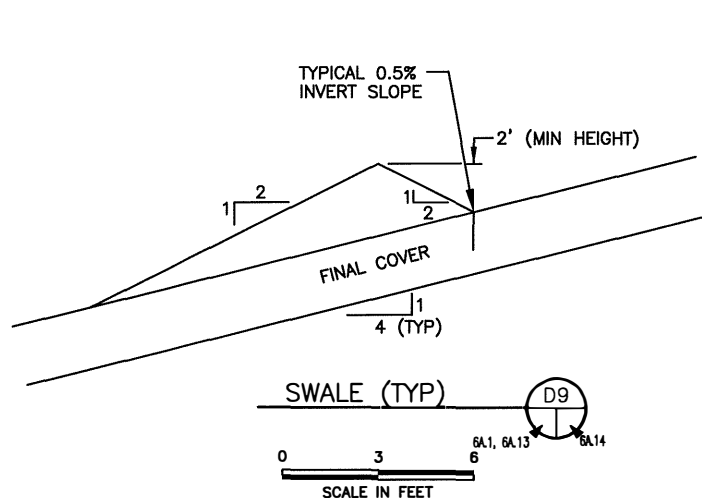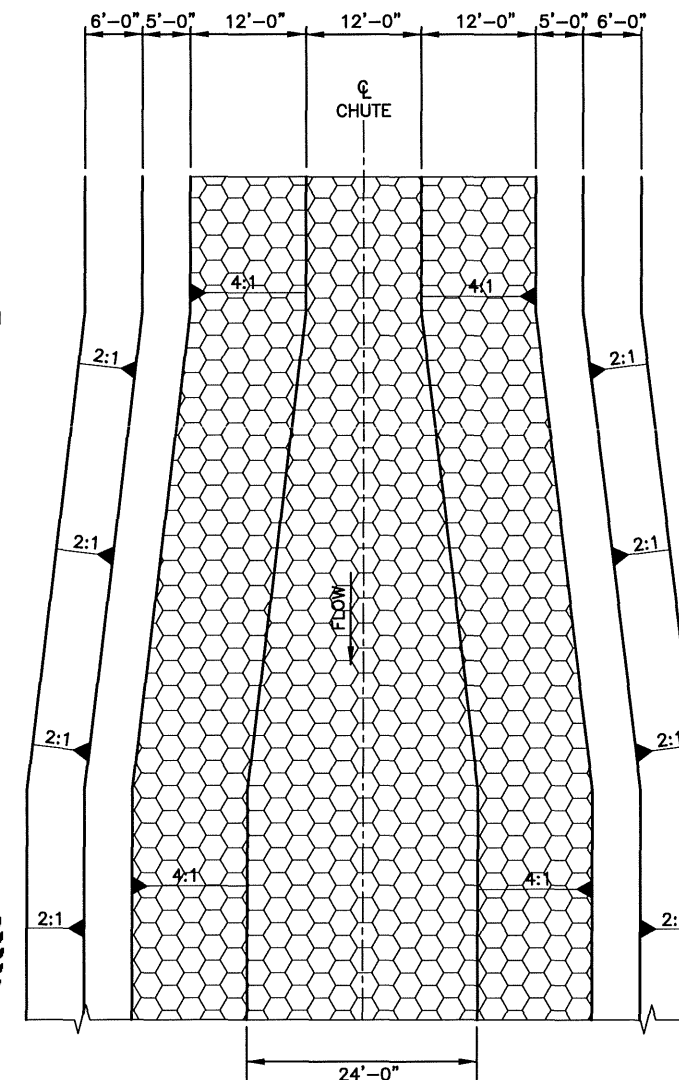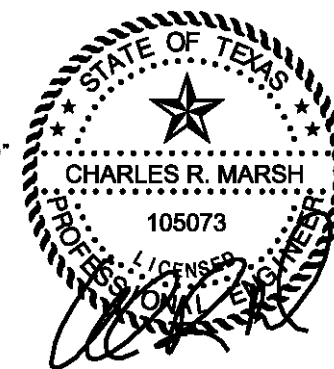


INDICATES REVISION  
(SEE LIST OF REVISIONS)

- LIST OF REVISIONS:
1. REVISED TOP DECK SWALE GEOMETRY.



<div><input type="checkbox"/> DRAFT</div> <div><input checked="" type="checkbox"/> FOR PERMITTING PURPOSES ONLY</div> <div><input type="checkbox"/> ISSUED FOR CONSTRUCTION</div>		PREPARED FOR		DRAINAGE DETAILS	
		McCARTY ROAD LANDFILL TX, LP			
DATE: 03/2004 FILE: 0120-439-11 CAD: 6A-14-DRAINDET1.DWG		DRAWN BY: JDW DESIGN BY: SAN REVIEWED BY: JPY		McCARTY ROAD LANDFILL HARRIS COUNTY, TEXAS	
REVISIONS					
NO.		DATE		DESCRIPTION	
1		10/2010		PERMIT MODIFICATION	
2		01/2012		PERMIT MODIFICATION	
3		12/2024		SEE LIST OF REVISIONS	
<div><div></div>Weaver Consultants Group</div> <div>TBPE REGISTRATION NO. F-3727</div>				WWW.WCGRP.COM	
				ATTACHMENT 6A.14	

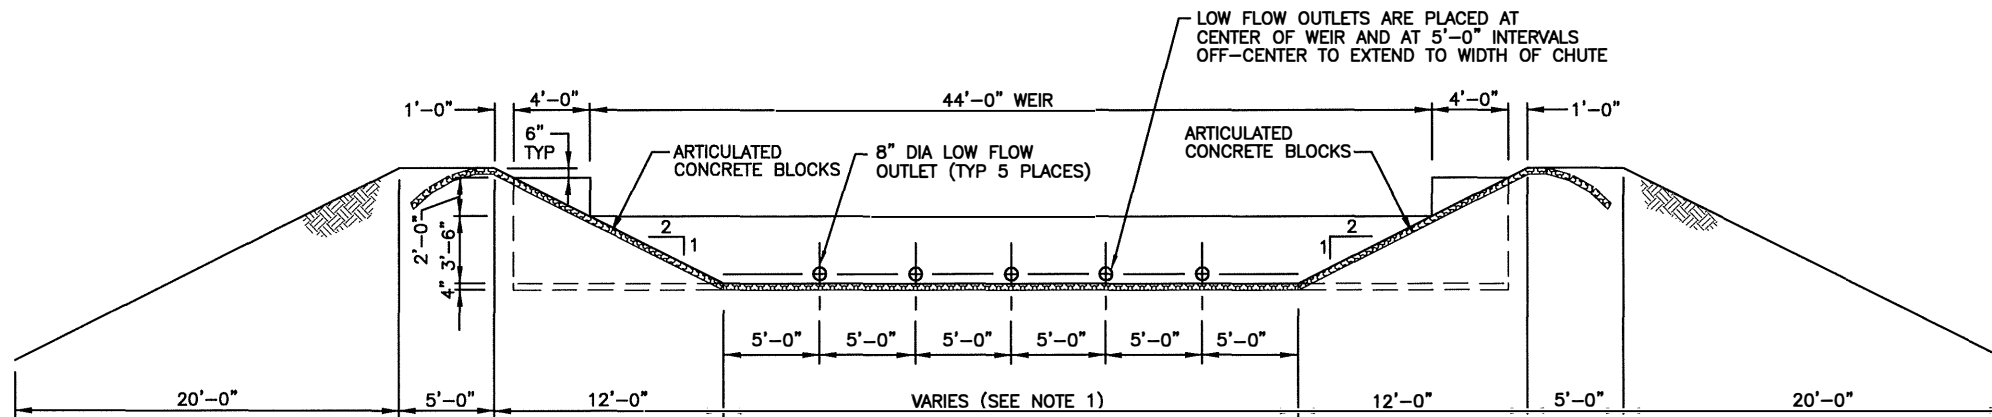

SECTION  
SCALE IN FEET  
0 5 10  
D20D  
6A.17L 6A.17J

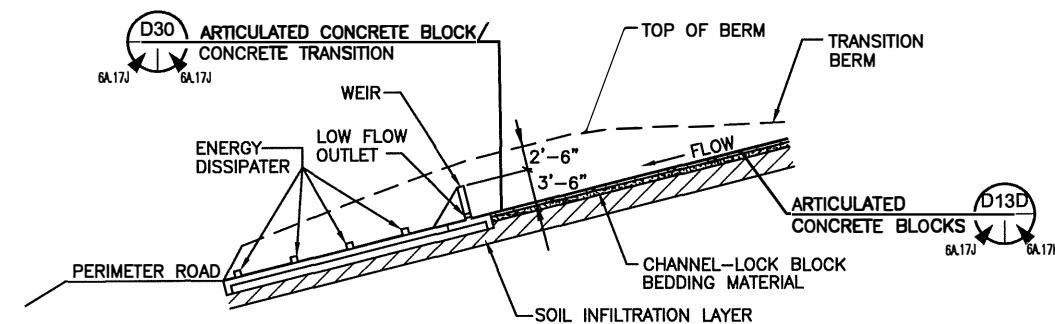


LONGITUDINAL SECTION  
SCALE IN FEET  
0 10 20  
D21D  
6A.17I 6A.17K

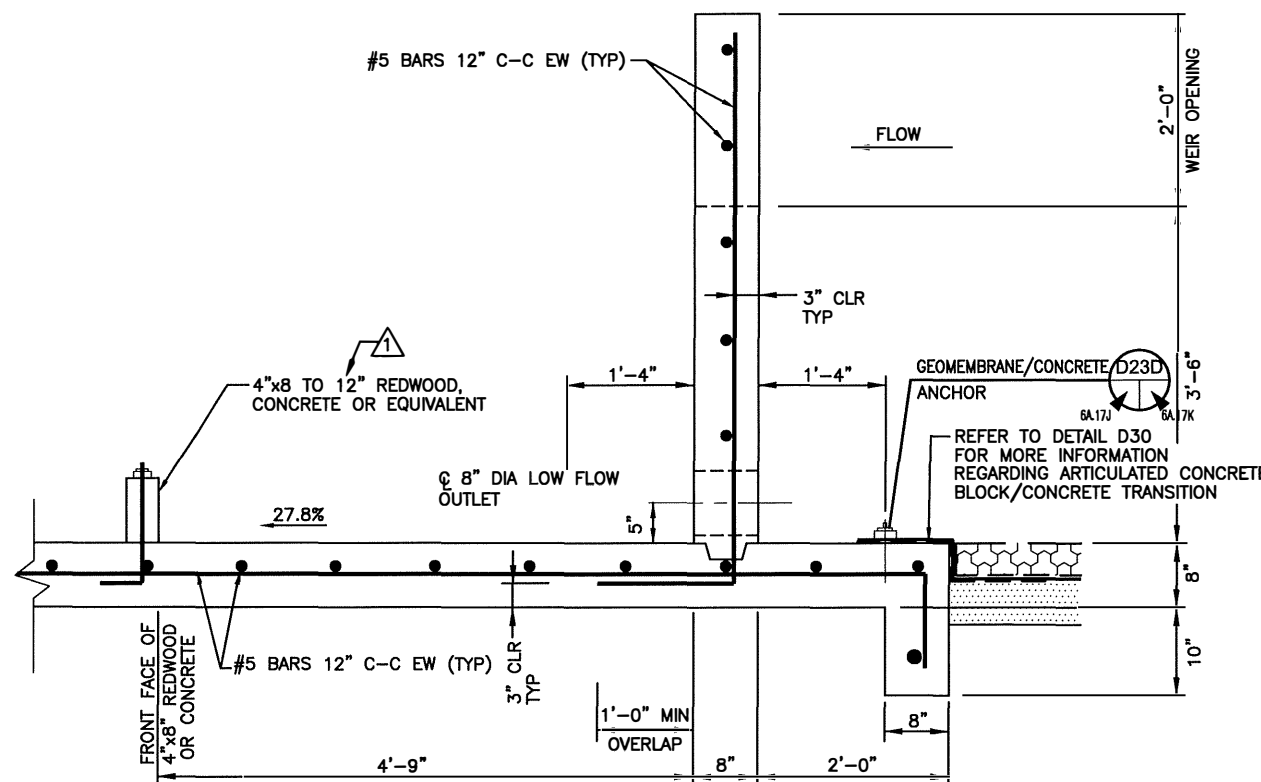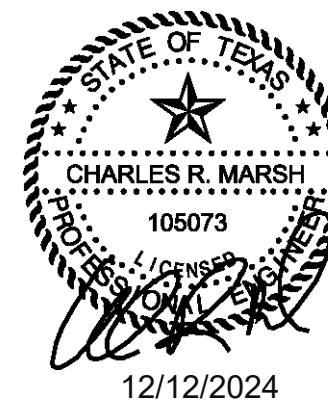

WEIR SECTION  
SCALE IN FEET  
0 1 2  
D24D  
6A.17K 6A.17J

LEGEND  
INDICATES REVISION  
(SEE LIST OF REVISIONS)

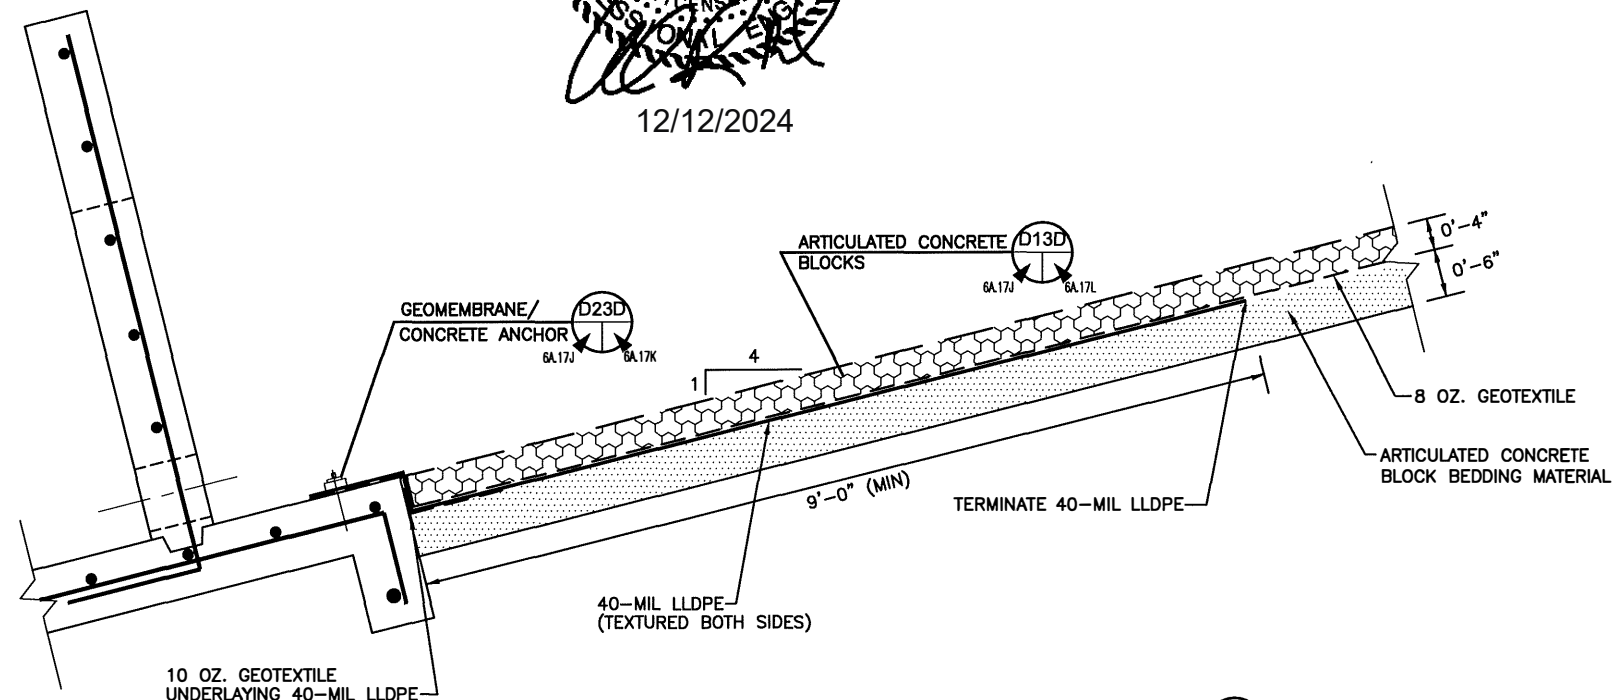


ARTICULATED CONCRETE BLOCK/CONCRETE TRANSITION  
SCALE IN FEET  
0 1 2  
D30  
6A.17J 6A.17K

LIST OF REVISIONS:  
1. REVISED DISSIPATOR DESIGN.

NOTE:  
1. DESIGN DIMENSIONS SHOWN ARE BASED ON CHUTE WITH 30-FOOT BOTTOM WIDTH. DESIGN ELEMENTS FOR EACH CHUTE WILL BE BASED ON CALCULATIONS PRESENTED IN APPENDIX 6A-C AND MAY VARY FROM THE DIMENSIONS SHOWN ON THIS PLAN.


<input type="checkbox"/> DRAFT <input checked="" type="checkbox"/> FOR PERMITTING PURPOSES ONLY <input type="checkbox"/> ISSUED FOR CONSTRUCTION		PREPARED FOR <b>MCCARTY ROAD LANDFILL TX, LP</b>		<b>LETDOWN DETAILS</b>	
DATE: 03/2004 FILE: 0120-438-11 CAD: 6A.17J-LETDOWN DETAILS.DWG		DRAWN BY: JOW DESIGN BY: SAN REVIEWED BY: JPY		McCARTY ROAD LANDFILL HARRIS COUNTY, TEXAS	
<b>Weaver Consultants Group</b> TBPE REGISTRATION NO. F-3727		REVISIONS		WWW.WCGRP.COM	
		NO.	DATE	DESCRIPTION	
		1	01/2012	PERMIT MODIFICATION	
		2	12/2024	SEE LIST OF REVISIONS	
				ATTACHMENT 6A.17J	



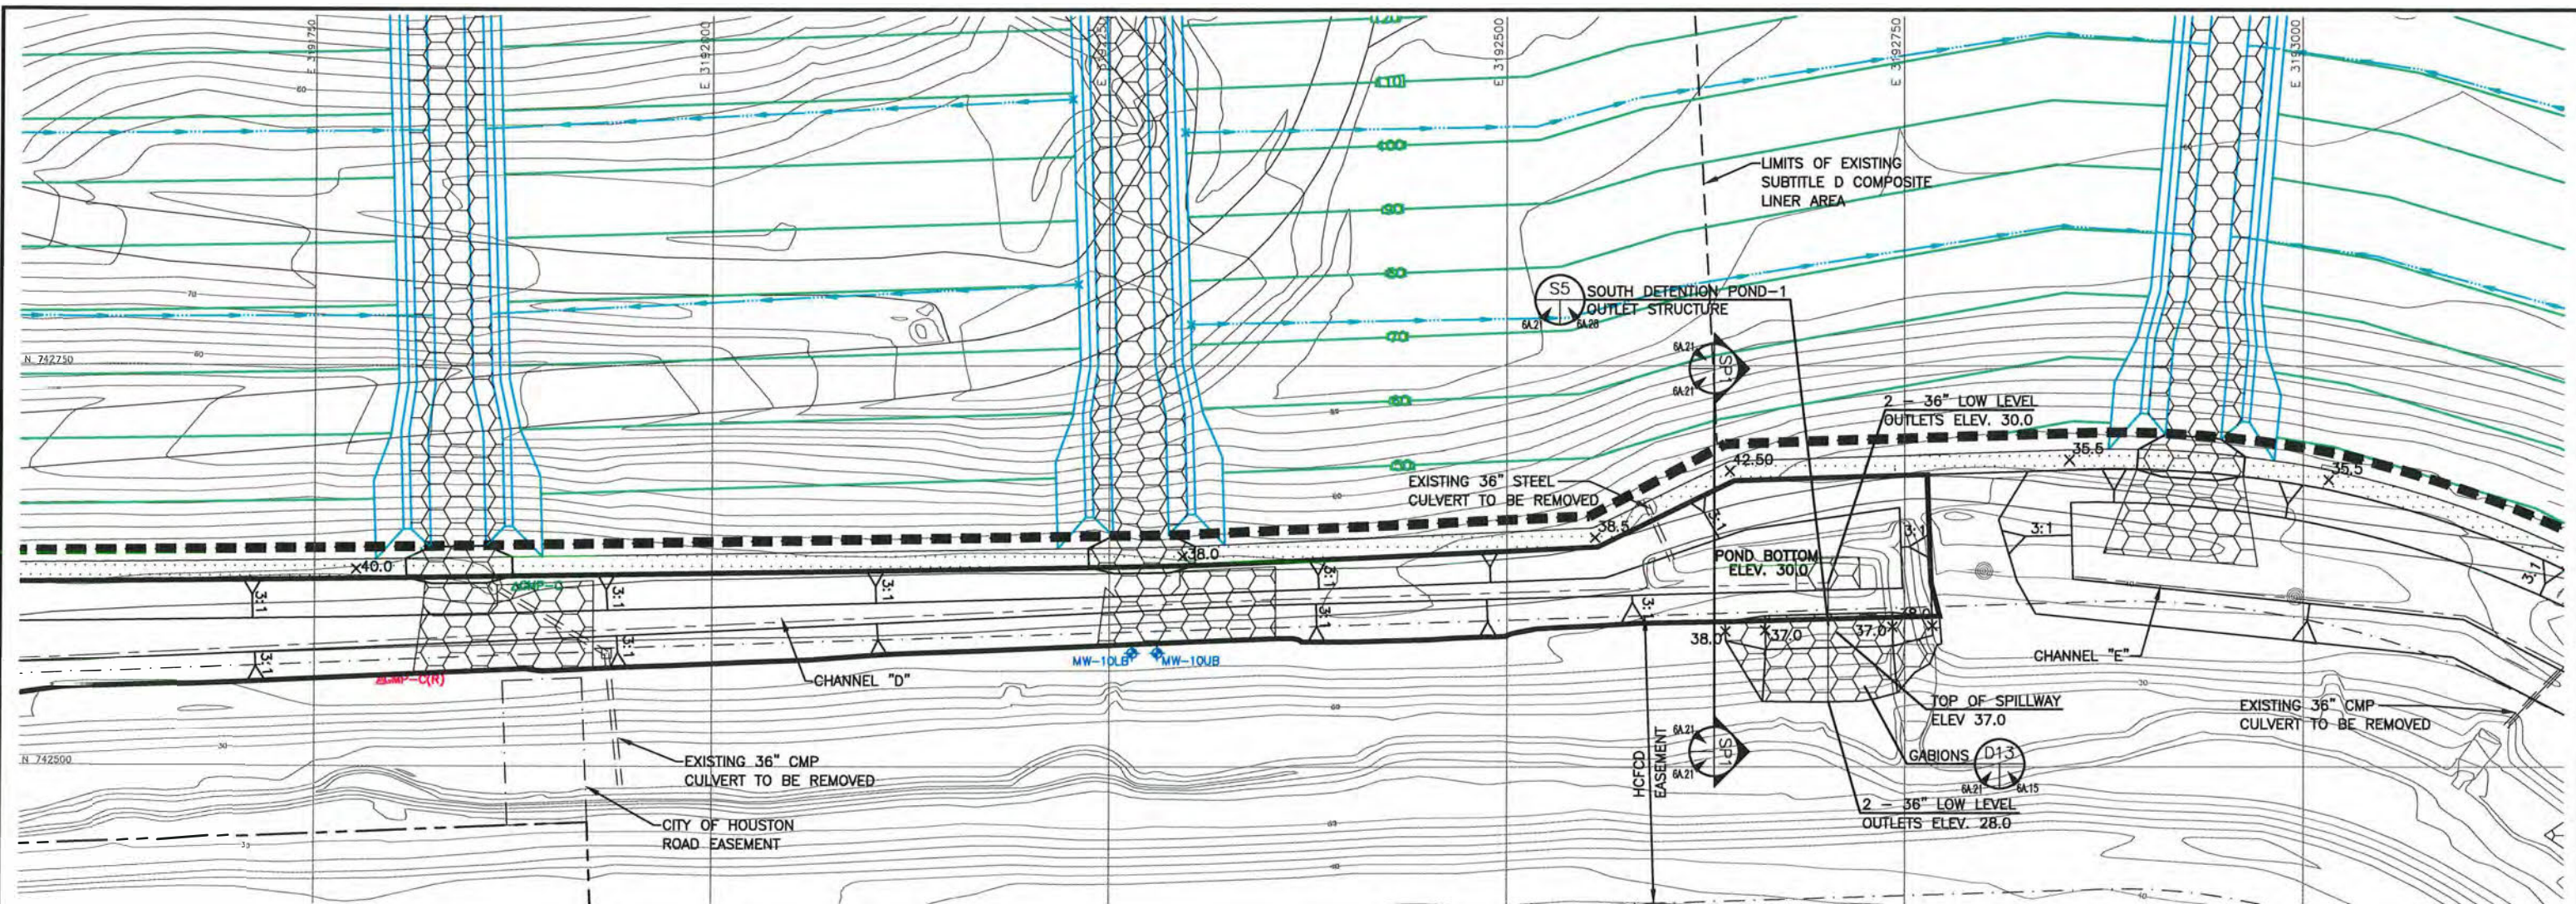

LEGEND

- PERMIT BOUNDARY
- EXISTING CONTOUR
- STATE PLANE COORDINATE SYSTEM
- FINAL CONTOUR
- LIMITS OF WASTE
- EASEMENT BOUNDARY
- PROPOSED DRAINAGE LETDOWN
- GABIONS
- PROPOSED DRAINAGE SWALE
- EXISTING DETECTION GROUNDWATER MONITORING WELL
- EXISTING LANDFILL GAS MONITORING PROBE TO BE DECOMMISSIONED
- PROPOSED REPLACEMENT LANDFILL GAS MONITORING PROBE
- POND LIMITS
- INDICATES REVISION (SEE LIST OF REVISIONS)

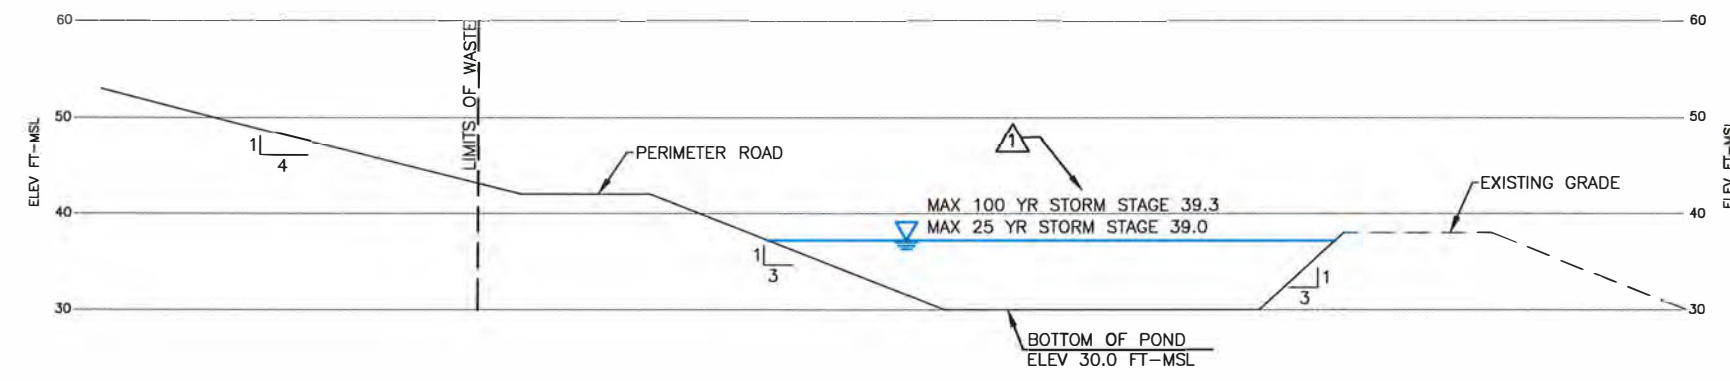


SOUTH DETENTION POND-1 SECTION



- LIST OF REVISIONS:
1. UPDATED STAGES.

SOUTH DETENTION POND-1	
ELEVATION (FT-MSL)	SURFACE AREA (AC)
30.0	0.0012
32.0	0.5971
34.0	0.9844
36.0	1.3785
38.0	1.7659

\* BOLD OUTLINE OF THE POND REPRESENTS THE LIMITS OF THE POND.

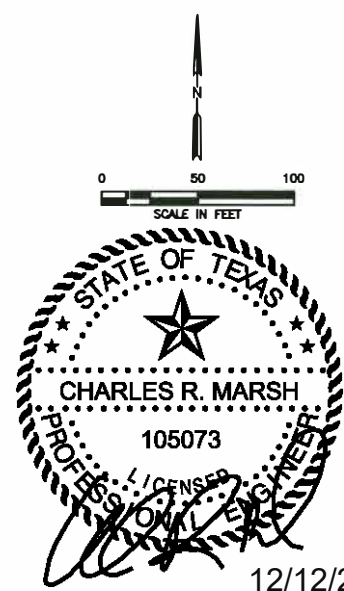



12/12/2024

<input type="checkbox"/> DRAFT <input checked="" type="checkbox"/> FOR PERMITTING PURPOSES ONLY <input type="checkbox"/> ISSUED FOR CONSTRUCTION	PREPARED FOR <b>McCARTY ROAD LANDFILL TX, LP</b>	MAJOR PERMIT AMENDMENT SOUTH POND-1
DATE: 03/2004 FILE: 0120-439-11 CAD: 6A21-S-POND1.DWG	DRAWN BY: JOW DESIGN BY: SAN/ALD REVIEWED BY: JPY	McCARTY ROAD LANDFILL HARRIS COUNTY, TEXAS
<b>Weaver Consultants Group</b> TBPE REGISTRATION NO. F-3727	REVISIONS NO. DATE DESCRIPTION 1 12/2024 SEE LIST OF REVISIONS	WWW.WCGRP.COM

ATTACHMENT 6A.21

O:\0120\439\PLP MOD 2024\ATT 6\6A\6A.21-S-POND1.dwg, rarrington, 1:2



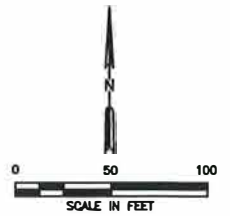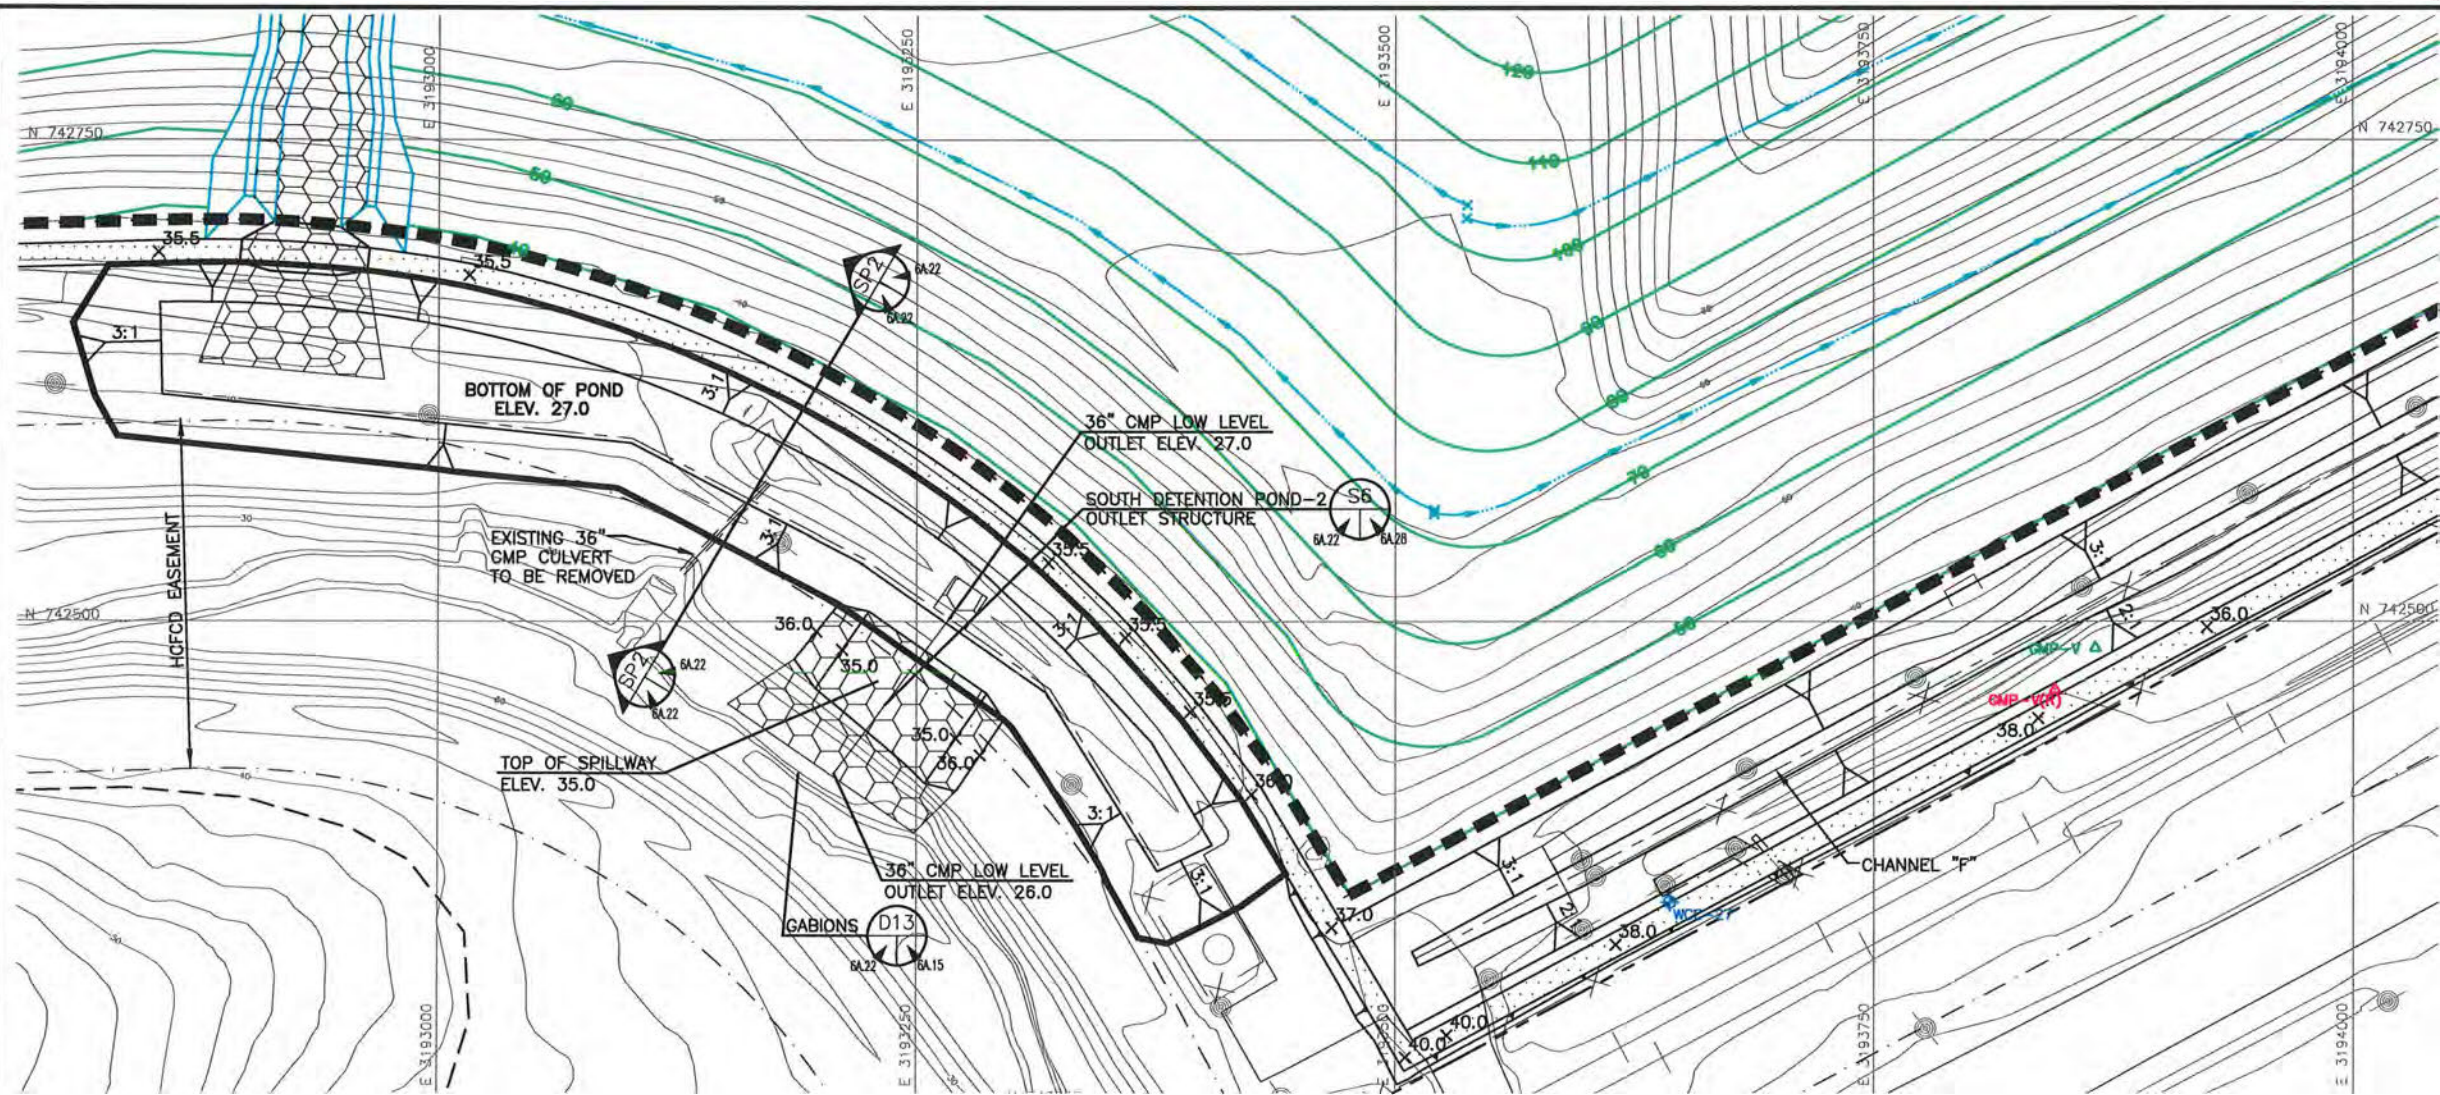


SOUTH DETENTION POND-2	
ELEVATION (FT-MSL)	SURFACE AREA (AC)
27.0	0.0010
28.0	0.5542
29.0	0.6472
30.0	0.7417
31.0	0.8379
32.0	0.9357
33.0	1.0352
34.0	1.1362
35.0	1.2332
36.0	1.3376

\* BOLD OUTLINE OF THE POND REPRESENTS THE LIMITS OF THE POND.

#### LEGEND


- PERMIT BOUNDARY
- EXISTING CONTOUR
- STATE PLANE COORDINATE SYSTEM
- FINAL CONTOUR
- LIMITS OF WASTE
- EASEMENT BOUNDARY
- PROPOSED DRAINAGE LETDOWN
- GABIONS
- PROPOSED DRAINAGE SWALE
- EXISTING DETECTION GROUNDWATER MONITORING WELL
- EXISTING LANDFILL GAS MONITORING PROBE TO BE DECOMMISSIONED
- PROPOSED REPLACEMENT LANDFILL GAS MONITORING PROBE
- POND LIMITS
- INDICATES REVISION (SEE LIST OF REVISIONS)

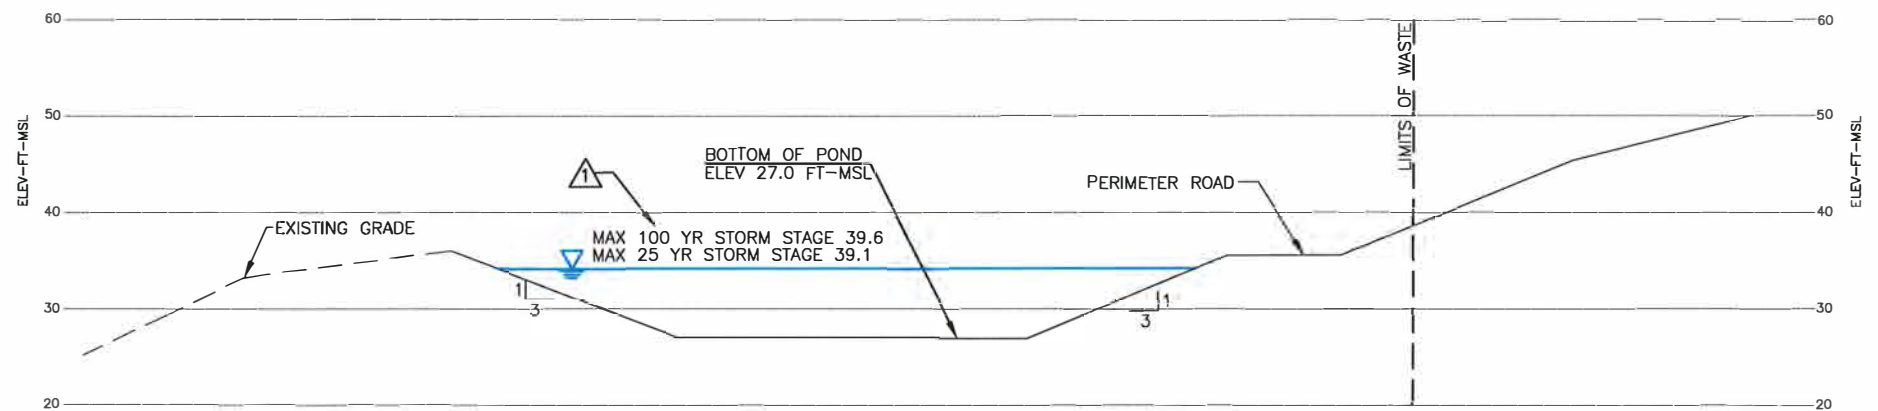

SOUTH DETENTION POND-2 SECTION SP2



- LIST OF REVISIONS:
1. UPDATED STAGES.

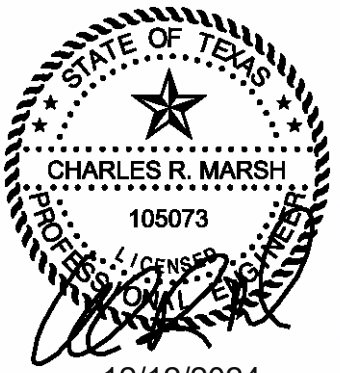


12/12/2024

<input type="checkbox"/> DRAFT <input checked="" type="checkbox"/> FOR PERMITTING PURPOSES ONLY <input type="checkbox"/> ISSUED FOR CONSTRUCTION	PREPARED FOR <b>MCCARTY ROAD LANDFILL TX, LP</b>	MAJOR PERMIT AMENDMENT SOUTH POND-2	
DATE: 03/2004 FILE: 0120-439-11 CAD: 6A22-S-POND.DWG	DRAWN BY: JDW DESIGN BY: SAN/ALD REVIEWED BY: JPY	McCARTY ROAD LANDFILL HARRIS COUNTY, TEXAS	
Weaver Consultants Group TBPE REGISTRATION NO. F-3727		WWW.WCGRP.COM	
REVISIONS		ATTACHMENT 6A.22	
NO. DATE DESCRIPTION			
1 12/2024 SEE LIST OF REVISIONS			




0:\0120\439\PLP MOD 2024\ATT 6\6A\6A.24-SE-POND.dwg, rarrington, 1:2

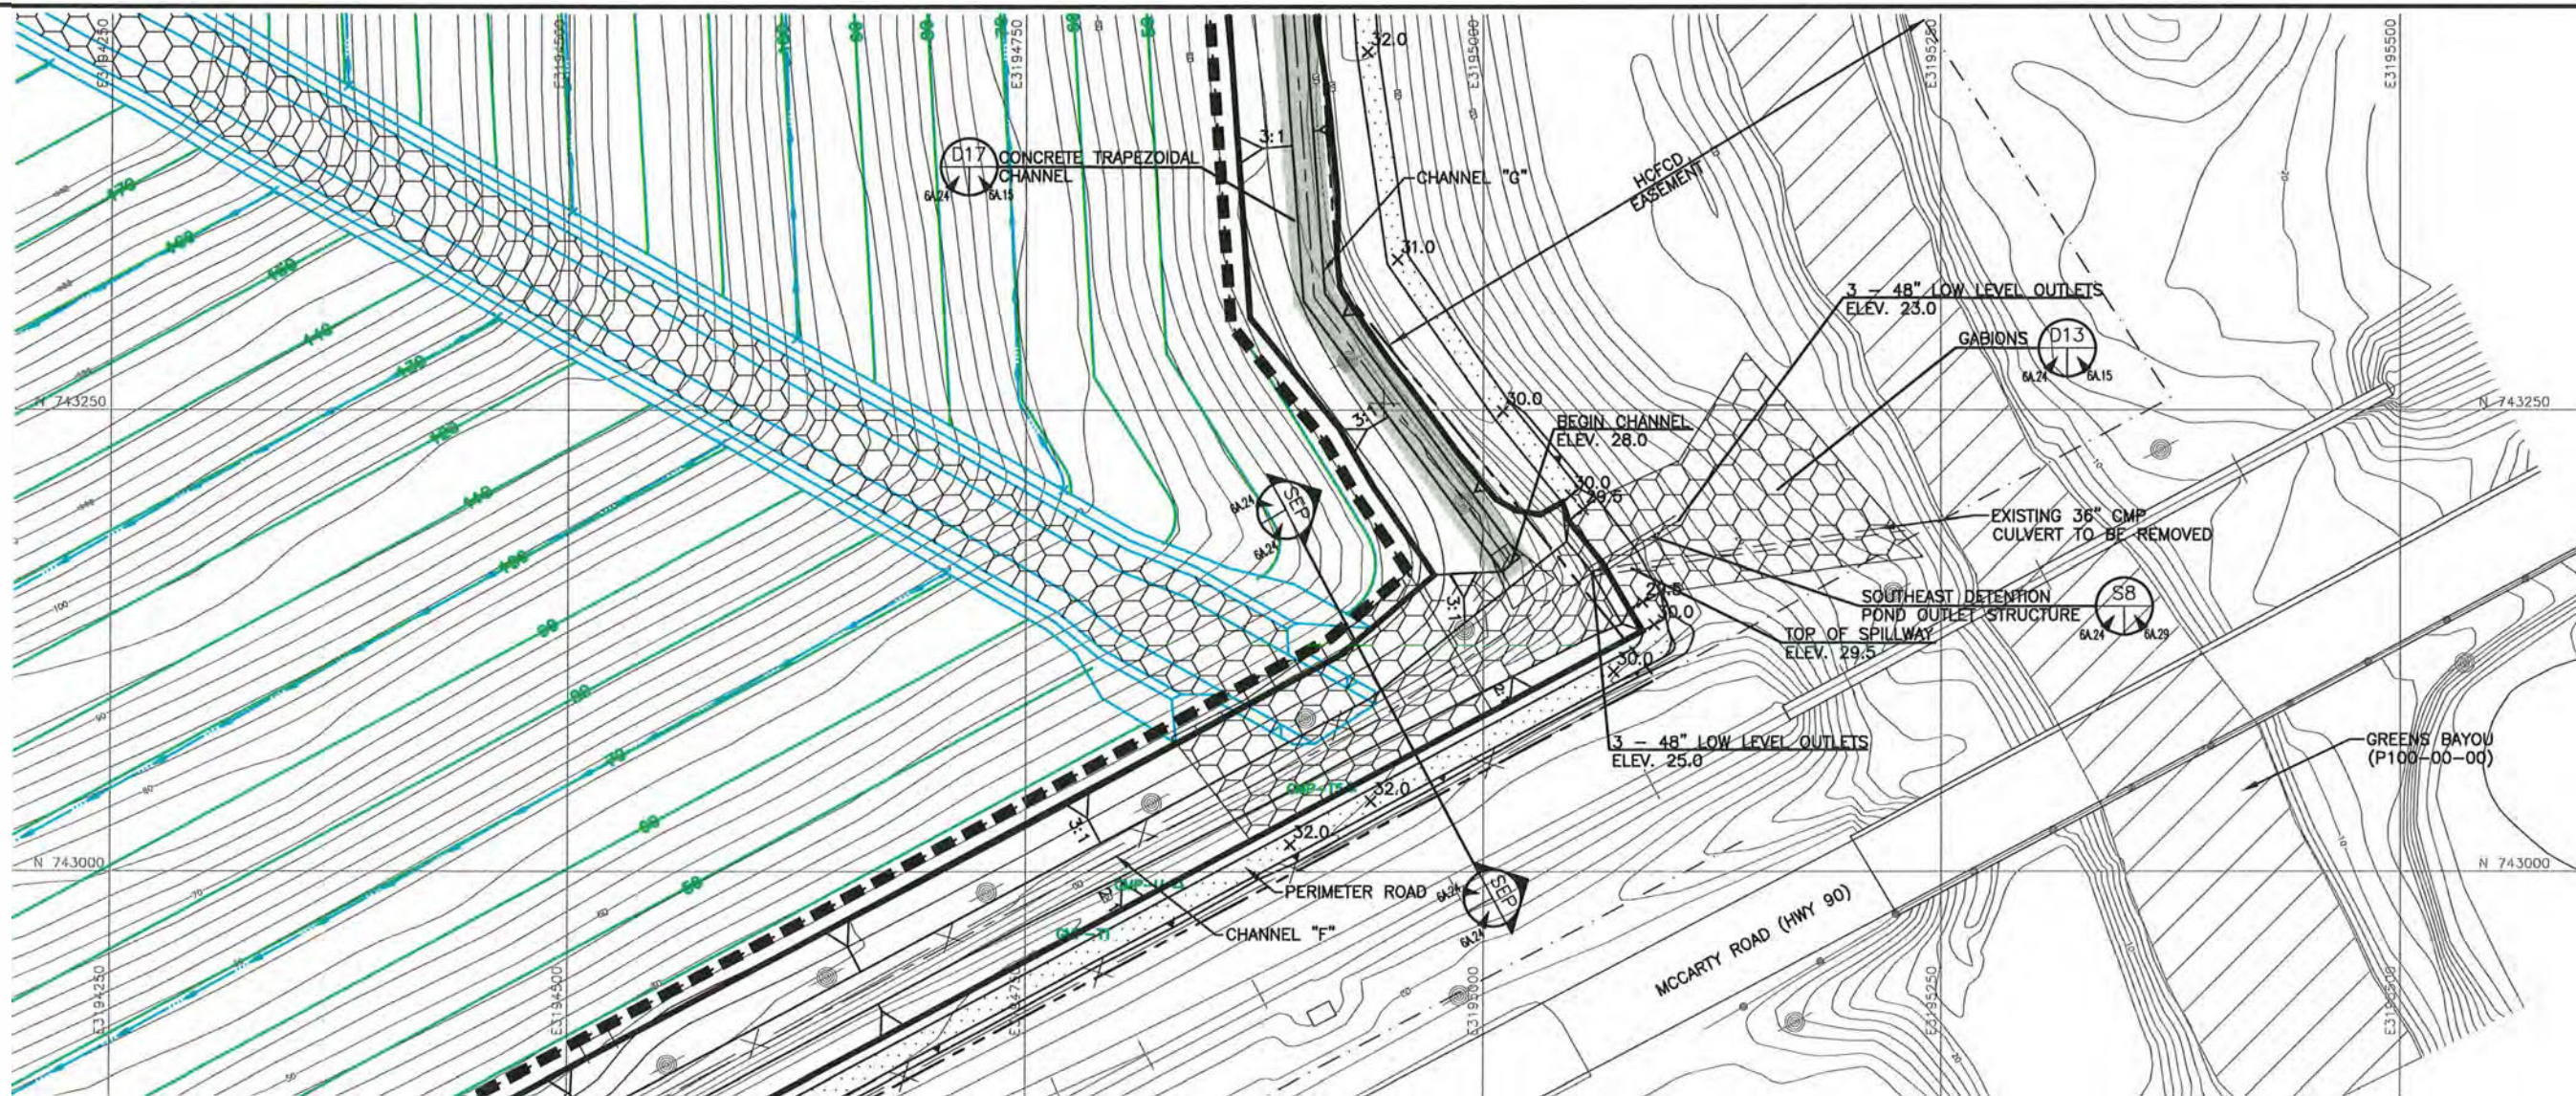

#### LEGEND

- PERMIT BOUNDARY
- EXISTING CONTOUR
- STATE PLANE COORDINATE SYSTEM
- FINAL CONTOUR
- LIMITS OF WASTE
- EASEMENT BOUNDARY
- PROPOSED DRAINAGE LETDOWN
- GABIONS
- CONCRETE
- PROPOSED DRAINAGE SWALE
- EXISTING LANDFILL GAS MONITORING PROBE (SEE NOTE 1)
- EXISTING LANDFILL GAS MONITORING PROBE TO BE DECOMMISSIONED (SEE NOTE 1)
- POND LIMITS
- INDICATES REVISION (SEE LIST OF REVISIONS)

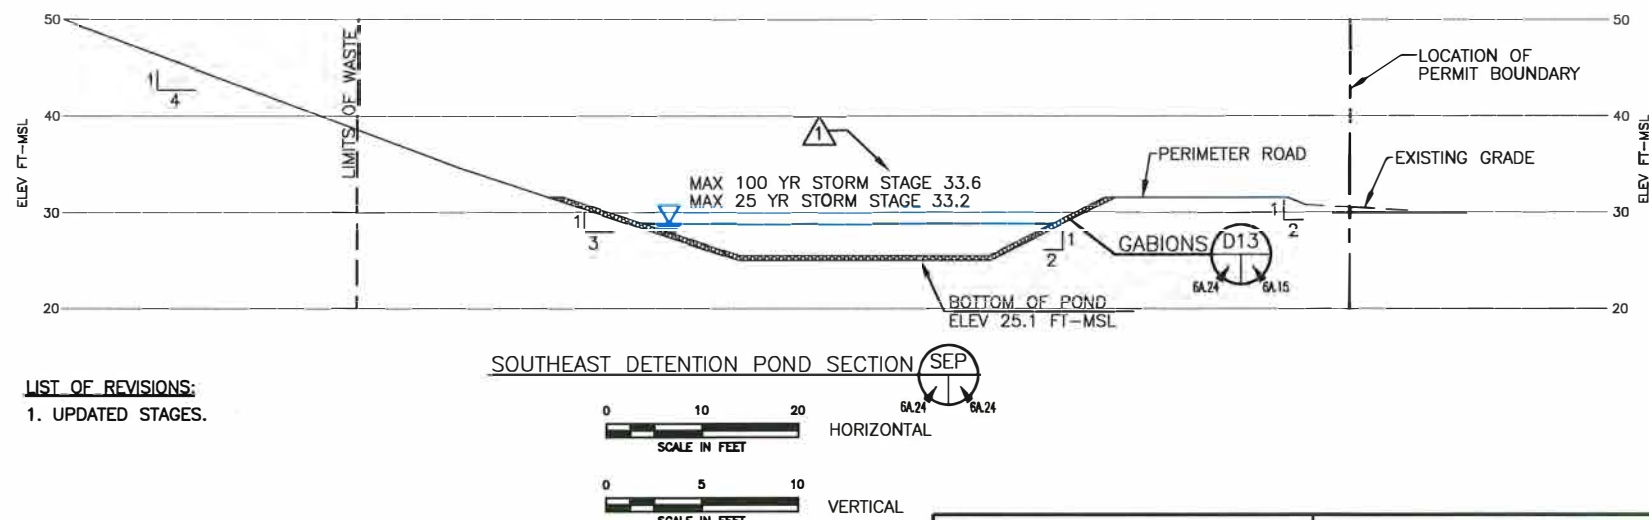

#### LIST OF REVISIONS:


1. UPDATED STAGES.

#### NOTE:

1. GMP-T5 AND GMP-U ARE BEING DECOMMISSIONED VIA A PERMIT MODIFICATION SUBMITTED BY WBC IN APRIL 2004. GMP-T1 WILL BECOME A PERMANENT GAS MONITORING PROBE FOR THIS AREA. REFER TO ATTACHMENT 14 FOR ADDITIONAL INFORMATION.

SOUTHEAST DETENTION POND	
ELEVATION (FT-MSL)	SURFACE AREA (AC)
25.0	0.0556
26.0	0.3693
27.0	0.6752
28.0	1.0046
29.0	1.3702
30.0	1.7328



\* BOLD OUTLINE OF THE POND REPRESENTS THE LIMITS OF THE POND.

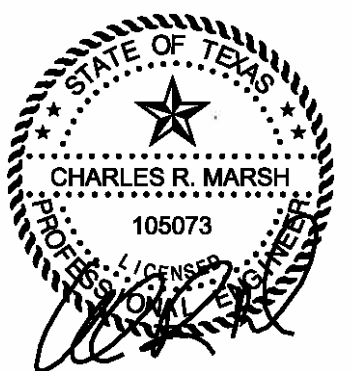


12/12/2024

<input type="checkbox"/> DRAFT <input checked="" type="checkbox"/> FOR PERMITTING PURPOSES ONLY <input type="checkbox"/> ISSUED FOR CONSTRUCTION	PREPARED FOR <b>MCCARTY ROAD LANDFILL TX, LP</b>	MAJOR PERMIT AMENDMENT SOUTHEAST POND
DATE: 03/2004 FILE: 0120-439-11 CAD: 6A.24-SE-POND.DWG	DRAWN BY: JDW DESIGN BY: SAN/ALD REVIEWED BY: JPY	REVISIONS NO. DATE DESCRIPTION 1 12/2024 SEE LIST OF REVISIONS
<b>Weaver Consultants Group</b> TBPB REGISTRATION NO. F-3727		WWW.WCGRP.COM ATTACHMENT 6A.24



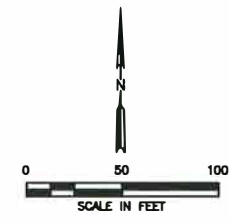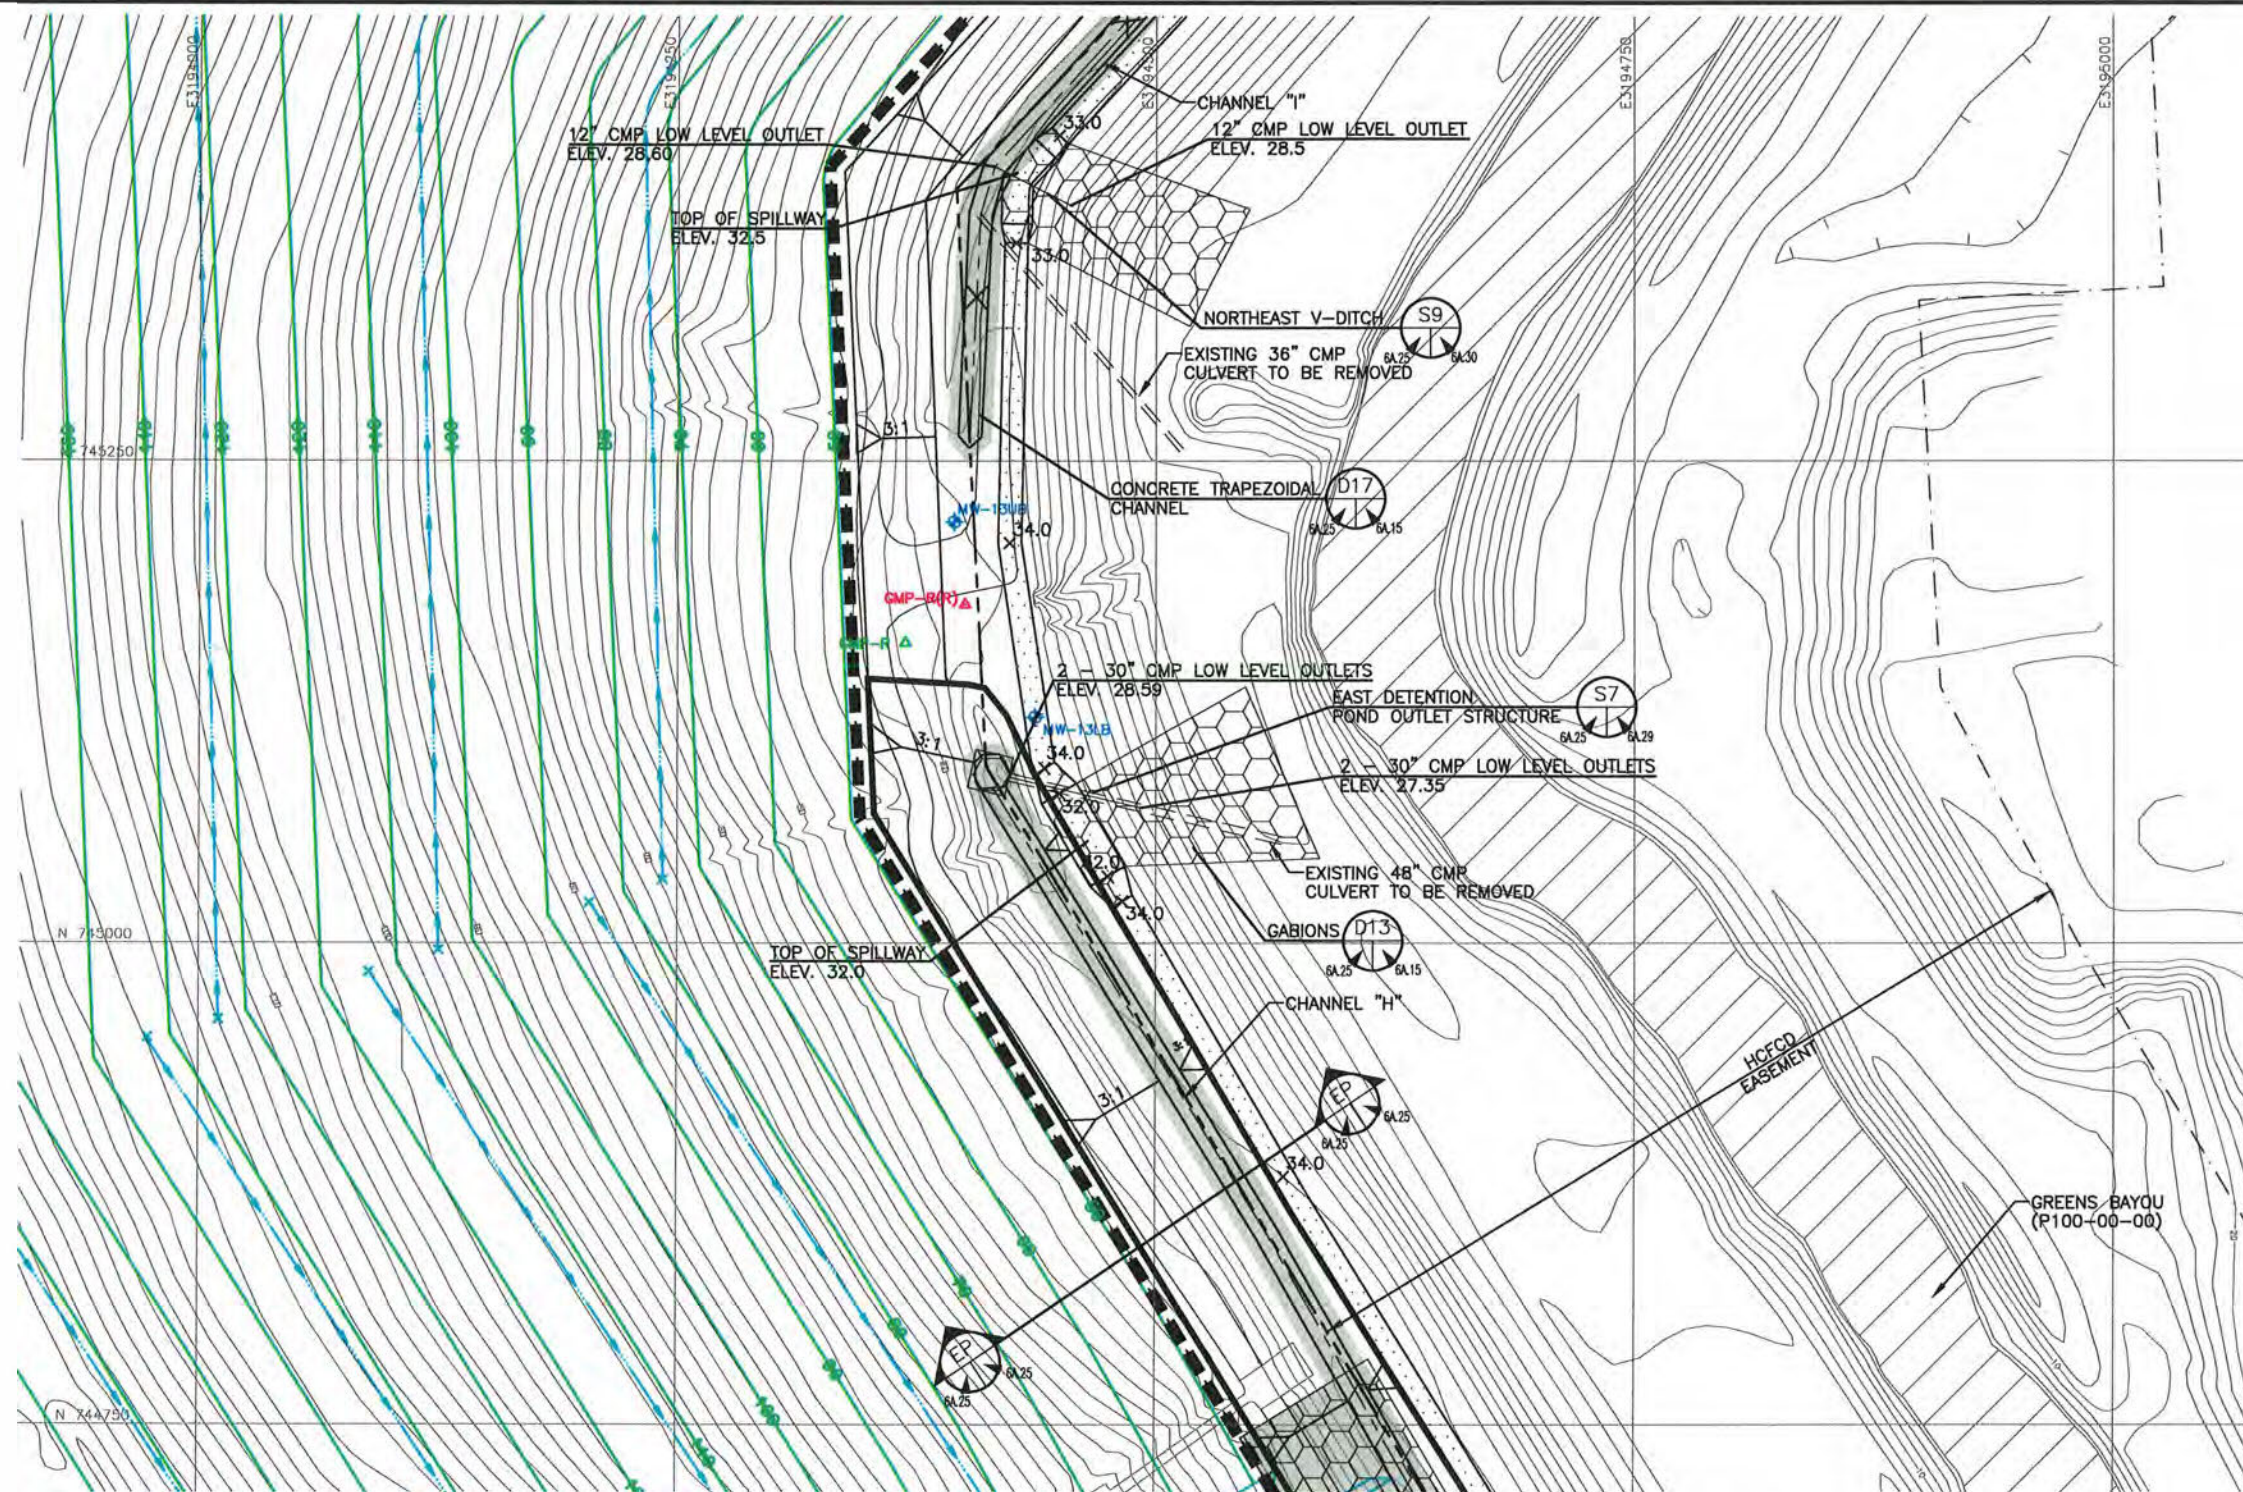

- LEGEND**
- PERMIT BOUNDARY
  - EXISTING CONTOUR
  - STATE PLANE COORDINATE SYSTEM
  - FINAL CONTOUR
  - LIMITS OF WASTE
  - EASEMENT BOUNDARY
  - GABIONS
  - CONCRETE
  - PROPOSED DRAINAGE SWALE
  - EXISTING DETECTION GROUNDWATER MONITORING WELL
  - EXISTING LANDFILL GAS MONITORING PROBE
  - EXISTING LANDFILL GAS MONITORING PROBE TO BE DECOMMISSIONED (SEE NOTE 1)
  - PROPOSED REPLACEMENT LANDFILL GAS MONITORING PROBE (SEE NOTE 1)
  - POND LIMITS
  - INDICATES REVISION (SEE LIST OF REVISIONS)

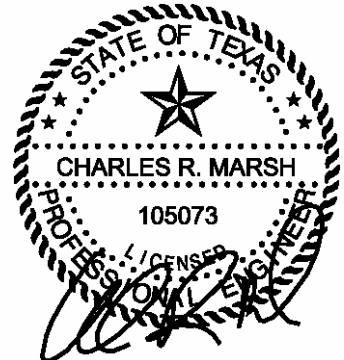


EAST DETENTION POND	
ELEVATION (FT-MSL)	SURFACE AREA (AC)
28.6	0.0061
29.0	0.1531
30.0	0.2422
31.0	0.3672
32.0	0.4937
33.0	0.6217

\* BOLD OUTLINE OF THE POND REPRESENTS THE LIMITS OF THE POND.

**NOTE:**

1. GAS MONITORING PROBE GMP-R WILL BE DECOMMISSIONED AND RELOCATED AS DOCUMENTED IN A PERMIT MODIFICATION SUBMITTED BY WEAVER BOOS CONSULTANTS IN APRIL 2004. REFER TO ATTACHMENT 14 FOR ADDITIONAL INFORMATION.

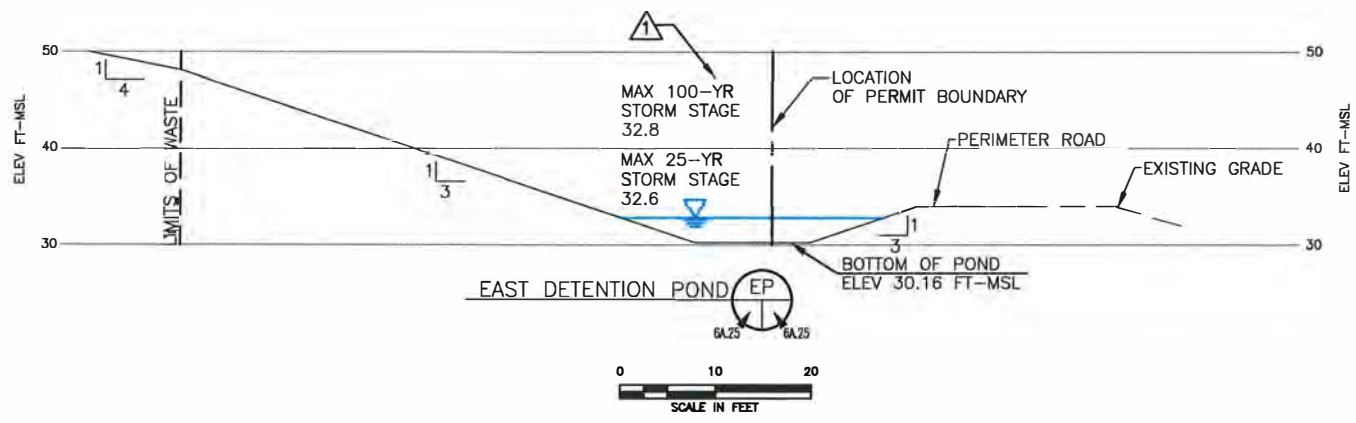

**LIST OF REVISIONS:**


1. UPDATED STAGES.

<input type="checkbox"/> DRAFT <input checked="" type="checkbox"/> FOR PERMITTING PURPOSES ONLY <input type="checkbox"/> ISSUED FOR CONSTRUCTION	PREPARED FOR <b>MCCARTY ROAD LANDFILL TX, LP</b>	<b>MAJOR PERMIT AMENDMENT EAST POND</b>		
DATE: 03/2004 FILE: 0120-439-11 CAD: 6A.14-SW-POND.DWG	DRAWN BY: JOW DESIGN BY: SAN/ALD REVIEWED BY: JPY	REVISIONS		
		NO.	DATE	DESCRIPTION
		1	12/2024	SEE LIST OF REVISIONS
<b>Weaver Consultants Group</b> TBPE REGISTRATION NO. F-3727				
		WWW.WCGRP.COM		ATTACHMENT 6A.25

O:\0120\439\FLIP MOD 2024\ATT 6A\6A.25-E-OUTLET.dwg, rarrington, 1:2





0:\0120\438\FLIP MOD 2024\ATT 6\6A\6A.28\OUTLET SP1&SP2.dwg, rarrington, 1:2

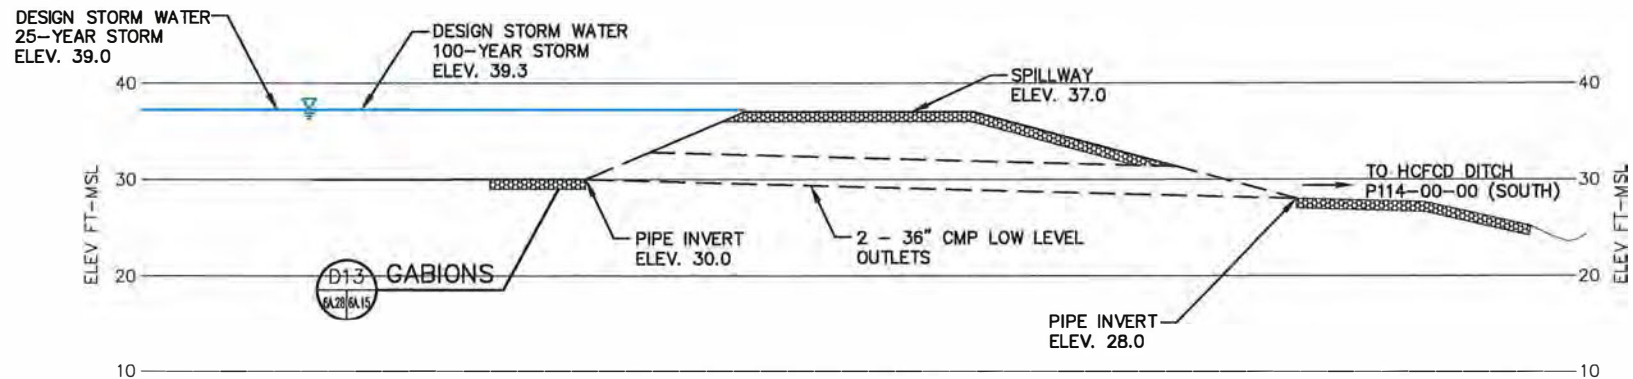

SOUTH DETENTION POND-1  
OUTLET STRUCTURE





SOUTH DETENTION POND-1	
BOTTOM ELEVATION	30.0 FT.
SPILLWAY ELEVATION	37.0 FT.
SPILLWAY LENGTH	80.0 FT.
PEAK 25-YEAR EVENT INFLOW	452.0 CFS
PEAK 25-YEAR EVENT OUTFLOW	307.0 CFS
PEAK 100-YEAR EVENT INFLOW	649.0 CFS
PEAK 100-YEAR EVENT OUTFLOW	415.0 CFS

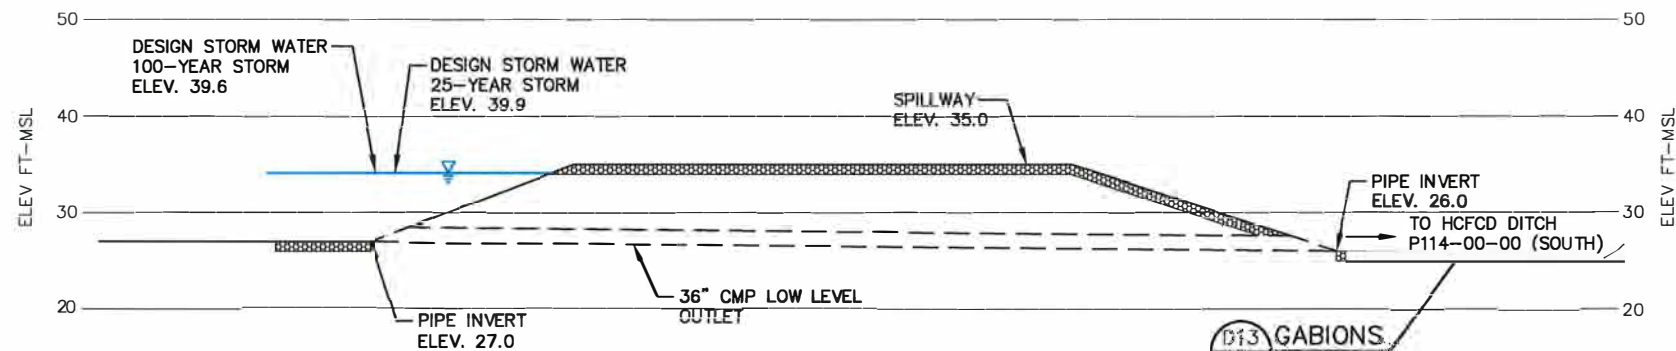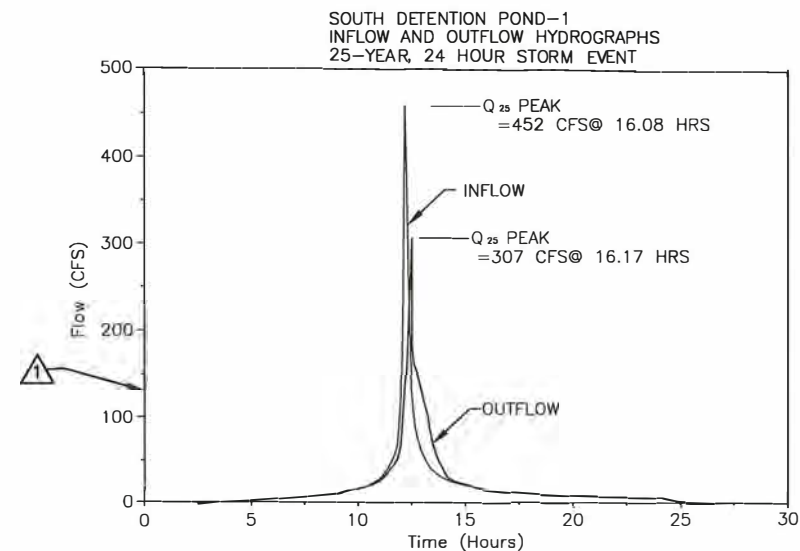

SOUTH DETENTION POND-2  
OUTLET STRUCTURE



SOUTH DETENTION POND-2	
BOTTOM ELEVATION	27.0 FT.
SPILLWAY ELEVATION	35.0 FT.
SPILLWAY LENGTH	75.0 FT.
PEAK 25-YEAR EVENT INFLOW	318.0 CFS
PEAK 25-YEAR EVENT OUTFLOW	18.0 CFS
PEAK 100-YEAR EVENT INFLOW	442.0 CFS
PEAK 100-YEAR EVENT OUTFLOW	75.0 CFS



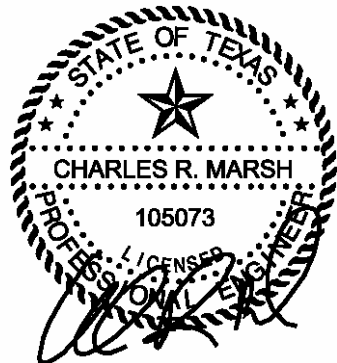
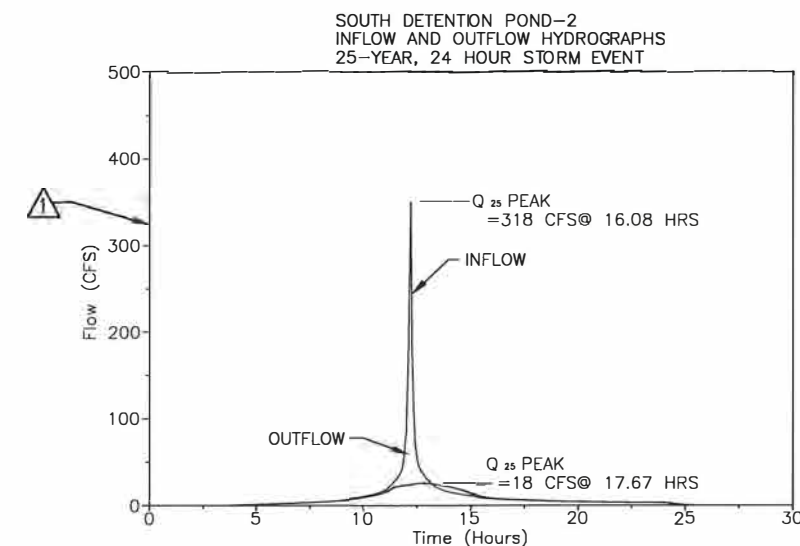


- INDICATES REVISION  
(SEE LIST OF REVISIONS)
- LIST OF REVISIONS:  
1. UPDATED DISCHARGE INFORMATION.


<input type="checkbox"/> DRAFT <input checked="" type="checkbox"/> FOR PERMITTING PURPOSES ONLY <input type="checkbox"/> ISSUED FOR CONSTRUCTION	PREPARED FOR <b>McCARTY ROAD LANDFILL TX, LP</b>	MAJOR PERMIT AMENDMENT POND OUTLET STRUCTURE DETAILS  McCARTY ROAD LANDFILL HARRIS COUNTY, TEXAS		
DATE: 03/2004 FILE: 0120-438-11 CAD: 6A-28 OUTLET SP1&SP2.DWG	DRAWN BY: JOW DESIGN BY: SAN/ALD REVIEWED BY: JPY			REVISIONS
Weaver Consultants Group TBPE REGISTRATION NO. F-3727		NO.	DATE	DESCRIPTION
		1	12/2024	SEE LIST OF REVISIONS
		WWW.WCGRP.COM		ATTACHMENT 6A.28



EAST DETENTION POND	
BOTTOM ELEVATION	28.59 FT.
SPILLWAY ELEVATION	32.0 FT.
SPILLWAY LENGTH	80.0 FT.
PEAK 25-YEAR EVENT INFLOW	270.0 CFS
PEAK 25-YEAR EVENT OUTFLOW	147.0 CFS
PEAK 100-YEAR EVENT INFLOW	374.0 CFS
PEAK 100-YEAR EVENT OUTFLOW	203.0 CFS

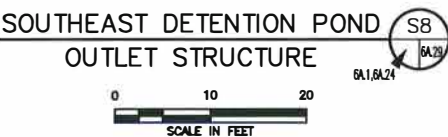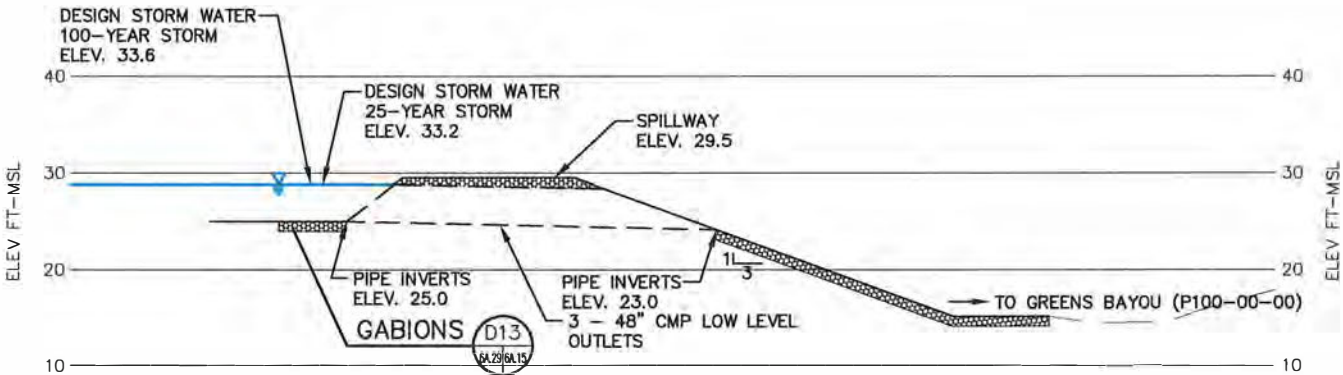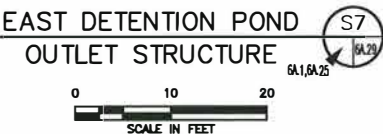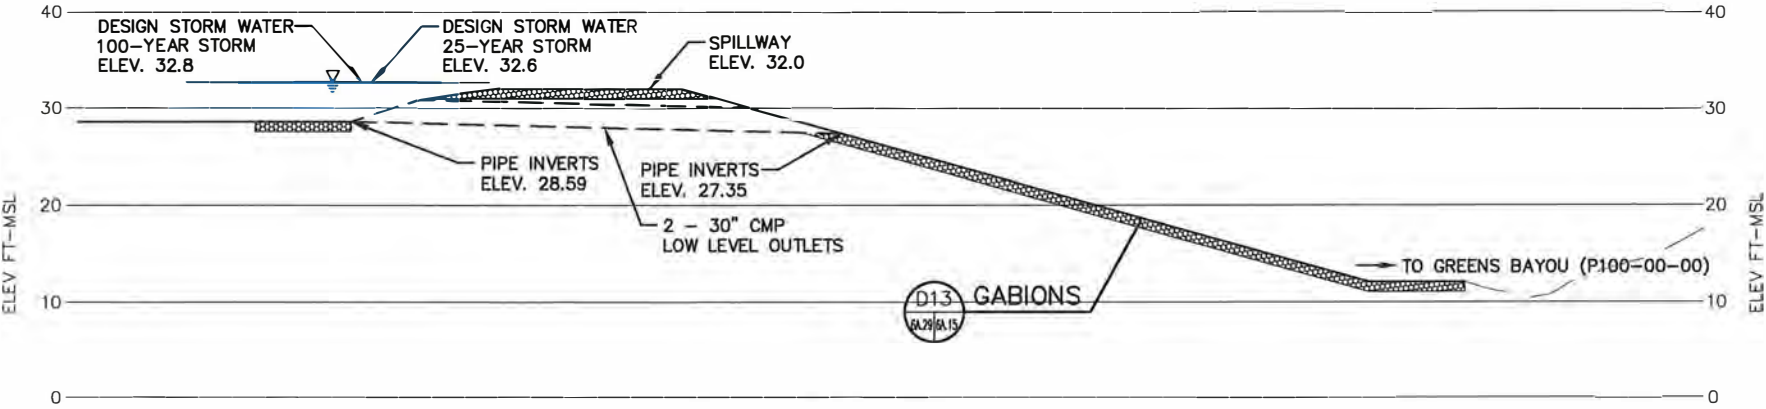


SOUTHEAST DETENTION POND	
BOTTOM ELEVATION	25.0 FT.
SPILLWAY ELEVATION	29.5 FT.
SPILLWAY LENGTH	60.0 FT.
PEAK 25-YEAR EVENT INFLOW	600.0 CFS
PEAK 25-YEAR EVENT OUTFLOW	423.0 CFS
PEAK 100-YEAR EVENT INFLOW	817.0 CFS
PEAK 100-YEAR EVENT OUTFLOW	564.0 CFS

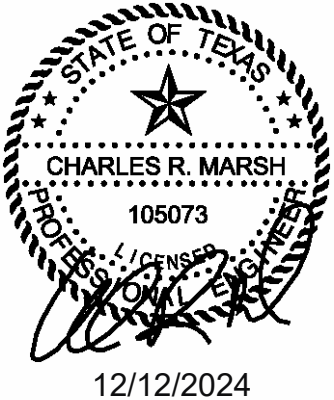


INDICATES REVISION  
(SEE LIST OF REVISIONS)

LIST OF REVISIONS:  
1. UPDATED DISCHARGE INFORMATION.

EAST DETENTION POND  
INFLOW AND OUTFLOW HYDROGRAPHS  
25-YEAR, 24 HOUR STORM EVENT

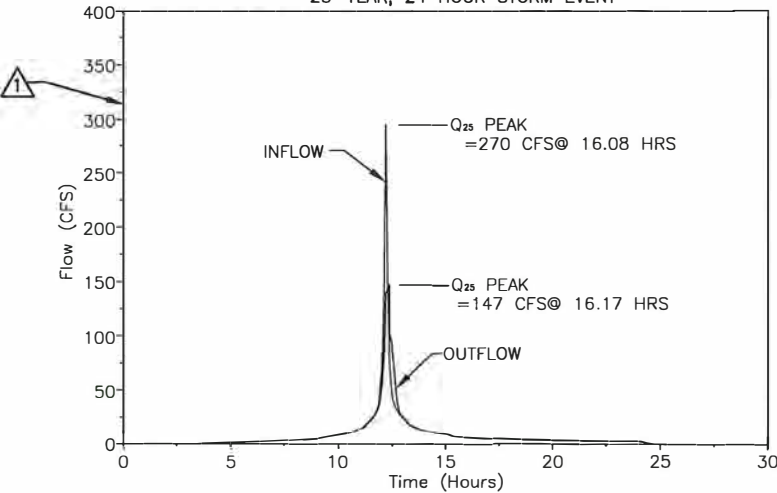


SOUTHEAST DETENTION POND  
INFLOW AND OUTFLOW HYDROGRAPHS  
25-YEAR, 24 HOUR STORM EVENT

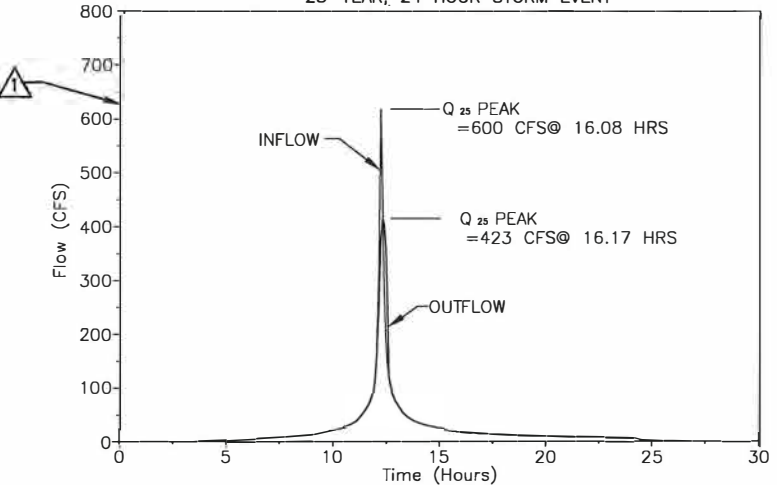

<input type="checkbox"/> DRAFT <input checked="" type="checkbox"/> FOR PERMITTING PURPOSES ONLY <input type="checkbox"/> ISSUED FOR CONSTRUCTION	PREPARED FOR <b>McCARTY ROAD LANDFILL TX, LP</b>	<b>MAJOR PERMIT AMENDMENT POND OUTLET STRUCTURE DETAILS</b>	
DATE: 03/2004 FILE: 0120-439-11 CAD: 6A-29 OUTLET EASE.DWG	DRAWN BY: JOW DESIGN BY: SAN/ALD REVIEWED BY: JPY		
Weaver Consultants Group TBPE REGISTRATION NO. F-3727		MAJOR PERMIT AMENDMENT POND OUTLET STRUCTURE DETAILS McCARTY ROAD LANDFILL HARRIS COUNTY, TEXAS WWW.WCGRP.COM ATTACHMENT 6A.29	



O:\0120\439\FLIP MOD 2024\ATT 6\6A\6A.29OUTLET EASE.dwg, rarrington, 1:2

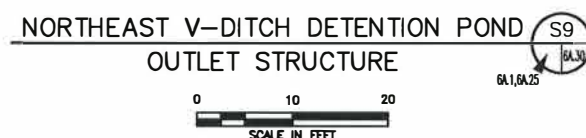

NORTHEAST V-DITCH	
BOTTOM ELEVATION	28.7 FT.
SPILLWAY ELEVATION	32 FT.
SPILLWAY LENGTH	50 FT.
PEAK 25-YEAR EVENT INFLOW	41 CFS
PEAK 25-YEAR EVENT OUTFLOW	32 CFS
PEAK 100-YEAR EVENT INFLOW	50 CFS
PEAK 100-YEAR EVENT OUTFLOW	42 CFS

 INDICATES REVISION  
(SEE LIST OF REVISIONS)


LIST OF REVISIONS:  
1. UPDATED DISCHARGE INFORMATION.

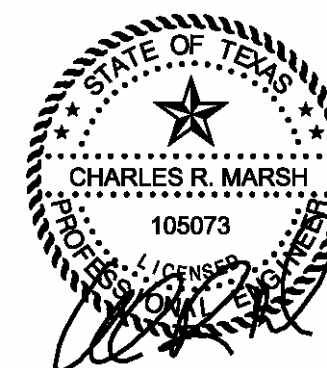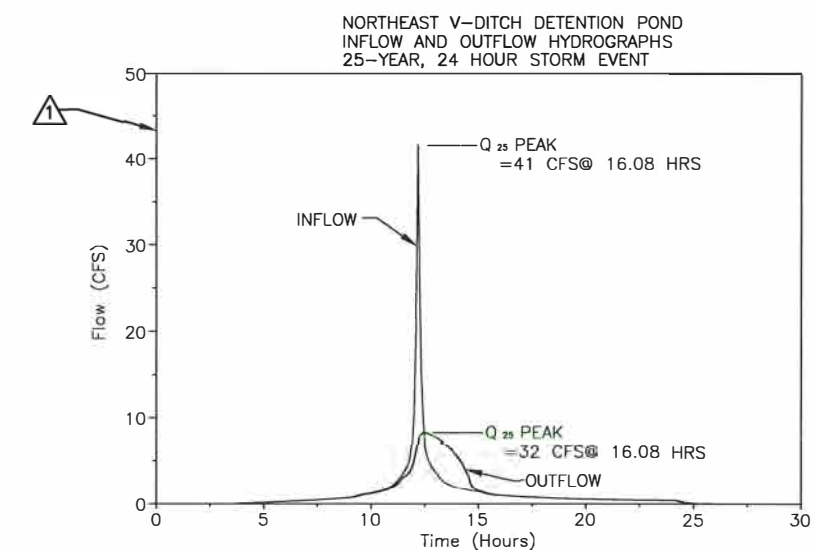

12/12/2024

**ATTACHMENT 6A**  
**APPENDIX 6A-B**  
**PERIMETER CHANNEL AND DETENTION POND DESIGN**

Includes pages 6A-B.1-1 through 6A-B.2B2-20

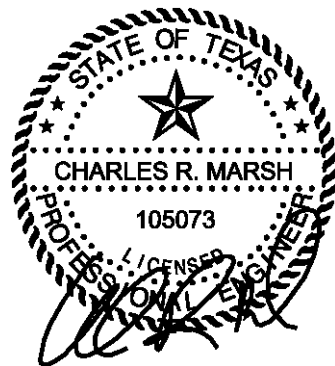

12/12/2024

McCARTY ROAD LANDFILL  
0120-439-11-03-11  
PERIMETER CHANNEL HYDRAULIC ANALYSIS  
100-YEAR NORMAL DEPTH CALCULATIONS

**Example Calculation:** Calculate the normal depth for Channel C between stations 2+59.2 and 9+02.7.

List of Symbols

$Q_d$  = design flow rate for channel, cfs  
 $R$  = hydraulic radius, ft  
 $n$  = Manning's roughness coefficient  
 $S$  = channel slope, ft/ft  
 $b$  = bottom width of channel, ft  
 $z$  = z-ratio (ratio of run to rise for channel sideslope)  
 $A_f$  = flow area, sf  
 $g$  = gravitational acceleration = 32.2 ft/s<sup>2</sup>  
 $T$  = top width of flow, ft  
 $d$  = normal depth of channel, ft

The program uses an iterative process to calculate the normal depth of the channel to satisfy Manning's Equation

$$Q = \frac{1.486}{n} A R^{0.67} S^{0.5}$$

Design Inputs:  $Q_d = 1427$  1551 cfs (from 100-year, 24-hour storm HEC-1 analysis, Attache)  
 $S = 0.002$  ft/ft  
 $b = 25$  ft  
 $z = 2$  (H) : 1 (V)  
 $n = 0.04$

Step 1 - Based on the geometry of the channel cross-section, solve for  $R$  and  $A_f$

$$R = \frac{bd + zd^2}{b + 2d(z^2 + 1)^{0.5}}$$

$$A_f = bd + zd^2$$

assume:  $d = 8.59$  7.68 ft

$R = 5.714$  5.223 ft

$A_f = 292.04$  310.10 sf

solve for Q:  $Q = 1427$  1551

if Q is not equal to  $Q_d$ , select a new d and repeat calculations

McCARTY ROAD LANDFILL  
0120-439-11-03-11  
PERIMETER CHANNEL HYDRAULIC ANALYSIS  
100-YEAR NORMAL DEPTH CALCULATIONS

Step 2 - solve for velocity, T, Froude number, velocity head, and energy head

$$Q = VA \Rightarrow V = Q/A$$

$$V = \frac{-4.89}{5.00} \text{ ft/s}$$

$$T = b + 2(z \times d)$$

$$T = \frac{-54.42}{55.73} \text{ ft}$$

$$F_r = \frac{V}{(gA/T)^{0.5}}$$

$$F_r = \frac{372}{0.374}$$

$$\text{Velocity Head} = \frac{V^2}{2g}$$

$$\text{Velocity Head} = \frac{0.37}{0.39} \text{ ft}$$

$$\text{Energy Head} = \text{water elevation} + \text{velocity head}$$

$$\text{Energy Head} = \frac{8.96}{8.07} \text{ ft}$$



**TRAPEZOIDAL CHANNEL ANALYSIS  
NORMAL DEPTH COMPUTATION**

**At the outfall of DCP-1**

**Permitted Conditions**

July 12, 2006

---

**PROGRAM INPUT DATA**

---

DESCRIPTION	VALUE
Flow Rate (cfs).....	1,101.0
Channel Bottom Slope (ft/ft).....	0.0016
Manning's Roughness Coefficient (n-value).....	0.03
Channel Left Side Slope (horizontal/vertical).....	3.0
Channel Right Side Slope (horizontal/vertical).....	3.0
Channel Bottom Width (ft).....	6.0

---

**COMPUTATION RESULTS**

---

DESCRIPTION	VALUE
Normal Depth (ft).....	7.6
Flow Velocity (fps).....	5.03
Froude Number.....	0.431
Velocity Head (ft).....	0.39
Energy Head (ft).....	7.99
Cross-Sectional Area of Flow (sq ft).....	218.83
Top Width of Flow (ft).....	51.59

---

HYDROCALC Hydraulics for Windows, Version 1.2a Copyright (c) 1996  
Dodson & Associates, Inc., 5629 FM 1960 West, Suite 314, Houston, TX 77069  
Phone:(281)440-3787, Fax:(281)440-4742, Email: [REDACTED]  
All Rights Reserved.

**TRAPEZOIDAL CHANNEL ANALYSIS  
NORMAL DEPTH COMPUTATION**

**At the outfall of BSD-2**

**Permitted Conditions**

**July 12, 2006**

---

PROGRAM INPUT DATA

DESCRIPTION	VALUE
Flow Rate (cfs).....	1,023.0
Channel Bottom Slope (ft/ft) .....	0.0016
Manning's Roughness Coefficient (n-value).....	0.03
Channel Left Side Slope (horizontal/vertical) .....	3.0
Channel Right Side Slope (horizontal/vertical) .....	3.0
Channel Bottom Width (ft).....	6.0

---

COMPUTATION RESULTS


DESCRIPTION	VALUE
Normal Depth (ft) .....	7.37
Flow Velocity (fps) .....	4.94
Froude Number .....	0.429
Velocity Head (ft) .....	0.38
Energy Head (ft) .....	7.75
Cross-Sectional Area of Flow (sq ft) .....	207.11
Top Width of Flow (ft) .....	50.21

---

HYDROCALC Hydraulics for Windows, Version 1.2a Copyright (c) 1996  
Dodson & Associates, Inc., 5629 FM 1960 West, Suite 314, Houston, TX 77069  
Phone:(281)440-3787, Fax:(281)440-4742, Email [REDACTED]  
All Rights Reserved.

**ATTACHMENT 6A**  
**APPENDIX 6A-C**  
**FINAL COVER EROSION CONTROL STRUCTURE DESIGN**

Includes pages 6A-C-1 through 6A-C-32

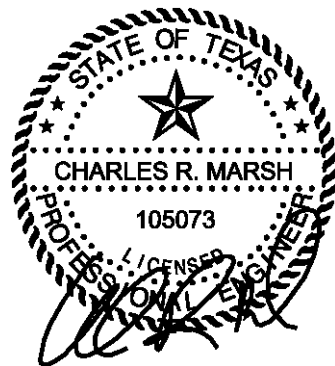

12/12/2024

Prep By: VG  
Date: 11/26/2024

McCARTY ROAD LANDFILL  
0120-439-11-03-11  
EROSION CONTROL STRUCTURE DESIGN  
GABION-LINED CHUTE DESIGN  
100-YEAR, 24 HOUR STORM

Chkd By: CRM  
Date: 11/26/2024

Chute	Q <sup>1</sup>		W	q		Y <sub>C</sub>		Y <sub>O</sub>		y <sub>i</sub>		K <sub>1</sub>		K <sub>2</sub>	
1	307	345	30	10.23	11.50	1.48	1.60	0.70	0.75	1.65	1.78	3.24	3.52	0.91	0.98
2	287	301	30	9.57	10.03	1.42	1.46	0.67	0.69	1.58	1.63	3.09	3.20	0.87	0.90
3	232	210	25	9.28	8.40	1.39	1.30	0.66	0.62	1.55	1.45	3.03	2.82	0.85	0.80
4	242	252	25	9.68	10.08	1.43	1.47	0.67	0.69	1.59	1.63	3.12	3.21	0.88	0.90
5	92		20	4.60		0.87		0.43		0.97		1.84		0.53	
6	346	341	40	8.65	8.53	1.32	1.31	0.63	0.62	1.47	1.46	2.88	2.85	0.81	0.81
7	371	365	40	9.28	9.13	1.39	1.37	0.66	0.65	1.55	1.53	3.03	2.99	0.85	0.84
8	344	342	35	9.83	9.77	1.44	1.44	0.68	0.68	1.61	1.60	3.15	3.14	0.89	0.88
9	246	250	30	8.20	8.34	1.28	1.29	0.61	0.62	1.42	1.44	2.77	2.81	0.79	0.79
10	294	292	30	9.80	9.72	1.44	1.43	0.68	0.67	1.60	1.59	3.15	3.13	0.88	0.88
11	177	176	20	8.85	8.80	1.34	1.34	0.64	0.64	1.50	1.49	2.93	2.92	0.83	0.82
12	260	257	30	8.67	8.56	1.33	1.31	0.63	0.62	1.48	1.46	2.88	2.86	0.82	0.81
13	400	394	40	10.00	9.85	1.46	1.44	0.69	0.68	1.62	1.61	3.19	3.16	0.90	0.89
14	303	306	35	8.66	8.75	1.33	1.33	0.63	0.63	1.48	1.49	2.88	2.90	0.81	0.82
15	270	272	30	9.00	9.07	1.36	1.37	0.64	0.65	1.51	1.52	2.96	2.98	0.84	0.84
16	268	254	30	8.93	8.47	1.35	1.31	0.64	0.62	1.51	1.45	2.95	2.84	0.83	0.80
17	434	431	40	10.85	10.78	1.54	1.53	0.72	0.72	1.72	1.71	3.38	3.37	0.95	0.94



McCARTY ROAD LANDFILL  
0120-439-11-03-11  
CHUTE ANALYSIS  
NORMAL DEPTH CALCULATIONS  
25-YEAR, 24 HOUR STORM

Drainage Area	Flow Rate (cfs)	Bottom Slope (ft/ft)	Manning's n	Side Slope (left)	Side Slope (right)	Bottom Width (ft)	Normal Depth (ft)		Flow Vel. (fps)		Froude Number		Velocity Head (ft)		Energy Head (ft)		Flow Area (sf)		Flow Top Width (ft)	
DA1	227	0.25	0.04	4.0	4.0	24.0	0.65		13.09		2.995	3.00	2.66		3.31		17.34		29.21	
DA2	215 214	0.25	0.04	4.0	4.0	24.0	0.63	0.63	12.84	12.82	2.982	2.980	2.56	2.55	3.19	3.18	16.74	16.69	29.05	29.04
DA3	172 162	0.25	0.04	4.0	4.0	24.0	0.55	0.53	11.85	11.60	2.925	2.909	2.18	2.09	2.74	2.62	14.51	13.97	28.43	28.28
DA4	178 169	0.25	0.04	4.0	4.0	24.0	0.56	0.55	12.00	11.78	2.933	2.920	2.24	2.16	2.80	2.70	14.83	14.35	28.52	28.38
DA5	69 66	0.25	0.04	4.0	4.0	12.0	0.48	0.47	10.39	10.23	2.825	2.815	1.68	1.63	2.15	2.09	6.64	6.45	15.82	15.72
DA5	69 66	0.25	0.04	4.0	4.0	24.0	0.32	0.31	8.45	8.31	2.687	2.675	1.11	1.07	1.43	1.39	8.17	7.95	26.58	26.52
DA6	256 247	0.25	0.04	4.0	4.0	12.0	1.00	0.98	15.91	15.74	3.129	3.123	3.93	3.85	4.94	4.84	16.09	15.69	20.04	19.88
DA6	256 247	0.25	0.04	4.0	4.0	24.0	0.70	0.68	13.66	13.49	3.026	3.017	2.90	2.83	3.60	3.51	18.74	18.31	29.59	29.48
DA7	267 273	0.25	0.04	4.0	4.0	12.0	1.03	1.04	16.12	16.23	3.140	3.145	4.04	4.09	5.07	5.13	16.56	16.82	20.22	20.33
DA7	267 273	0.25	0.04	4.0	4.0	24.0	0.72	0.73	13.86	13.97	3.037	3.043	2.99	3.03	3.70	3.76	19.26	19.54	29.73	29.81
DA8	248 246	0.25	0.04	4.0	4.0	12.0	0.99	0.98	15.76	15.72	3.124	3.122	3.86	3.84	4.85	4.82	15.74	15.65	19.89	19.86
DA8	248 246	0.25	0.04	4.0	4.0	24.0	0.69	0.68	13.51	13.47	3.018	3.016	2.84	2.82	3.52	3.50	18.36	18.26	29.49	29.47
DA9	193 180	0.25	0.04	4.0	4.0	12.0	0.86	0.83	14.57	14.25	3.065	3.049	3.30	3.16	4.16	3.98	13.25	12.63	18.87	18.60
DA9	193 180	0.25	0.04	4.0	4.0	24.0	0.59	0.57	12.35	12.05	2.954	2.936	2.37	2.26	2.96	2.82	15.62	14.94	28.74	28.55
DA10	216 211	0.25	0.04	4.0	4.0	12.0	0.91	0.90	15.11	15.00	3.095	3.090	3.55	3.50	4.46	4.40	14.30	14.07	19.31	19.21
DA10	216 211	0.25	0.04	4.0	4.0	24.0	0.63	0.62	12.86	12.75	2.983	2.977	2.57	2.53	3.20	3.15	16.79	16.54	29.06	28.99
DA11	131 127	0.25	0.04	4.0	4.0	12.0	0.69	0.68	12.86	12.73	2.974	2.967	2.57	2.52	3.26	3.20	10.18	9.97	17.52	17.42
DA11	131 127	0.25	0.04	4.0	4.0	24.0	0.47	0.46	10.74	10.60	2.856	2.841	1.79	1.75	2.26	2.21	12.20	11.98	27.77	27.71
DA12	195 185	0.25	0.04	4.0	4.0	12.0	0.86	0.84	14.62	14.37	3.067	3.055	3.32	3.21	4.18	4.05	13.34	12.87	18.91	18.71
DA12	195 185	0.25	0.04	4.0	4.0	24.0	0.60	0.58	12.40	12.17	2.957	2.943	2.39	2.30	2.99	2.88	15.73	15.20	28.77	28.62
DA13	297 285	0.25	0.04	4.0	4.0	12.0	1.09	1.07	16.65	16.44	3.163	3.154	4.31	4.20	5.40	5.27	17.84	17.33	20.72	20.53
DA13	297 285	0.25	0.04	4.0	4.0	24.0	0.76	0.74	14.39	14.19	3.065	3.054	3.22	3.13	3.98	3.87	20.63	20.09	30.10	29.96
DA14	213 220	0.25	0.04	4.0	4.0	12.0	0.91	0.92	15.04	15.19	3.092	3.098	3.52	3.59	4.42	4.51	14.16	14.48	19.25	19.38
DA14	213 220	0.25	0.04	4.0	4.0	24.0	0.63	0.64	12.80	12.95	2.979	2.987	2.54	2.60	3.17	3.24	16.64	16.99	29.02	29.12
DA15	207 196	0.25	0.04	4.0	4.0	12.0	0.89	0.87	14.91	14.64	3.086	3.069	3.45	3.33	4.35	4.20	13.88	13.39	19.14	18.93
DA15	207 196	0.25	0.04	4.0	4.0	24.0	0.62	0.60	12.67	12.42	2.972	2.958	2.49	2.40	3.11	3.00	16.34	15.78	28.94	28.78
DA16	206 187	0.25	0.04	4.0	4.0	12.0	0.89	0.84	14.89	14.42	3.084	3.058	3.44	3.23	4.33	4.08	13.84	12.97	19.12	18.75
DA16	206 187	0.25	0.04	4.0	4.0	24.0	0.62	0.58	12.65	12.21	2.971	2.946	2.48	2.32	3.10	2.90	16.29	15.31	28.92	28.65
DA17	309 308	0.25	0.04	4.0	4.0	12.0	1.11	1.11	16.85	16.83	3.172	3.171	4.41	4.40	5.53	5.51	18.34	18.30	20.92	20.90
DA17	309 308	0.25	0.04	4.0	4.0	24.0	0.78	0.78	14.59	14.58	3.075	3.074	3.31	3.30	4.09	4.08	21.17	21.13	30.25	30.23

Note: Calculations were performed using the HYDROCALC HYDRAULICS program developed by Dodson and Associates (Version 1.2a- 2.0.1, 1996).

McCARTY ROAD LANDFILL  
0120-439-11-03-11  
CHUTE ANALYSIS  
NORMAL DEPTH CALCULATIONS  
25-YEAR, 24 HOUR STORM

**Example Calculation:** Calculate the normal depth for the chute for DA10.

List of Symbols

$Q_d$  = design flow rate for channel, cfs  
 $R$  = hydraulic radius, ft  
 $n$  = Manning's roughness coefficient  
 $S$  = channel slope, ft/ft  
 $b$  = bottom width of channel, ft  
 $z$  = z-ratio (ratio of run to rise for channel sideslope)  
 $A_f$  = flow area, sf  
 $g$  = gravitational acceleration = 32.2 ft/s<sup>2</sup>  
 $T$  = top width of flow, ft  
 $d$  = normal depth of chute, ft

The program uses an iterative process to calculate the normal depth of the chute to satisfy Manning's Equation

$$Q = \frac{1.486}{n} A R^{0.67} S^{0.5}$$

Design Inputs:

$Q_d$ =	246	211	cfs (from HEC-1 HEC-HMS analysis, Attachment 6A-A)
$S$ =	0.25		ft/ft
$b$ =	12		ft
$z$ =	4		(H) : 1 (V)
$n$ =	0.04		

Step 1 - Based on the geometry of the chute cross-section, solve for  $R$  and  $A_f$

$$R = \frac{bd + zd^2}{b + 2d(z^2 + 1)^{0.5}}$$

$$A_f = bd + zd^2$$

assume:  $d$  = 0.91 0.90 ft

$R$  = 0.000 0.724 ft

$A_f$  = 9.81 14.07 sf

solve for  $Q$ :  $Q$  = 148 211 cfs

McCARTY ROAD LANDFILL  
0120-439-11-03-11  
CHUTE ANALYSIS  
NORMAL DEPTH CALCULATIONS  
25-YEAR, 24 HOUR STORM

if Q is not equal to  $Q_d$ , select a new d and repeat calculations

Step 2 - solve for velocity, T, Froude number, velocity head, and energy head

$$Q = VA \Rightarrow$$

$$V = Q/A$$

$$V = \frac{42.63}{15.00} \text{ ft/s}$$

$$T = b + 2(z \times d)$$

$$T = \frac{47.35}{19.21} \text{ ft}$$

$$F_r = \frac{V}{(gA/T)^{0.5}}$$

$$F_r = \frac{2.962}{3.090} \text{ ft}$$

$$\text{Velocity Head} = \frac{V^2}{2g}$$

$$\text{Velocity Head} = \frac{2.48}{3.50} \text{ ft}$$

$$\text{Energy Head} = \text{water elevation} + \text{velocity head}$$

$$\text{Energy Head} = \frac{3.39}{4.40} \text{ ft}$$




**ATTACHMENT 6A**

**APPENDIX 6A-G**


**EROSION CONTROL PLAN FOR ALL PHASES  
OF LANDFILL OPERATION**

Includes Pages 6A-G-1 through 6A-G-7

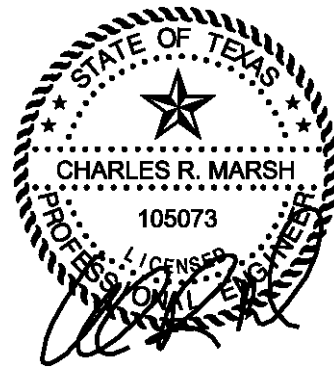


12/12/2024


0:\0120\439\FLIP MOD 2024\ECF\FIG 2-SWALE DESIGN.dwg, rarrington, 1:2

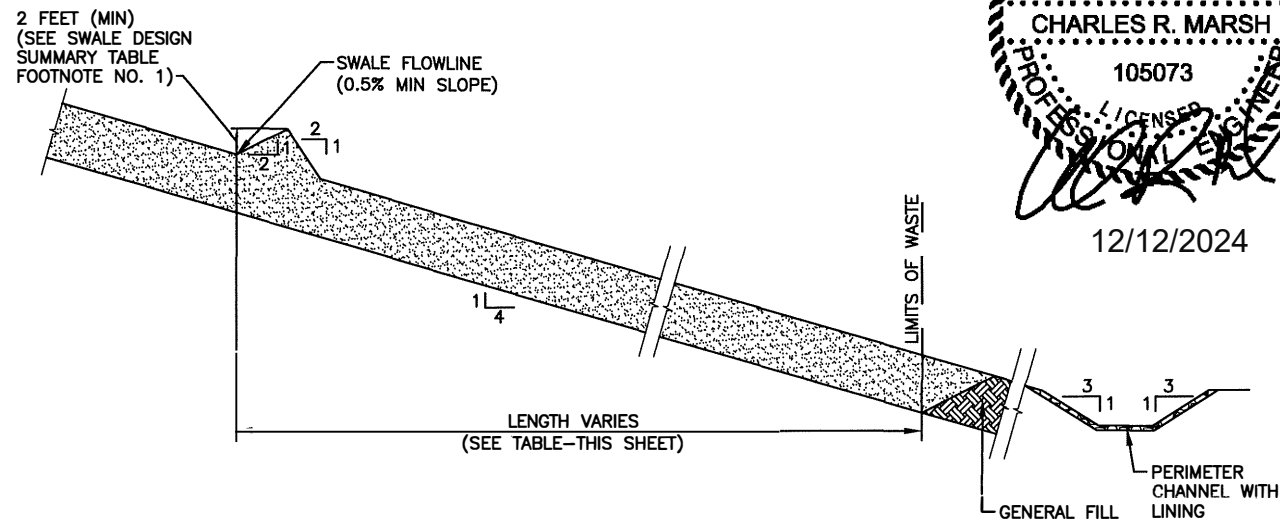

A  
1 2  
SIDE SLOPE DRAINAGE SWALE

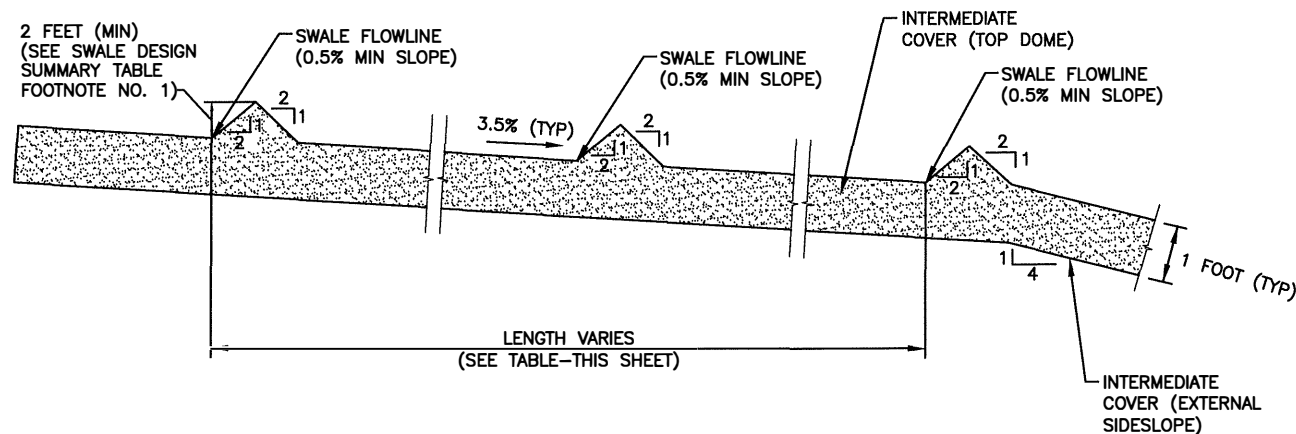

A  
1 2  
TOP DOME SURFACE DRAINAGE SWALE

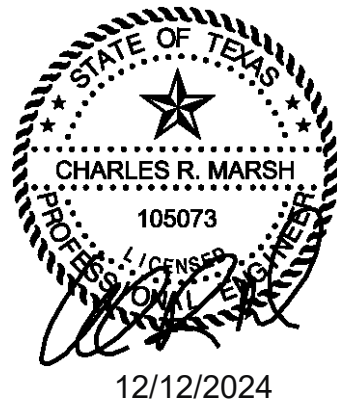

SWALE DESIGN SUMMARY<sup>1</sup>

SIDE SLOPE (4H:1V)				TOP SLOPE (3.5%)			
VEGETATIVE COVER PERCENTAGE	DISTANCE BETWEEN SWALES (FT)	ESTIMATED SOIL LOSS (TONS/ACRE/YEAR)	ADDITIONAL SEDIMENT CAPTURE REQUIRED <sup>2</sup>	VEGETATIVE COVER PERCENTAGE	DISTANCE BETWEEN SWALES (FT)	ESTIMATED SOIL LOSS (TONS/ACRE/YEAR)	ADDITIONAL SEDIMENT CAPTURE REQUIRED <sup>2</sup>
60	300	23.9	NO	60	500	1.4	NO
70	300	9.7	NO	70	500	0.6	NO
80	300	7.4	NO	80	500	0.4	NO
90	300	3.6	NO	90	500	0.2	NO
70	400	11.2	NO	60	600	1.5	NO
80	400	8.5	NO	70	600	0.6	NO
90	400	4.2	NO	80	600	0.5	NO
70	500	12.2	NO	90	600	0.2	NO
80	500	9.3	NO	60	700	1.6	NO
90	500	4.6	NO	70	700	0.6	NO
70	600	13.6	NO	80	700	0.5	NO
80	600	10.4	NO	90	700	0.2	NO
90	600	5.1	NO				
70	700	14.7	NO				
80	700	11.2	NO				
90	700	5.5	NO				
70	800	15.8	NO				
80	800	12.1	NO				
90	800	5.9	NO				

<sup>1</sup> REFER TO APPENDIX 6A-G-1 FOR SUPPORTING CALCULATIONS.

<sup>2</sup> IF SITE SPECIFIC CONDITIONS YIELD A MAXIMUM HORIZONTAL DISTANCE BETWEEN THE TOE OF THE SLOPE AND GRADE BREAK OF LESS THAN 300 FEET FOR SIDE SLOPES AND A DISTANCE OF 500 FEET FROM THE GRADE BREAK TO THE PEAK OF THE TOP SLOPES, ESTABLISHMENT OF 60% VEGETATION WILL BE SUFFICIENT MEANS OF EROSION CONTROL WITHOUT THE ADDITION OF TEMPORARY SWALES AND LETDOWNS GIVEN THAT THE TOTAL SOIL LOSS FOR THE SIDE SLOPE IS LESS THAN 50 TONS/ACRE/YEAR AND THE TOP SLOPE IS LESS THAN 50 TONS/ACRE/YEAR.

SWALE DRAINAGE AREA SUMMARY

CONDITION (SWALE HEIGHT)	MAXIMUM DRAINAGE AREA (ACRES)	MINIMUM SWALE SPACING <sup>1</sup> (FEET)	MAXIMUM SWALE LENGTH <sup>2</sup> (FEET)
TOP SLOPE (2 FT SWALE)	26.9	500	2,343
TOP SLOPE (1.5 FT SWALE)	12.5	500	1,089
TOP SLOPE (1 FT SWALE)	4.5	500	392
SIDE SLOPE (2 FT SWALE)	5.0	300	726

<sup>1</sup> MINIMUM SWALE SPACING IS OBTAINED FROM THE CALCULATIONS PROVIDED ON PAGE 6A-G-1-9.

<sup>2</sup> MAXIMUM SWALE LENGTH CALCULATED USING THE FOLLOWING EQUATION:

$$\text{MAXIMUM DRAINAGE AREA} \times (43,560 \text{ SF/ACRE}) / \text{MINIMUM SWALE SPACING}$$

LEGEND

INDICATES REVISION  
(SEE LIST OF REVISIONS)

LIST OF REVISIONS:

1. REVISED SWALE CALCULATIONS.

<input type="checkbox"/> DRAFT <input checked="" type="checkbox"/> FOR PERMITTING PURPOSES ONLY <input type="checkbox"/> ISSUED FOR CONSTRUCTION	PREPARED FOR <b>MCCARTY ROAD LANDFILL TX, LP</b>	<b>EROSION CONTROL PLAN SWALE DESIGN SUMMARY</b>  McCARTY ROAD LANDFILL HARRIS COUNTY, TEXAS	
DATE: 01/2010 FILE: 0120-439-11 CAD: FIG 2-SWALE DESIGN.DWG	DRAWN BY: SRF DESIGN BY: BJL REVIEWED BY: JPY		REVISIONS
Weaver Consultants Group TBPE REGISTRATION NO. F-3727			NO. DATE DESCRIPTION
			1 01/2010 PERMIT MODIFICATION 2 12/2024 SEE LIST OF REVISIONS
WWW.WCGRP.COM		FIGURE 2	



### OPEN CHANNEL GEOMEMBRANE LETDOWN DESIGN SUMMARY

DESIGN IS APPLICABLE FOR A DRAINAGE AREA UP TO 35 ACRES (TOP DECK AND SIDE SLOPE).  
25% SLOPE  
MAXIMUM FLOW DEPTH = 0.62 FT.  
BOTTOM WIDTH = 8 FT.  
3.5% SLOPE  
MAXIMUM FLOW DEPTH = 1.08 FT.  
BOTTOM WIDTH = 8 FT.

### OPEN CHANNEL GABION LETDOWN DESIGN SUMMARY

DESIGN IS APPLICABLE FOR A DRAINAGE AREA UP TO 25 ACRES (TOP DECK AND SIDE SLOPE).  
25% SLOPE  
MAXIMUM FLOW DEPTH = 1.36 FT.  
BOTTOM WIDTH = 8 FT.  
3.5% SLOPE  
MAXIMUM FLOW DEPTH = 1.94 FT.  
BOTTOM WIDTH = 8 FT.

### OPEN CHANNEL ROCK RIPRAP LETDOWN DESIGN SUMMARY


DESIGN IS APPLICABLE FOR A DRAINAGE AREA UP TO 25 ACRES (TOP DECK ONLY).  
3.5% SLOPE  
MAXIMUM FLOW DEPTH = 1.94 FT.  
BOTTOM WIDTH = 8 FT.

### OPEN CHANNEL GROUTED RIPRAP LETDOWN DESIGN SUMMARY

DESIGN IS APPLICABLE FOR A DRAINAGE AREA UP TO 25 ACRES (TOP DECK) AND 35 ACRES (SIDE SLOPE).  
25% SLOPE  
MAXIMUM FLOW DEPTH = 1.36 FT.  
BOTTOM WIDTH = 8 FT.  
3.5% SLOPE  
MAXIMUM FLOW DEPTH = 1.94 FT.  
BOTTOM WIDTH = 8 FT.


### OPEN CHANNEL TURF REINFORCEMENT LETDOWN DESIGN SUMMARY

DESIGN IS APPLICABLE FOR A DRAINAGE AREA UP TO 35 ACRES (TOP DECK AND SIDE SLOPE).  
25% SLOPE  
MAXIMUM FLOW DEPTH = 1.36 FT.  
BOTTOM WIDTH = 8 FT.  
3.5% SLOPE  
MAXIMUM FLOW DEPTH = 1.99 FT.  
BOTTOM WIDTH = 8 FT.

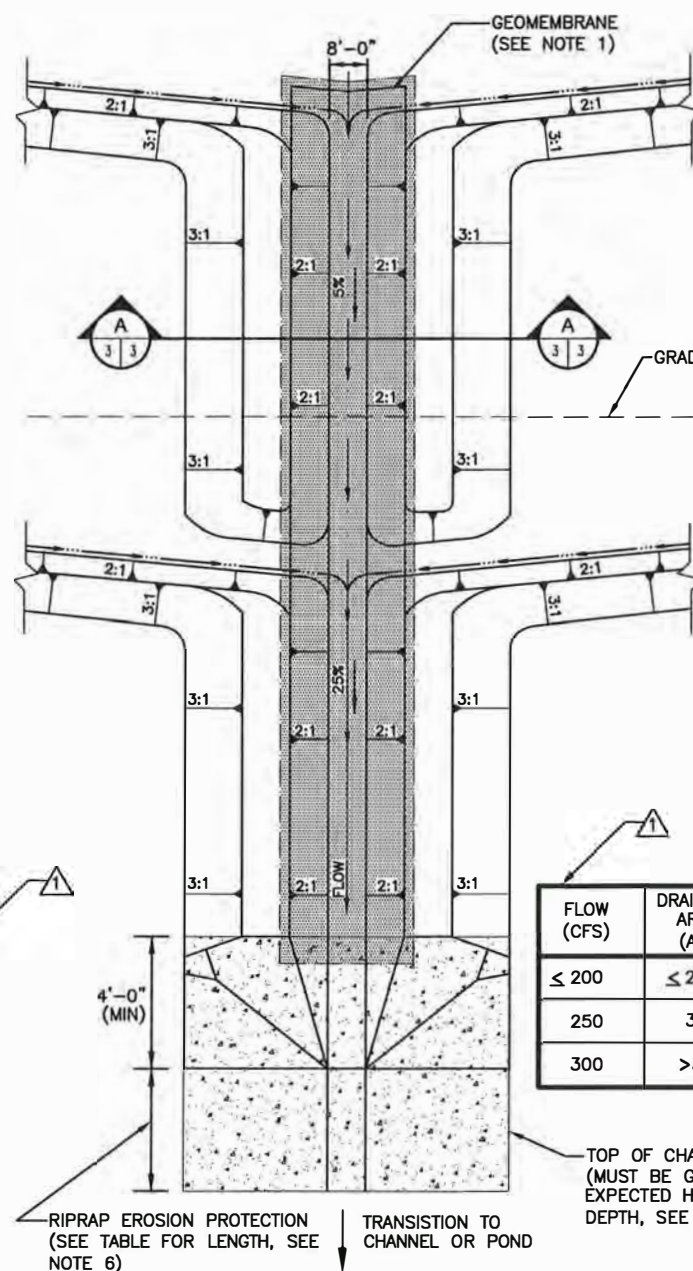


TEMPORARY OPEN CHANNEL LETDOWN

0 20 40  
SCALE IN FEET

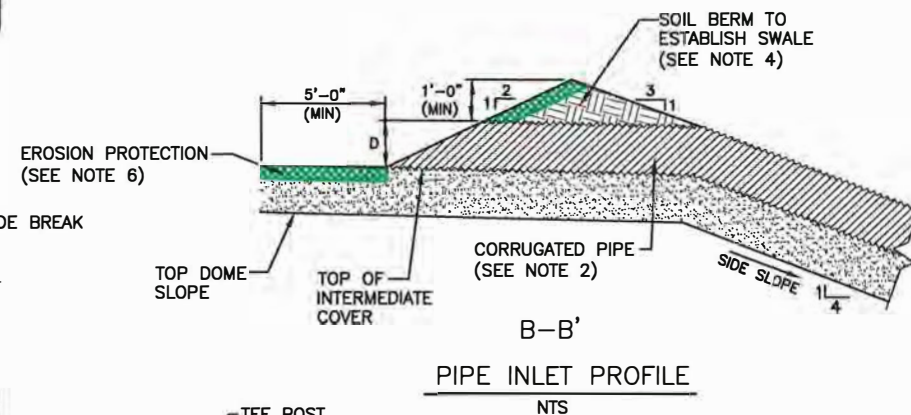


B-B'  
PIPE INLET PROFILE  
NTS

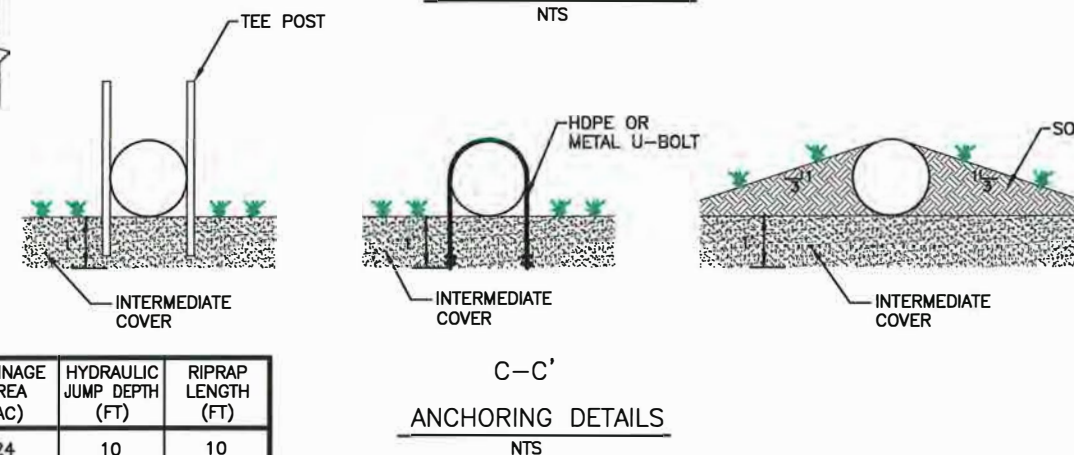

C-C'  
ANCHORING DETAILS  
NTS


FLOW (CFS)	DRAINAGE AREA (AC)	HYDRAULIC JUMP DEPTH (FT)	RIPRAP LENGTH (FT)
≤ 200	≤ 24	10	10
250	32	16	16
300	>35	25	25

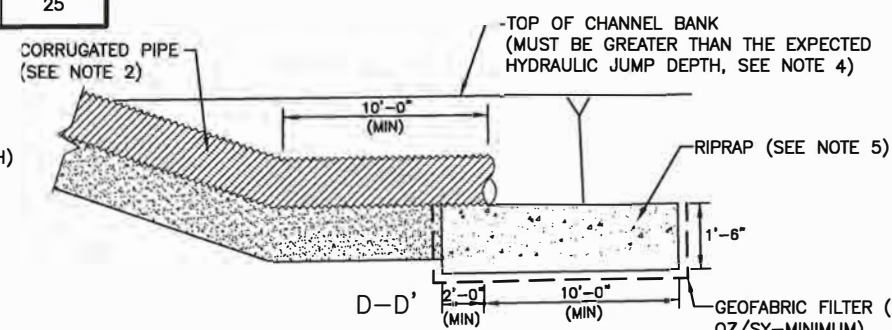

D-D'  
PIPE OUTLET PROFILE  
(SEE NOTE 3)  
NTS

PIPE LETDOWN DESIGN SUMMARY* (USE OF PIPE LETDOWN IS LIMITED TO 1-INLET)		
DRAINAGE AREA (ACRE)	DESIGN FLOW RATE (CFS)	REQUIRED PIPE DIAMETER (FT)
2.0	16.0	2
2.7	21.0	3

\*SEE NOTE 4

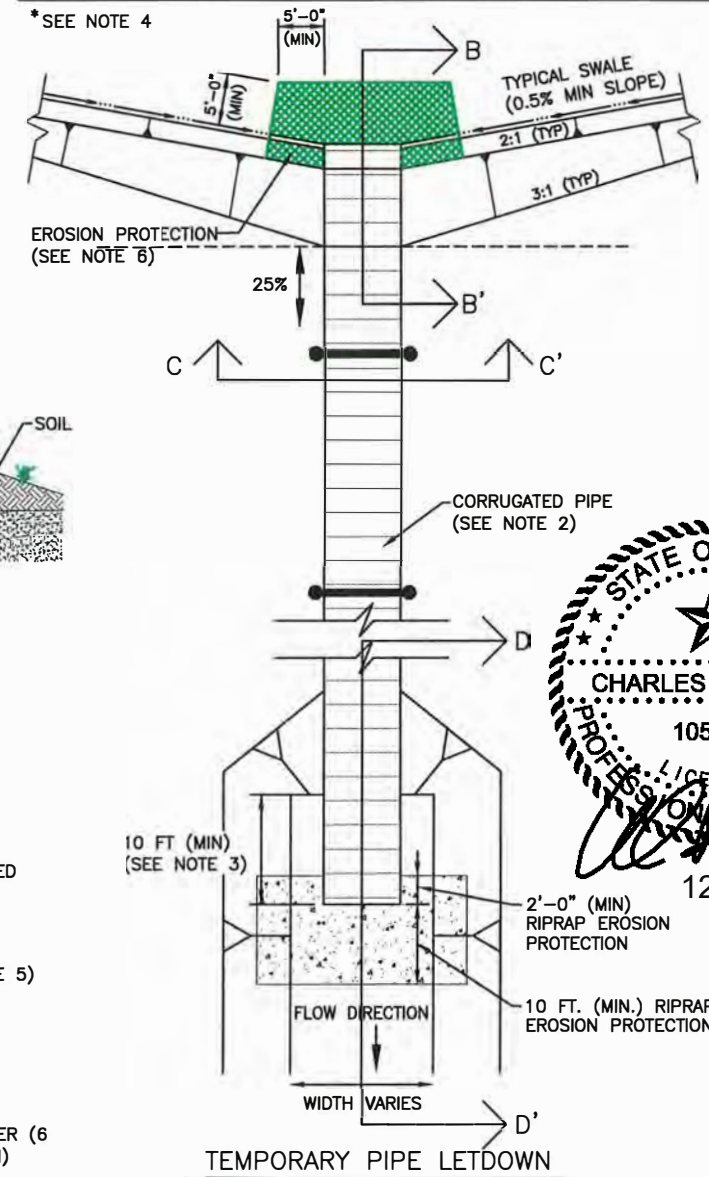

TEMPORARY PIPE LETDOWN  
NTS



#### NOTES:

- GEOMEMBRANE TEXTURED ON BOTH SIDES WILL BE USED FOR GEOMEMBRANE LETDOWN LINING. AS AN ALTERNATIVE, TEMPORARY LETDOWN CAN BE LINED WITH GABIONS, GROUTED CONCRETE RIPRAP, TURF REINFORCEMENT MAT, OR ROCK RIPRAP.
- PIPE DRAINAGE LETDOWN WILL BE ANCHORED BY USING SOIL BERM AT THE INLET LOCATED WITHIN THE SWALE. ADDITIONAL ANCHORING ON THE SIDE SLOPE MAY BE PROVIDED USING SOIL, HDPE, METAL U-BOLTS, T-POSTS OR EQUIVALENT MATERIALS.
- PIPE WILL BE EXTENDED INTO THE CHANNEL TO MINIMIZE EROSION.
- PIPE LETDOWNS WILL BE LIMITED TO 1 INLET PER LETDOWN. SOIL BERMS AROUND THE PIPE INLET WILL BE EXTENDED A MINIMUM 1-FOOT ABOVE THE LETDOWN PIPE INLET. REFER TO PAGE 6A-G-2-9 FOR HYDRAULIC ANALYSIS.
- RIPRAP APRON DESIGN IS PROVIDED ON PAGES 6A-G-2-19 AND 20.  $D_{90}$  FOR RIPRAP IS 5-INCHES MINIMUM.
- RIPRAP, GROUTED RIPRAP, GABIONS, GEOMEMBRANE, EXISTING VEGETATION, OR TURF REINFORCEMENT MAY BE USED FOR INLET EROSION PROTECTION.
- REFER TO PAGE 6A-G-2-5A FOR EROSION PROTECTION DESIGN. IF LETDOWN DISCHARGES TO A POND, 10 FEET OF RIPRAP WILL BE SUFFICIENT.

#### LEGEND

INDICATES REVISION  
(SEE LIST OF REVISIONS)

#### LIST OF REVISIONS:

- REVISED LETDOWN CALCULATIONS.

- ☐ DRAFT  
☒ FOR PERMITTING PURPOSES ONLY  
☐ ISSUED FOR CONSTRUCTION

DATE: 05/2010  
FILE: 0120-439-11  
CAD: FIG 3-LETDOWN DESIGN.DWG

DRAWN BY: SRP  
DESIGN BY: BJL  
REVIEWED BY: JPY

Weaver Consultants Group  
TBPE REGISTRATION NO. F-3727

PREPARED FOR  
McCARTY ROAD LANDFILL TX, LP

REVISIONS		
NO.	DATE	DESCRIPTION
1	01/2010	1ST TCEQ COMMENT RESPONSE
2	05/2010	PERMIT MODIFICATION
3	12/2024	SEE LIST OF REVISIONS


### EROSION CONTROL PLAN LETDOWN DESIGN SUMMARY

McCARTY ROAD LANDFILL  
HARRIS COUNTY, TEXAS

WWW.WCGRP.COM

FIGURE 3



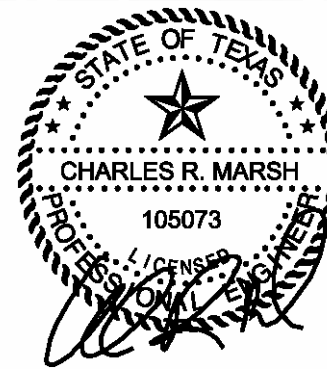

EXAMPLE CALCULATION

REQUIRED POND SIZE = EXTERNAL EMBANKMENT AREA X POND AREA REQUIRED/  
(ACRES) UNIT DRAINAGE AREA FACTOR

EXTERNAL EMBANKMENT AREA DRAINING TO POND = 50 ACRES

ADDITIONAL UPLAND AREA DRAINING TO POND = 0 ACRES (SEE NOTE 1)

REQUIRED SEDIMENT REMOVAL FROM = 80 TONS/ACRE/YEAR TO 50 TONS/ACRE/YEAR  
EXTERNAL SIDE SLOPE AREA

POND AREA REQUIRED/UNIT DRAINAGE AREA FACTOR = 0.105  
(FROM TABLE BELOW)


REQUIRED POND SIZE = 50 ACRES X 0.105 = 5.25 ACRES

SIZE OF POND REQUIRED <sup>1</sup>		
REQUIRED SEDIMENT REMOVAL (TONS/ACRE/YEAR)	POND AREA REQUIRED/ UNIT DRAINAGE AREA FACTOR	EFFICIENCY OF POND (DYNAMIC AND QUIESCENT)
60 TO 50	0.040	18.0%
70 TO 50	0.070	29.3%
80 TO 50	0.105	37.3%
90 TO 50	0.125	43.8%
100 TO 50	0.140	51.9%
200 TO 50	0.375	75.3%

<sup>1</sup> REFER TO APPENDIX 6A-G-3 FOR MORE INFORMATION. THE POND DESIGN AND DEMONSTRATION ARE PROVIDED TO ENSURE THAT SEDIMENT DISCHARGE FROM THE SITE WILL BE PREVENTED DURING INITIAL ESTABLISHMENT OF VEGETATION OVER THE SIDESLOPES AND TOP DOME SURFACES.

NOTES:

- EXAMPLE POND CONFIGURATION IS SHOWN. THE POND WILL BE LOCATED WITHIN THE PERMIT BOUNDARY. A DEMONSTRATION WILL BE INCLUDED IN THE SITE OPERATING RECORD TO SHOW THAT THE POND HAS THE CAPABILITY TO CAPTURE SEDIMENT SUCH THAT DISCHARGE IS LESS THAN OR EQUAL TO 50 TONS/ACRE/YEAR FROM THE EXTERNAL SIDE SLOPE AND TOP DOME AREA. THE DEMONSTRATION WILL ACCOUNT FOR THE ADDITIONAL SEDIMENT CREATED BY THE UPLAND AREA THAT FLOWS TO THE POND. FOR DEMONSTRATION PURPOSES, THE POND DEPTH WILL BE AN AVERAGE OF 4 FEET. OVERALL SEDIMENT DISCHARGE FROM THE SITE MUST COMPLY WITH THE CURRENT TPDES PERMIT FOR THE SITE.
- EXCAVATED FUTURE CELL AREAS OR SOIL BORROW AREAS CAN ALSO BE USED AS SEDIMENTATION PONDS. IF THESE AREAS ARE USED FOR PONDS, A DEMONSTRATION NOTING THAT THE EXCAVATED FUTURE CELL AREA OR SOIL BORROW AREA HAS MORE CAPACITY THAN THE VOLUME PRODUCED BY THE 25-YEAR, 24-HOUR STORM WILL BE DOCUMENTED AND MAINTAINED IN THE SITE OPERATING RECORD.
- AS STATED IN SECTION 2.2, A STATEMENT WILL BE ADDED TO THE SITE OPERATING RECORD EACH TIME A SEDIMENTATION POND IS INSTALLED TO NOTE HOW THE TEMPORARY SEDIMENTATION POND AND THE POND OUTLET WERE CONSTRUCTED CONSISTENT WITH THE REQUIREMENTS OF THE SITE DEVELOPMENT PLAN.

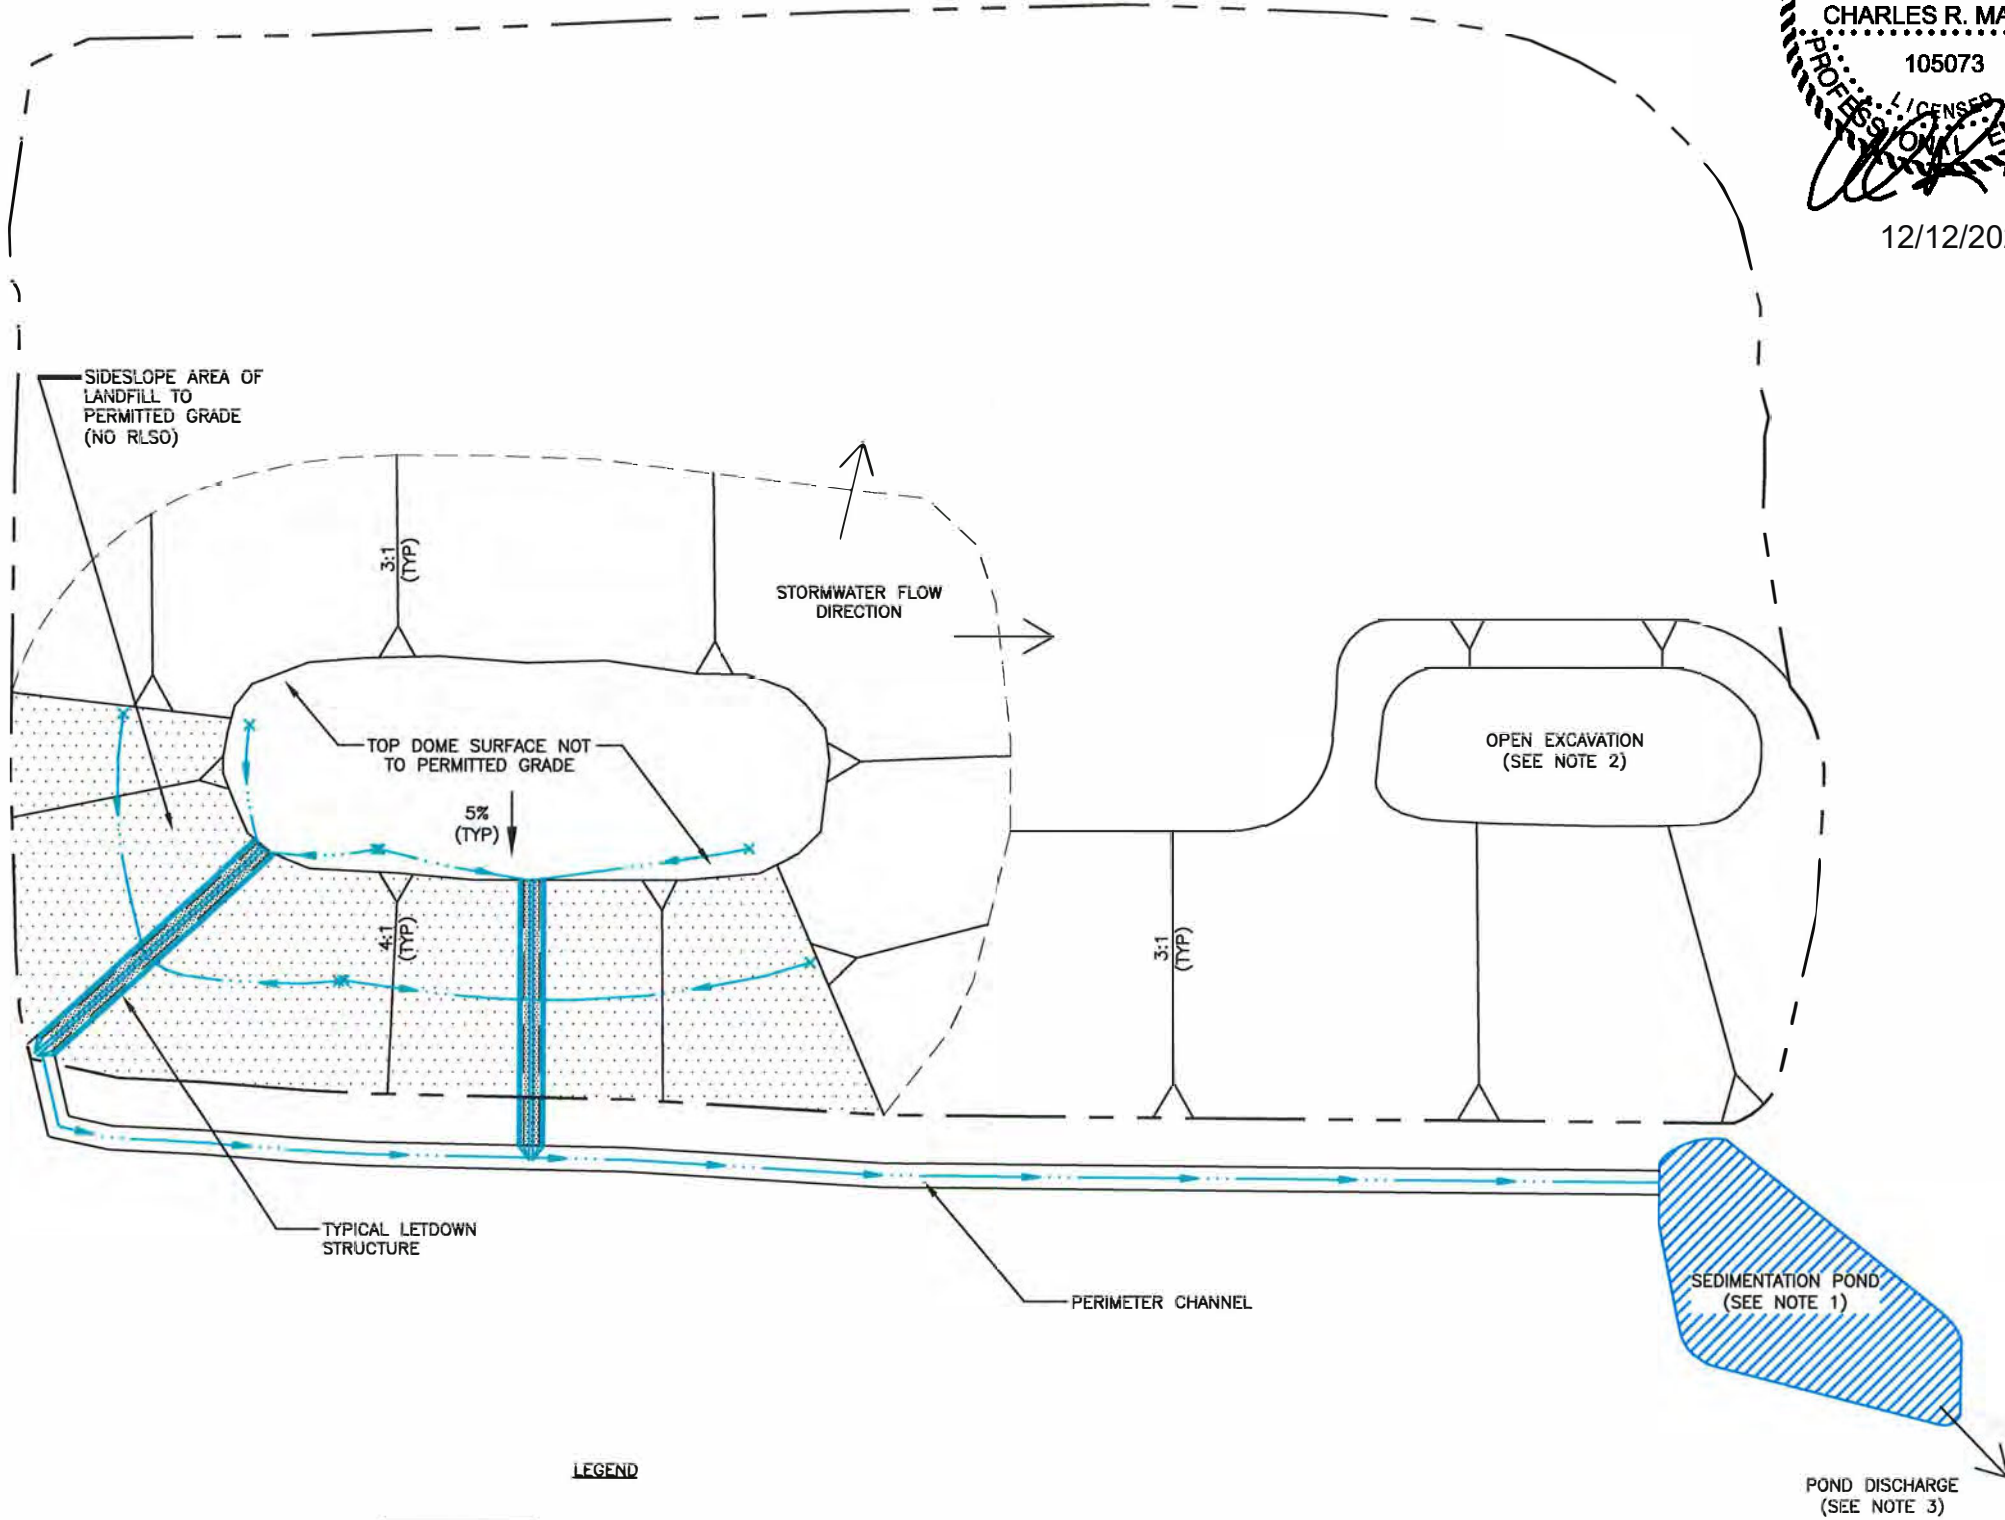

LEGEND

EXTERNAL SIDE SLOPE TO PERMITTED GRADE

LETDOWN

DRAINAGE SWALE

STORMWATER FLOW DIRECTION

INDICATES REVISION (SEE LIST OF REVISIONS)

LIST OF REVISIONS:  
1. REVISED POND CALCULATIONS.

<input type="checkbox"/> DRAFT <input checked="" type="checkbox"/> FOR PERMITTING PURPOSES ONLY <input type="checkbox"/> ISSUED FOR CONSTRUCTION	PREPARED FOR <b>McCARTY ROAD LANDFILL TX, LP</b>	EROSION CONTROL PLAN SEDIMENT CONTROL POND PLAN	
DATE: 05/2010 FILE: 0120-438-11 CAD: FIG 4-RETENTION POND PLAN.DWG	DRAWN BY: SRF DESIGN BY: BJL REVIEWED BY: JPY	McCARTY ROAD LANDFILL HARRIS COUNTY, TEXAS	
Weaver Consultants Group TPE REGISTRATION NO. F-3727		WWW.WCGRP.COM	
REVISIONS		FIGURE 4	
NO. DATE DESCRIPTION			
1 01/2010 1ST TCEQ COMMENT RESPONSE			
2 05/2010 PERMIT MODIFICATION			
3 12/2024 SEE LIST OF REVISIONS			

**McCARTY ROAD LANDFILL  
CITY OF HOUSTON, HARRIS COUNTY, TEXAS  
TCEQ PERMIT NO. MSW-261B**

**PART III – SITE DEVELOPMENT PLAN  
ATTACHMENT 7  
LANDFILL COMPLETION PLAN**

Prepared for

McCarty Road Landfill TX, LP

Approved Site Development Plan


August 2008

Revised October 2008

Revised December 2010

Revised January 2012

Revised December 2024

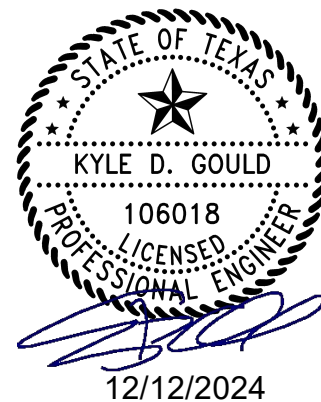




Prepared by

**Weaver Consultants Group, LLC**  
TBPE Registration No. F-3727  
6420 Southwest Boulevard, Suite 206  
Fort Worth, Texas 76109  
817-735-9770

WCG Project No. 0120-439-11-259



D:\0120\439\FLIP MOD 2024\ATT 7\7-A COMPLETION PLAN.dwg, Farrington, 1:2

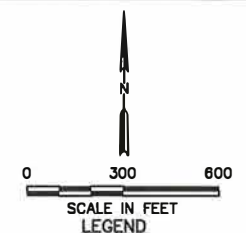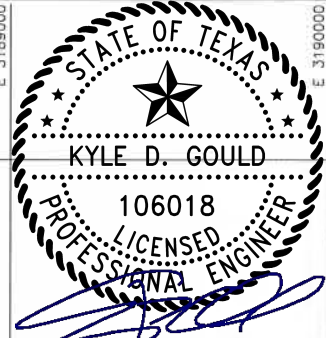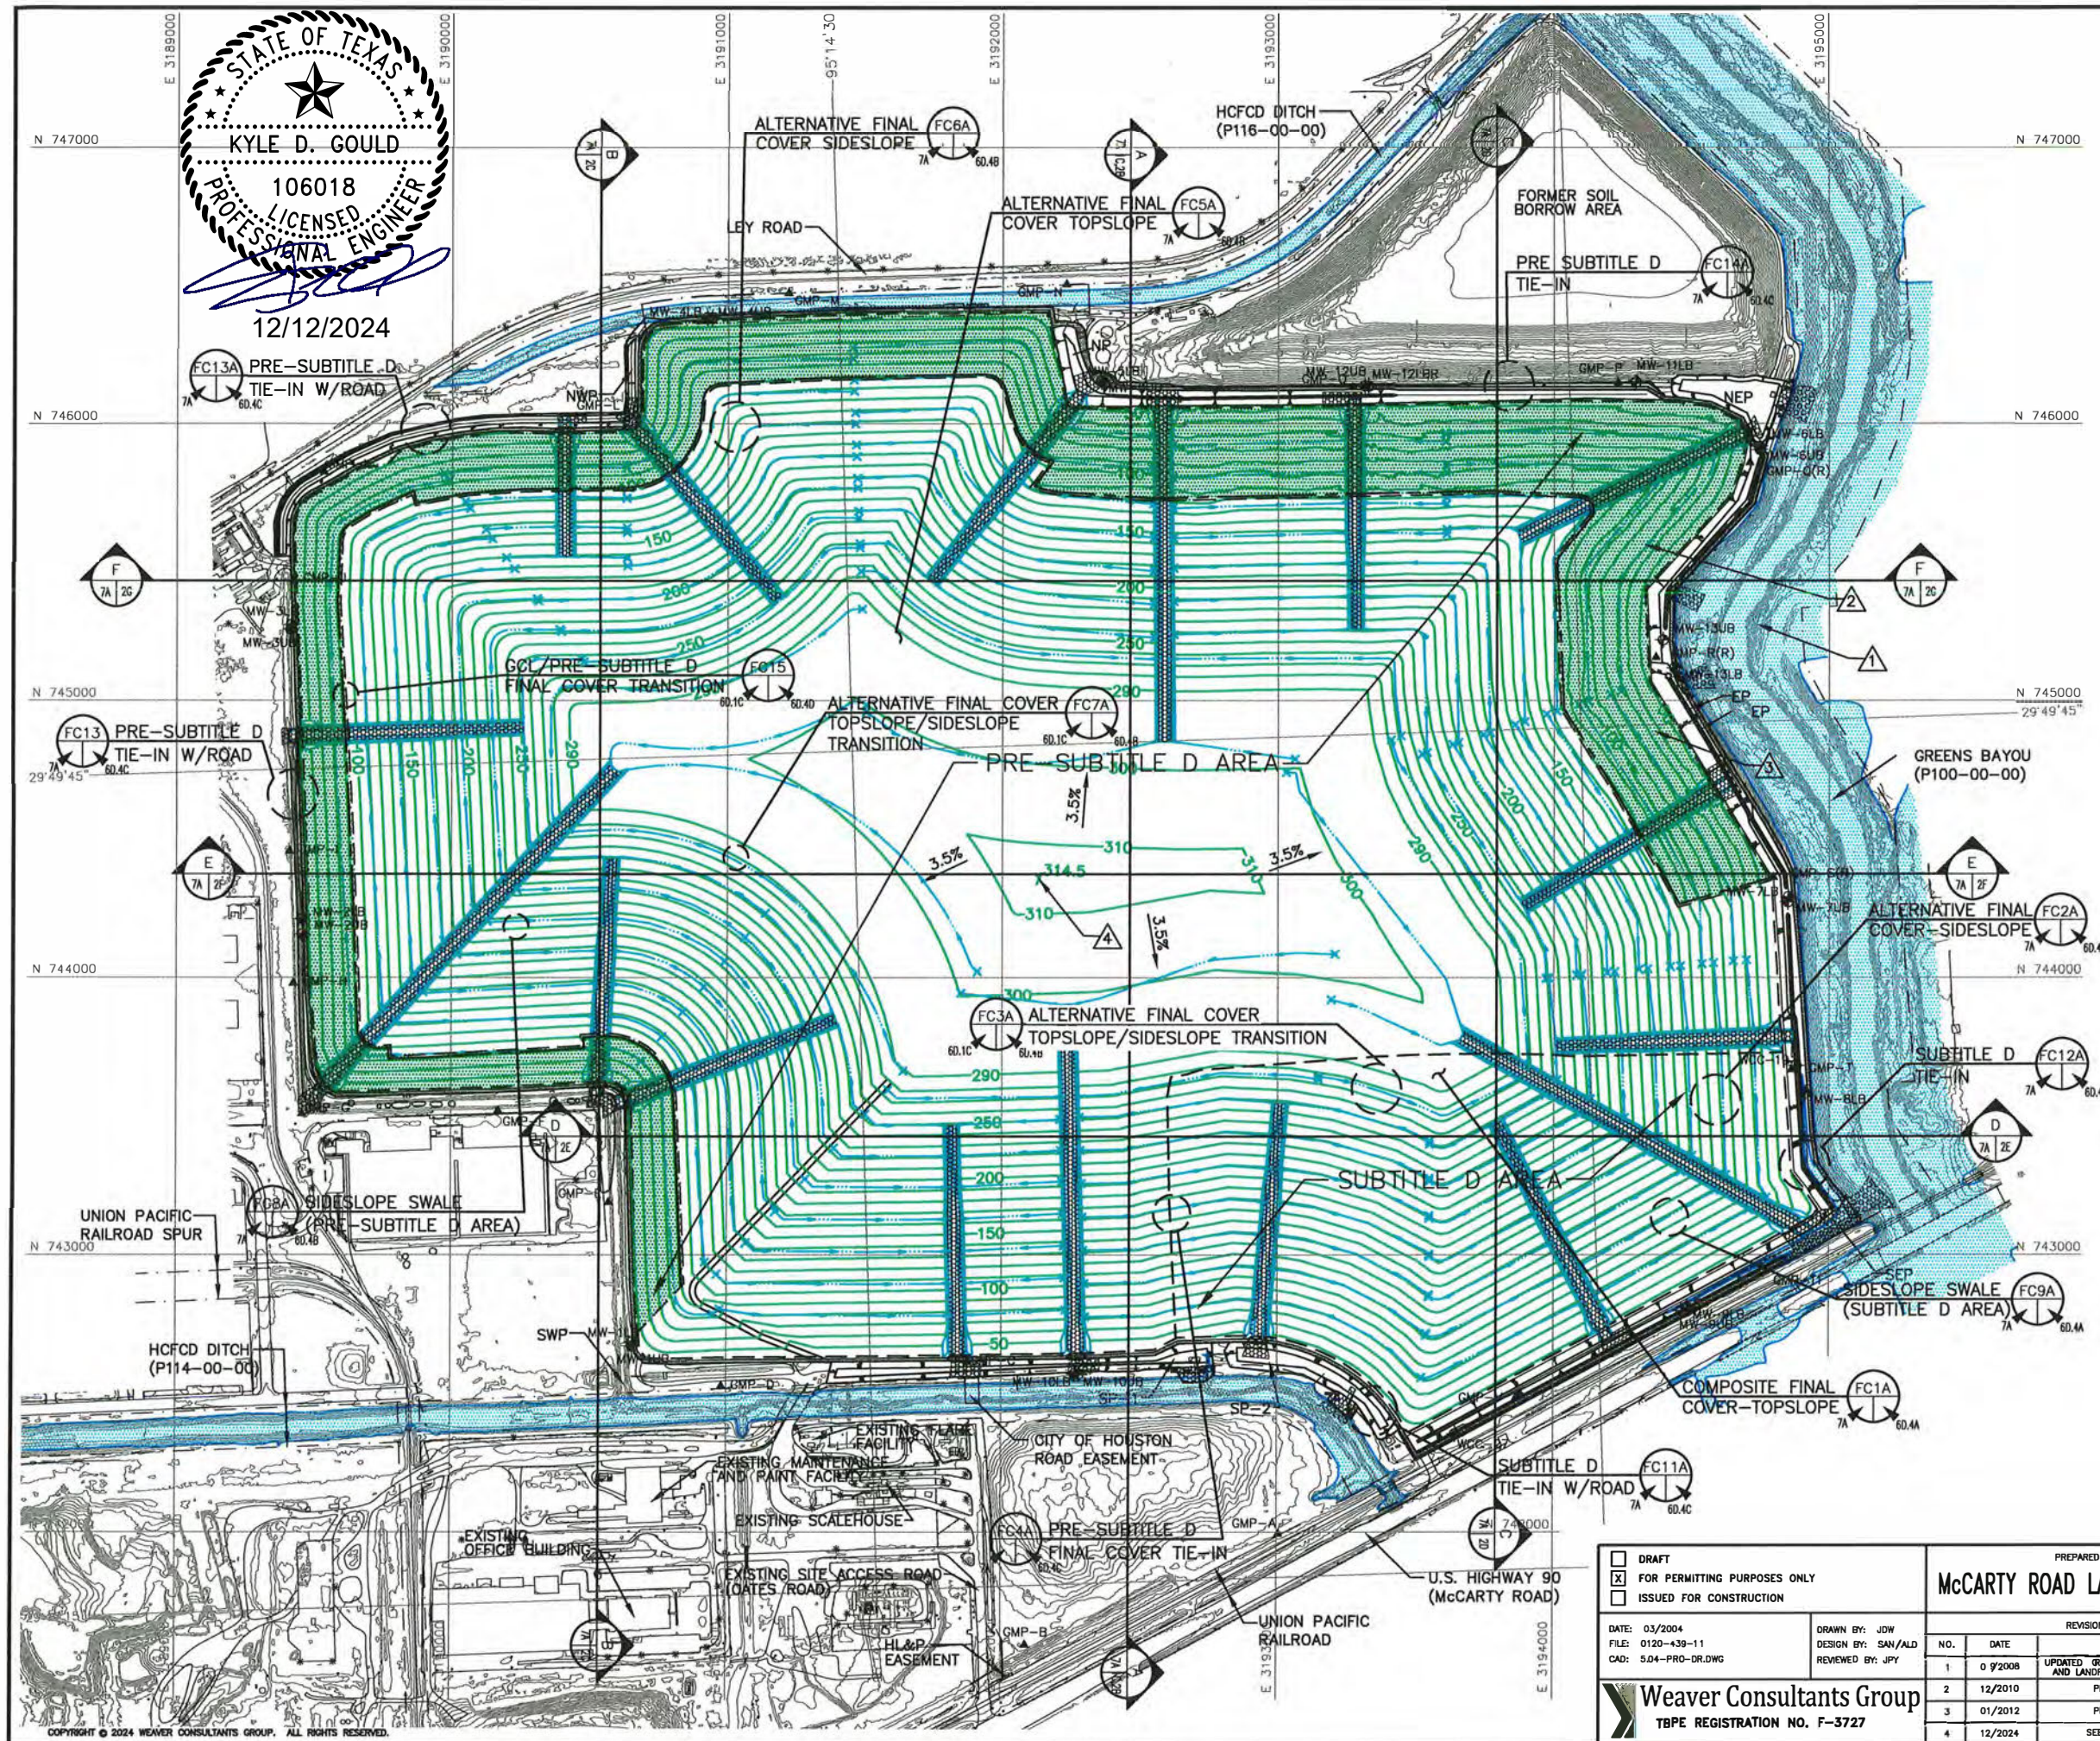


POND LABELS	
NP	NORTH POND
NWP	NORTHWEST POND
NEP	NORTHEAST POND
EP	EAST POND
SEP	SOUTHEAST POND
SWP	SOUTHWEST POND
SP-1	SOUTH POND 1
SP-2	SOUTH POND 2

- — — — — PERMIT BOUNDARY  
- - - - - LIMITS OF WASTE  
- - - - - DEED RESTRICTION BOUNDARY (SEE NOTE 10)  
— 200 — FINAL CONTOURS  
745000 N STATE PLANE COORDINATE SYSTEM  
29°49'45" GEODETIC COORDINATE SYSTEM  
— 20 — EXISTING CONTOUR  
MW-11UB GROUNDWATER MONITORING WELL  
GMP-M LANDFILL GAS MONITORING PROBE  
- - - - - EASEMENT BOUNDARY  
100-YR FLOODPLAIN (REFER TO ATTACHMENT 6C)  
GABIONS  
PROPOSED DRAINAGE SWALE  
PROPOSED DRAINAGE LETDOWN  
CONSTRUCTED FINAL COVER  
INDICATES REVISION (SEE LIST OF REVISIONS)

- NOTES:
- TOPOGRAPHIC MAPPING PREPARED BY FIRMATEK FROM AERIAL PHOTOGRAPHY FLOWN 11-17-2023. THE GRID SYSTEM IS TIED TO THE TEXAS STATE PLANE COORDINATE SYSTEM SOUTH CENTRAL ZONE NAD 1927.
  - PERMIT BOUNDARY AND EASEMENTS WERE REPRODUCED FROM COSTELLO, INC. STANDARD LAND SURVEY DRAWING, DATED MARCH 2004.
  - REFER TO ATTACHMENT 7B FOR POST DEVELOPMENT DRAINAGE INFORMATION.
  - FINAL COVER DETAILS ARE PROVIDED IN ATTACHMENT 6D-FINAL COVER DETAILS.
  - MAXIMUM FINAL COVER ELEVATION: 314.5 FT-MSL  
MAXIMUM WASTE ELEVATION: 313.5 FT-MSL
  - REFER TO ATTACHMENT 2 FOR TYPICAL CROSS SECTION INFORMATION.
  - DRAINAGE DESIGN INFORMATION INCLUDED IN ATTACHMENT 6A.
  - THE TOP DECK WILL BE MARKED AND LIGHTED. CONSISTENT WITH FAA REQUIREMENTS. REFER TO PARTS I/II, APPENDIX I/IIA FOR MORE INFORMATION.
  - REFER TO ATTACHMENT 14 FOR DETAILS OF THE LANDFILL GAS MANAGEMENT PLAN.
  - REFER TO ATTACHMENT 6, APPENDIX 6A-F FOR DEED RESTRICTION INFORMATION.

- LIST OF REVISIONS:
- UPDATED TOPOGRAPHIC MAPPING.
  - REVISED FINAL COVER CONTOURS.
  - ADDED CONSTRUCTED FINAL COVER AREA.
  - UPDATED MAXIMUM FINAL COVER ELEVATION FOR GCL ALTERNATIVE.

<div><input type="checkbox"/> DRAFT</div> <div><input checked="" type="checkbox"/> FOR PERMITTING PURPOSES ONLY</div> <div><input type="checkbox"/> ISSUED FOR CONSTRUCTION</div>		PREPARED FOR		MAJOR PERMIT AMENDMENT LANDFILL COMPLETION PLAN			
		McCARTY ROAD LANDFILL TX, LP					
DATE: 03/2004 FILE: 0120-439-11 CAD: 5.04-PRO-DR.DWG		DRAWN BY: JDW DESIGN BY: SAN/ALD REVIEWED BY: JPY		McCARTY ROAD LANDFILL HARRIS COUNTY, TEXAS			
REVISIONS							
NO.		DATE				DESCRIPTION	
1		0 9/2008				UPDATED GROUNDWATER OBSERVATION WELLS AND LANDFILL GAS MONITORING PROBES	
2		12/2010				PERMIT MODIFICATION	
3		01/2012				PERMIT MODIFICATION	
<div> Weaver Consultants Group</div> <div>TBPE REGISTRATION NO. F-3727</div>		4		12/2024		SEE LIST OF REVISIONS	
						WWW.WCGRP.COM	
						ATTACHMENT 7A	



**McCARTY ROAD LANDFILL  
CITY OF HOUSTON, HARRIS COUNTY, TEXAS  
TCEQ PERMIT NO. MSW-261B**

**PART III – SITE DEVELOPMENT PLAN  
ATTACHMENT 12  
FINAL CLOSURE PLAN**

Prepared for

McCarty Road Landfill TX, LP

Approved Site Development Plan  
August 2008


Revised October 2009

Revised September 2011

Revised February 2013

Revised August 2020

Revised December 2024

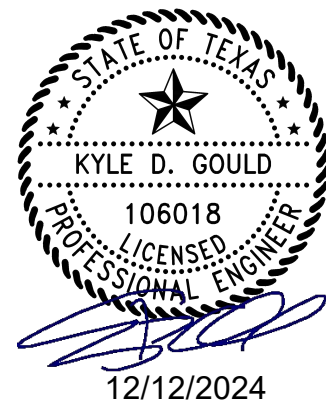

12/12/2024

Prepared by

**Weaver Consultants Group, LLC**  
TBPE Registration No. F-3727  
6420 Southwest Boulevard, Suite 206  
Fort Worth, Texas 76109  
817-735-9770

WCG Project No. 0120-439-11-259

**McCARTY ROAD LANDFILL  
CITY OF HOUSTON, HARRIS COUNTY, TEXAS  
TCEQ PERMIT NO. MSW-261B**

**MAJOR PERMIT AMENDMENT APPLICATION**

**PART III – SITE DEVELOPMENT PLAN  
ATTACHMENT APPENDIX 12A  
FINAL COVER SYSTEM QUALITY CONTROL PLAN**


Prepared for

McCarty Road Landfill TX, LP

Approved Site Development Plan August 2008

Revised March 2011

Revised December 2024

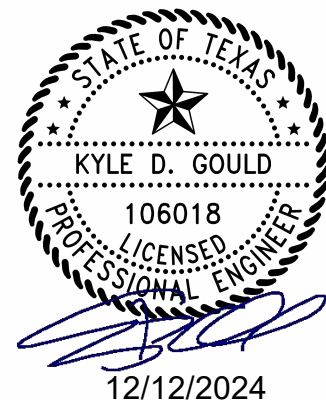

Prepared by


**Weaver Consultants Group, LLC**  
TBPE Registration No. F-3727  
6420 Southwest Boulevard, Suite 206  
Fort Worth, Texas 76109  
817-735-9770

WCG Project No. 0120-439-11-259

**APPENDIX 12A-A**

**FINAL COVER DRAINAGE LAYER DESIGN**


Includes pages 12A-A.1 through 12A-A.7

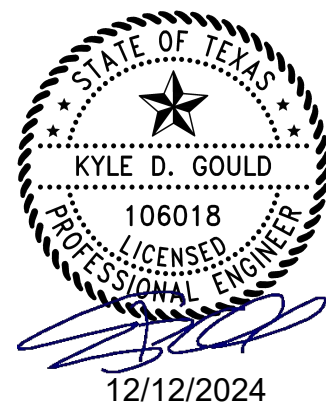



**ATTACHMENT 2**

**REPLACEMENT PAGES**  
**(CLEAN VERSION)**

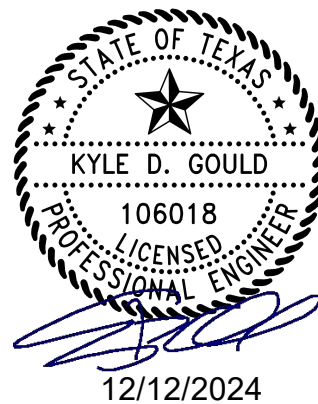

**McCARTY ROAD LANDFILL  
CITY OF HOUSTON, HARRIS COUNTY, TEXAS  
TCEQ PERMIT NO. MSW-261B**

**PART III – SITE DEVELOPMENT PLAN  
SITE DEVELOPMENT PLAN NARRATIVE**

Prepared for

McCarty Road Landfill TX, LP

Approved Site Development Plan August 2008

Revised June 2009

Revised October 2009

Revised February 2010


Revised December 2010

Revised January 2012

Revised October 2014

Revised March 2024

Revised December 2024

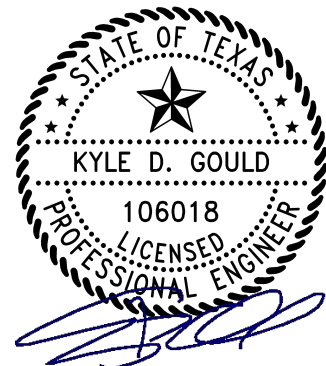

12/12/2024

Prepared by

**Weaver Consultants Group, LLC**  
TBPE Registration No. F-3727  
6420 Southwest Boulevard, Suite 206  
Fort Worth, Texas 76109  
817-735-9770

WCG Project No. 0120-439-11-259



south of the site). The floodplain elevation in Greens Bayou ranges from approximately 30.5 ft-msl near US Highway 90 to 32 ft-msl near the northeast corner of the site. Over 4 feet of freeboard exists between the 100-year flood elevation in Greens Bayou and the limits of waste. As discussed in Attachment 6A, the proposed vertical expansion does not impact stormwater flow in Greens Bayou.

The entire waste fill footprint is located outside the 100-year floodplain as defined on the FIRM. The 100-year water surface profile for P116-00-00 and P114-00-00 are also presented in Attachment 6C. As shown in Attachment 6C, the 100-year storm event is contained within the channel banks of these two HCFC channels.

Refer to Attachment 6C – Floodplain Information for additional information.

The Subtitle D Location Restriction Certification of Compliance for floodplains is included in Parts I/II, Appendix I/IIB.

### **3.8 Cover System Design**

The final cover system will consist of a soil only (pre-Subtitle D areas) and composite (Subtitle D areas) cover system, as well as a GCL alternative final cover for both pre-Subtitle D and Subtitle D areas. The GCL alternative final cover includes replacing the compacted clay infiltration layer with a GCL. As discussed in Attachment 6D, the site will either select the compacted clay infiltration layer option or the GCL infiltration layer option for the remaining footprint that has not received final cover (i.e., only one of the final cover options will be used for the remaining footprint unless a subsequent permit modification is submitted). The final cover system will provide a low maintenance cover, protect against erosion, reduce rainfall percolation through the cover system, and subsequently minimize leachate generation within the landfill. As depicted on Attachment 7A – Landfill Completion Plan, a maximum of 3.5 percent top slopes and 4H:1V sideslopes are provided to minimize erosion and facilitate drainage of the landfill. A composite final cover system will be constructed over the Subtitle D waste disposal areas. Components of the multi-layer final cover system for both pre-Subtitle D and Subtitle D areas include (from top to bottom):

#### Subtitle D Area

- An erosion layer consisting of a 24-inch-thick layer of earthen material (top 6 inches capable of sustaining plant growth). The vegetation layer will consist of native or introduced grasses capable of providing 90 percent coverage over the cover system.
- A drainage geocomposite will be used as the drainage layer.
- A 40-mil, smooth (topslope) and textured (sideslope), linear low-density polyethylene (LLDPE), geomembrane liner or other equivalent geomembrane liner material may be used.

An 18-inch-thick compacted clay infiltration layer with a coefficient of permeability of less than or equal to  $1 \times 10^{-5}$  cm/sec or a geosynthetic clay layer (GCL) with a coefficient of permeability of less than or equal to  $3 \times 10^{-9}$  cm/s. Unreinforced GCL will be used on the topslopes and reinforced GCL will be used on the sideslopes.

**McCARTY ROAD LANDFILL  
CITY OF HOUSTON, HARRIS COUNTY, TEXAS  
TCEQ PERMIT NO. MSW-261B**

**PART III - SITE DEVELOPMENT PLAN  
ATTACHMENT 1  
SITE LAYOUT PLANS**

Prepared for

McCarty Road Landfill TX, LP

Approved Site Development Plan

August 2008

Revised June 2009

Revised October 2009

Revised December 2010

Revised January 2011

Revised January 2012

Revised October 2014

Revised December 2024



**Weaver Consultants Group, LLC**  
TBPE Registration No. F-3727  
6420 Southwest Boulevard, Suite 206  
Fort Worth, Texas 76109  
817-735-9770

WCG Project No.0120-439-11-259



**McCARTY ROAD LANDFILL  
CITY OF HOUSTON, HARRIS COUNTY, TEXAS  
TCEQ PERMIT NO. MSW-261B**

**PART III - SITE DEVELOPMENT PLAN  
ATTACHMENT 2  
FILL CROSS SECTIONS**

Prepared for

McCarty Road Landfill TX, LP

Approved Site Development Plan

August 2008

Revised October 2009

Revised December 2010

Revised January 2011

Revised January 2012

Revised October 2014


Revised December 2024




**Weaver Consultants Group, LLC**  
TBPE Registration No. F-3727  
6420 Southwest Boulevard, Suite 206  
Fort Worth, Texas 76109  
817-735-9770

WCG Project No.0120-439-11-259



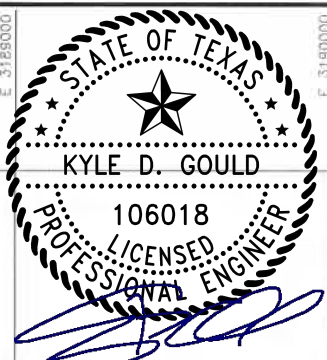


12/12/2024

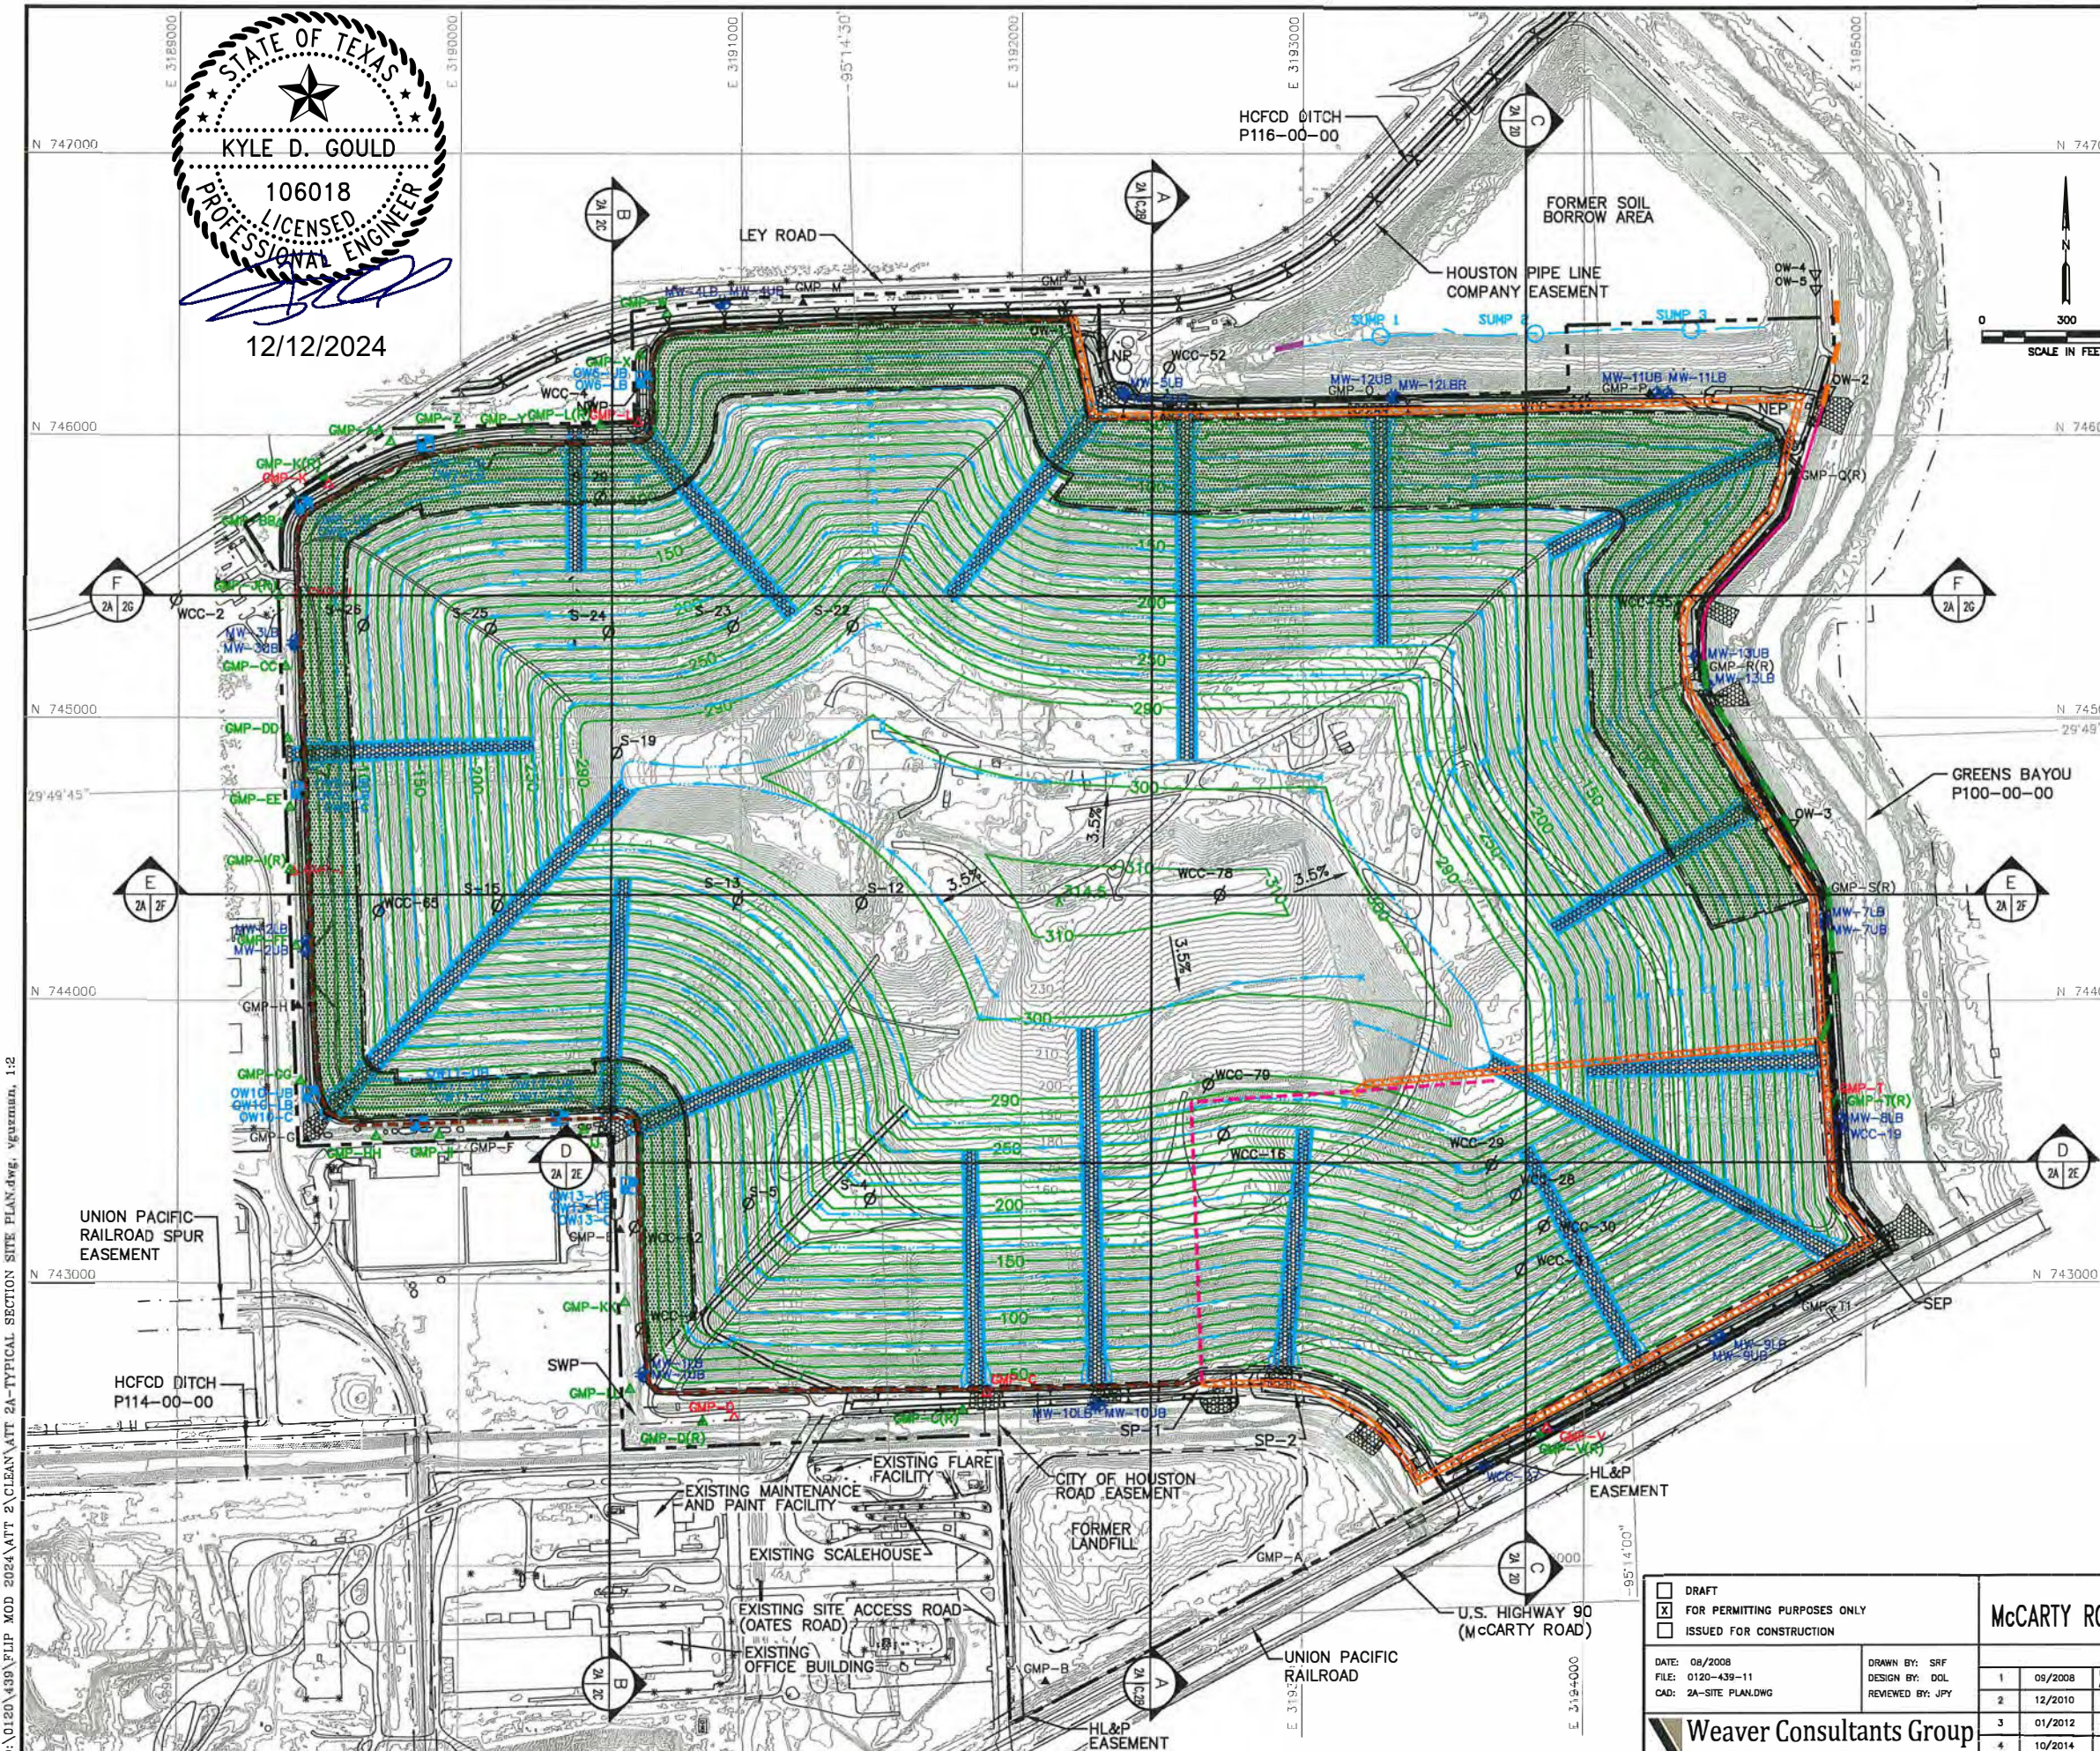

LEGEND	
	PERMIT BOUNDARY
	LIMITS OF WASTE
	DEED RESTRICTION BOUNDARY (SEE NOTE 5)
	STATE PLANE COORDINATE SYSTEM
	GEODETIC COORDINATE SYSTEM
	EXISTING CONTOUR
	FINAL CONTOURS
	COMPACTED CLAY SLOPE LINER
	CLAY CUTOFF WALL
	SLURRY WALL
	DEEP SLURRY WALL
	NORTHERN EAST SLURRY WALL EXTENSION (REFER TO ATT. 6D)
	EAST SLURRY WALL EXTENSION (REFER TO ATT. 6D)
	SLURRY WALL EXTENSION OF GWRT (REFER TO ATT. 6D)
	EXISTING DETECTION GROUNDWATER MONITORING WELL
	PROPOSED OBSERVATION WELL CLUSTERS (SEE NOTE 7)
	EXISTING OBSERVATION WELL (SEE NOTE 7)
	EXISTING LANDFILL GAS MONITORING PROBE
	EXISTING LANDFILL GAS MONITORING PROBE TO BE DECOMMISSIONED
	PROPOSED LANDFILL GAS MONITORING PROBE (SEE NOTE 6)
	EASEMENT BOUNDARY
	SOUTHWEST LAB SOIL BORING
	WOODWARD CLYDE SOIL BORING
	GABIONS
	PROPOSED DRAINAGE SWALE
	PROPOSED DRAINAGE LETDOWN
	GROUND WATER RECOVERY TRENCH
	GROUND WATER RECOVERY TRENCH SUMP
	CONSTRUCTED FINAL COVER


- NOTES:
- TOPOGRAPHIC MAPPING PREPARED BY FIRMATEK FROM AERIAL PHOTOGRAPHY FLOWN 11-17-2023. THE GRID SYSTEM IS TIED TO THE TEXAS STATE PLANE COORDINATE SYSTEM SOUTH CENTRAL ZONE NAD 1927.
  - PERMIT BOUNDARY AND EASEMENTS WERE REPRODUCED FROM COSTELLO, INC. STANDARD LAND SURVEY DRAWING, DATED MARCH 2004.
  - BORING LOCATIONS HAVE BEEN REPRODUCED FROM VARIOUS SUBSURFACE INVESTIGATIONS PREVIOUSLY COMPLETED AND ARE APPROXIMATE. ONLY BORINGS SHOWN ON SECTIONS ARE PRESENTED ON THIS DRAWING. PLEASE REFER TO ATTACHMENT 4, FIGURE 4B.2 FOR A FIGURE THAT SHOWS ALL THE BORINGS COMPLETED AT THE SITE.
  - REFER TO ATTACHMENT 1H FOR THE FINAL CONTOUR PLAN AND 1I FOR THE BOTTOM OF WASTE PLAN.
  - REFER TO ATTACHMENT 6, APPENDIX 6A-F FOR DEED RESTRICTION INFORMATION.
  - PROPOSED PROBES DESIGNATED WITH "(R)" ARE REPLACEMENT PROBES. PROPOSED PROBES GMP-W THROUGH GMP-LL WERE ADDED ALONG THE WESTERN PERIMETER OF THE LANDFILL AS PART OF THE AAWWE SETTLEMENT AGREEMENT.
  - GROUNDWATER OBSERVATION WELLS OW-1, OW-2, OW-3, OW-4 AND OW-5 WERE ADDED ALONG THE NORTHERN AND EASTERN PERIMETER OF THE LANDFILL AS PART OF THE HARRIS COUNTY SETTLEMENT AGREEMENT. ADDITIONAL PROPOSED OBSERVATION WELLS WERE ADDED ALONG THE WESTERN PERIMETER OF THE LANDFILL AS PART OF THE AAWWE SETTLEMENT AGREEMENT.

<input type="checkbox"/> DRAFT <input checked="" type="checkbox"/> FOR PERMITTING PURPOSES ONLY <input type="checkbox"/> ISSUED FOR CONSTRUCTION		PREPARED FOR <b>McCARTY ROAD LANDFILL TX, LP</b>		TYPICAL SECTION SITE PLAN		
DATE: 08/2008 FILE: 0120-439-11 CAD: 2A-SITE PLAN.DWG		DRAWN BY: SRF DESIGN BY: DOL REVIEWED BY: JPY				
 <b>Weaver Consultants Group</b> TBPE REGISTRATION NO. F-3727		REVISIONS		<b>McCARTY ROAD LANDFILL</b> <b>HARRIS COUNTY, TEXAS</b>		
		1	09/2008			UPDATED LANDFILL GAS MONITORING PROBES AND ADDED EAST SLURRY WALL
		2	12/2010			PERMIT MODIFICATION
		3	01/2012			PERMIT MODIFICATION
		4	10/2014			PERMIT MODIFICATION
		5	12/2024	PERMIT MODIFICATION	WWW.WCGRP.COM	ATTACHMENT 2A

O:\0120\439\FLIP MOD 2024\ATT 2\CLEAN\ATT 2A-TYPICAL SECTION SITE PLAN.dwg, vgenman, 1:2



D:\0120\439\FLIP MOD 2024\ATT 2\CLEAN\ATT 2P-SEC-E.dwg vguzman, 1:2

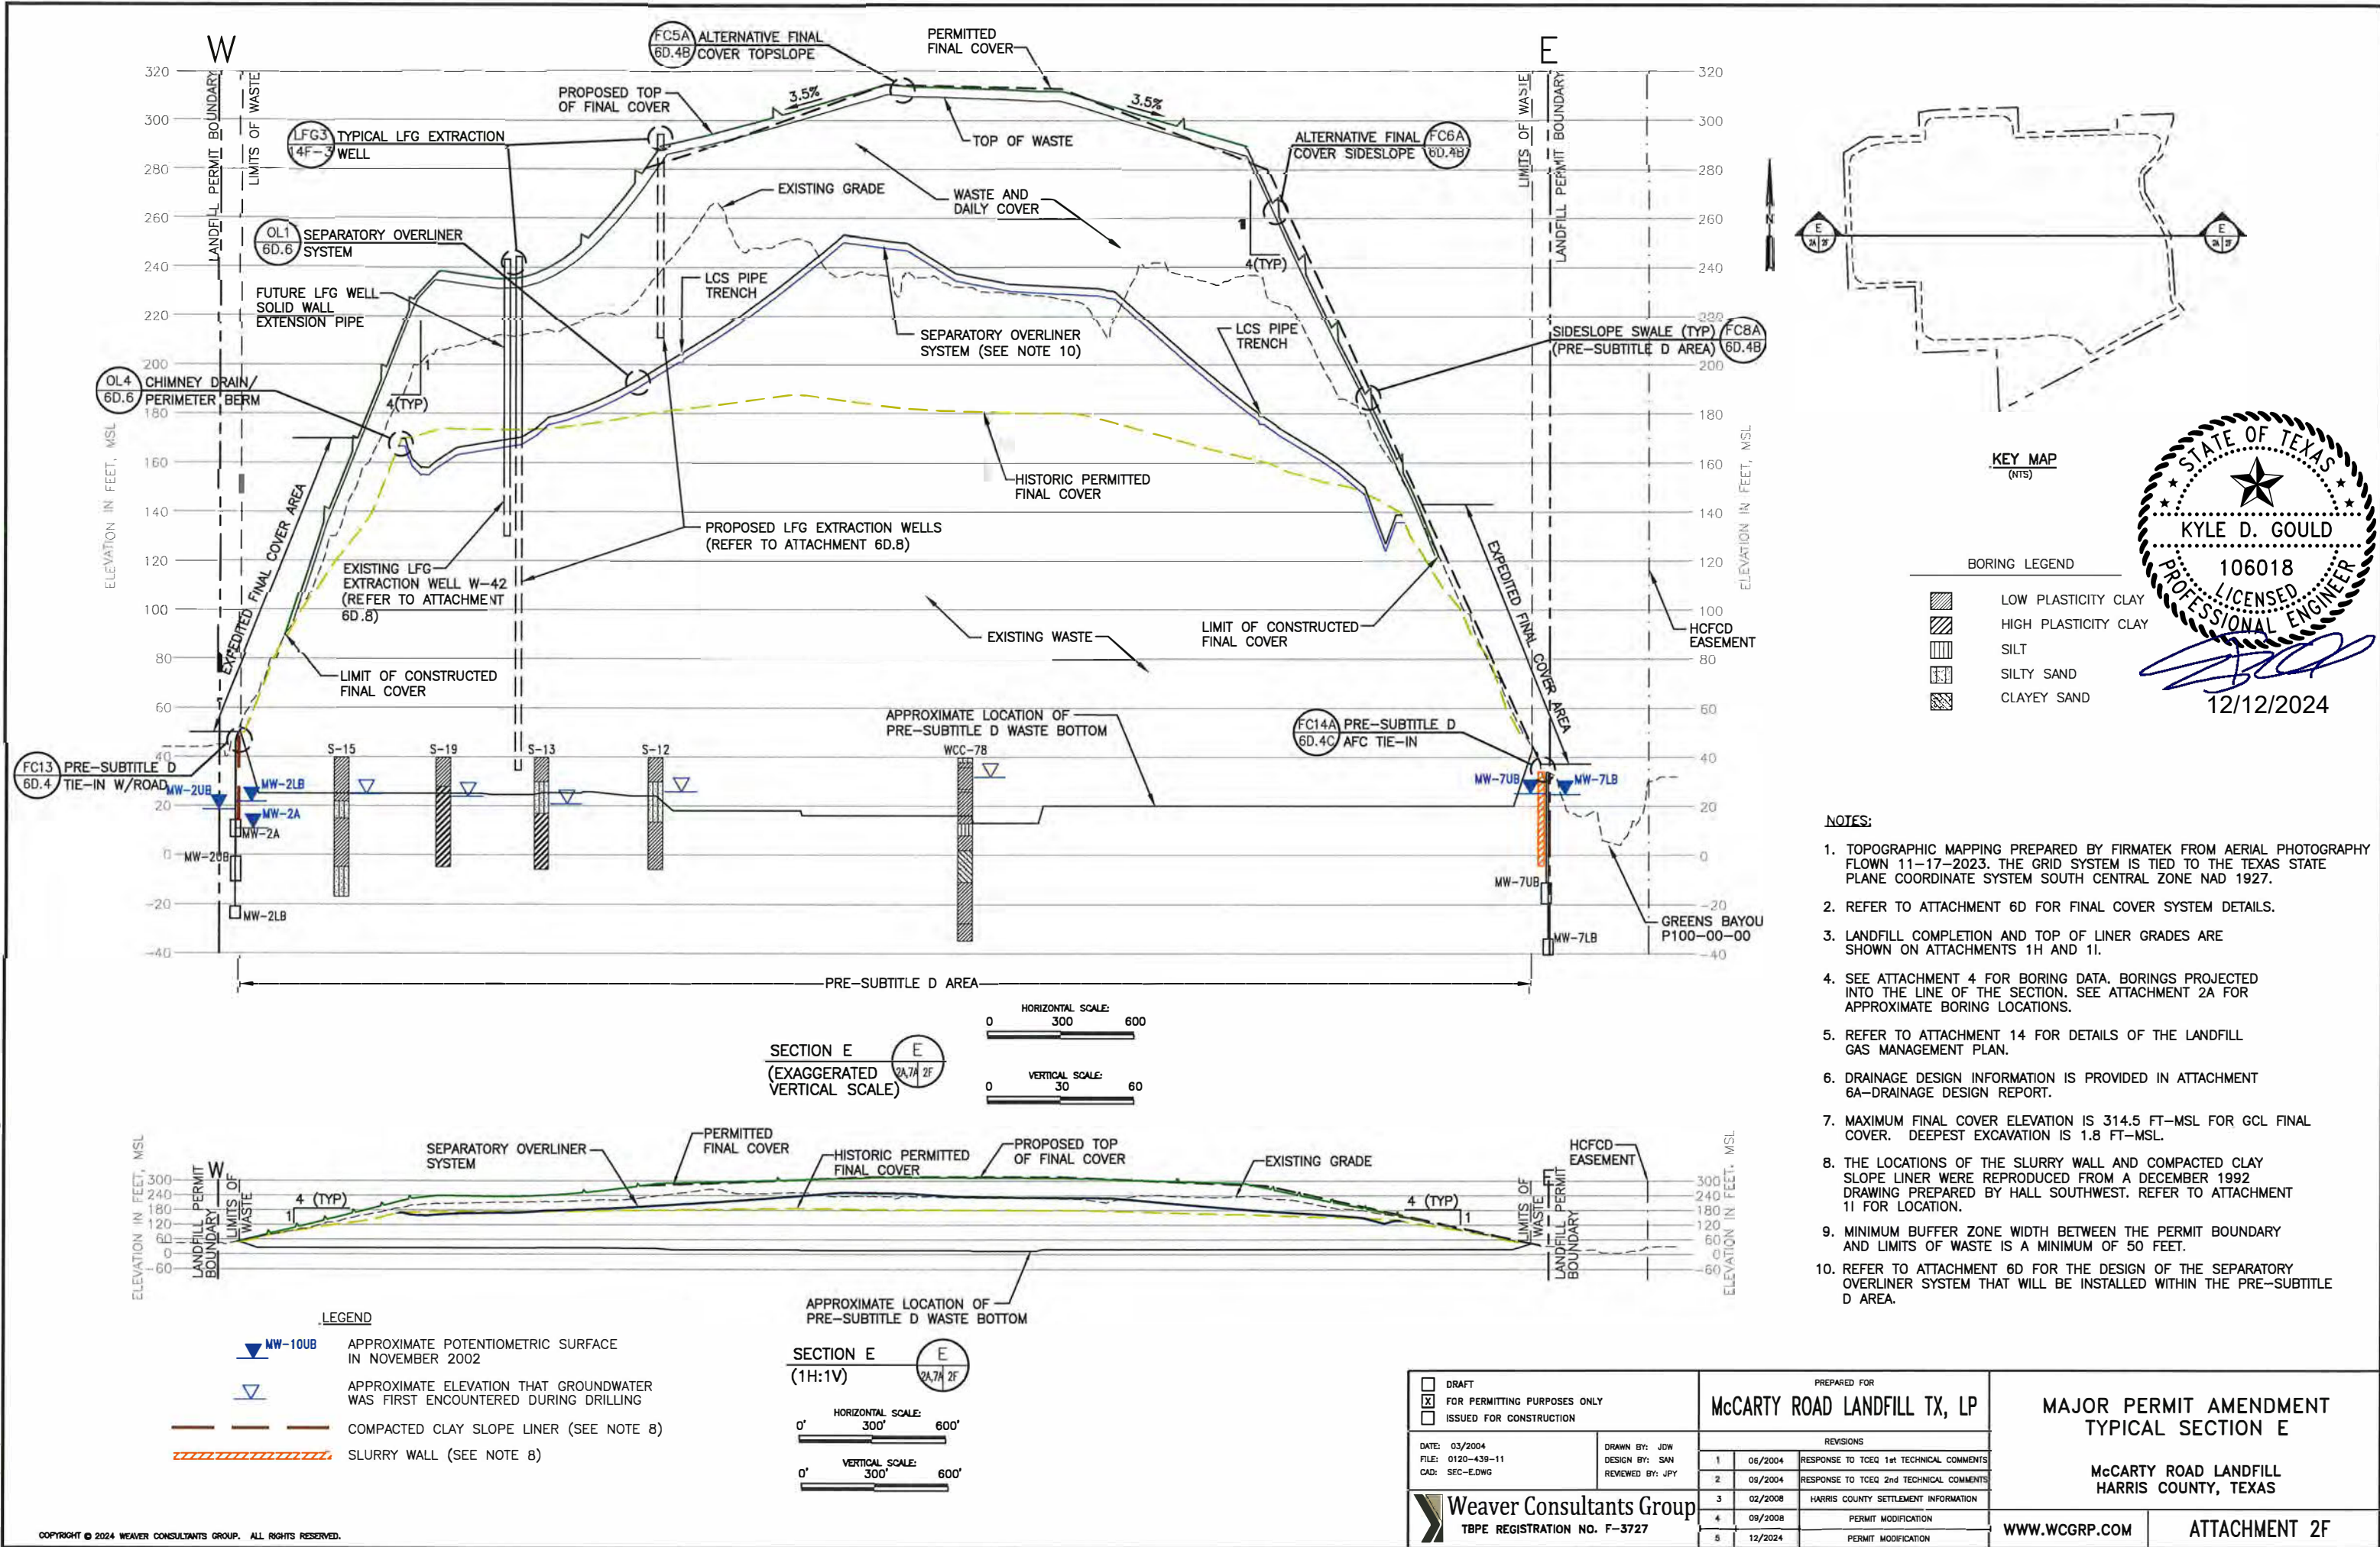

**McCARTY ROAD LANDFILL  
CITY OF HOUSTON, HARRIS COUNTY, TEXAS  
TCEQ PERMIT NO. MSW-261B**

**PART III – SITE DEVELOPMENT PLAN  
ATTACHMENT 6  
GROUNDWATER AND SURFACE WATER  
PROTECTION PLAN**

Prepared for

McCarty Road Landfill TX, LP

Approved Site Development Plan

August 2008

Revised October 2009


Revised August 2010

Revised December 2010

Revised January 2011

Revised October 2014

Revised December 2024

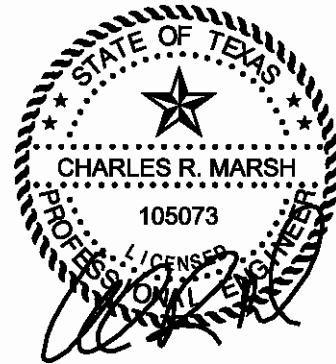

12/12/2024

**Weaver Consultants Group, LLC**  
TBPE Registration No. F-3727  
6420 Southwest Boulevard, Suite 206  
Fort Worth, Texas 76109  
817-735-9770

WCG Project No.0120-439-11-259



**McCARTY ROAD LANDFILL  
CITY OF HOUSTON, HARRIS COUNTY, TEXAS  
TCEQ PERMIT NO. MSW-261B**

**MAJOR PERMIT AMENDMENT APPLICATION**

**PART III - SITE DEVELOPMENT PLAN  
ATTACHMENT 6A  
DRAINAGE DESIGN REPORT**

Prepared for

McCarty Road Landfill TX, LP

Approved Site Development Plan


August 2008

Revised October 2010

Revised January 2012

Revised March 2024

Revised December 2024

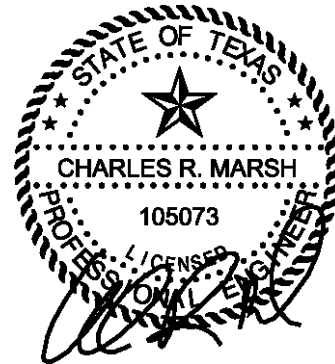

12/12/2024

**Weaver Consultants Group, LLC**  
TBPE Registration No. F-3727  
6420 Southwest Boulevard, Suite 206  
Fort Worth, Texas 76109  
817-735-9770

WCG Project No.0120-439-11-259

- HCFC D P100-00-00. This unit description belongs to Greens Bayou, which is located east of the site.

The peak flow generated from the area within the solid waste fill area will increase with this vertical expansion because the 4H:1V sideslope area has increased, the topdeck of the landfill has decreased, and the hydrologic modeling (e.g., precipitation model and modeling program) has been updated. Thus, drainage flowing from the landfill area will be conveyed to the perimeter channels faster than the currently permitted landfill configuration. To offset this increase in the peak flows, additional detention ponds and upgrades to the existing perimeter channels (and their outlet structures) have been incorporated into the design for the vertical expansion to attenuate the peak flows leaving the site. These drainage improvements are detailed in Attachments 6A.1 through 6A.30.

In addition, Table 6.1 has been developed to facilitate a comparison of flow rates and volumes entering the three downstream HCFC D drainage structures. A summary of peak flows and volumes is listed below.

- **Peak Flow.** As shown on Table 6.1, for each of these three discharges the peak flow for the landfill expansion condition is consistent with the peak flow for the existing permitted landfill condition. The perimeter channel improvements and new detention ponds adequately attenuate the increase in peak flow generated by expanding the landfill vertically. In addition, the shape of the hydrographs in each case is similar. In general, for the expansion case the hydrograph peaks are reduced and the tail end of the hydrograph is slightly higher due to the additional detention that is added to the expansion drainage design.

**Table 6.1**  
**Flow Rates and Runoff Volumes for the Design Storm Event**

Stormwater Discharge Point	Existing Permitted Conditions				Postdevelopment Conditions			
	Flow Rate (cfs)		Runoff Volume (ac-ft)		Flow Rate (cfs)		Runoff Volume (ac-ft)	
	25 year	100 year	25 year	100 year	25 year	100 year	25 year	100 year
North (P116-00-00)	1,077	1,456	146	241	1,068	1,451	148	240
East (P100-00-00)	776	1,027	68	136	745	1,002	82	132
South (P114-00-00)	2,537	3,842	123	240	2,530	3,822	128	256

- **Volumes.** As shown in Table 6.1, the volumes of flow entering each HCFC D channel for both the existing permitted condition and the proposed vertical



expansion condition are very similar. As discussed in Attachment 6A-A, the curve numbers used to represent the landfill final cover in both cases is 88. No change to the final cover system design is proposed. Therefore, the main reason for the additional volume for the postdevelopment condition is the changes to the hydrologic model provided by HCFCD. The pond areas are modeled with a curve number of 100 (i.e., the decrease in infiltration due to the detention ponds results in a slightly increased total volume of runoff generated from the site).

Also shown in the Table 6.1, postdevelopment runoff volumes generated from the landfill's three drainage basins do not significantly alter the existing permitted conditions. This demonstration was submitted to the HCFCD in July 2011. Excerpts from the HCFCD submittal and their September 15, 2011 approval letter is included in Attachment 6B.

#### **4.4 Effect of Vertical Expansion on Peak Flows, Volumes, and Velocities Entering and Exiting the Landfill Permit Boundary**

The purpose of this section is to provide a demonstration that the peak flows, volumes, and velocities are not significantly altered at the landfill permit boundary. To complete this analysis, the HEC-HMS models for both the existing permitted and proposed vertical expansion cases were incorporated into the Greens Bayou model obtained from the HCFCD in February 2024. The resulting model, which is included in Appendix 6A-A, assesses the impact of the proposed vertical expansion on the local and regional drainage patterns.

The results of this demonstration are provided on Table 6-2 and Figures 4.3 through 4.6. Each discharge point is discussed in the following subsections.

##### **4.4.1 HCFCD Channel P116-00-00 (North)**

As shown in Attachment 6A.1, the permit boundary encompasses P116-00-00 on the north portion of the site. The hydrographs for stormwater entering and exiting the permit boundary are shown on Figure 4.4 for the 25-year and 100-year storm events. As Figure 4.4 shows, the hydrographs entering the site are similar for each storm event. The proposed condition results in no increases in discharge rate nor increases in the water surface elevation in P116-00-00. Additionally, the increased flow rates do not cause erosive flow velocities in P116-00-00.

As shown in Table 6-2, the volume of flow entering and exiting the permit boundary is consistent. The changes in volume is due to the changes made to the HCFCD hydrologic model.

The velocities entering and exiting the permit boundary in the channel are similar, as shown on Table 6-2. This is to be expected given that the flow rates are similar and the channel cross-sections are the same. As demonstrated in the approved HCFCD analysis

(see Appendix B), the increase in flow rate, volume, and velocity in P116-00-00 has no adverse impact on Greens Bayou downstream of the permit boundary.

#### **4.4.2 HCFCD Channel P114-00-00 (South)**

The permit boundary encompasses P114-00-00 on the southern portion of the site. The hydrographs entering and exiting the site are shown on Figure 4.5 for the 25-year and 100-year storm events. As with HCFCD channel P116-00-00, the hydrographs entering the permit boundary are similar for each storm event. The peak flow leaving the permit boundary for this channel is decreased slightly.

As shown on Table 6-2 the volume of flow entering the permit boundary is unchanged by the expansion condition. The volume exiting the permit boundary is lower for the expansion condition. This result occurs because the differences between the drainage areas under the permitted and proposed conditions (refer to Figure 4.2) and the hydrologic model differences.

The differences in velocities in the channel entering and exiting the permit boundary are similar to the differences in flow rates for the permitted expansion conditions, as shown on Table 6-2. This is to be expected given that the flow rate and channel cross-section is the same. In both cases, the velocities are well below an erosive velocity (i.e., 5 ft/sec).

As demonstrated in the approved HCFCD analysis (see Appendix B), the increase in flow rate, volume, and velocity in P114-00-00 has no adverse impact on Greens Bayou downstream of the permit boundary.

#### **4.4.3 Greens Bayou (P100-00-00 located east of the site)**

As shown on Figures 4.2 and 4.3, the location of the permitted outfalls will not be modified with the vertical expansion of the landfill along the eastern portion of the site. As shown on Figure 4.6, and listed in Table 6-2, the combined peak flow leaving the permit boundary on the eastern portion of the site for the vertical expansion is less than the permitted condition, due to the updates to the hydrologic model.

Also, the volume of flow has been increased, as shown in Table 6-2. This is due to the changes in the hydrologic modeling method and drainage area delineations.

A velocity comparison is not applicable to this portion of the site since the outfall locations and design have not been modified and the flow rates have slightly decreased (i.e., the velocities will be less). However, as demonstrated in Appendix 6A-B the outfall structures have been designed to manage the incremental velocities created at each outfall structure. Each outfall structure includes a low-water outlet and emergency spillway which is lined with gabions to protect the underlying soil from erosive velocities. In addition, the design of these outfalls, which are located within the HCFCD easement, have been approved by HCFCD (refer to Attachment 6B).



**TABLE 6-2**  
**FLOW RATE, VOLUME, AND VELOCITY COMPARISON AT PERMIT BOUNDARY**

COMPARISON POINT	EXISTING PERMITTED CONDITION						VERTICAL EXPANSION CONDITION					
	FLOW RATE (cfs)		RUN-OFF VOLUME (ac-ft)		VELOCITY (ft/sec)		FLOW RATE (cfs)		RUN-OFF VOLUME (ac-ft)		VELOCITY (ft/sec)	
	25 year	100 year	25 year	100 year	25 year	100 year	25 year	100 year	25 year	100 year	25 year	100 year
ENTERING P116-00-00 (North)	51	77	50	81	1.91	2.55	51	77	50	81	1.91	2.55
LEAVING P116-00-00	1,077	1,456	146	241	4.57	3.00	1,068	1,451	148	240	4.51	4.98
ENTERING P114-00-00 (South)	733	1,080	379	634	2.52	3.63	733	1,080	379	634	2.52	3.63
LEAVING P114-00-00	2,537	3,842	1,374	2,314	2.94	3.08	2,530	3,822	1,379	2,300	2.94	3.07
Leaving Eastern Permit Boundary to Greens Bayou	776	1,027	68	136	N/A <sup>1</sup>	N/A <sup>1</sup>	745	1,002	82	132	N/A <sup>1</sup>	N/A <sup>1</sup>

1 A velocity comparison is not applicable to this portion of the site.

## 4.5 Effect of Vertical Expansion on Greens Bayou

Sections 4.3 and 4.4 demonstrated that the vertical expansion will not adversely alter existing drainage patterns. The purpose of this Section is to provide a final demonstration that shows the flow in Greens Bayou downstream of the site is also not adversely impacted by the proposed vertical expansion of the landfill.

Figure 4.1 shows the Greens Bayou watershed in the area of the site. This figure also shows the individual drainage areas, as reproduced from previous HCFCD studies. Note that flow from the northern and eastern portion of the landfill discharges to Greens Bayou at a location adjacent to the site. Flow from the southern portion of the site drains to P114-00-00, which flows beneath US Highway 90 before discharging to Greens Bayou approximately 3,000 feet south of the site.


To demonstrate that the proposed vertical expansion does not adversely alter the existing drainage patterns of Greens Bayou, both the HEC-HMS analysis for the permitted and proposed conditions were incorporated into the regional study obtained from the HCFCD. Hydrographs for both conditions were developed at the downstream point of Area P100 T, as shown on Figure 4.1. The resulting hydrographs for both the 25-year and 100-year storm events are presented on Figure 4.7. As shown on Figure 4.7, the hydrographs for both the permitted and proposed vertical expansion conditions are similar in shape and scale. As shown in Appendix 6B, when the permit boundary is incorporated into the existing HCFCD hydrologic model, the peak flow rates downstream of the permit boundary are decreased due to the timing of the hydrographs in Greens Bayou.

## 4.6 Summary

The updated detention pond designs will result in increased flow rates discharged from this permit boundary; however, the regional drainage patterns (e.g., flow rates in Greens Bayou downstream of the permit boundary) are not adversely impacted.

From the hydrological evaluations of the existing permitted and postdevelopment conditions, the drainage conditions at the permit boundary will not be adversely altered by the proposed development. Given that: (1) drainage patterns are not adversely altered and (2) stormwater discharge outfall locations are consistent with the permitted and existing configurations, it is concluded that the proposed landfill development will not significantly alter existing permitted drainage patterns consistent with §330.56 (f)(4)(A)(iv) and §330.55(b)(5)(D).



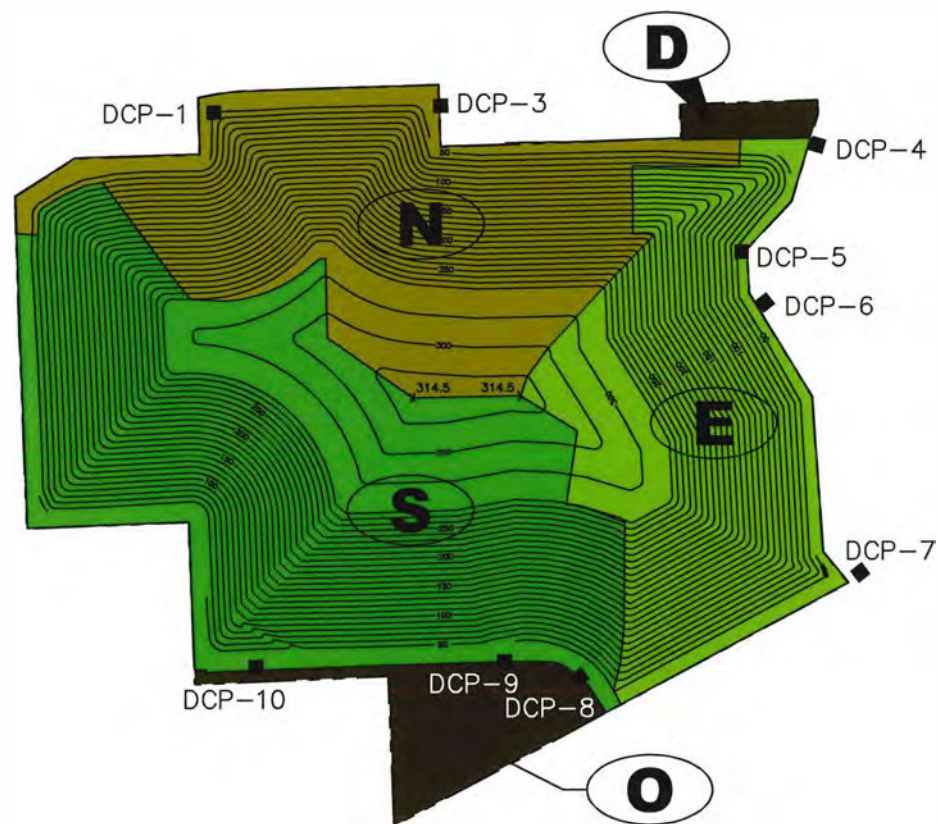



CURRENTLY PERMITTED CONDITION  
DRAINAGE AREAS

N= 125.99 ACRES  
S= 195.10 ACRES  
E= 105.41 ACRES  
D= 5.49 ACRES  
O= 26.26 ACRES

NOTES:


1. DRAINAGE AREA D FLOWS INTO THE NORTHERN SOIL BORROW AREA.
2. DRAINAGE AREA O IS MOSTLY COMPRISED OF THE OLD LANDFILL.
3. SEE ATTACHMENT 7 FOR PROPOSED FINAL COMPLETION PLAN.
4. FLOW FROM DRAINAGE AREA W SHEET FLOWS TO AN AREA WEST OF THE SITE.

LEGEND

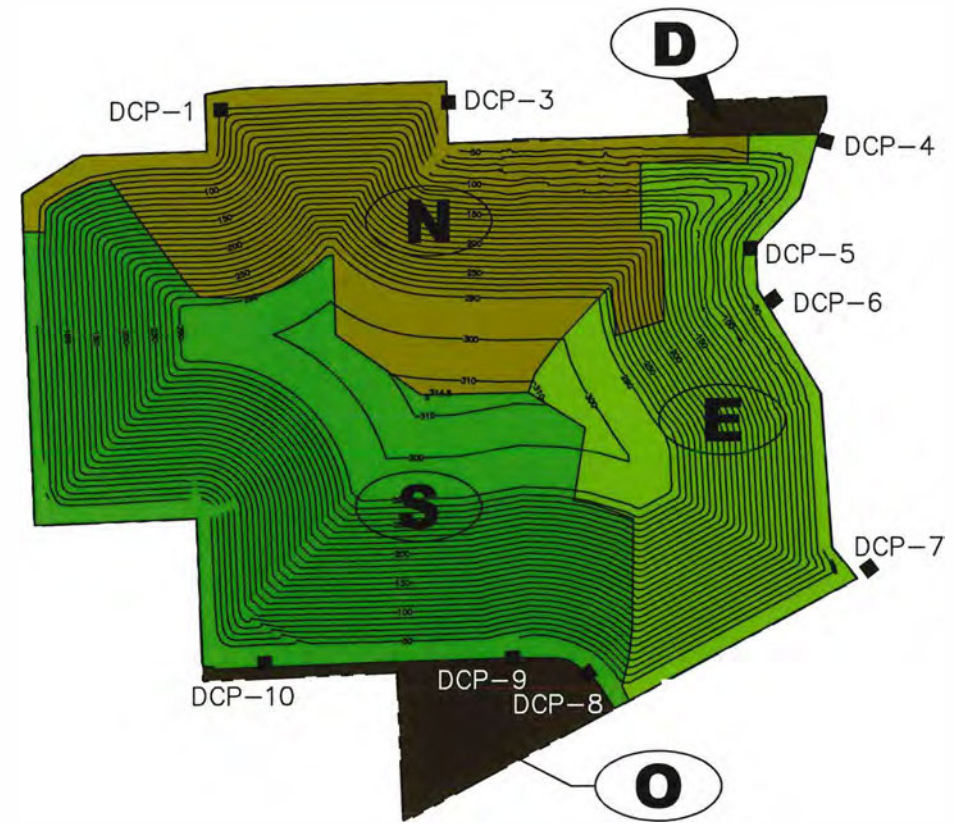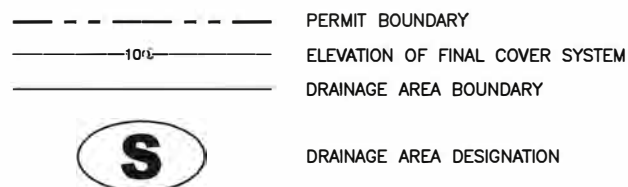

PROPOSED FINAL CONTOUR IMPROVEMENTS  
DRAINAGE AREAS


N= 124.69 ACRES  
S= 195.10 ACRES  
E= 106.71 ACRES  
D= 5.49 ACRES  
O= 26.26 ACRES

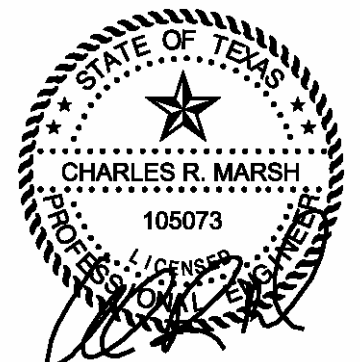


12/12/2024

<input type="checkbox"/> DRAFT <input checked="" type="checkbox"/> FOR PERMITTING PURPOSES ONLY <input type="checkbox"/> ISSUED FOR CONSTRUCTION		PREPARED FOR <b>McCARTY ROAD LANDFILL TX, LP</b>		MAJOR PERMIT AMENDMENT SITE DRAINAGE PATTERNS	
DATE: 03/2004 FILE: 0120-439-11 CAD: FIG-4.2DRAIN AREA.DWG	DRAWN BY: JDW DESIGN BY: SAN/ALO REVIEWED BY: JPY	REVISIONS		McCARTY ROAD LANDFILL HARRIS COUNTY, TEXAS	
		NO.	DATE	DESCRIPTION	
		1	08/2006	PERMIT MODIFICATION UPDATE	
		2	12/2024	PERMIT MODIFICATION	
<b>Weaver Consultants Group</b> TBPE REGISTRATION NO. F-3727				WWW.WCGRP.COM	FIGURE 4.2



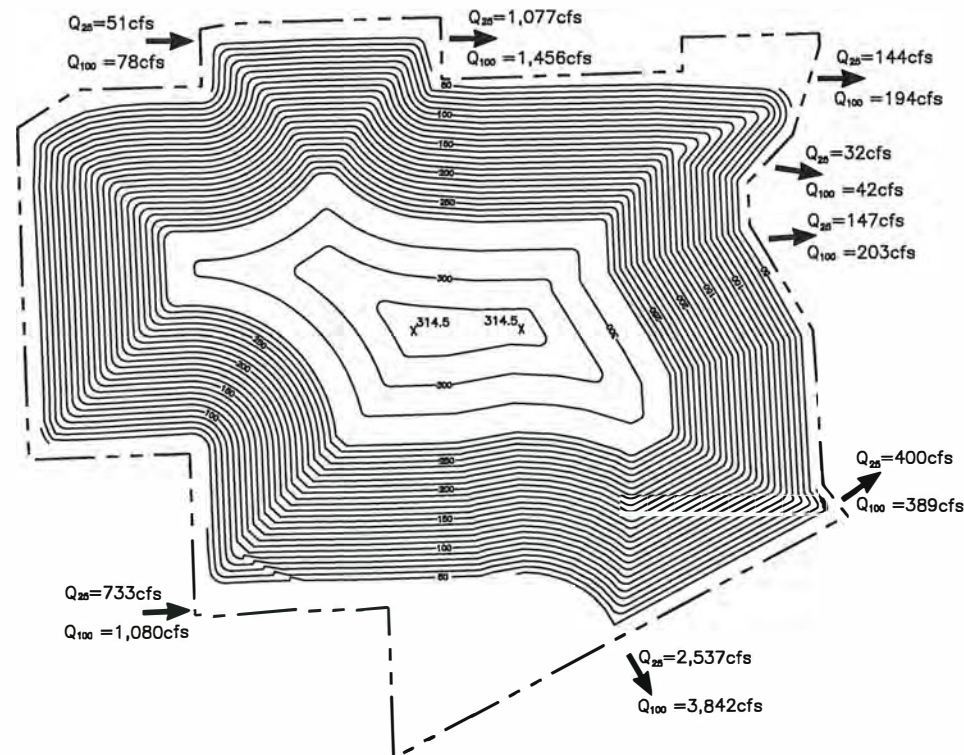

CURRENTLY PERMITTED CONDITION

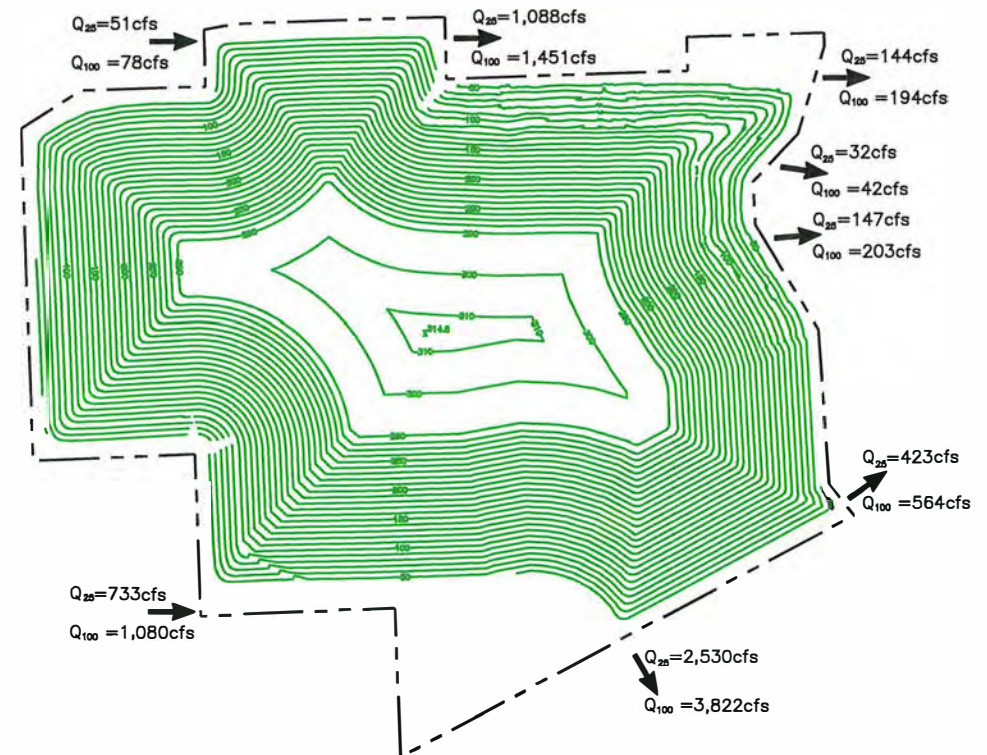


PROPOSED FINAL CONTOUR IMPROVEMENTS

LEGEND


- PERMIT BOUNDARY  
100 ELEVATION OF FINAL COVER SYSTEM

NOTES:

- SEE ATTACHMENT 6A-A FOR POST DEVELOPMENT HYDROLOGIC INFORMATION.
- SEE ATTACHMENT 6A-E FOR CURRENTLY PERMITTED HYDROLOGIC INFORMATION.

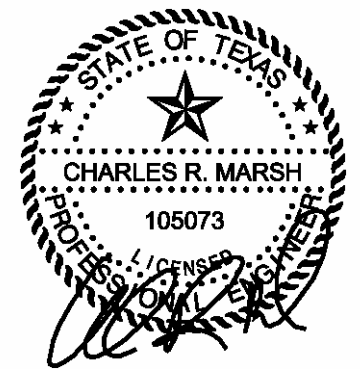


12/12/2024


<input type="checkbox"/> DRAFT <input checked="" type="checkbox"/> FOR PERMITTING PURPOSES ONLY <input type="checkbox"/> ISSUED FOR CONSTRUCTION		PREPARED FOR <b>McCARTY ROAD LANDFILL TX, LP</b>		MAJOR PERMIT AMENDMENT SITE DRAINAGE PATTERNS	
DATE: 03/2004 FILE: 0120-439-11 CAD: FIG-4.3 PATTERNS.DWG		DRAWN BY: JDW DESIGN BY: SAN REVIEWED BY: JPY		McCARTY ROAD LANDFILL HARRIS COUNTY, TEXAS	
 <b>Weaver Consultants Group</b> TBPB REGISTRATION NO. F-3727		REVISIONS		WWW.WCGRP.COM	
		NO.	DATE	DESCRIPTION	
		1	08/2006	PERMIT MODIFICATION UPDATE	
		2	01/2012	PERMIT MODIFICATION	
		3	12/2024	PERMIT MODIFICATION	



PEAK FLOW ENTERING NORTHWEST PERMIT BOUNDARY  
HCFC DITCH P116-00-00

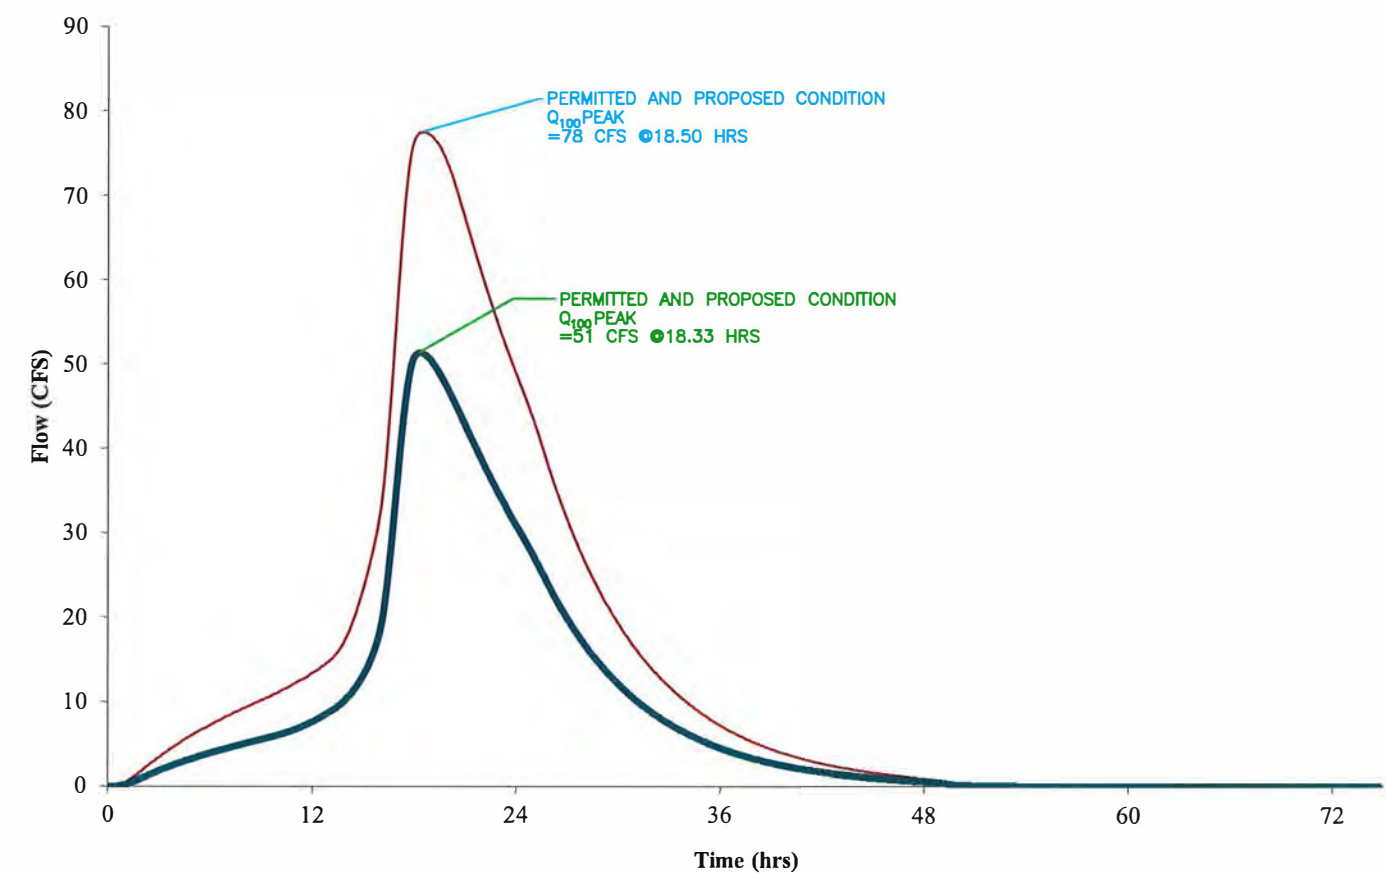

PEAK FLOW LEAVING NORTHEAST PERMIT BOUNDARY  
HCFC DITCH P116-00-00

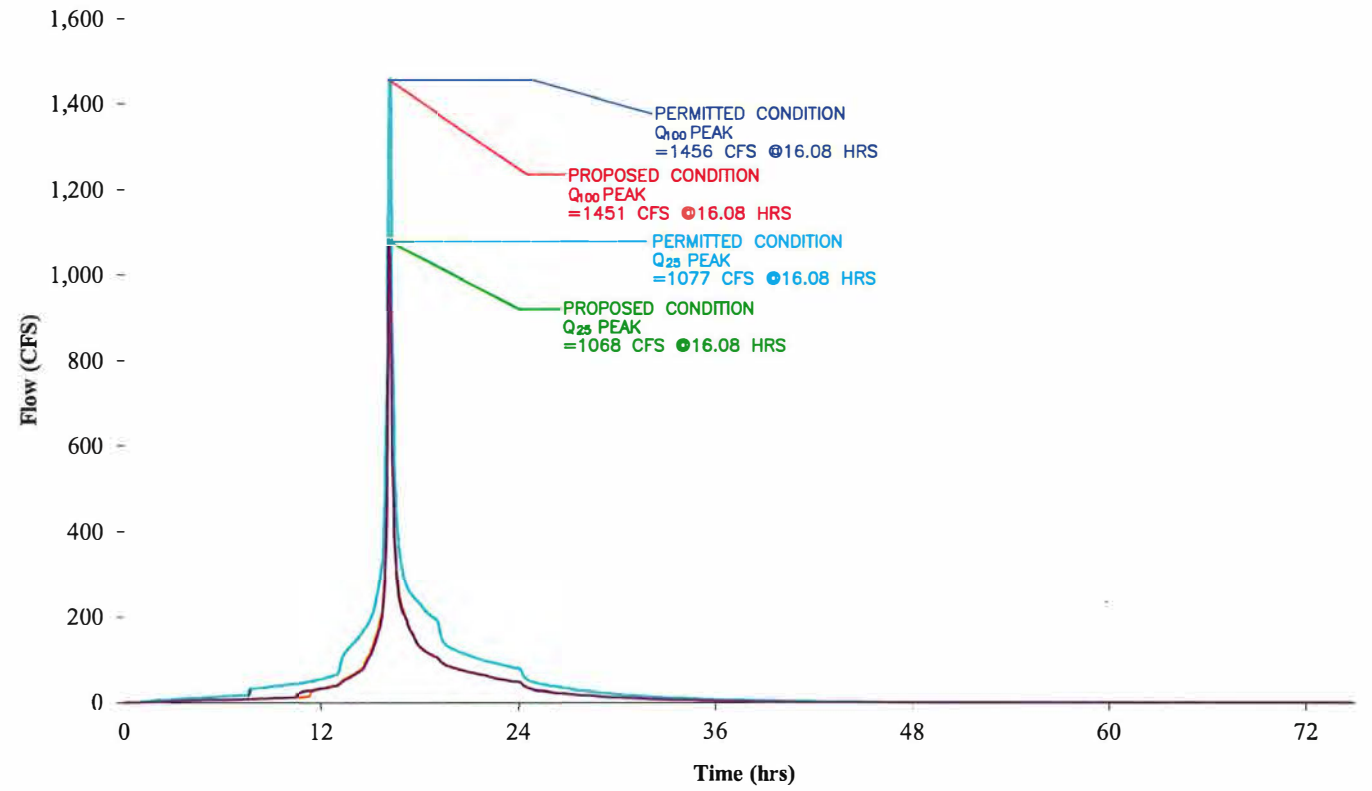


STATE OF TEXAS  
★  
CHARLES R. MARSH  
105073  
PROF. LICENSED  
12/12/2024


<input type="checkbox"/> DRAFT <input checked="" type="checkbox"/> FOR PERMITTING PURPOSES ONLY <input type="checkbox"/> ISSUED FOR CONSTRUCTION	PREPARED FOR <b>McCARTY ROAD LANDFILL TX, LP</b>	<b>MAJOR PERMIT AMENDMENT PEAK FLOW COMPARISON HCFC DITCH P116-00-00 (NORTH)</b>  McCARTY ROAD LANDFILL HARRIS COUNTY, TEXAS	
DATE: 03/2004 FILE: 0120-439-11 CAD: FIG-4.4 PEAK.DWG	DRAWN BY: JDW DESIGN BY: SAN REVIEWED BY: JPY		REVISIONS
<b>Weaver Consultants Group</b> TBPE REGISTRATION NO. F-3727			NO. DATE DESCRIPTION
			1 08/2006 PERMIT MODIFICATION UPDATE 2 01/2012 PERMIT MODIFICATION 3 12/2024 PERMIT MODIFICATION
		WWW.WCGRP.COM	FIGURE 4.4

D:\0120\439\FLIP MOD 2024\ATT 6\FIGURES\CLEAN\FIG-4.4 PEAK.dwg, vnguzman, 1:2

PEAK FLOW ENTERING SOUTHWEST PERMIT BOUNDARY  
HCFCD DITCH P114-00-00

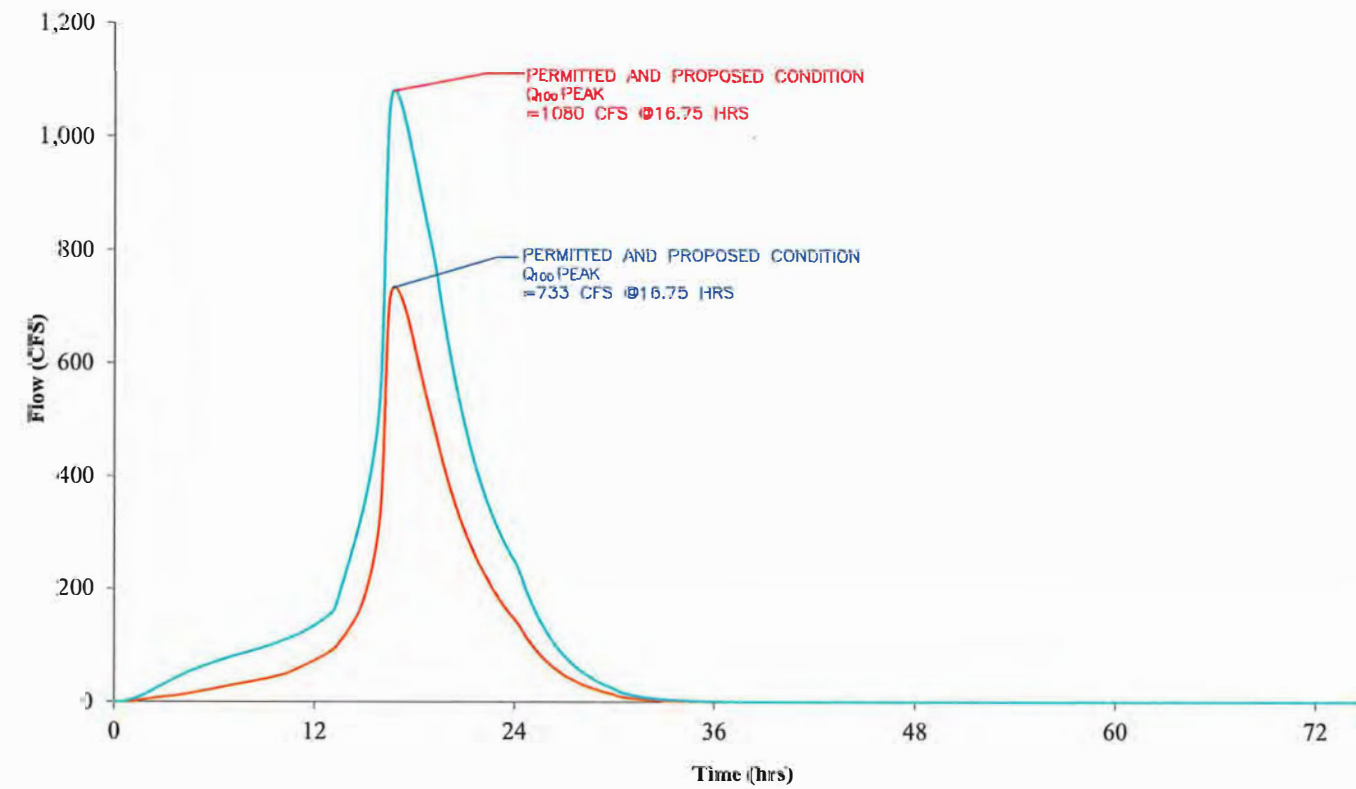

PEAK FLOW LEAVING SOUTH PERMIT BOUNDARY  
HCFCD DITCH P114-00-00

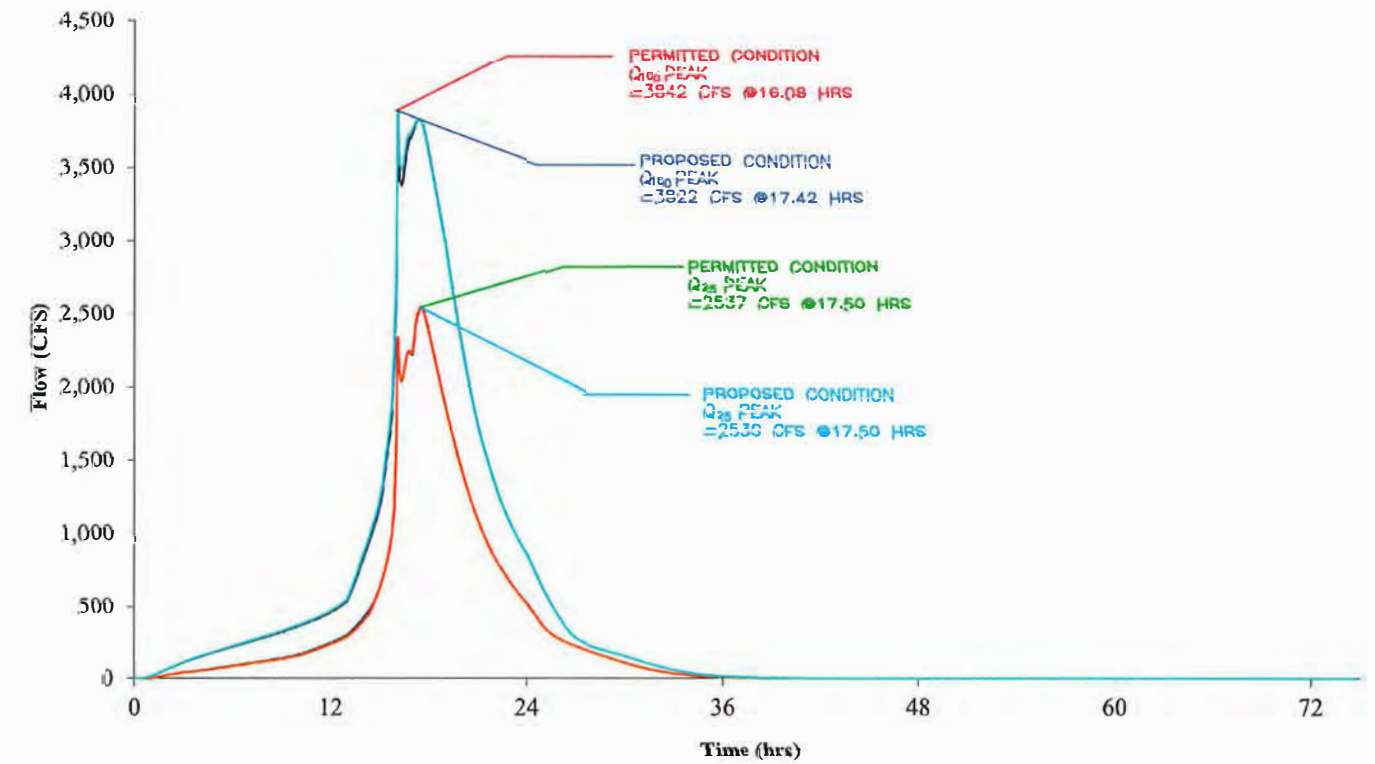


STATE OF TEXAS  
★  
CHARLES R. MARSH  
105073  
PROFESSIONAL ENGINEER  
12/12/2024

<input type="checkbox"/> DRAFT <input checked="" type="checkbox"/> FOR PERMITTING PURPOSES ONLY <input type="checkbox"/> ISSUED FOR CONSTRUCTION		PREPARED FOR <b>McCARTY ROAD LANDFILL TX, LP</b>		<b>MAJOR PERMIT AMENDMENT PEAK FLOW COMPARISON HCFCD DITCH P114-00-00 (SOUTH)</b> McCARTY ROAD LANDFILL HARRIS COUNTY, TEXAS													
DATE: 01/2004 FILE: (1120-430-1) Q25: PG-4.5 PEAK.DWG		DRAWN BY: JOW DESIGN BY: SAN REVIEWED BY: JOW		REVISIONS <table border="1"> <thead> <tr> <th>NO.</th> <th>DATE</th> <th>DESCRIPTION</th> </tr> </thead> <tbody> <tr> <td>1</td> <td>08/2006</td> <td>PERMIT MODIFICATION UPDATE</td> </tr> <tr> <td>2</td> <td>01/2012</td> <td>PERMIT MODIFICATION</td> </tr> <tr> <td>3</td> <td>12/2024</td> <td>PERMIT MODIFICATION</td> </tr> </tbody> </table>		NO.	DATE	DESCRIPTION	1	08/2006	PERMIT MODIFICATION UPDATE	2	01/2012	PERMIT MODIFICATION	3	12/2024	PERMIT MODIFICATION
NO.	DATE	DESCRIPTION															
1	08/2006	PERMIT MODIFICATION UPDATE															
2	01/2012	PERMIT MODIFICATION															
3	12/2024	PERMIT MODIFICATION															
<b>Weaver Consultants Group</b> TYPE REGISTRATION NO. T-3727				WWW.WCGRP.COM	<b>FIGURE 4.5</b>												




D:\0120\439\FLIP MOD 2024\ATT 6\FIGURES\CLEAN\FIG-4.6 PEAK.dwg, V:\userman, 1:2

COMBINED FLOW INTO GREENS BAYOU (EAST)


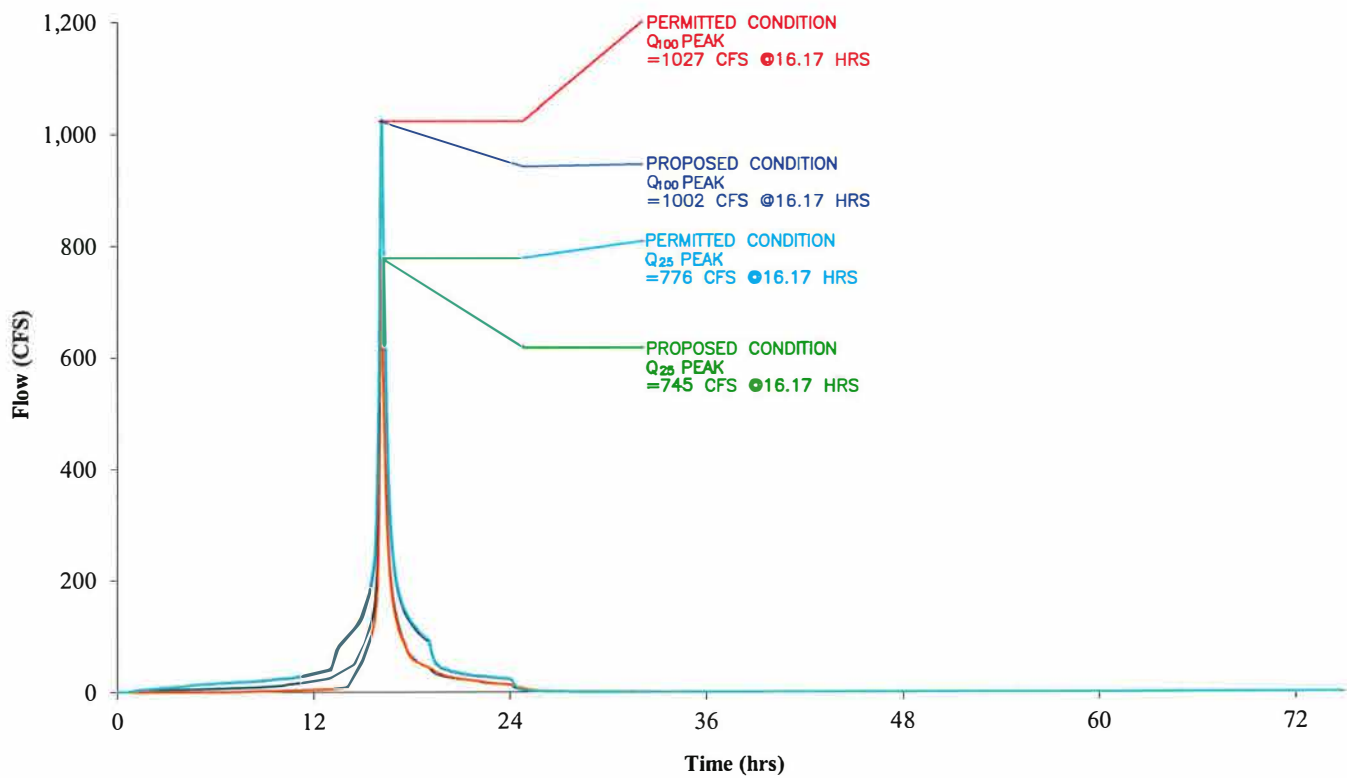


STATE OF TEXAS  
★  
CHARLES R. MARSH  
105073  
PROF. L. LICENSED  
12/12/2024


<input type="checkbox"/> DRAFT <input checked="" type="checkbox"/> FOR PERMITTING PURPOSES ONLY <input type="checkbox"/> ISSUED FOR CONSTRUCTION		PREPARED FOR <b>McCARTY ROAD LANDFILL TX, LP</b>		<b>MAJOR PERMIT AMENDMENT COMBINED FLOW INTO GREENS BAYOU (EAST) McCARTY ROAD LANDFILL HARRIS COUNTY, TEXAS</b>			
DATE: 03/2004 FILE: 0120-439-11 CAD: FIG-4.6 PEAK.DWG		DRAWN BY: JDW DESIGN BY: SAN REVIEWED BY: JPY				REVISIONS	
						NO. DATE DESCRIPTION	
						1 06/2006 PERMIT MODIFICATION UPDATE	
				2 12/2024 PERMIT MODIFICATION		WWW.WCGRP.COM	
 <b>Weaver Consultants Group</b> TBPE REGISTRATION NO. F-3727						FIGURE 4.6	

D:\0120\438\FLIP MOD 2024\ATT 6\FIGURES\CLEAN\FIG-4.7 PEAK.dwg, vguzman, 1:2


PEAK FLOW FOR COMBINED FLOW IN GREENS BAYOU  
HCFCD CHANNEL P100-00-00

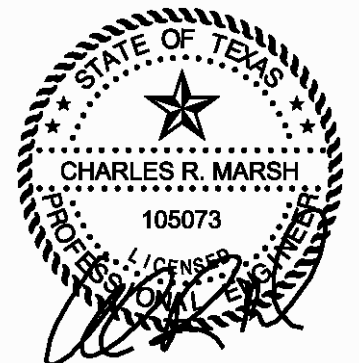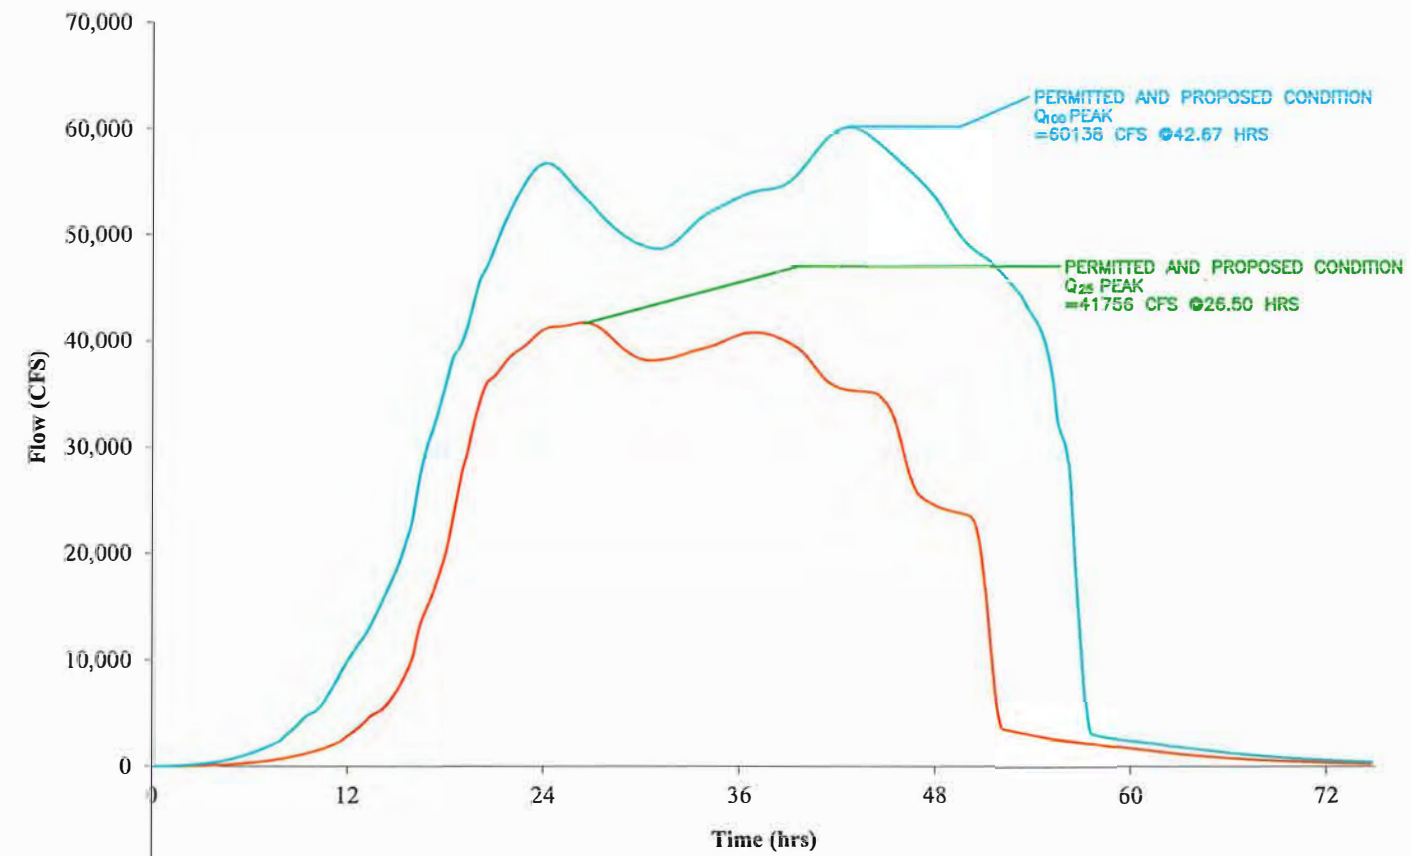

12/12/2024

<input type="checkbox"/> DRAFT <input checked="" type="checkbox"/> FOR PERMITTING PURPOSES ONLY <input type="checkbox"/> ISSUED FOR CONSTRUCTION		PREPARED FOR <b>McCARTY ROAD LANDFILL TX, LP</b>		<b>MAJOR PERMIT AMENDMENT COMBINED FLOW COMPARISON FOR GREENS BAYOU</b>  McCARTY ROAD LANDFILL HARRIS COUNTY, TEXAS			
DATE: 03/2004 FILE: 0120-438-11 CAD: FIG-4.7 PEAK.DWG		DRAWN BY: JOW DESIGN BY: SAN REVIEWED BY: JPY				REVISIONS	
						NO. DATE DESCRIPTION	
						1 08/2008 PERMIT MODIFICATION UPDATE	
 <b>Weaver Consultants Group</b> TBPE REGISTRATION NO. F-3727				2 01/2012 PERMIT MODIFICATION			
				3 12/2024 PERMIT MODIFICATION			
				WWW.WCGRP.COM			
				FIGURE 4.7			



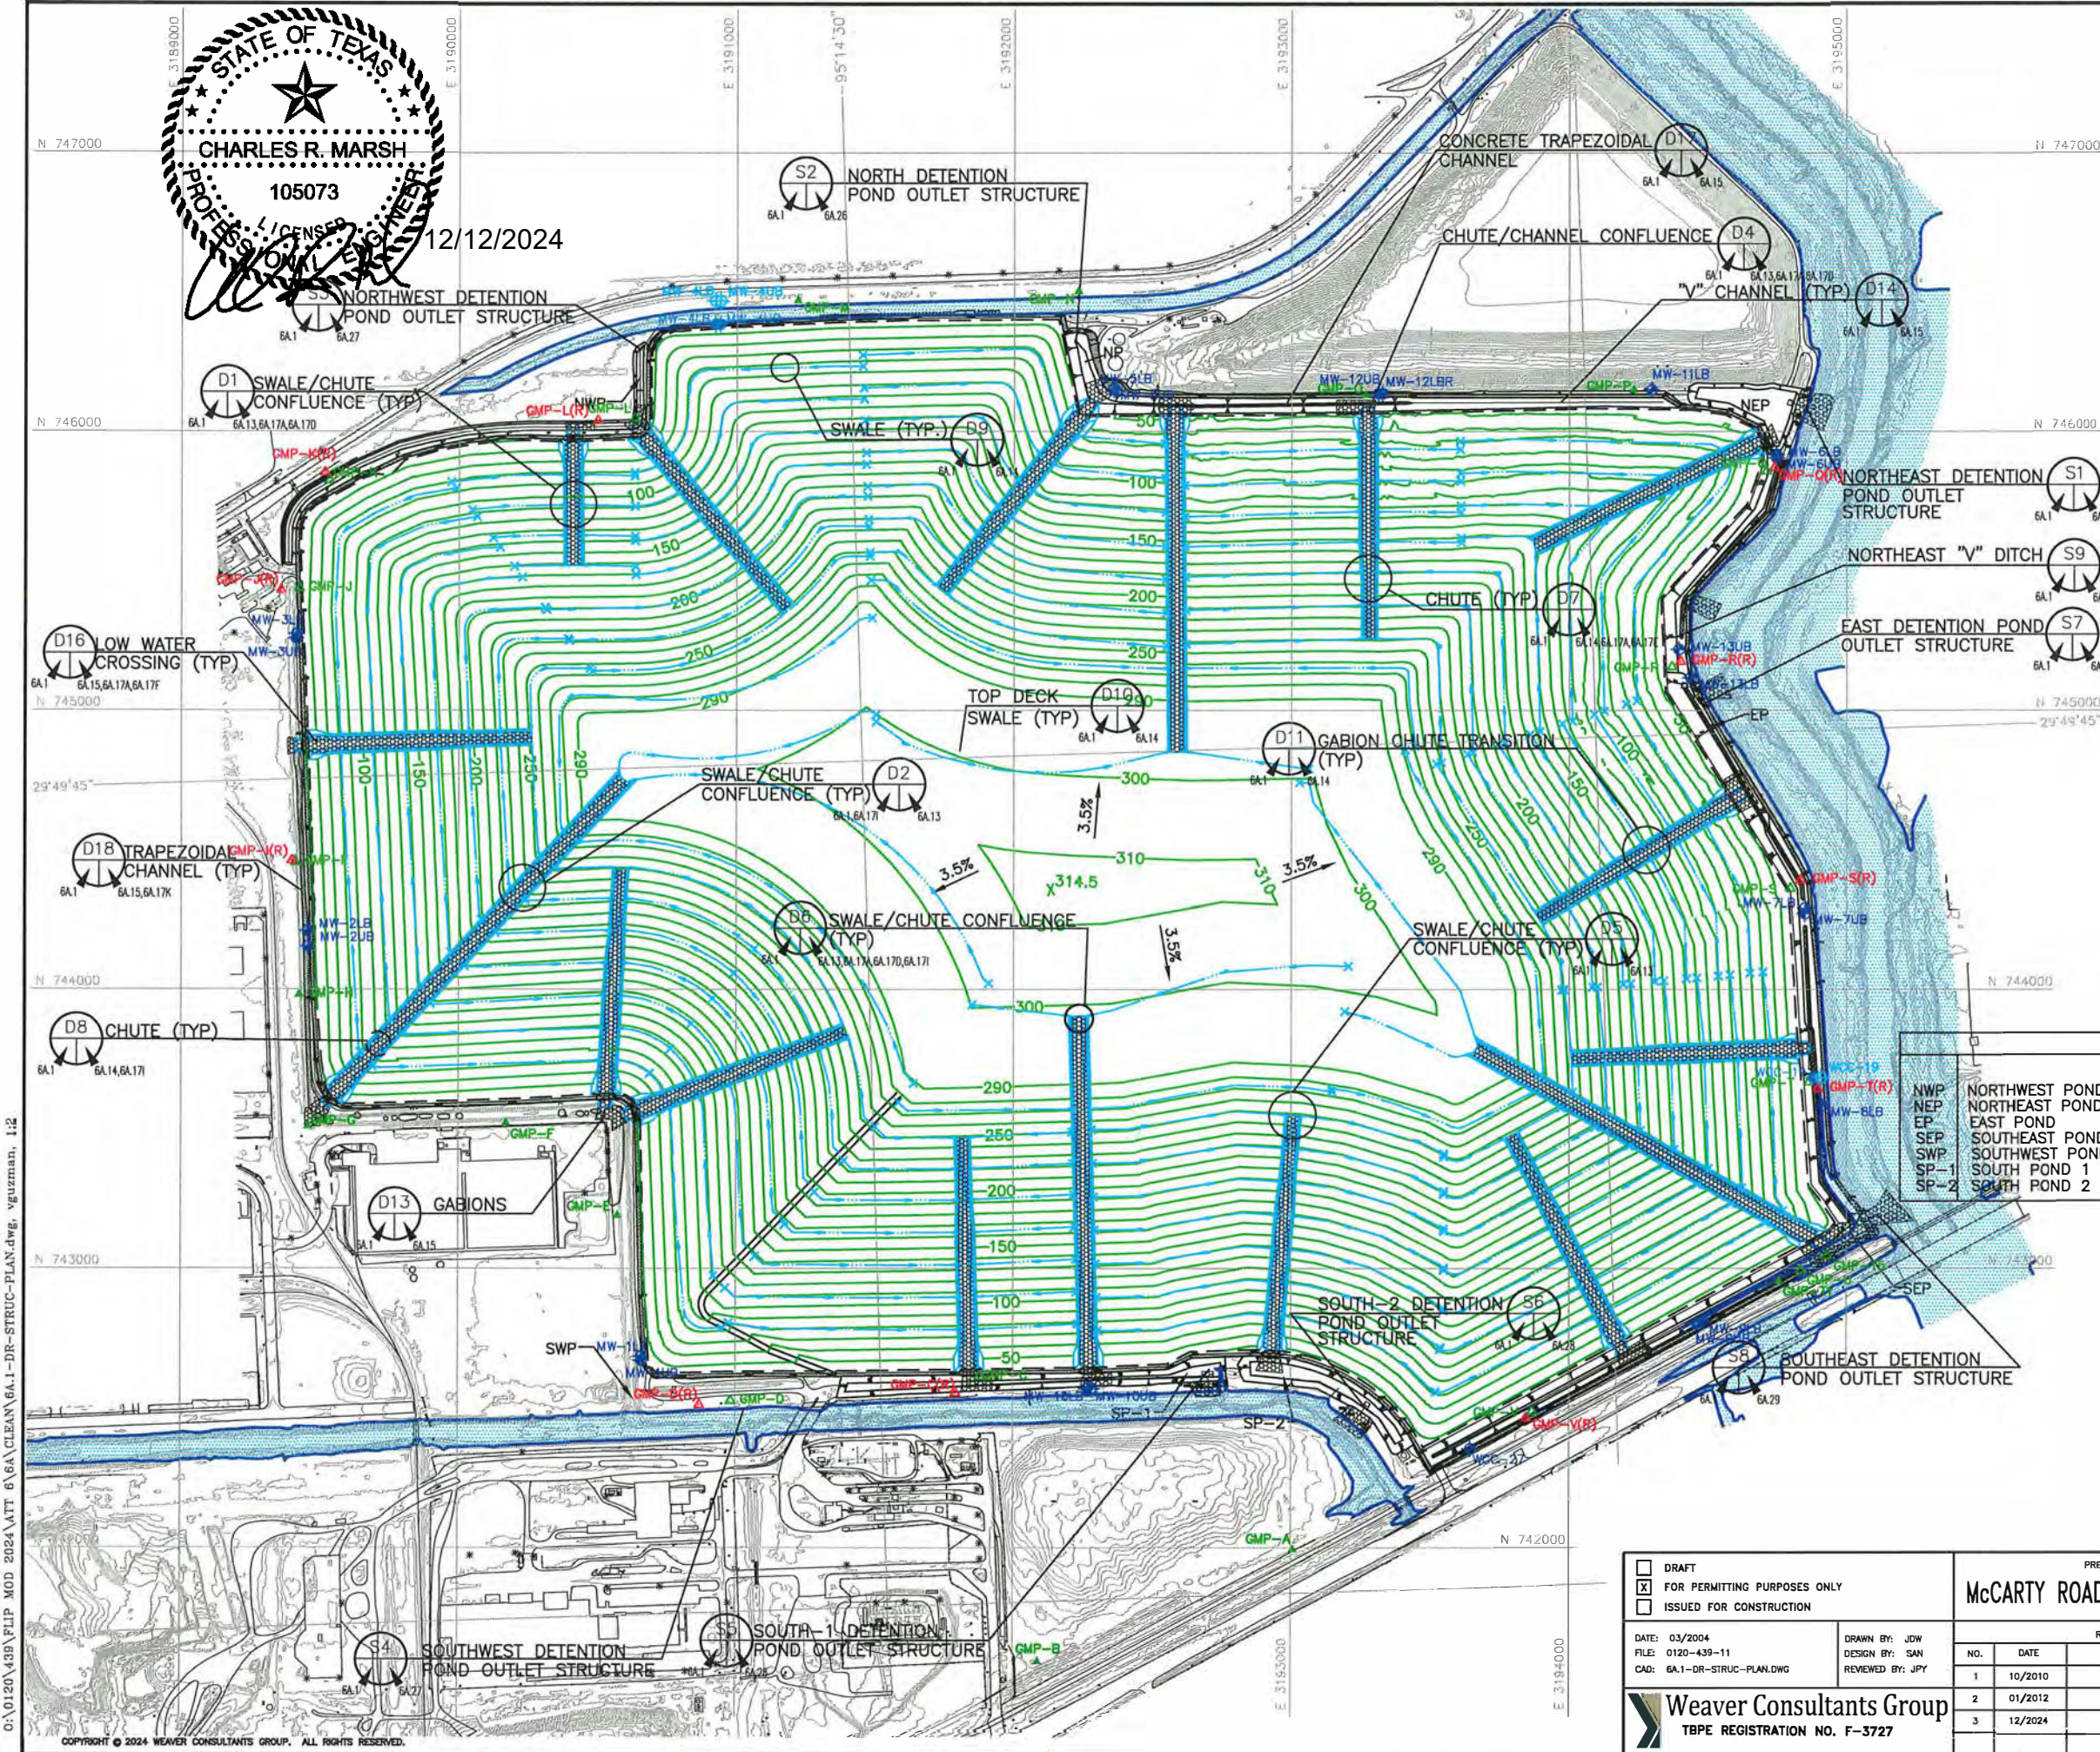

NORTHWEST DETENTION  
POND OUTLET STRUCTURE

NORTH DETENTION	
POND OUTLET STRUCTURE	

CONCRETE TRAPEZOIDAL CHANNEL

CHUTE/CHANNEL CONFLUENCE (D4)

6A1 6A13, 6A17 6A17D  
"V" CHANNEL (TYP)

Figure 1

(R) NORTHE  
POND G

STRUCTURE

NORTHE

[illegible]

EAST DE  
OUTLET



...the ...

Figure 1

$P \rightarrow S(R)$

W-7UB

**Abstract** The purpose of this study was to determine whether there were differences in the prevalence of self-reported depression between men and women who had been exposed to violence during childhood and adulthood. Data from the National Longitudinal Study of Adolescent Health (*N = 9,800*) were used to examine the association between exposure to violence and self-reported depression among adolescents. Results showed that exposure to violence during childhood and adulthood was associated with higher rates of self-reported depression. Furthermore, the association between exposure to violence and self-reported depression was stronger for women than for men.

Group	Condition A	Condition B	Condition C	Condition D
Control	~95	~95	~95	~95
MCI	~85	~85	~85	~85
AD	~75	~75	~75	~75

1

WCC-19  
GMP-T(R)

MW-8LB

12

GMP-15



HEAST DE  
OUTLET

---












 







ONLY

DRAWN BY: JH

DESIGN BY: S  
REVIEWED BY:

## stants Gr


D. F-3727

	PERMIT BOUNDARY	
	LIMITS OF WASTE	
	DEED RESTRICTION BOUNDARY (SEE NOTE 7)	
	FINAL CONTOUR	
	STATE PLANE COORDINATE SYSTEM	
	GEODETTIC COORDINATE SYSTEM	
	EXISTING GROUND CONTOUR	
	PROPOSED DRAINAGE SWALE	
	PROPOSED DRAINAGE LETDOWN (SEE NOTE 9)	
	EXISTING DETECTION GROUNDWATER MONITORING WELL	
	EXISTING DETECTION GROUNDWATER MONITORING WELL TO BE DECOMMISSIONED	
	PROPOSED DETECTION REPLACEMENT MONITORING WELL	
	EXISTING LANDFILL GAS MONITORING PROBE (SEE NOTE 8)	
	EXISTING LANDFILL GAS MONITORING PROBE TO BE DECOMMISSIONED (SEE NOTE 8)	
	PROPOSED REPLACEMENT LANDFILL GAS MONITORING PROBE (SEE NOTE 8)	
	EASEMENT BOUNDARY	
	GABIONS	
	100-YR FLOODPLAIN (REFER TO ATTACHMENT 6C)	


1. TOPOGRAPHIC MAPPING PREPARED BY FIRMATEK FROM AERIAL PHOTOGRAPHY FLOWN 11-17-2023. THE GRID SYSTEM IS TIED TO THE TEXAS STATE PLANE COORDINATE SYSTEM SOUTH CENTRAL ZONE NAD 1927.
2. PERMIT BOUNDARY AND EASEMENTS WERE REPRODUCED FROM COSTELLO, INC. STANDARD LAND SURVEY DRAWING, DATED MARCH 2004.
3. REFER TO ATTACHMENT 7B FOR POST DEVELOPMENT DRAINAGE INFORMATION.
4. COVER DETAILS ARE PROVIDED IN ATTACHMENT 6D-FINAL COVER DETAILS.
5. TYPICAL SIDESLOPES ARE 4H:1V, TYPICAL TOPSLOPE IS 3.5%.
6. DETENTION POND INFORMATION IS PROVIDED ON ATTACHMENTS 6A.18 THROUGH 6A.25.
7. REFER TO ATTACHMENT 6, APPENDIX 6A-F FOR DEED RESTRICTION INFORMATION.
8. GAS MONITORING PROBES GMP-Q, GMP-R, AND GMP-S ARE BEING DECOMMISSIONED AND RELOCATED AS DOCUMENTED IN A PERMIT MODIFICATION SUBMITTED BY WEAVER BOOS CONSULTANTS (WBC) IN APRIL 2004. GMP-T5 AND GMP-U ARE BEING DECOMMISSIONED IN A PERMIT MODIFICATION SUBMITTED BY WBC IN APRIL 2004. GMP-T1 WILL BECOME A PERMANENT GAS MONITORING PROBE FOR THIS AREA. REFER TO ATTACHMENT 14 FOR ADDITIONAL INFORMATION.
9. GABION-LINED LETDOWN DETAILS ARE INCLUDED ON ATTACHMENTS 6A.13 THROUGH 6A.17. FLEXIBLE MEMBRANE LINED (FML) LETDOWN DETAILS ARE INCLUDED ON ATTACHMENTS 6A.17A THROUGH 6A.17C. FLEXAMAT LETDOWN DETAILS ARE INCLUDED ON ATTACHMENTS 6A.17D THROUGH 6A.17H. ARTICULATED BLOCK LETDOWN DETAILS ARE INCLUDED ON ATTACHMENTS 6A.17I THROUGH 6A.17L.

<p>MAJOR PERMIT AMENDMENT DRAINAGE STRUCTURE PLAN</p> <p>McCARTY ROAD LANDFILL HARRIS COUNTY, TEXAS</p>	
<p>WWW.WCGRP.COM</p>	<p>ATTACHMENT 6A.1</p>



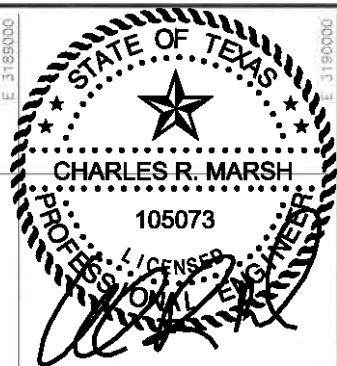

12/12/2024

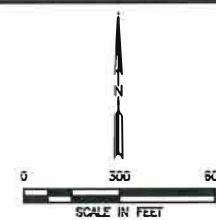

LEGEND

- PERMIT BOUNDARY
- LIMITS OF WASTE
- DEED RESTRICTION BOUNDARY (SEE NOTE 4)
- FINAL CONTOUR
- STATE PLANE COORDINATE SYSTEM
- GEODETIC COORDINATE SYSTEM
- EXISTING CONTOUR
- PROPOSED DRAINAGE SWALE
- PROPOSED DRAINAGE LETDOWN
- EXISTING DETECTION GROUNDWATER MONITORING WELL
- EXISTING DETECTION GROUNDWATER MONITORING WELL TO BE DECOMMISSIONED
- PROPOSED DETECTION REPLACEMENT MONITORING WELL
- EXISTING LANDFILL GAS MONITORING PROBE (SEE NOTE 5)
- EXISTING LANDFILL GAS MONITORING PROBE TO BE DECOMMISSIONED (SEE NOTE 5)
- PROPOSED REPLACEMENT LANDFILL GAS MONITORING ROBE (SEE NOTE 5)
- EASEMENT BOUNDARY
- GABIONS
- 100-YR FLOODPLAIN (REFER TO ATTACHMENT 6C)
- DRAINAGE AREA DESIGNATION
- DRAINAGE AREA BOUNDARY

NOTES:

- TOPOGRAPHIC MAPPING PREPARED BY FIRMATEK FROM AERIAL PHOTOGRAPHY FLOWN 11-17-2023. THE GRID SYSTEM IS TIED TO THE TEXAS STATE PLANE COORDINATE SYSTEM SOUTH CENTRAL ZONE NAD 1927.
- PERMIT BOUNDARY AND EASEMENTS WERE REPRODUCED FROM COSTELLO, INC. STANDARD LAND SURVEY DRAWING, DATED MARCH 2004.
- REFER TO ATTACHMENT 7B FOR POST DEVELOPMENT DRAINAGE INFORMATION.
- REFER TO ATTACHMENT 6, APPENDIX 6A-F FOR DEED RESTRICTION INFORMATION.
- GAS MONITORING PROBES GMP-Q, GMP-R, AND GMP-S ARE BEING DECOMMISSIONED AND RELOCATED AS DOCUMENTED IN A PERMIT MODIFICATION SUBMITTED BY WEAVER BOOS CONSULTANTS (WBC) IN APRIL 2004. GMP-T5 AND GMP-U ARE BEING DECOMMISSIONED IN A PERMIT MODIFICATION SUBMITTED BY WBC IN APRIL 2004. GMP-T1 WILL BECOME A PERMANENT GAS MONITORING PROBE FOR THIS AREA. REFER TO ATTACHMENT 14 FOR ADDITIONAL INFORMATION.

- ☐ DRAFT
- ☒ FOR PERMITTING PURPOSES ONLY
- ☐ ISSUED FOR CONSTRUCTION

DATE: 03/2004  
FILE: 0120-439-11  
CAD: 6A.2-PRO-DR-AREAS.DWG

DRAWN BY: JOW  
DESIGN BY: SAN  
REVIEWED BY: JPY

Weaver Consultants Group  
TBPE REGISTRATION NO. F-3727

PREPARED FOR  
McCARTY ROAD LANDFILL TX, LP

REVISIONS		
NO.	DATE	DESCRIPTION
1	01/2012	PERMIT MODIFICATION
2	12/2024	PERMIT MODIFICATION


MAJOR PERMIT AMENDMENT  
DRAINAGE AREA PLAN

McCARTY ROAD LANDFILL  
HARRIS COUNTY, TEXAS

WWW.WCGRP.COM

ATTACHMENT 6A.2



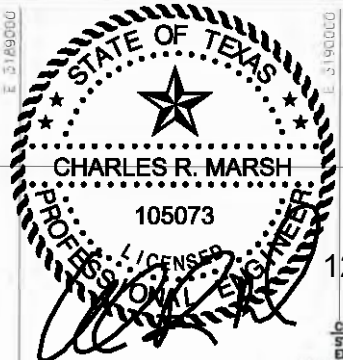

12/12/2024

**LEGEND**

- PERMIT BOUNDARY
- LIMITS OF WASTE
- DEED RESTRICTION BOUNDARY (SEE NOTE 4)
- STATE PLANE COORDINATE SYSTEM
- GEODETIC COORDINATE SYSTEM
- EXISTING CONTOUR
- EXISTING DETECTION GROUNDWATER MONITORING WELL
- EXISTING DETECTION GROUNDWATER MONITORING WELL TO BE DECOMMISSIONED
- PROPOSED DETECTION REPLACEMENT MONITORING WELL
- EXISTING LANDFILL GAS MONITORING PROBE (SEE NOTE 5)
- EXISTING LANDFILL GAS MONITORING PROBE TO BE DECOMMISSIONED (SEE NOTE 5)
- PROPOSED REPLACEMENT LANDFILL GAS MONITORING PROBE (SEE NOTE 5)
- EASEMENT BOUNDARY
- DABIONS
- CONCRETE
- POINT OF INTERSECTION
- POINT OF VERTICAL INTERSECTION
- STATION (FT)
- ELEVATION (FT-MSL)
- 25-YEAR PEAK FLOW RATE (CUBIC FEET PER SECOND)
- 100-YEAR PEAK FLOW RATE (CUBIC FEET PER SECOND)

**POND LABELS**



NP	NORTH POND
NWP	NORTHWEST POND
NEP	NORTHEAST POND
EP	EAST POND
SEP	SOUTHEAST POND
SWP	SOUTHWEST POND
SP-1	SOUTH POND 1
SP-2	SOUTH POND 2

- NOTES:**
- TOPOGRAPHIC MAPPING PREPARED BY FIRMATEK FROM AERIAL PHOTOGRAPHY FLOWN 11-17-2023. THE GRID SYSTEM IS TIED TO THE TEXAS STATE PLANE COORDINATE SYSTEM SOUTH CENTRAL ZONE NAD 1927.
  - PERMIT BOUNDARY AND EASEMENTS WERE REPRODUCED FROM COSTELLO, INC. STANDARD LAND SURVEY DRAWING, DATED MARCH 2004.
  - CHANNEL PROFILE INFORMATION PRESENTED ON ATTACHMENTS DA-4 THROUGH DA-13.
  - REFER TO ATTACHMENT D, APPENDIX DA-F FOR DEED RESTRICTION INFORMATION.
  - GAS MONITORING PROBES GMP-Q, GMP-R, AND GMP-S ARE BEING DECOMMISSIONED AND RELOCATED AS DOCUMENTED IN A PERMIT MODIFICATION SUBMITTED BY WEAVER BOUS CONSULTANTS (WBC) IN APRIL 2004. GMP-TS AND GMP-U ARE BEING DECOMMISSIONED IN A PERMIT MODIFICATION SUBMITTED BY WBC IN APRIL 2004. GMP-T1 WILL BECOME A PERMANENT GAS MONITORING PROBE FOR THIS AREA.

<input type="checkbox"/> DRAFT		PREPARED FOR		McCARTY ROAD LANDFILL TX, LP	
<input checked="" type="checkbox"/> FOR PERMITTING PURPOSES ONLY					
<input type="checkbox"/> ISSUED FOR CONSTRUCTION					
DATE: 05/20/04		DESIGNED BY: WBC		REVIEWED BY: WBC	
FILE: 0120L-038-11		DESIGN BY: WBC		REVIEWED BY: WBC	
DWG: 6A.03-PER-STRUC-PLAN.dwg		DESIGN BY: WBC		REVIEWED BY: WBC	
Weaver Consultants Group		TBPB REGISTRATION NO. T-5727		MAJOR PERMIT AMENDMENT PERIMETER DRAINAGE PLAN	
				McCARTY ROAD LANDFILL HARRIS COUNTY, TEXAS	
				WWW.WCGM.COM ATTACHMENT 6A.3	

O:\0120\439\PLP MOD 2024\ATT 6A\CLEAN\6a.03-PER-STRUC-PLAN.dwg, vgluzman, 1:2



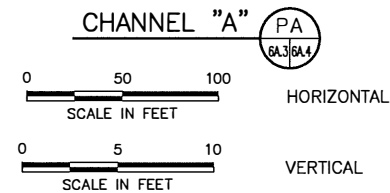
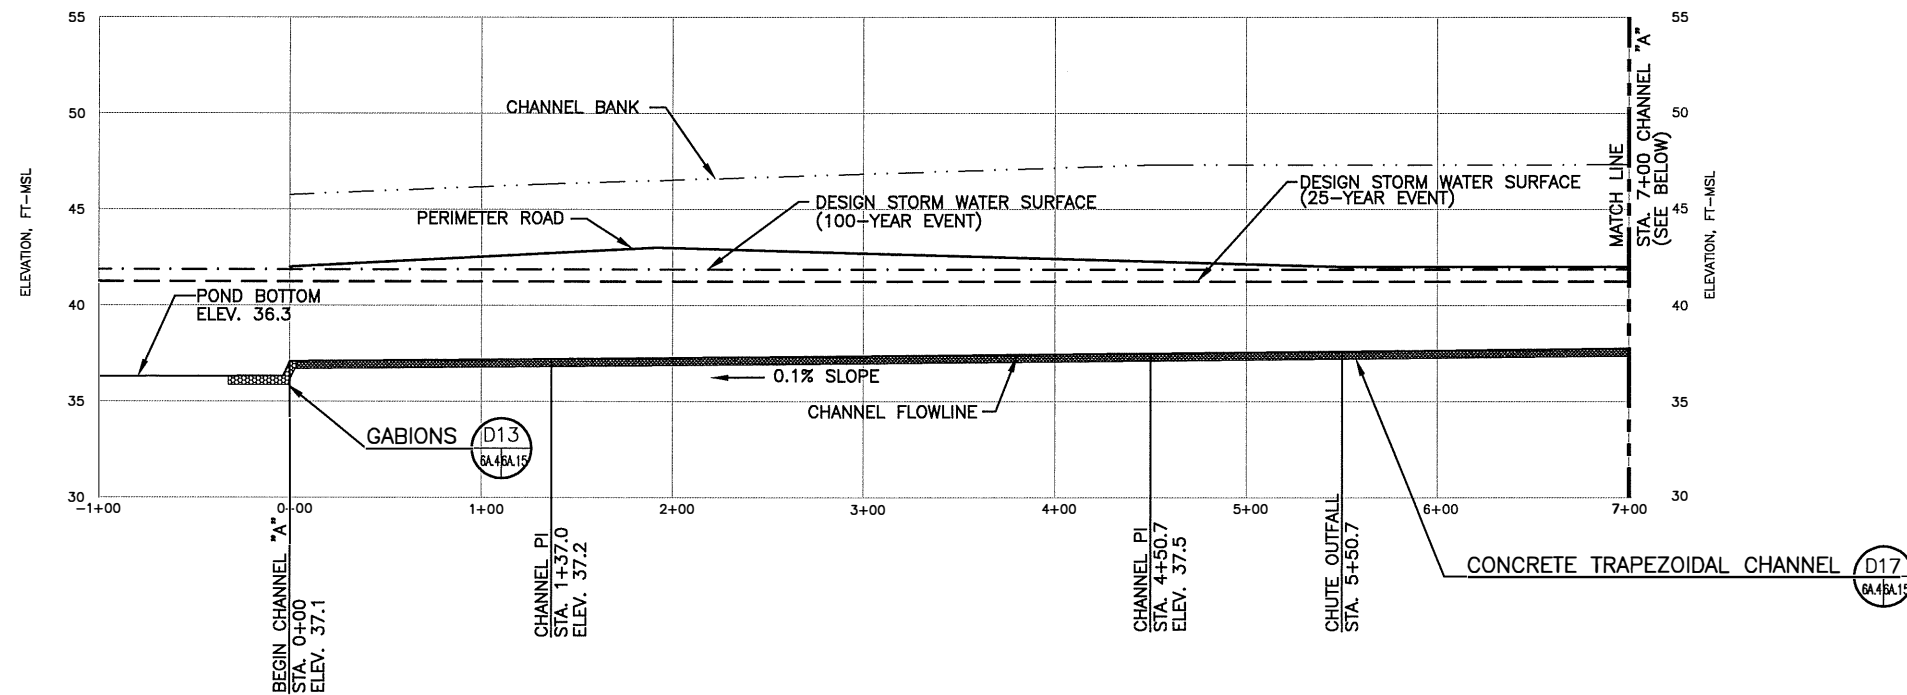


25-YEAR CHANNEL "A" INFORMATION						
CHANNEL FROM	STATION TO	BOTTOM WIDTH (FT)	PEAK INFLOW (CFS)	SLOPE (%)	FLOW DEPTH (FT.)	VELOCITY (FT/S)
0+00	1+37	12	315	0.1	2.99	5.02
1+37	4+50.7	12	315	0.1	2.99	5.02
4+50.7	7+68.1	12	315	0.1	2.99	5.02
7+68.1	16+89.6	0	34	0.1	2.82	1.43

NOTE: NORMAL DEPTH CALCULATION DOES NOT ACCOUNT FOR BACK WATER WHICH WILL INCREASE FLOW DEPTH (SEE PROFILE) AND DECREASE VELOCITY.


100-YEAR CHANNEL "A" INFORMATION						
CHANNEL FROM	STATION TO	BOTTOM WIDTH (FT)	PEAK INFLOW (CFS)	SLOPE (%)	FLOW DEPTH (FT.)	VELOCITY (FT/S)
0+00	1+37	12	432	0.1	3.50	5.47
1+37	4+50.7	12	432	0.1	3.50	5.47
4+50.7	7+68.1	12	432	0.1	3.50	5.47
7+68.1	16+89.6	0	48	0.1	3.21	1.55

NOTE: NORMAL DEPTH CALCULATION DOES NOT ACCOUNT FOR BACK WATER WHICH WILL INCREASE FLOW DEPTH (SEE PROFILE) AND DECREASE VELOCITY.

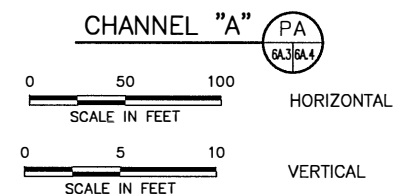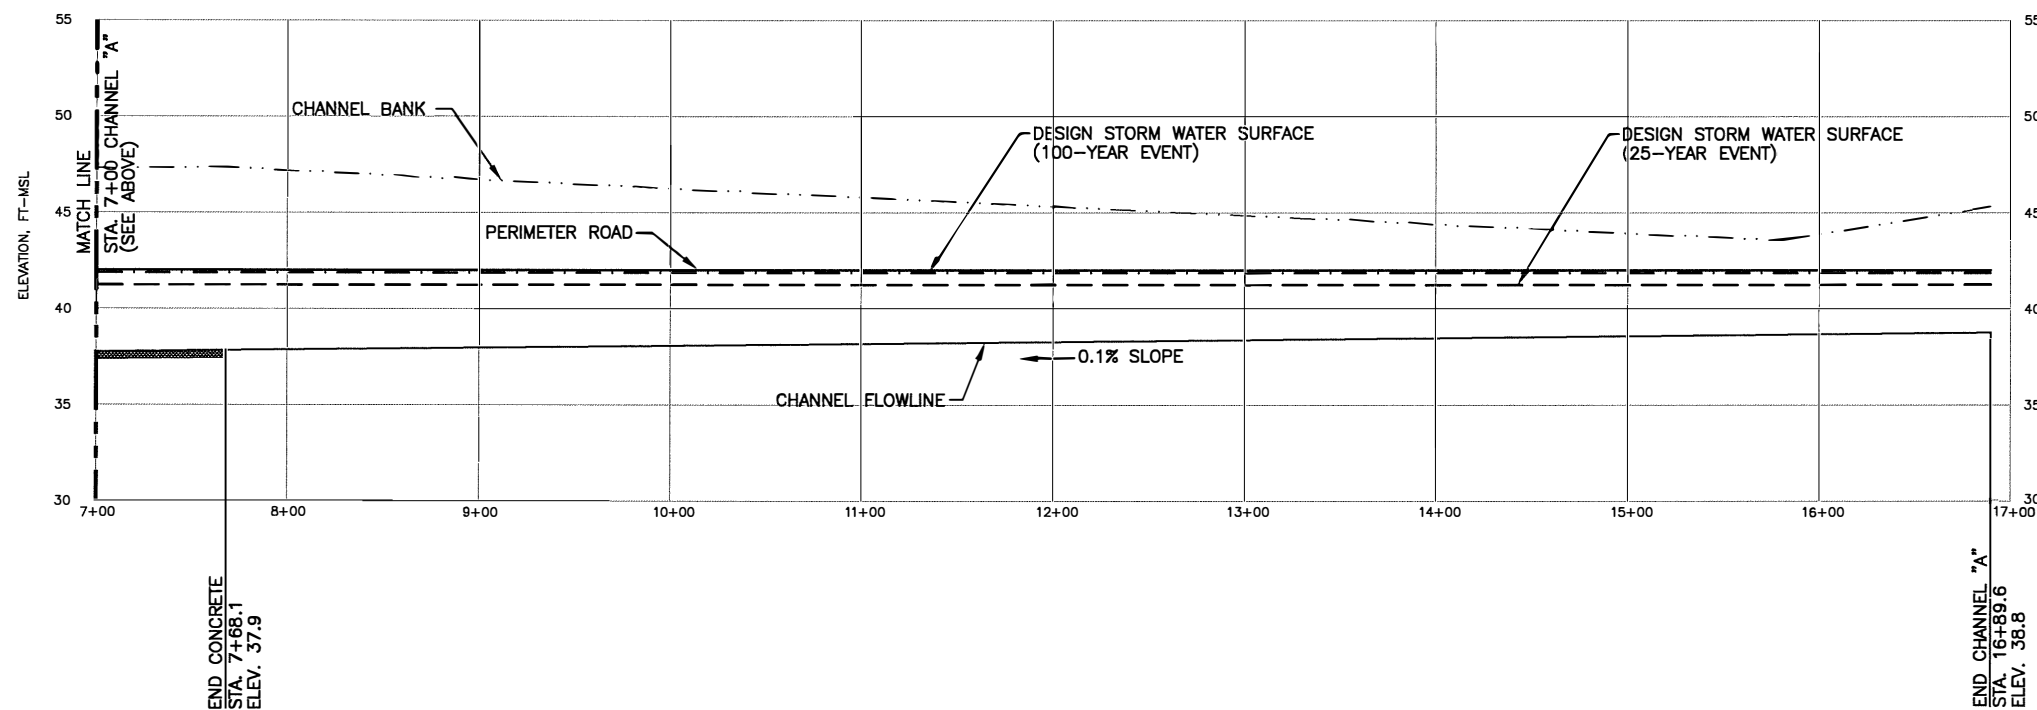


NOTES:

- REFER TO ATTACHMENT 6A.3 FOR PROFILE LOCATIONS.
- CONTOURS AND ELEVATIONS DEVELOPED BY BASE MAPPING FROM AERIAL PHOTOGRAPHY FLOWN FEBRUARY 18, 2003. THE GRID SYSTEM IS TIED TO THE TEXAS STATE PLANE COORDINATE SYSTEM SOUTH CENTRAL ZONE NAD 1927.
- HYDRAULIC CALCULATIONS INCLUDED IN ATTACHMENT 6A-B.

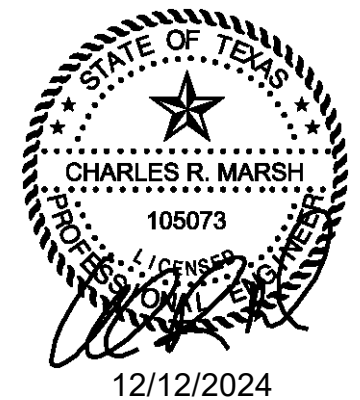


<input type="checkbox"/> DRAFT <input checked="" type="checkbox"/> FOR PERMITTING PURPOSES ONLY <input type="checkbox"/> ISSUED FOR CONSTRUCTION	PREPARED FOR <b>MCCARTY ROAD LANDFILL TX, LP</b>	MAJOR PERMIT AMENDMENT PERIMETER CHANNEL "A" PROFILE	
DATE: 03/2004 FILE: 0120-439-11 CAD: 6A.04-PROA.DWG	DRAWN BY: JOW DESIGN BY: SAN REVIEWED BY: JPY	McCARTY ROAD LANDFILL HARRIS COUNTY, TEXAS	
<b>Weaver Consultants Group</b> TBPE REGISTRATION NO. F-3727		WWW.WCGRP.COM	
		ATTACHMENT 6A.4	



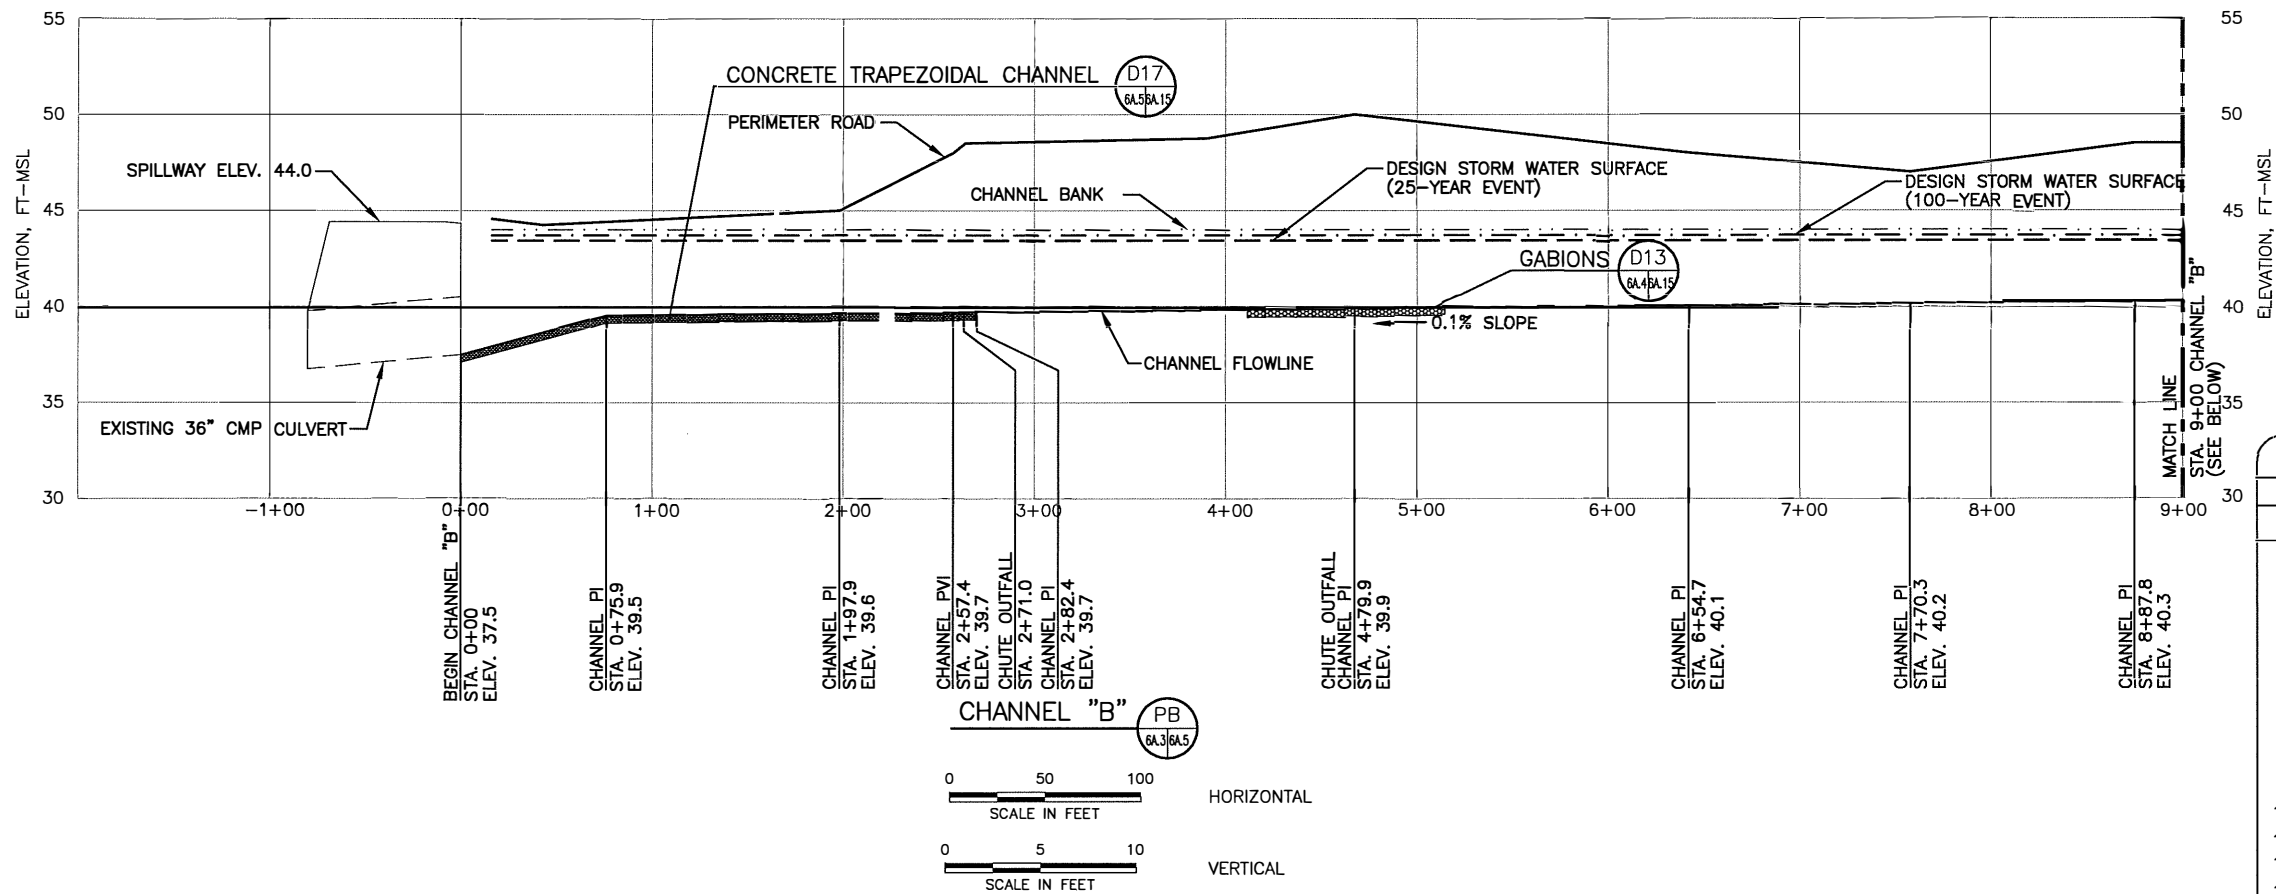

25-YEAR CHANNEL "B" INFORMATION						
CHANNEL STATION		BOTTOM WIDTH (FT)	PEAK INFLOW (CFS)	SLOPE (%)	FLOW DEPTH (FT.)	VELOCITY (FT/S)
FROM	TO					
0+00	0+75.9	25	378	0.1	2.49	5.07
0+75.9	1+97.9	25	378	0.1	2.49	5.07
1+97.9	2+57.4	25	378	0.1	2.49	5.07
2+57.4	2+82.4	25	113	0.1	1.23	3.35
2+82.4	4+79.9	25	113	0.1	2.18	1.76
4+79.9	6+54.7	25	37	0.1	1.13	1.20
6+54.7	7+70.3	25	37	0.1	1.13	1.20
7+70.3	8+87.8	25	37	0.1	1.13	1.20
8+87.8	10+18.2	25	37	0.1	1.13	1.20
10+18.2	11+30.4	25	37	0.1	1.13	1.20
11+30.4	12+90.0	25	37	0.1	1.13	1.20
12+90.0	14+68.0	25	37	0.1	1.13	1.20
14+68.0	15+56.7	25	37	0.1	1.13	1.20
15+56.7	16+46.5	25	37	0.1	1.13	1.20
16+46.5	17+71.6	25	37	0.1	1.13	1.20

NOTE: NORMAL DEPTH CALCULATION DOES NOT ACCOUNT FOR BACK WATER WHICH WILL INCREASE FLOW DEPTH (SEE PROFILE) AND DECREASE VELOCITY.

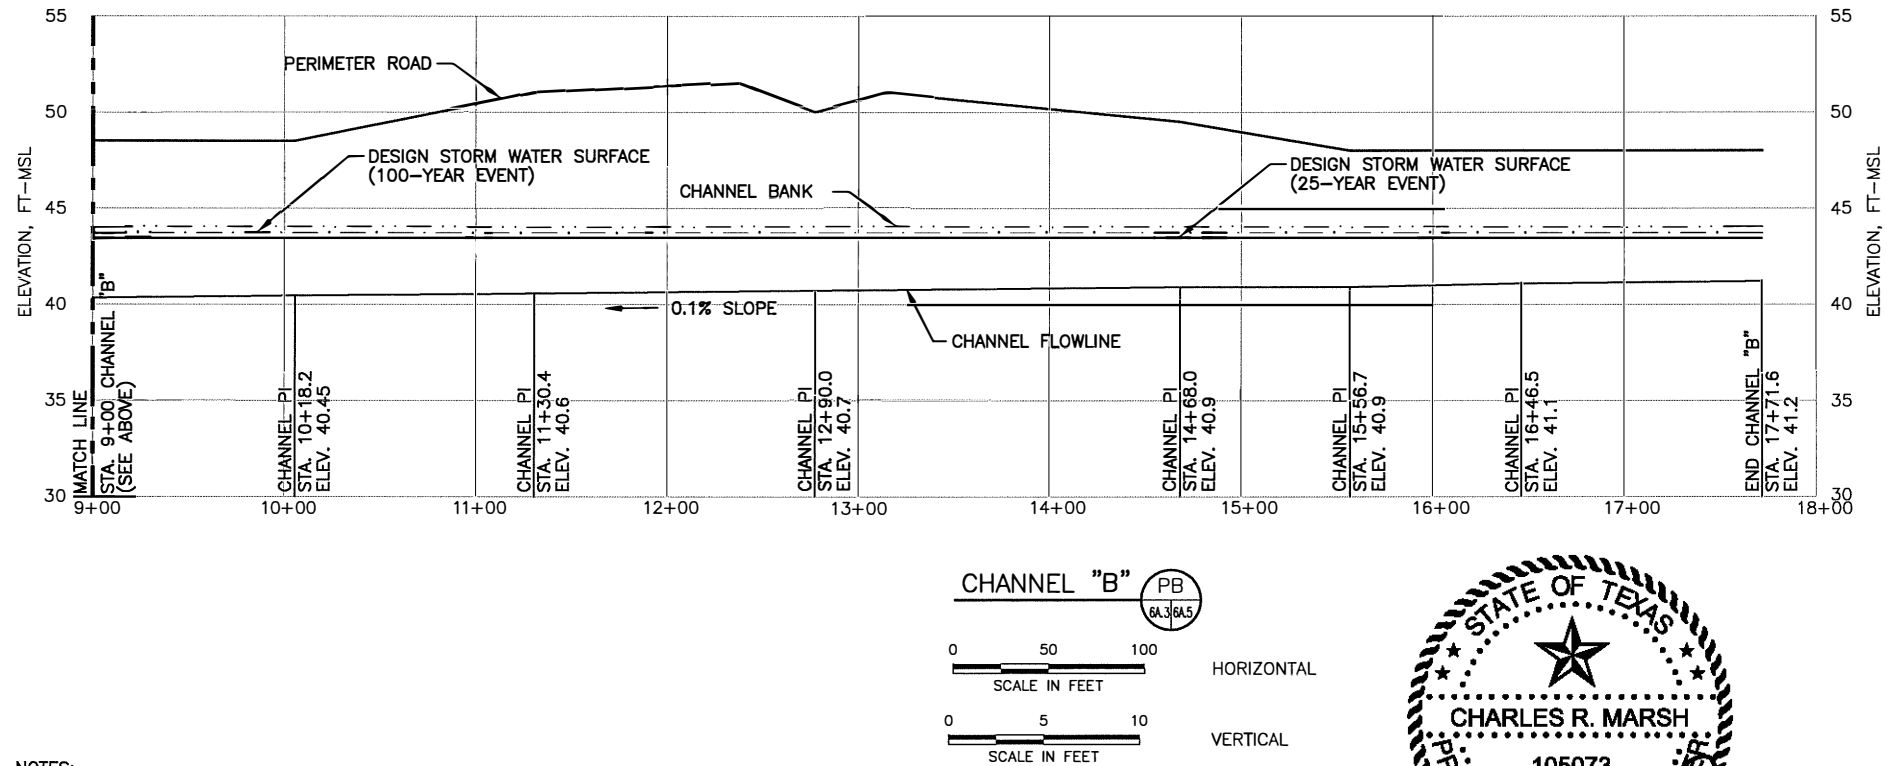

100-YEAR CHANNEL "B" INFORMATION						
CHANNEL STATION		BOTTOM WIDTH (FT)	PEAK INFLOW (CFS)	SLOPE (%)	FLOW DEPTH (FT.)	VELOCITY (FT/S)
FROM	TO					
0+00	0+75.9	25	525	0.1	3.00	5.65
0+75.9	1+97.9	25	525	0.1	3.00	5.65
1+97.9	2+57.4	25	525	0.1	3.00	5.65
2+57.4	2+82.4	25	159	0.1	1.50	3.78
2+82.4	4+79.9	25	159	0.1	2.66	1.98
4+79.9	6+54.7	25	54	0.1	1.42	1.37
6+54.7	7+70.3	25	54	0.1	1.42	1.37
7+70.3	8+87.8	25	54	0.1	1.42	1.37
8+87.8	10+18.2	25	54	0.1	1.42	1.37
10+18.2	11+30.4	25	54	0.1	1.42	1.37
11+30.4	12+90.0	25	54	0.1	1.42	1.37
12+90.0	14+68.0	25	54	0.1	1.42	1.37
14+68.0	15+56.7	25	54	0.1	1.42	1.37
15+56.7	16+46.5	25	54	0.1	1.42	1.37
16+46.5	17+71.6	25	54	0.1	1.42	1.37


NOTE: NORMAL DEPTH CALCULATION DOES NOT ACCOUNT FOR BACK WATER WHICH WILL INCREASE FLOW DEPTH (SEE PROFILE) AND DECREASE VELOCITY.

NOTES:



- REFER TO ATTACHMENT 6A.3 FOR PROFILE LOCATIONS.
- CONTOURS AND ELEVATIONS DEVELOPED BY BASE MAPPING FROM AERIAL PHOTOGRAPHY FLOWN FEBRUARY 18, 2003. THE GRID SYSTEM IS TIED TO THE TEXAS STATE PLANE COORDINATE SYSTEM SOUTH CENTRAL ZONE NAD 1927.
- HYDRAULIC CALCULATIONS INCLUDED IN ATTACHMENT 6A-B.



<input type="checkbox"/> DRAFT <input checked="" type="checkbox"/> FOR PERMITTING PURPOSES ONLY <input type="checkbox"/> ISSUED FOR CONSTRUCTION	PREPARED FOR <b>MCCARTY ROAD LANDFILL TX, LP</b>	MAJOR PERMIT AMENDMENT PERIMETER CHANNEL "B" PROFILE	
DATE: 03/2004 FILE: 0120-439-11 CAD: 6A.05-PROB.DWG	DRAWN BY: JOW DESIGN BY: SAN REVIEWED BY: JPY	McCARTY ROAD LANDFILL HARRIS COUNTY, TEXAS	
Weaver Consultants Group TBPE REGISTRATION NO. F-3727		WWW.WCGRP.COM	
REVISIONS		ATTACHMENT 6A.5	
NO. DATE DESCRIPTION			
1 01/2012 PERMIT MODIFICATION			
2 12/2024 PERMIT MODIFICATION			

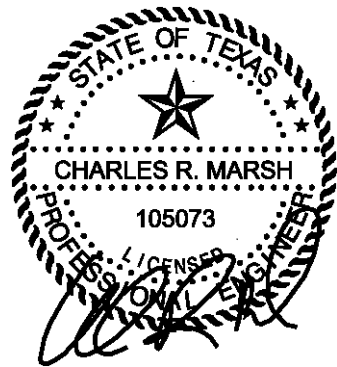

12/12/2024

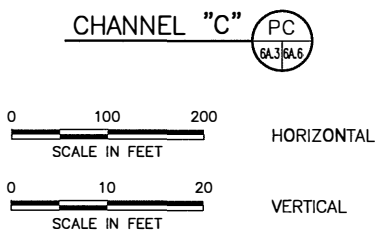
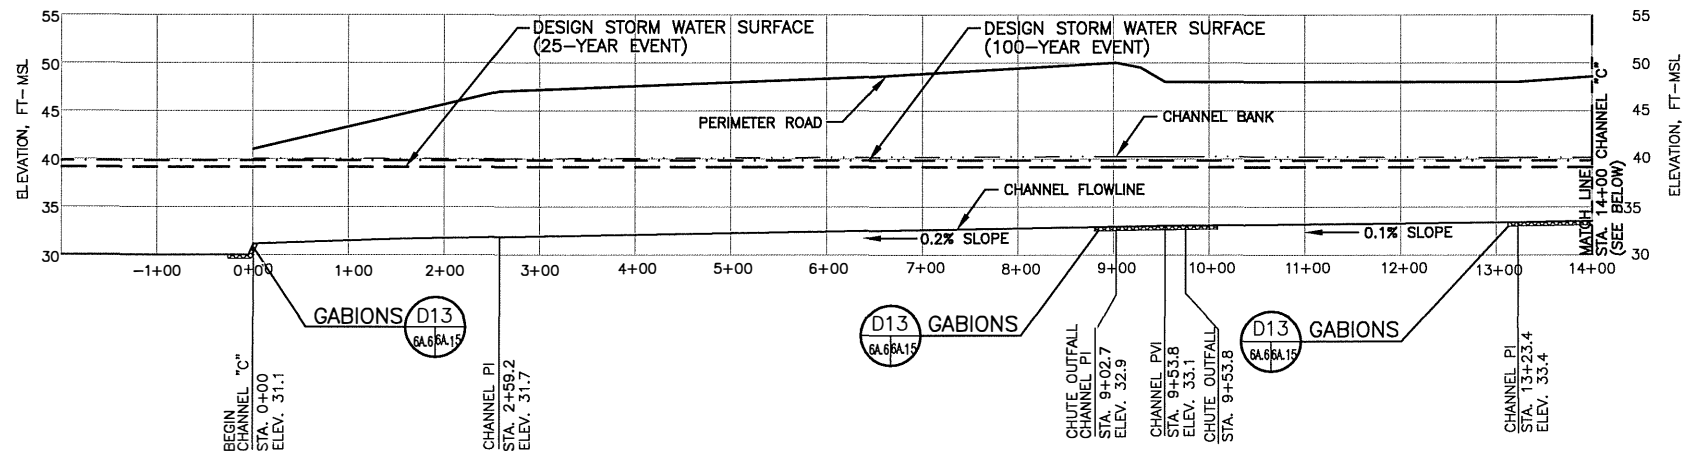


25-YEAR CHANNEL "C" INFORMATION						
CHANNEL FROM	STATION TO	BOTTOM WIDTH (FT)	PEAK INFLOW (CFS)	SLOPE (%)	FLOW DEPTH (FT.)	VELOCITY (FT/S)
0+00	2+59.2	25	1090	0.2	6.38	4.53
2+59.2	9+02.7	25	1090	0.2	6.38	4.53
9+02.7	9+53.8	25	1090	0.2	6.38	4.53
9+53.8	13+23.4	25	654	0.1	5.84	3.05
13+23.4	15+88.8	15	654	0.1	4.29	6.46
15+88.8	18+16.4	15	654	0.1	4.29	6.46
18+16.4	19+38.4	15	654	0.1	4.29	6.46
19+38.4	20+20.0	15	654	0.1	4.29	6.46
20+20.0	20+92.2	15	375	0.1	5.35	2.72
20+92.2	21+86.1	15	375	0.1	5.35	2.72
21+86.1	33+48.8	15	375	0.1	5.35	2.72
33+48.8	39+47.8	15	29	0.1	1.31	1.26

NOTE: NORMAL DEPTH CALCULATION DOES NOT ACCOUNT FOR BACK WATER WHICH WILL INCREASE FLOW DEPTH (SEE PROFILE) AND DECREASE VELOCITY.

100-YEAR CHANNEL "C" INFORMATION						
CHANNEL FROM	STATION TO	BOTTOM WIDTH (FT)	PEAK INFLOW (CFS)	SLOPE (%)	FLOW DEPTH (FT.)	VELOCITY (FT/S)
0+00	2+59.2	25	1551	0.2	7.68	5.00
2+59.2	9+02.7	25	1551	0.2	7.68	5.00
9+02.7	9+53.8	25	1551	0.2	7.68	5.00
9+53.8	13+23.4	25	949	0.1	7.12	3.40
13+23.4	15+88.8	15	949	0.1	5.21	7.16
15+88.8	18+16.4	15	949	0.1	5.21	7.16
18+16.4	19+38.4	15	949	0.1	5.21	7.16
19+38.4	20+20.0	15	949	0.1	5.21	7.16
20+20.0	20+92.2	15	531	0.1	6.38	2.99
20+92.2	21+86.1	15	531	0.1	6.38	2.99
21+86.1	33+48.8	15	531	0.1	6.38	2.99
33+48.8	39+47.4	15	36	0.1	1.91	1.56

NOTE: NORMAL DEPTH CALCULATION DOES NOT ACCOUNT FOR BACK WATER WHICH WILL INCREASE FLOW DEPTH (SEE PROFILE) AND DECREASE VELOCITY.

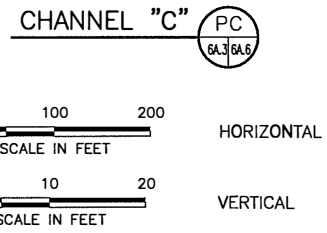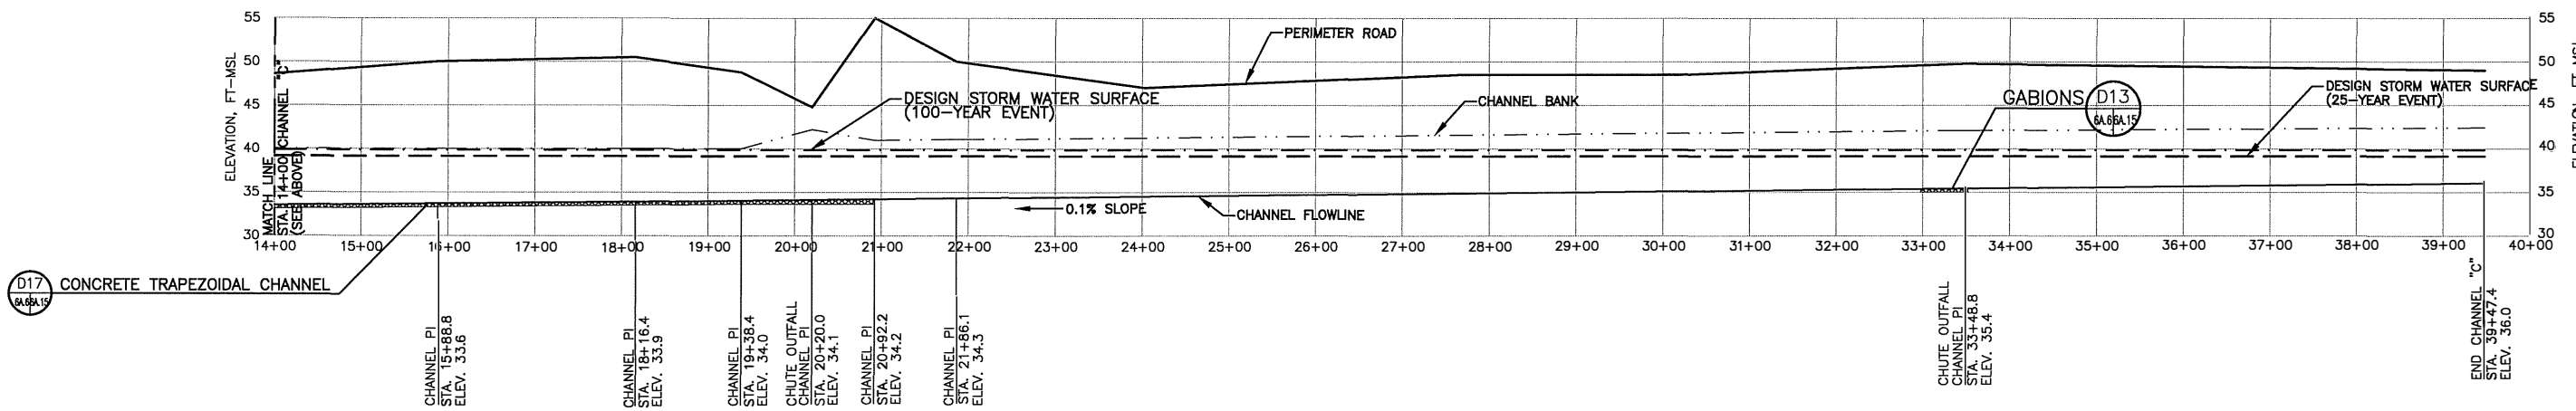



- NOTES:
- REFER TO ATTACHMENT 6A.3 FOR PROFILE LOCATIONS.
  - CONTOURS AND ELEVATIONS DEVELOPED BY BASE MAPPING FROM AERIAL PHOTOGRAPHY FLOWN FEBRUARY 18, 2003. THE GRID SYSTEM IS TIED TO THE TEXAS STATE PLANE COORDINATE SYSTEM SOUTH CENTRAL ZONE NAD 1927.
  - HYDRAULIC CALCULATIONS INCLUDED IN ATTACHMENT 6A-B.

<input type="checkbox"/> DRAFT <input checked="" type="checkbox"/> FOR PERMITTING PURPOSES ONLY <input type="checkbox"/> ISSUED FOR CONSTRUCTION	PREPARED FOR <b>MCCARTY ROAD LANDFILL TX, LP</b>	<b>MAJOR PERMIT AMENDMENT PERIMETER CHANNEL "C" PROFILE</b>  McCARTY ROAD LANDFILL HARRIS COUNTY, TEXAS  WWW.WCGRP.COM								
DATE: 03/2004 FILE: 0120-439-11 CAD: 6A.06-PROC.DWG	DRAWN BY: JOW DESIGN BY: SAN REVIEWED BY: JFY		REVISIONS							
<table><tr><th>NO.</th><th>DATE</th><th>DESCRIPTION</th></tr><tr><td>1</td><td>01/2012</td><td>PERMIT MODIFICATION</td></tr><tr><td>2</td><td>12/2024</td><td>PERMIT MODIFICATION</td></tr></table>			NO.	DATE	DESCRIPTION	1	01/2012	PERMIT MODIFICATION	2	12/2024
NO.	DATE	DESCRIPTION								
1	01/2012	PERMIT MODIFICATION								
2	12/2024	PERMIT MODIFICATION								

**Weaver Consultants Group**  
TBPE REGISTRATION NO. F-3727





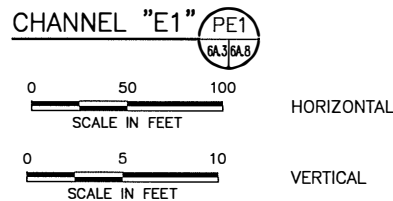
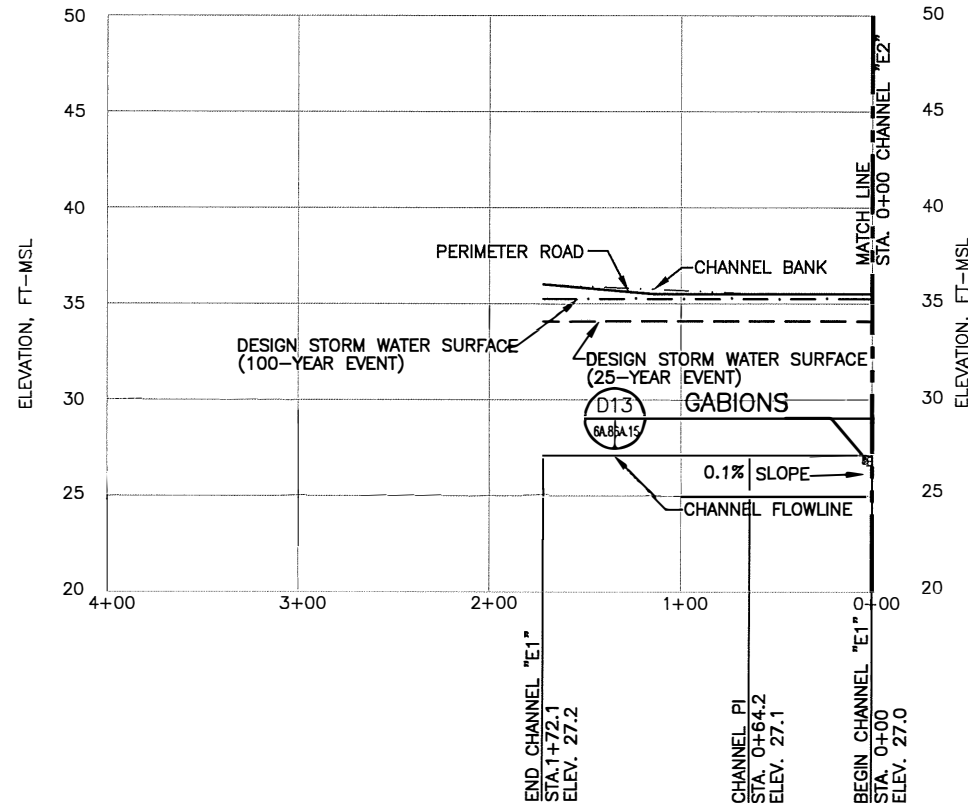


25-YEAR CHANNEL "E1" INFORMATION						
CHANNEL STATION		BOTTOM WIDTH (FT)	PEAK INFLOW (CFS)	SLOPE (%)	FLOW DEPTH (FT.)	VELOCITY (FT/S)
FROM	TO					
0+00	0+64.2	25	26	0.1	0.91	1.03
0+64.2	1+72.1	30	26	0.1	0.82	0.98

NOTE: NORMAL DEPTH CALCULATION DOES NOT ACCOUNT FOR BACK WATER WHICH WILL INCREASE FLOW DEPTH (SEE PROFILE) AND DECREASE VELOCITY.

100-YEAR CHANNEL "E1" INFORMATION						
CHANNEL STATION		BOTTOM WIDTH (FT)	PEAK INFLOW (CFS)	SLOPE (%)	FLOW DEPTH (FT.)	VELOCITY (FT/S)
FROM	TO					
0+00	0+64.2	25	37	0.1	1.12	1.17
0+64.2	1+72.1	30	37	0.1	1.01	1.11

NOTE: NORMAL DEPTH CALCULATION DOES NOT ACCOUNT FOR BACK WATER WHICH WILL INCREASE FLOW DEPTH (SEE PROFILE) AND DECREASE VELOCITY.

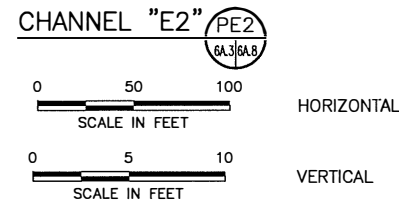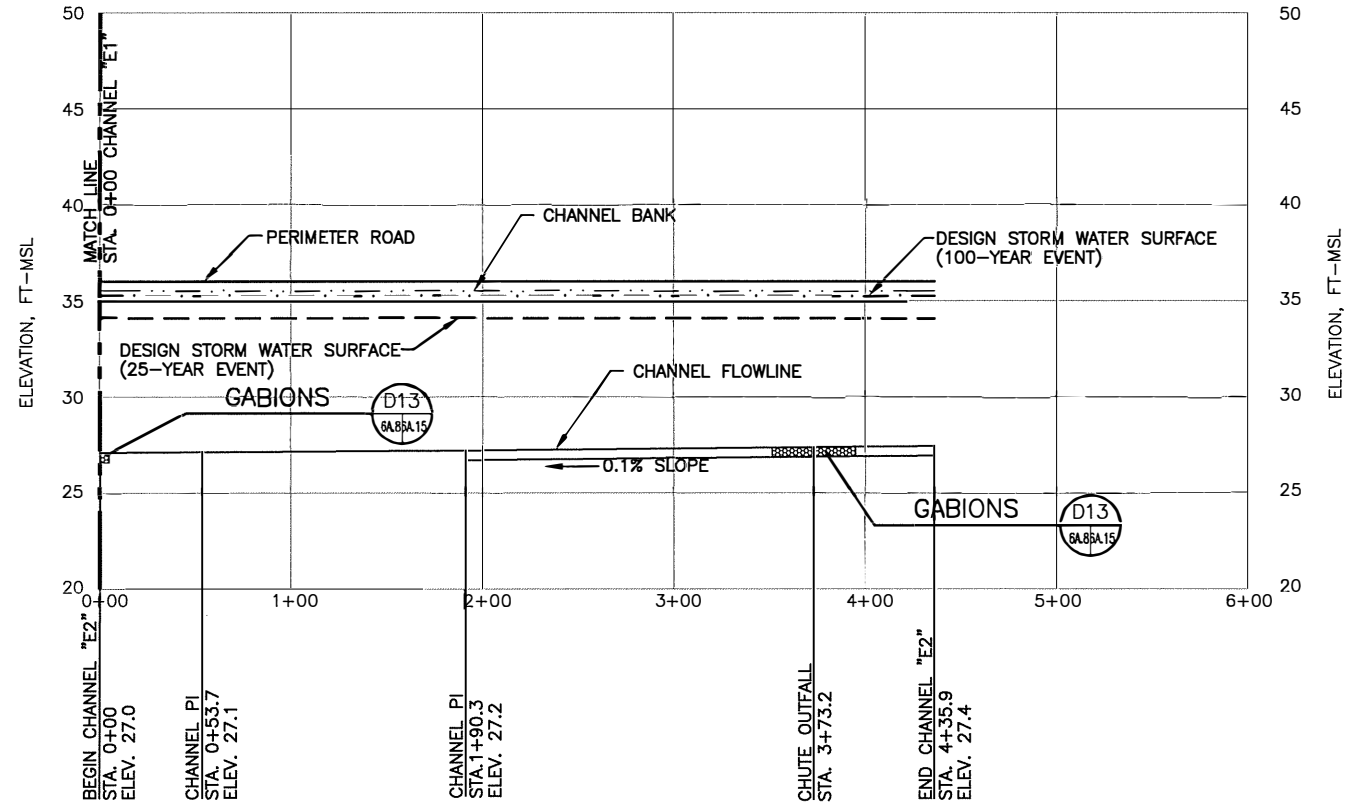

25-YEAR CHANNEL "E2" INFORMATION						
CHANNEL STATION		BOTTOM WIDTH (FT)	PEAK INFLOW (CFS)	SLOPE (%)	FLOW DEPTH (FT.)	VELOCITY (FT/S)
FROM	TO					
0+00	0+53.6	25	318	0.1	3.76	2.33
0+53.6	1+90.3	35	318	0.1	3.21	2.22
1+90.3	4+35.9	45	318	0.1	2.82	2.11

NOTE: NORMAL DEPTH CALCULATION DOES NOT ACCOUNT FOR BACK WATER WHICH WILL INCREASE FLOW DEPTH (SEE PROFILE) AND DECREASE VELOCITY.

100-YEAR CHANNEL "E2" INFORMATION						
CHANNEL STATION		BOTTOM WIDTH (FT)	PEAK INFLOW (CFS)	SLOPE (%)	FLOW DEPTH (FT.)	VELOCITY (FT/S)
FROM	TO					
0+00	0+53.6	25	442	0.1	4.48	2.57
0+53.6	1+90.3	35	442	0.1	3.86	2.46
1+90.3	4+35.9	45	442	0.1	3.41	2.35


NOTE: NORMAL DEPTH CALCULATION DOES NOT ACCOUNT FOR BACK WATER WHICH WILL INCREASE FLOW DEPTH (SEE PROFILE) AND DECREASE VELOCITY.




- NOTES:
- REFER TO ATTACHMENT 6A.3 FOR PROFILE LOCATIONS.
  - CONTOURS AND ELEVATIONS DEVELOPED BY BASE MAPPING FROM AERIAL PHOTOGRAPHY FLOWN FEBRUARY 18, 2003. THE GRID SYSTEM IS TIED TO THE TEXAS STATE PLANE COORDINATE SYSTEM SOUTH CENTRAL ZONE NAD 1927.
  - HYDRAULIC CALCULATIONS INCLUDED IN ATTACHMENT 6A-B.

<input type="checkbox"/> DRAFT <input checked="" type="checkbox"/> FOR PERMITTING PURPOSES ONLY <input type="checkbox"/> ISSUED FOR CONSTRUCTION	PREPARED FOR <b>McCARTY ROAD LANDFILL TX, LP</b>	MAJOR PERMIT AMENDMENT PERIMETER CHANNEL "E" PROFILE	
DATE: 03/2004 FILE: 0120-439-11 CAD: 6A.08-PROE.DWG	DRAWN BY: JOW DESIGN BY: SAN REVIEWED BY: JPY	McCARTY ROAD LANDFILL HARRIS COUNTY, TEXAS	
Weaver Consultants Group TBPE REGISTRATION NO. F-3727		NO. 1 DATE 12/2024 DESCRIPTION PERMIT MODIFICATION	WWW.WCGRP.COM ATTACHMENT 6A.8



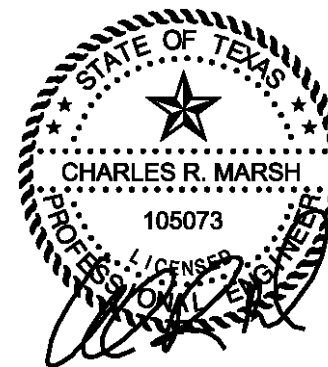


12/12/2024

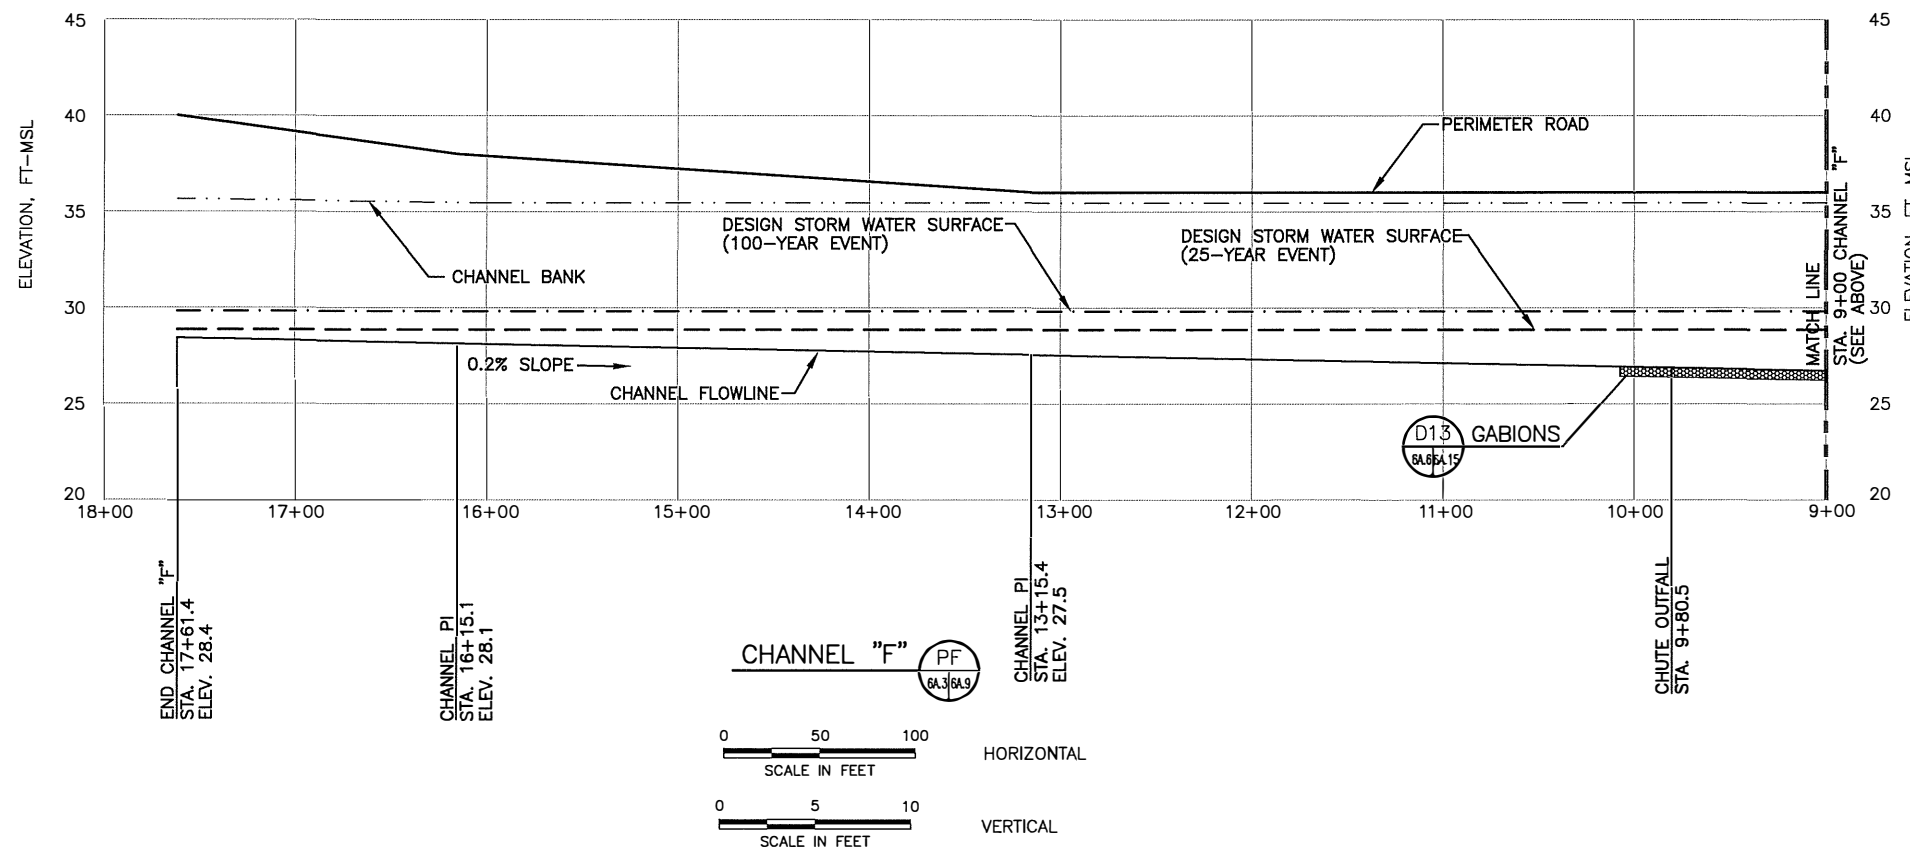

25-YEAR CHANNEL "F" INFORMATION						
CHANNEL STATION		BOTTOM WIDTH (FT)	PEAK INFLOW (CFS)	SLOPE (%)	FLOW DEPTH (FT.)	VELOCITY (FT/S)
FROM	TO					
0+00	1+39.9	35	594	0.2	3.81	3.50
1+39.9	3+65.4	20	221	0.2	2.88	2.82
3+65.4	6+33.8	15	221	0.2	3.27	2.91
6+33.8	13+15.4	15	35	0.2	1.18	1.65
13+15.4	16+15.1	12	35	0.2	1.32	1.73
16+15.1	17+61.4	12	35	0.2	1.32	1.73

NOTE: NORMAL DEPTH CALCULATION DOES NOT ACCOUNT FOR BACK WATER WHICH WILL INCREASE FLOW DEPTH (SEE PROFILE) AND DECREASE VELOCITY.

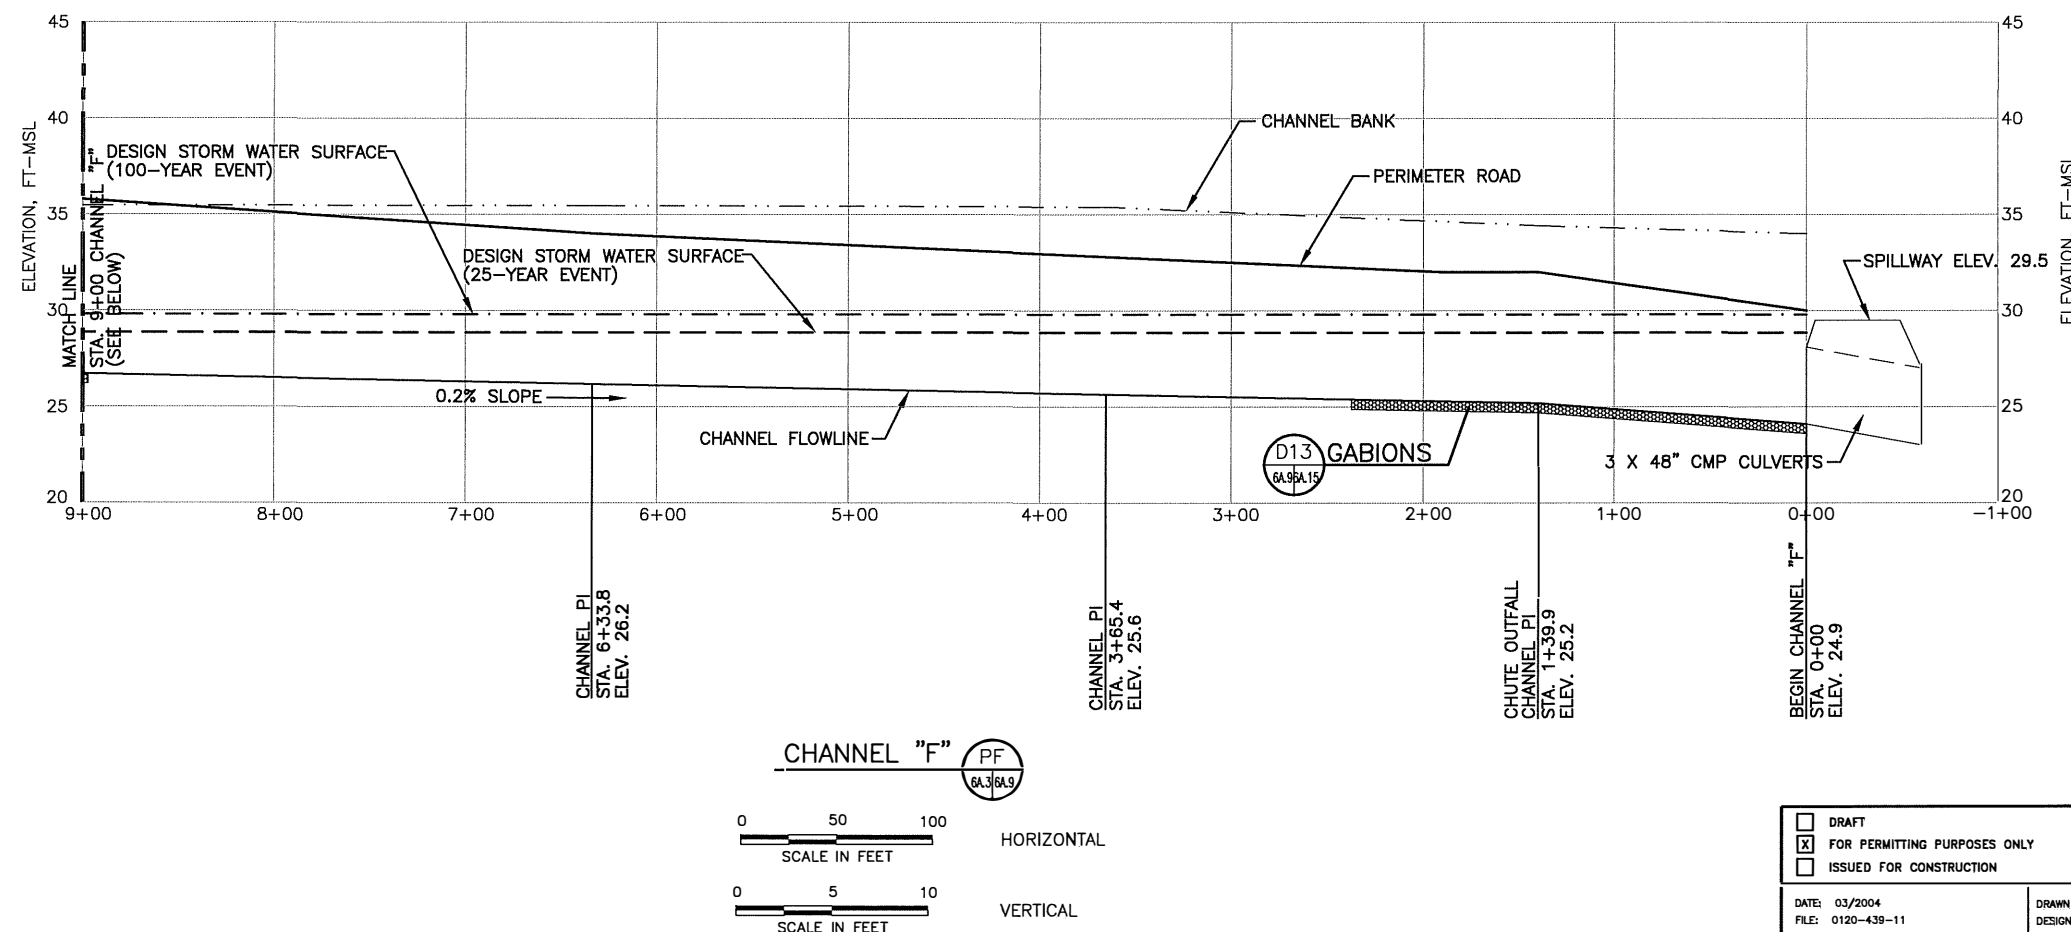

100-YEAR CHANNEL "F" INFORMATION						
CHANNEL STATION		BOTTOM WIDTH (FT)	PEAK INFLOW (CFS)	SLOPE (%)	FLOW DEPTH (FT.)	VELOCITY (FT/S)
FROM	TO					
0+00	1+39.9	35	817	0.2	4.56	3.86
1+39.9	3+65.4	20	817	0.2	5.78	4.11
3+65.4	6+33.8	15	817	0.2	6.35	3.20
6+33.8	13+15.4	15	50	0.2	1.45	1.85
13+15.4	16+15.1	12	50	0.2	1.62	1.93
16+15.1	17+61.4	12	50	0.2	1.62	1.93

NOTE: NORMAL DEPTH CALCULATION DOES NOT ACCOUNT FOR BACK WATER WHICH WILL INCREASE FLOW DEPTH (SEE PROFILE) AND DECREASE VELOCITY.

NOTES:


1. REFER TO ATTACHMENT 6A.3 FOR PROFILE LOCATIONS.
2. CONTOURS AND ELEVATIONS DEVELOPED BY BASE MAPPING FROM AERIAL PHOTOGRAPHY FLOWN FEBRUARY 18, 2003. THE GRID SYSTEM IS TIED TO THE TEXAS STATE PLANE COORDINATE SYSTEM SOUTH CENTRAL ZONE NAD 1927.
3. HYDRAULIC CALCULATIONS INCLUDED IN ATTACHMENT 6A-B.

<input type="checkbox"/> DRAFT <input checked="" type="checkbox"/> FOR PERMITTING PURPOSES ONLY <input type="checkbox"/> ISSUED FOR CONSTRUCTION	PREPARED FOR <b>MCCARTY ROAD LANDFILL TX, LP</b>	MAJOR PERMIT AMENDMENT PERIMETER CHANNEL "F" PROFILE	
DATE: 03/2004 FILE: 0120-439-11 CAD: 6A.09-PROF.DWG	DRAWN BY: JDW DESIGN BY: SAN REVIEWED BY: JPY	McCARTY ROAD LANDFILL HARRIS COUNTY, TEXAS	
Weaver Consultants Group TBPE REGISTRATION NO. F-3727		WWW.WCGRP.COM	
		ATTACHMENT 6A.9	






O:\0120\439\PLP MOD 2024\ATT 6\6A\CLEAN\6A.11-PROH.dwg, vguzman, 1:200

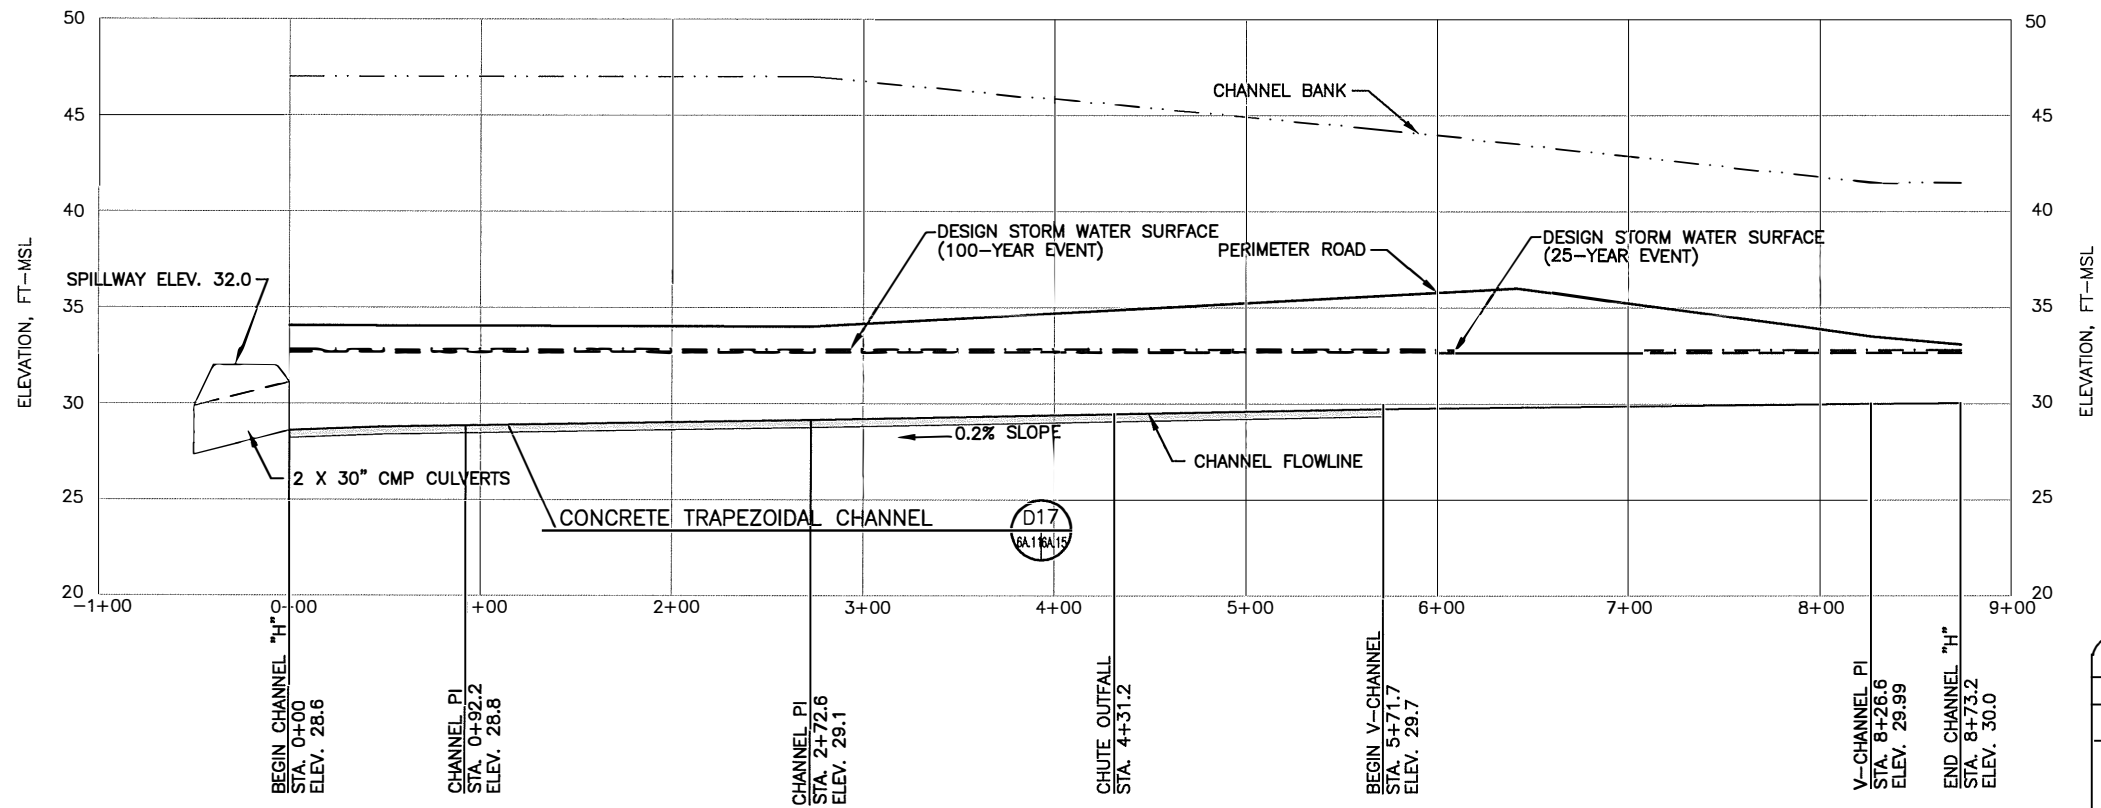

CHANNEL "H" PH  
6A.3A.1V

0 50 100  
SCALE IN FEET  
HORIZONTAL

0 5 10  
SCALE IN FEET  
VERTICAL

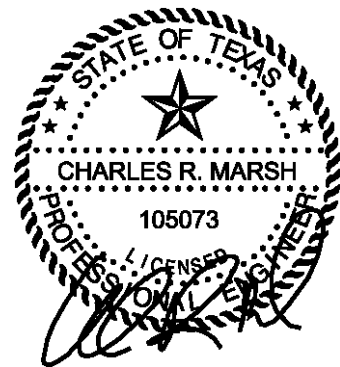

12/12/2024

#### 25-YEAR CHANNEL "H" INFORMATION

CHANNEL STATION		BOTTOM WIDTH (FT)	PEAK INFLOW (CFS)	SLOPE (%)	FLOW DEPTH (FT.)	VELOCITY (FT/S)
FROM	TO					
0+00	0+48.6	12	270	0.2	2.31	6.17
0+48.6	2+72.9	12	270	0.2	2.31	6.17
2+72.9	5+71.7	12	270	0.2	2.31	6.17
5+71.7	8+26.6	0	25	0.2	2.21	1.71
8+26.6	8+73.2	0	25	0.2	2.21	1.71

NOTE: NORMAL DEPTH CALCULATION DOES NOT ACCOUNT FOR BACK WATER WHICH WILL INCREASE FLOW DEPTH (SEE PROFILE) AND DECREASE VELOCITY.

#### 100-YEAR CHANNEL "H" INFORMATION





CHANNEL STATION		BOTTOM WIDTH (FT)	PEAK INFLOW (CFS)	SLOPE (%)	FLOW DEPTH (FT.)	VELOCITY (FT/S)
FROM	TO					
0+00	0+48.6	12	374	0.2	2.74	6.76
0+48.6	2+72.6	12	374	0.2	2.74	6.76
2+72.6	5+71.7	12	374	0.2	2.74	6.76
5+71.7	8+26.6	0	35	0.2	2.50	1.86
8+26.6	8+73.2	0	35	0.2	2.50	1.86

NOTE: NORMAL DEPTH CALCULATION DOES NOT ACCOUNT FOR BACK WATER WHICH WILL INCREASE FLOW DEPTH (SEE PROFILE) AND DECREASE VELOCITY.

#### NOTES:

- REFER TO ATTACHMENT 6A.3 FOR PROFILE LOCATIONS.
- CONTOURS AND ELEVATIONS DEVELOPED BY BASE MAPPING FROM AERIAL PHOTOGRAPHY FLOWN FEBRUARY 18, 2003. THE GRID SYSTEM IS TIED TO THE TEXAS STATE PLANE COORDINATE SYSTEM SOUTH CENTRAL ZONE NAD 1927.
- HYDRAULIC CALCULATIONS INCLUDED IN ATTACHMENT 6A-B.

<input type="checkbox"/> DRAFT <input checked="" type="checkbox"/> FOR PERMITTING PURPOSES ONLY <input type="checkbox"/> ISSUED FOR CONSTRUCTION	PREPARED FOR <b>MCCARTY ROAD LANDFILL TX, LP</b>	MAJOR PERMIT AMENDMENT PERIMETER CHANNEL "H" PROFILE	
DATE: 03/2004 FILE: 0120-439-11 CAD: 6A.11-PROH.DWG	DRAWN BY: JOW DESIGN BY: SAN REVIEWED BY: JPY	McCARTY ROAD LANDFILL HARRIS COUNTY, TEXAS	
Weaver Consultants Group TBP REGISTRATION NO. F-3727		REVISIONS NO. DATE DESCRIPTION 1 12/2024 PERMIT MODIFICATION	WWW.WCGRP.COM
			ATTACHMENT 6A.11

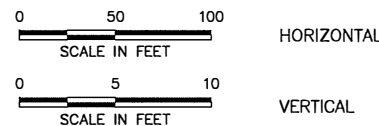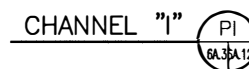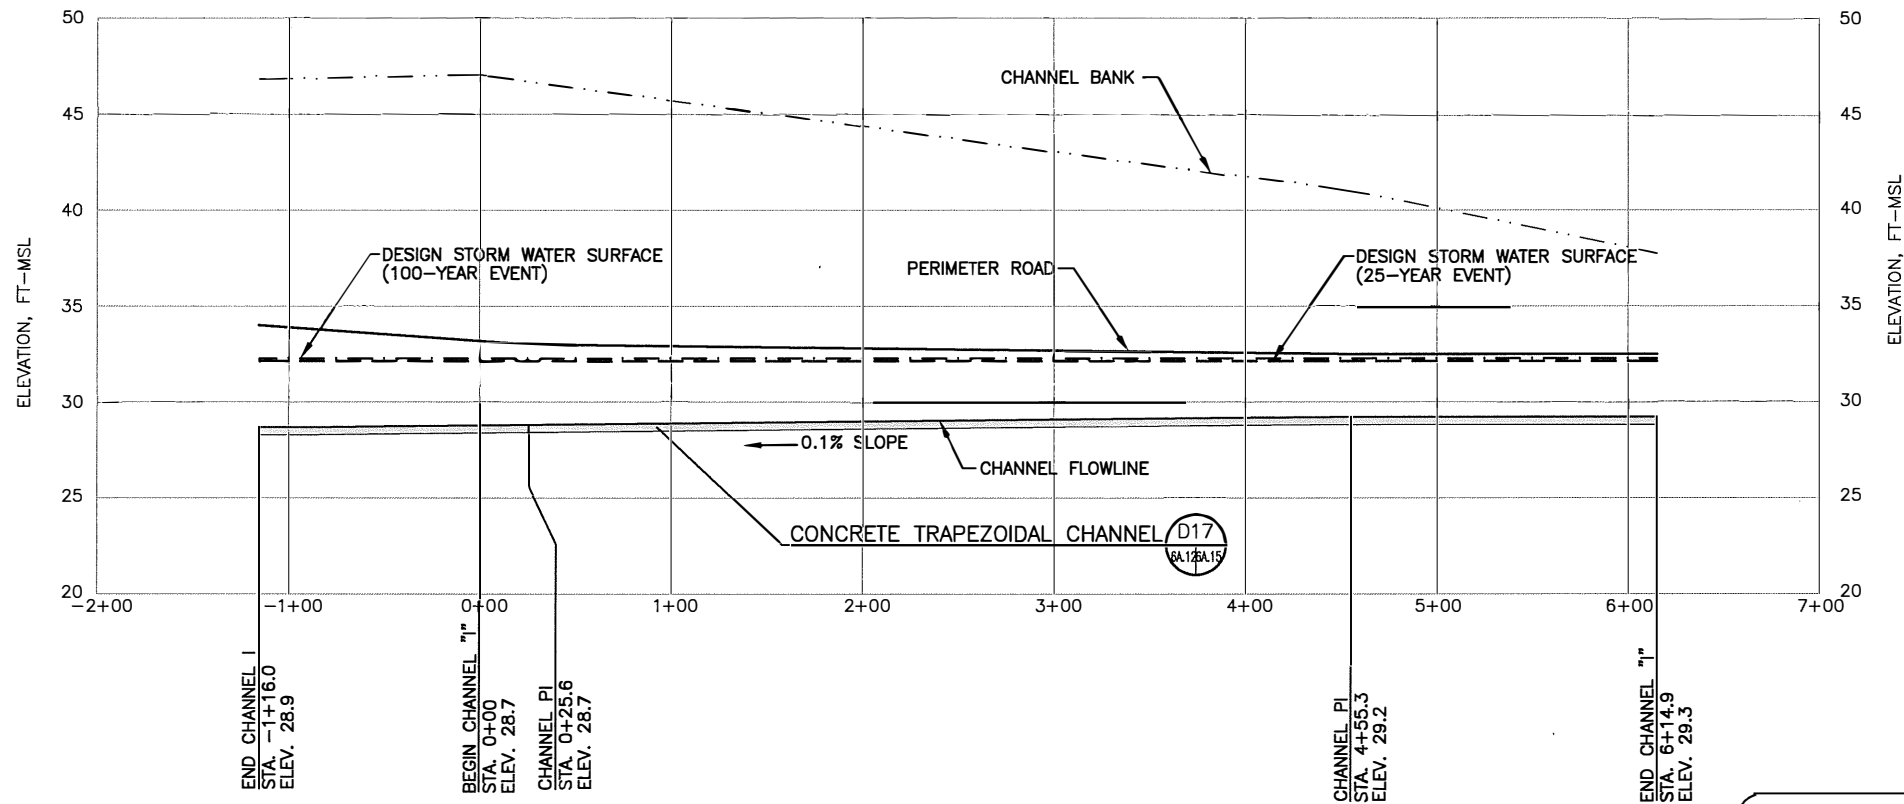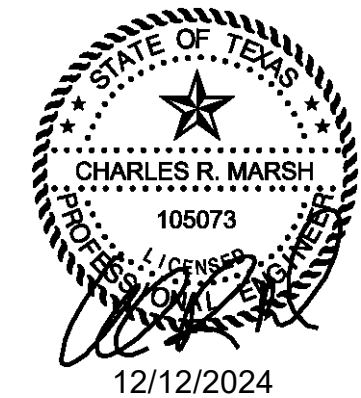

25-YEAR CHANNEL "I" INFORMATION						
CHANNEL STATION		BOTTOM WIDTH (FT)	PEAK INFLOW 25-YEAR (CFS)	SLOPE (%)	FLOW DEPTH (FT.)	VELOCITY (FT/S)
FROM	TO					
-1+16.0	0+00	0	41	0.1	2.09	3.12
0+00	0+25.6	0	41	0.1	2.09	3.12
0+25.6	4+55.3	0	41	0.1	2.09	3.12
4+55.3	6+14.9	0	41	0.1	2.09	3.12

NOTE: NORMAL DEPTH CALCULATION DOES NOT ACCOUNT FOR BACK WATER WHICH WILL INCREASE FLOW DEPTH (SEE PROFILE) AND DECREASE VELOCITY.


100-YEAR CHANNEL "I" INFORMATION						
CHANNEL STATION		BOTTOM WIDTH (FT)	PEAK INFLOW 25-YEAR (CFS)	SLOPE (%)	FLOW DEPTH (FT.)	VELOCITY (FT/S)
FROM	TO					
-1+16.0	0+00	0	50	0.1	2.26	3.28
0+00	0+25.6	0	50	0.1	2.26	3.28
0+25.6	4+55.3	0	50	0.1	2.26	3.28
4+55.3	6+14.9	0	50	0.1	2.26	3.28

NOTE: NORMAL DEPTH CALCULATION DOES NOT ACCOUNT FOR BACK WATER WHICH WILL INCREASE FLOW DEPTH (SEE PROFILE) AND DECREASE VELOCITY.

- NOTES:
- REFER TO ATTACHMENT 6A.3 FOR PROFILE LOCATIONS.
  - CONTOURS AND ELEVATIONS DEVELOPED BY BASE MAPPING FROM AERIAL PHOTOGRAPHY FLOWN FEBRUARY 18, 2003. THE GRID SYSTEM IS TIED TO THE TEXAS STATE PLANE COORDINATE SYSTEM SOUTH CENTRAL ZONE NAD 1927.
  - HYDRAULIC CALCULATIONS INCLUDED IN ATTACHMENT 6A-B.




<input type="checkbox"/> DRAFT <input checked="" type="checkbox"/> FOR PERMITTING PURPOSES ONLY <input type="checkbox"/> ISSUED FOR CONSTRUCTION	PREPARED FOR <b>MCCARTY ROAD LANDFILL TX, LP</b>	MAJOR PERMIT AMENDMENT PERIMETER CHANNEL "I" PROFILE	
DATE: 03/2004 FILE: 0120-439-11 CAD: 6A.12-PROLDWG	DRAWN BY: JDW DESIGN BY: SAN REVIEWED BY: JPY	McCARTY ROAD LANDFILL HARRIS COUNTY, TEXAS	
Weaver Consultants Group TBPE REGISTRATION NO. F-3727		NO. 1 DATE 12/2024 DESCRIPTION PERMIT MODIFICATION	WWW.WCGRP.COM ATTACHMENT 6A.12





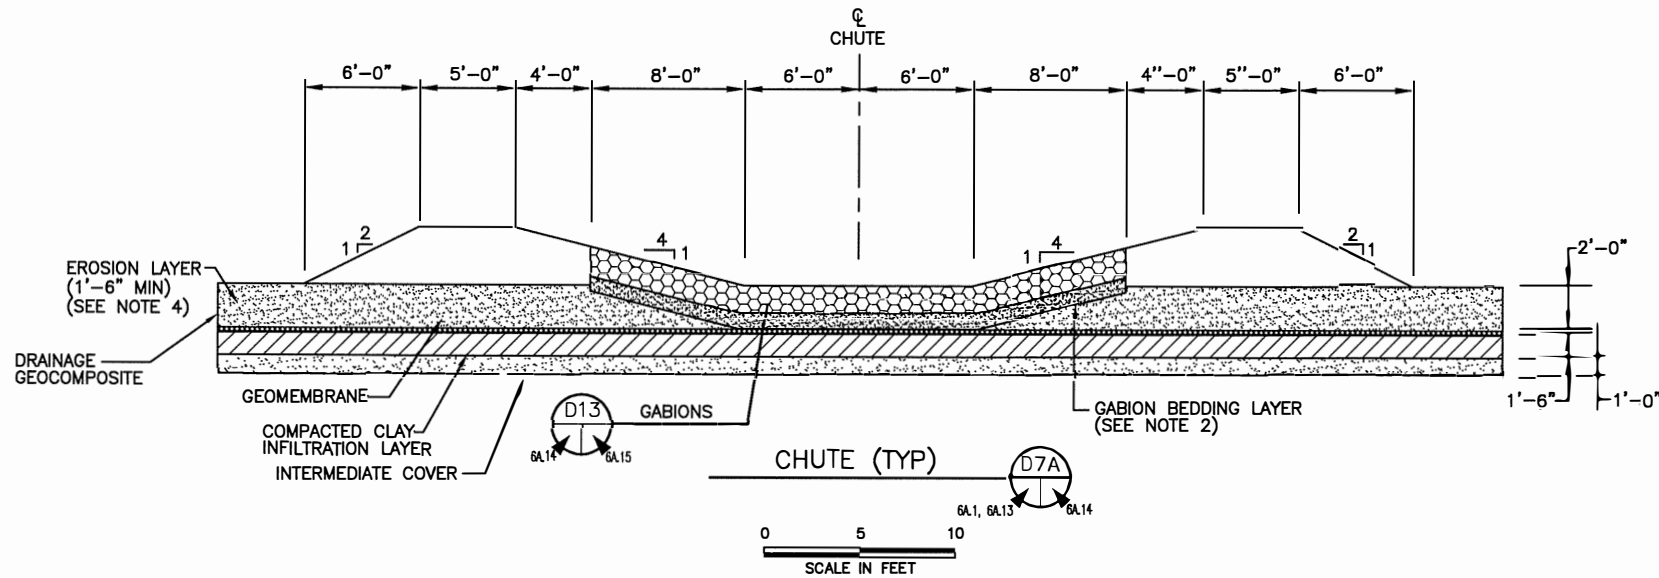


#### NOTES:


1. REFER TO ATTACHMENT 6A.1-DRAINAGE STRUCTURE PLAN FOR LOCATION OF DETAILS.
2. BEDDING MATERIAL WILL CONSIST OF A SW OR SP MATERIAL AS DEFINED BY UNIFIED SOIL CLASSIFICATION SYSTEM. (USCS).
3. BOTTOM WIDTH OF CHUTES WILL VARY PER ENERGY DISSIPATOR CALCULATIONS (SEE APPENDIX 6A-C).
4. TOP 6 INCHES OF EROSION LAYER WILL BE CAPABLE OF SUSTAINING VEGETATIVE GROWTH.
5. DETAILS ARE SHOWN WITH SUBTITLE-D FINAL COVER CONFIGURATION.
6. REFER TO ATTACHMENT 6A.17A THROUGH 6A.17C FOR GEOMEMBRANE LETDOWN DETAILS. REFER TO ATTACHMENT 6A.17D THROUGH 6A.17H FOR FLEXAMAT LETDOWN DETAILS. REFER TO ATTACHMENT 6A.17I THROUGH 6A.17L FOR ARTICULATED BLOCK LETDOWN DETAILS.

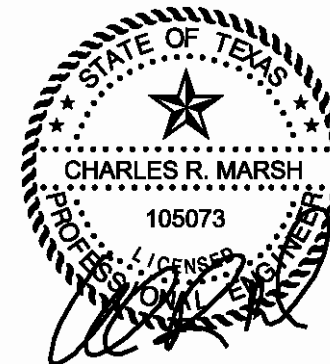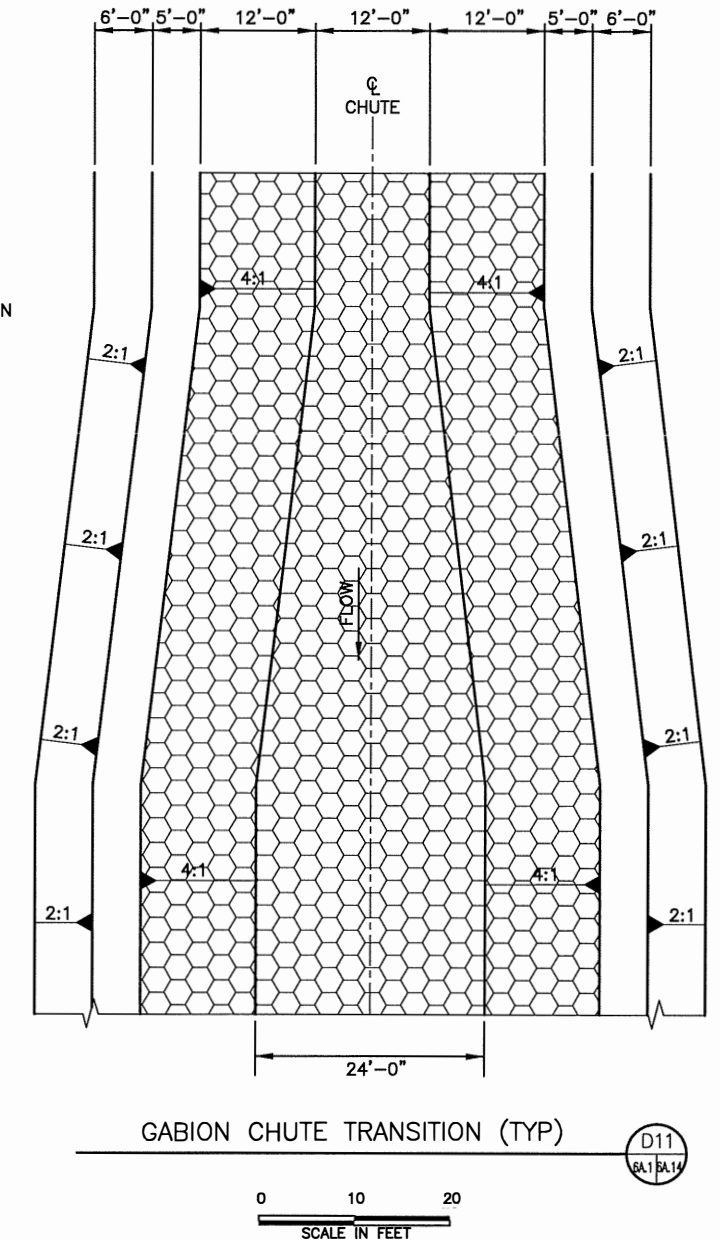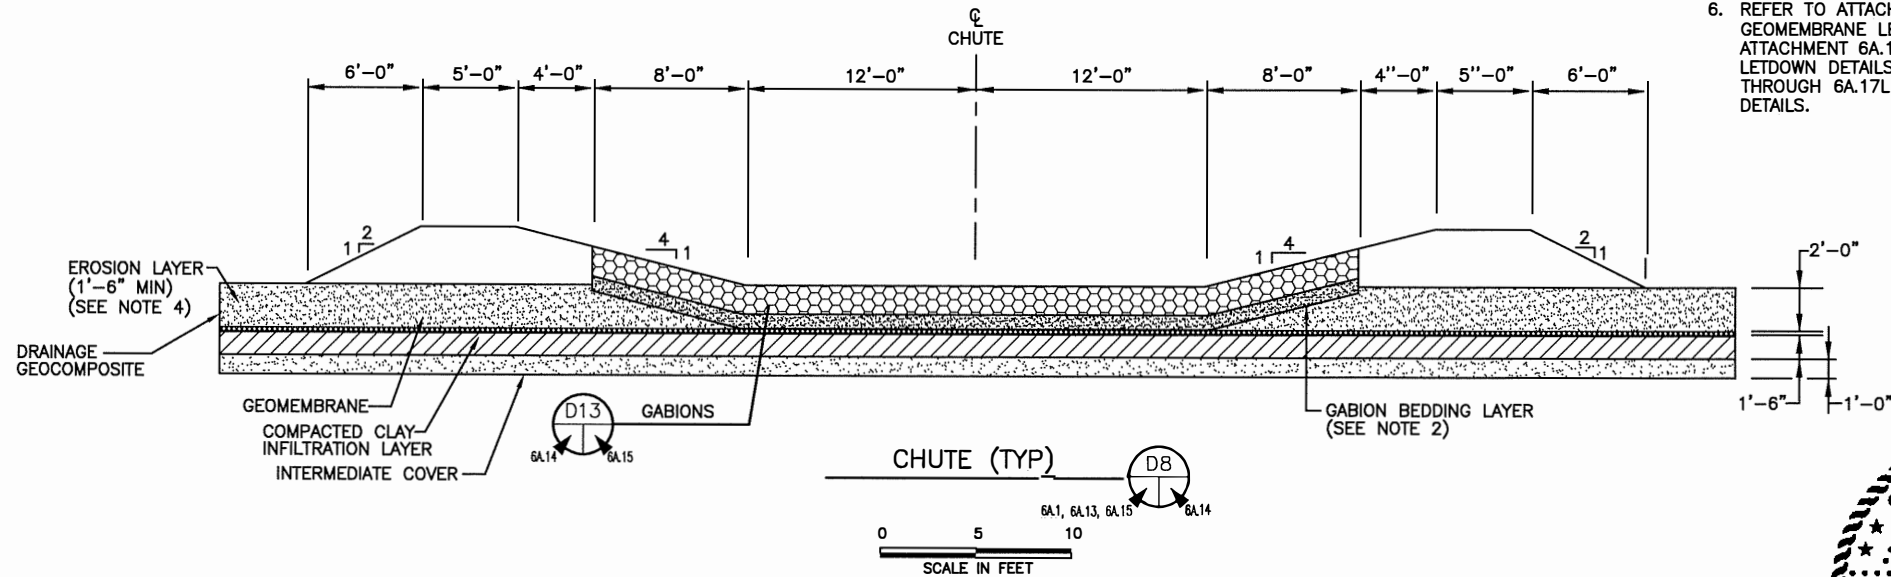


12/12/2024

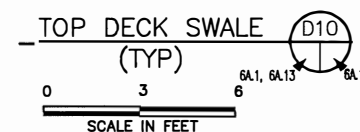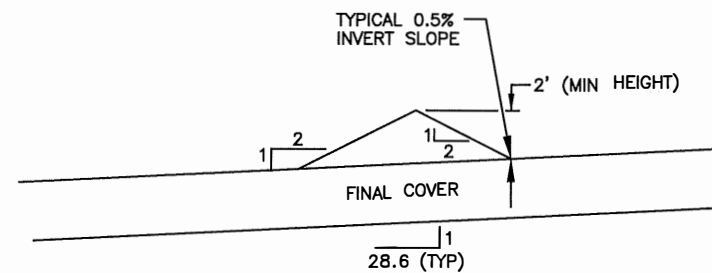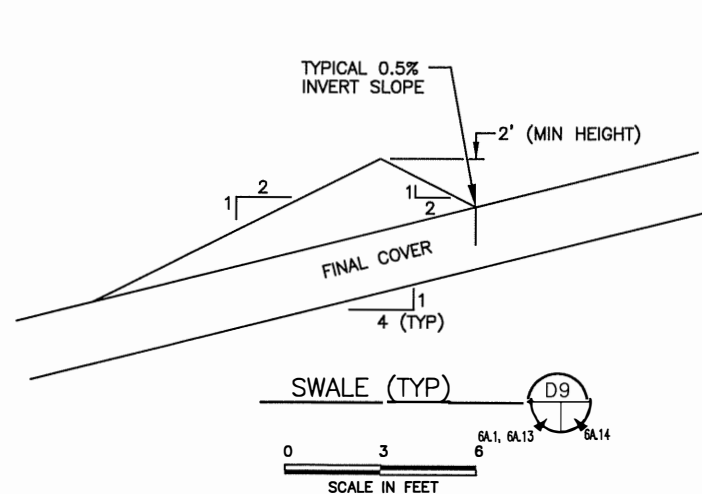



<input type="checkbox"/> DRAFT <input checked="" type="checkbox"/> FOR PERMITTING PURPOSES ONLY <input type="checkbox"/> ISSUED FOR CONSTRUCTION		PREPARED FOR <b>MCCARTY ROAD LANDFILL TX, LP</b>		<b>DRAINAGE DETAILS</b>	
DATE: 03/2004 FILE: 0120-439-11 CAD: 6A-14-DRAINDET1.DWG		DRAWN BY: JOW DESIGN BY: SAN REVIEWED BY: JPY		McCARTY ROAD LANDFILL HARRIS COUNTY, TEXAS	
<b>Weaver Consultants Group</b> TBPE REGISTRATION NO. F-3727		REVISIONS		www.wcgrp.com	
		NO.	DATE	DESCRIPTION	
		1	10/2010	PERMIT MODIFICATION	
		2	01/2012	PERMIT MODIFICATION	
		3	12/2024	PERMIT MODIFICATION	
				ATTACHMENT 6A.14	

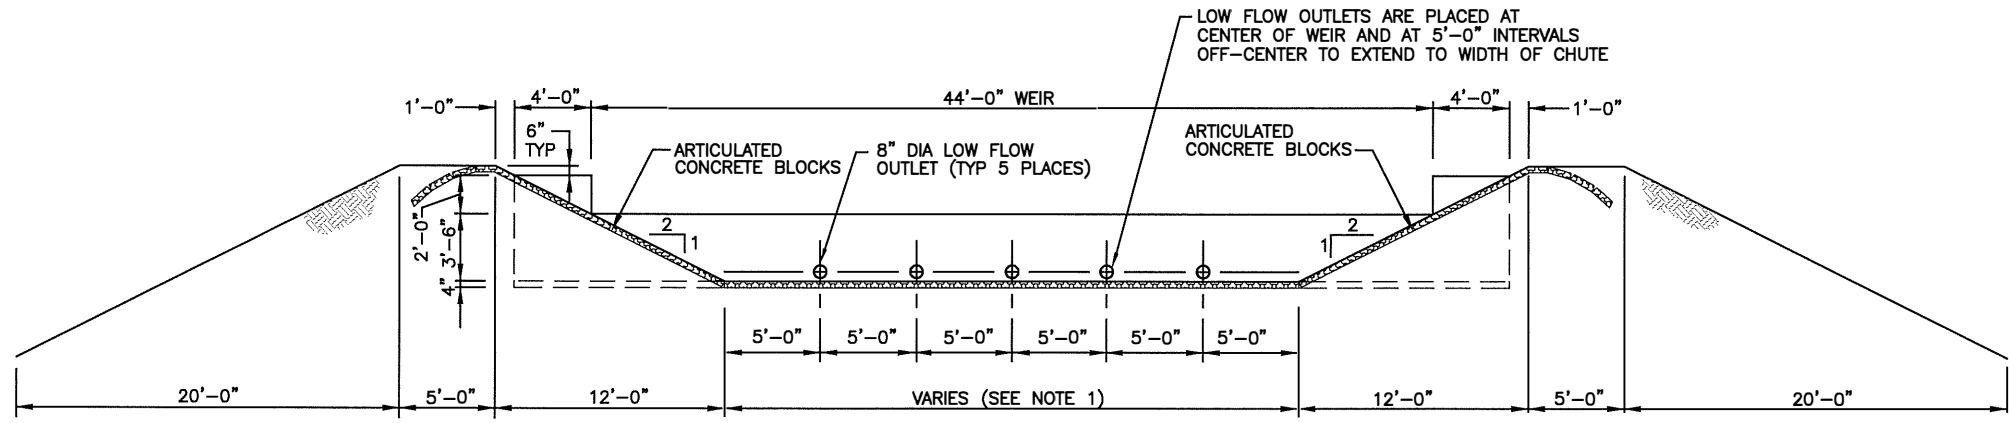


SECTION  
D20D  
SCALE IN FEET

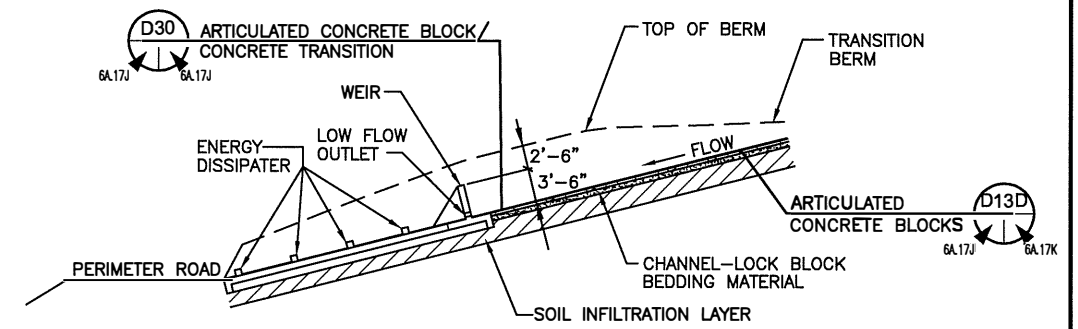

LONGITUDINAL SECTION  
D21D  
SCALE IN FEET

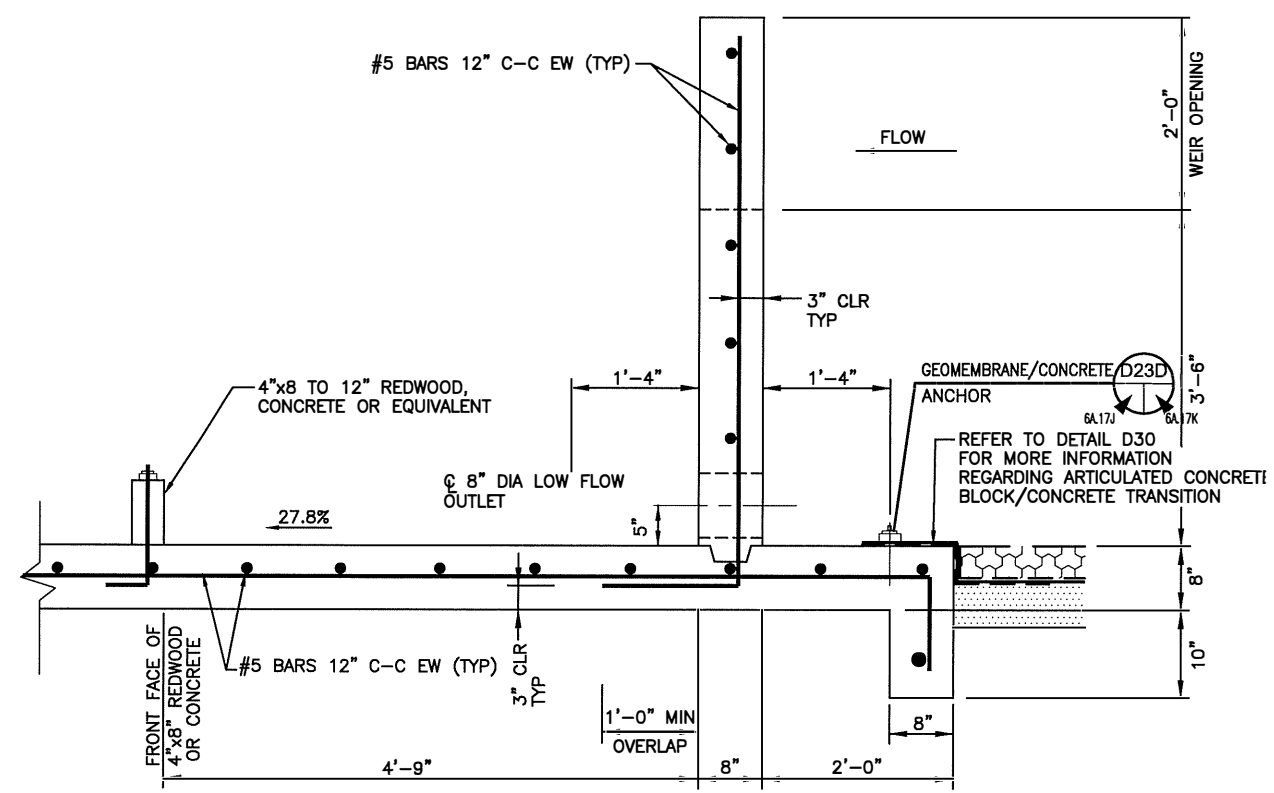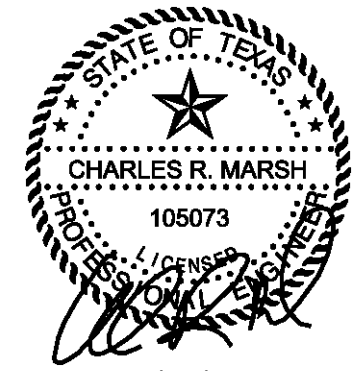

WEIR SECTION  
D24D  
SCALE IN FEET

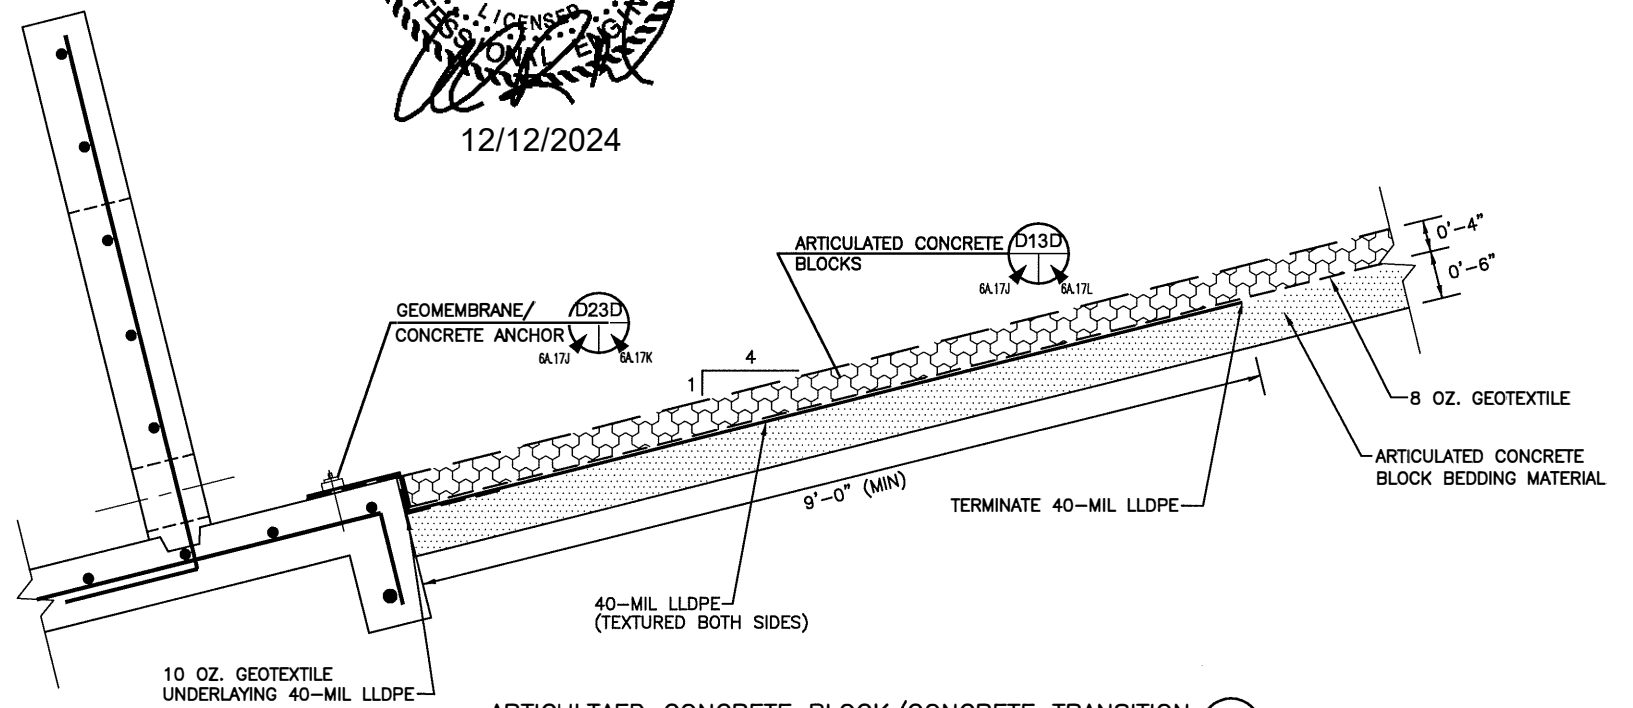

ARTICULTAED CONCRETE BLOCK/CONCRETE TRANSITION  
D30  
SCALE IN FEET

NOTE:  
1. DESIGN DIMENSIONS SHOWN ARE BASED ON CHUTE WITH 30-FOOT BOTTOM WIDTH. DESIGN ELEMENTS FOR EACH CHUTE WILL BE BASED ON CALCULATIONS PRESENTED IN APPENDIX 6A-C AND MAY VARY FROM THE DIMENSIONS SHOWN ON THIS PLAN.



<input type="checkbox"/> DRAFT <input checked="" type="checkbox"/> FOR PERMITTING PURPOSES ONLY <input type="checkbox"/> ISSUED FOR CONSTRUCTION		PREPARED FOR <b>MCCARTY ROAD LANDFILL TX, LP</b>		LETDOWN DETAILS	
DATE: 03/2004 FILE: 0120-439-11 CAD: 6A.17J-LETDOWN DETAILS.DWG		DRAWN BY: JDW DESIGN BY: SAN REVIEWED BY: JPY		McCARTY ROAD LANDFILL HARRIS COUNTY, TEXAS	
<b>Weaver Consultants Group</b> TBPE REGISTRATION NO. F-3727		REVISIONS			
		NO. DATE DESCRIPTION			
		1 01/2012 PERMIT MODIFICATION			
		2 12/2024 PERMIT MODIFICATION			
		WWW.WCGRP.COM ATTACHMENT 6A.17J			

O:\0120\439\FLIP MOD 2024\ATT 6\6A\CLEAN\6A.17J-LETDOWN DETAILS.dwg, vguzman, 1,2







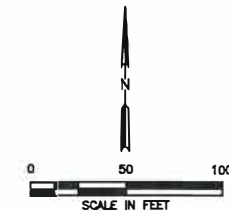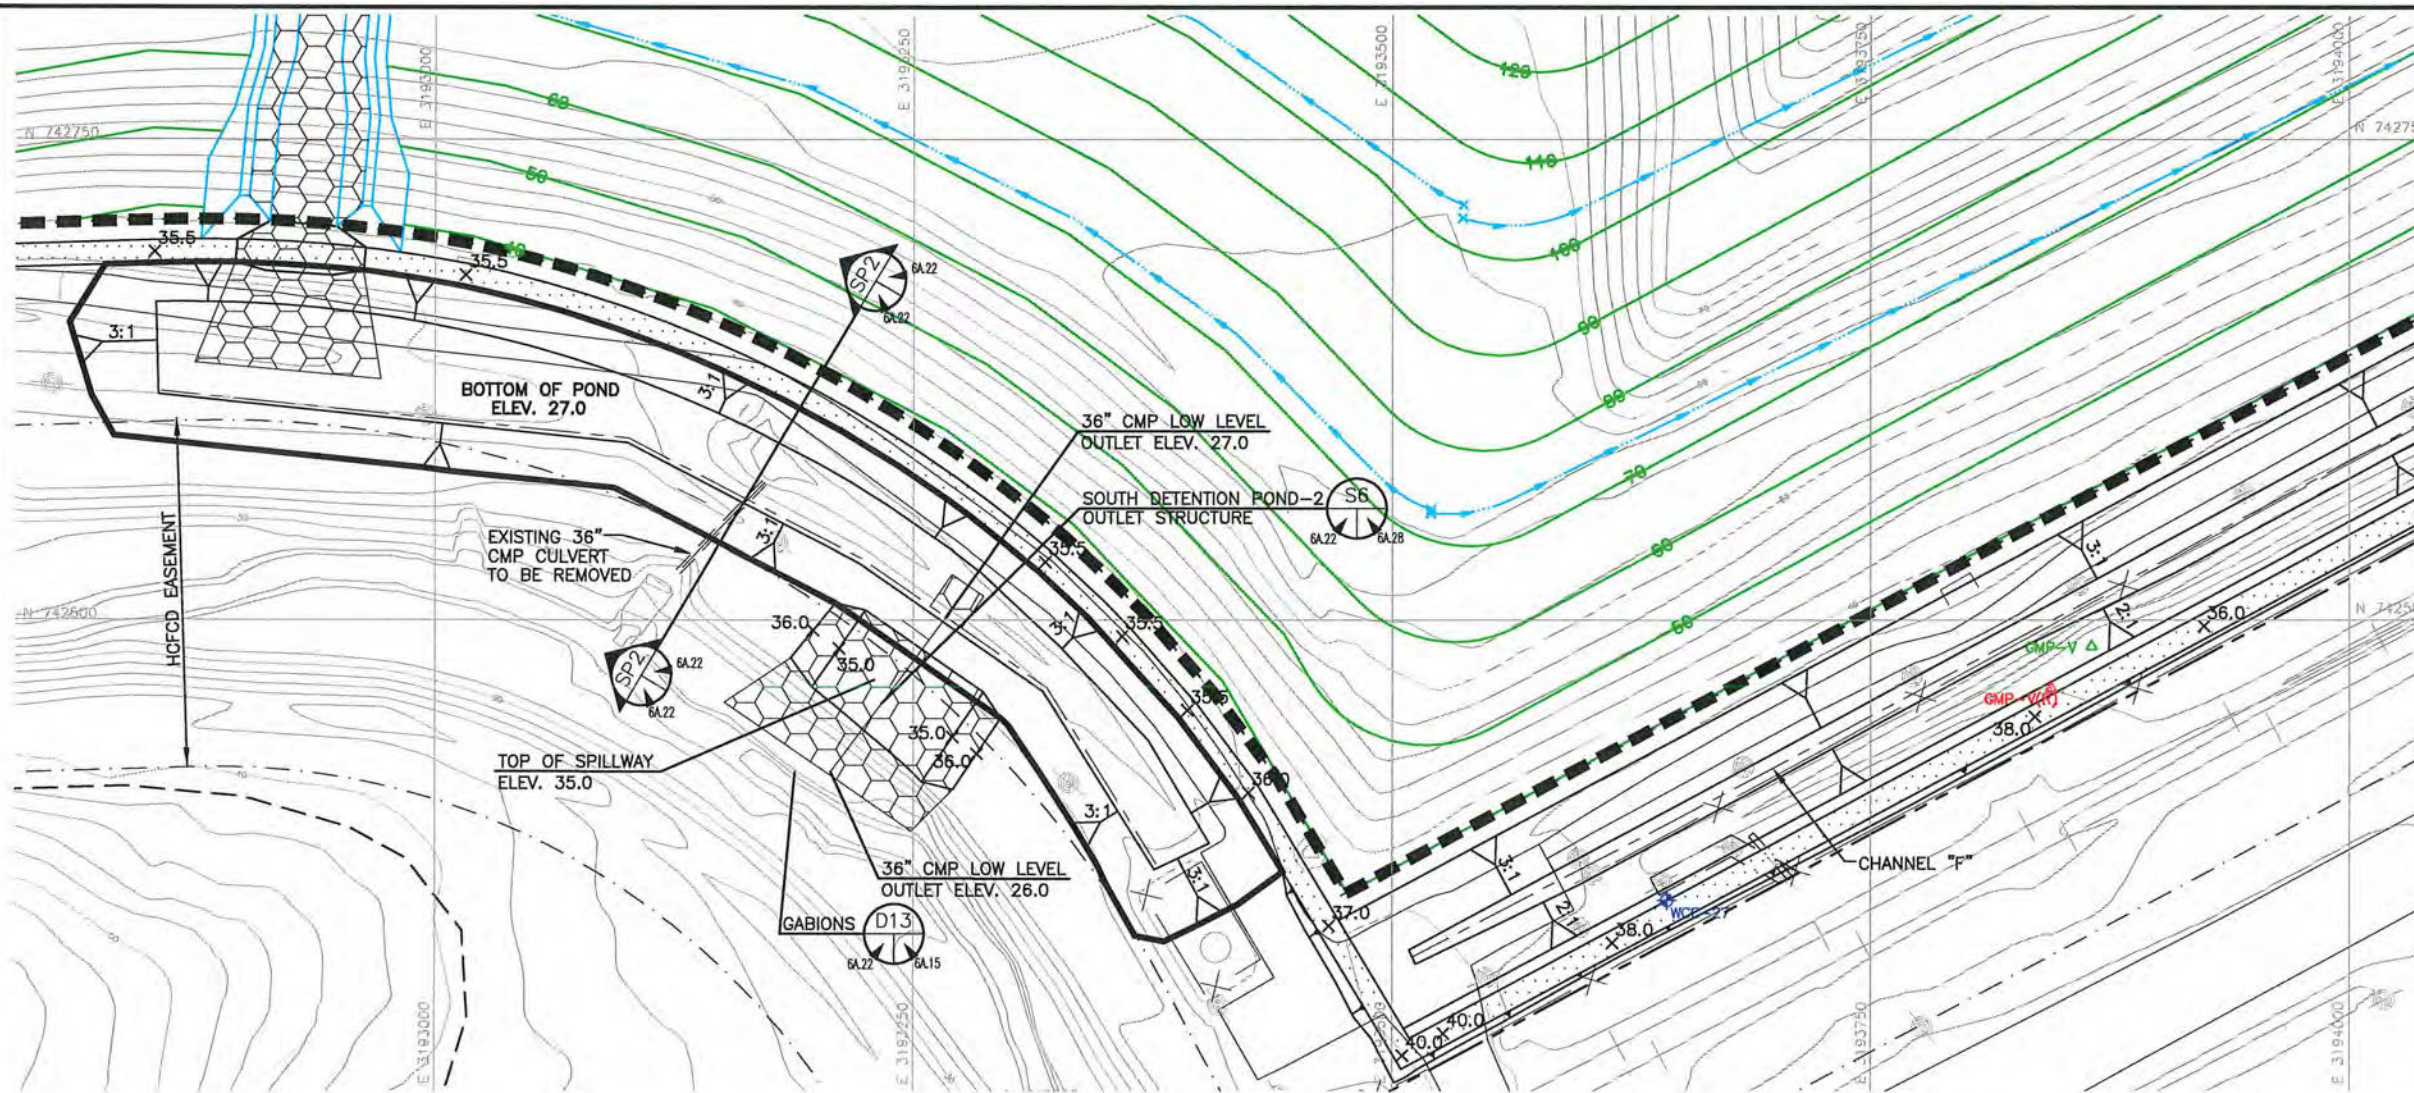


SOUTH DETENTION POND-2	
ELEVATION (FT-MSL)	SURFACE AREA (AC)
27.0	0.0010
28.0	0.5542
29.0	0.6472
30.0	0.7417
31.0	0.8379
32.0	0.9357
33.0	1.0352
34.0	1.1362
35.0	1.2332
36.0	1.3376


\* BOLD OUTLINE OF THE POND REPRESENTS THE LIMITS OF THE POND.

#### LEGEND

- PERMIT BOUNDARY
- EXISTING CONTOUR
- STATE PLANE COORDINATE SYSTEM
- FINAL CONTOUR
- LIMITS OF WASTE
- EASEMENT BOUNDARY
- PROPOSED DRAINAGE LETDOWN
- GABIONS
- PROPOSED DRAINAGE SWALE
- EXISTING DETECTION GROUNDWATER MONITORING WELL
- EXISTING LANDFILL GAS MONITORING PROBE TO BE DECOMMISSIONED
- PROPOSED REPLACEMENT LANDFILL GAS MONITORING PROBE
- POND LIMITS

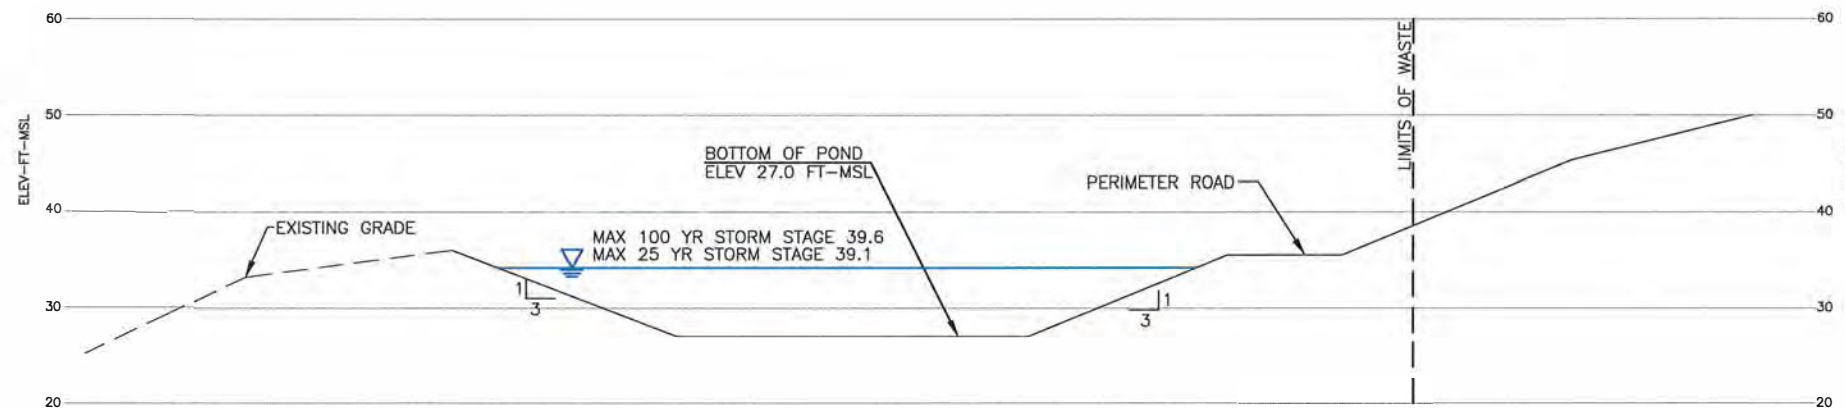


#### SOUTH DETENTION POND-2 SECTION

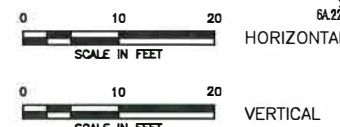


<input type="checkbox"/> DRAFT	PREPARED FOR
<input checked="" type="checkbox"/> FOR PERMITTING PURPOSES ONLY	McCARTY ROAD LANDFILL TX, LP
<input type="checkbox"/> ISSUED FOR CONSTRUCTION	
DATE: 03/2004	DRAWN BY: JOW
FILE: 0120-439-11	DESIGN BY: SAN/ALD
CAD: 6A22-S-POND.DWG	REVIEWED BY: JPY
Weaver Consultants Group	
TBPE REGISTRATION NO. F-3727	

MAJOR PERMIT AMENDMENT	
SOUTH POND-2	
McCARTY ROAD LANDFILL	
HARRIS COUNTY, TEXAS	
WWW.WCGRP.COM	ATTACHMENT 6A.22

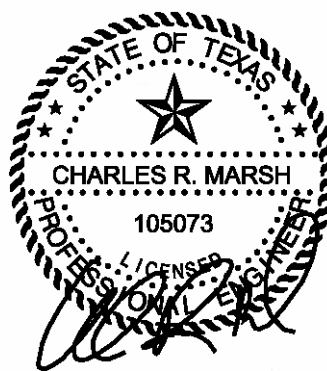



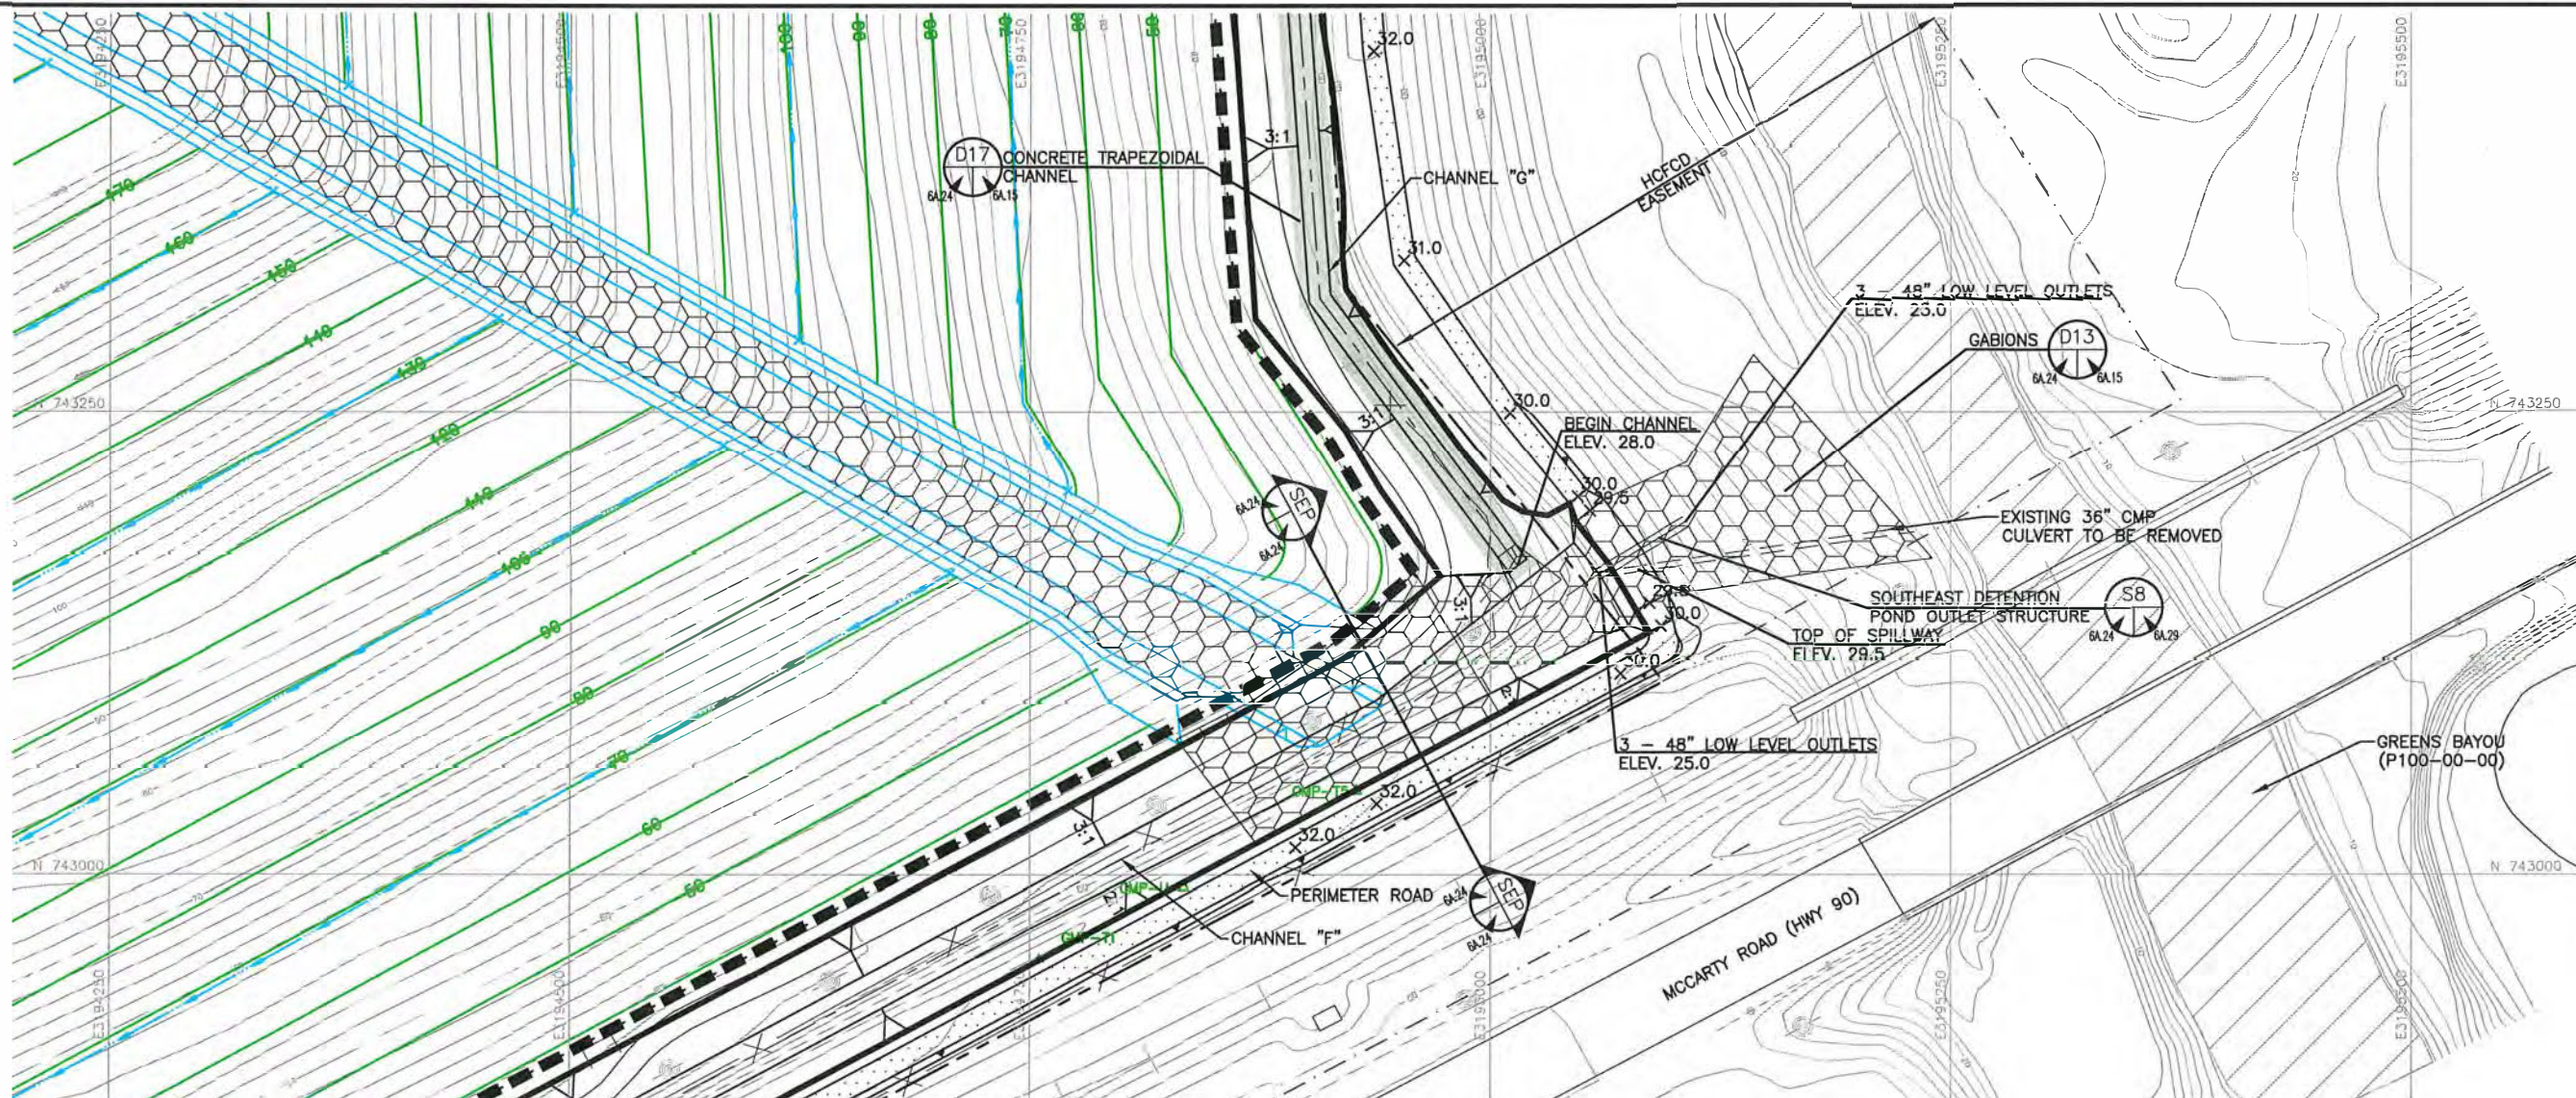


SOUTHEAST DETENTION POND	
ELEVATION (FT-MSL)	SURFACE AREA (AC)
25.0	0.0556
26.0	0.3693
27.0	0.6752
28.0	1.0046
29.0	1.3702
30.0	1.7328


\* BOLD OUTLINE OF THE POND REPRESENTS THE LIMITS OF THE POND.

LEGEND

- PERMIT BOUNDARY
- EXISTING CONTOUR
- STATE PLANE COORDINATE SYSTEM
- FINAL CONTOUR
- LIMITS OF WASTE
- EASEMENT BOUNDARY
- PROPOSED DRAINAGE LETDOWN
- GABIONS
- CONCRETE
- PROPOSED DRAINAGE SWALE
- EXISTING LANDFILL GAS MONITORING PROBE (SEE NOTE 1)
- EXISTING LANDFILL GAS MONITORING PROBE TO BE DECOMMISSIONED (SEE NOTE 1)
- POND LIMITS

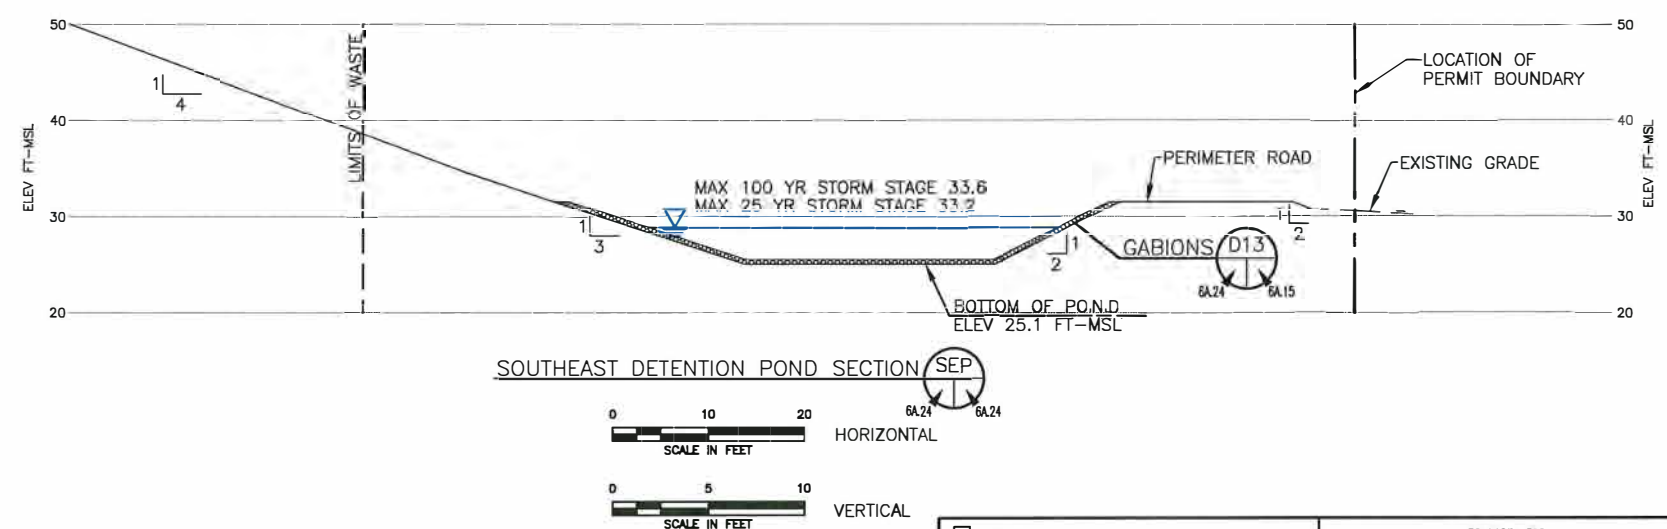

NOTE:  
1. GMP-T5 AND GMP-U ARE BEING DECOMMISSIONED VIA A PERMIT MODIFICATION SUBMITTED BY WBC IN APRIL 2004. GMP-T1 WILL BECOME A PERMANENT GAS MONITORING PROBE FOR THIS AREA. REFER TO ATTACHMENT 14 FOR ADDITIONAL INFORMATION.


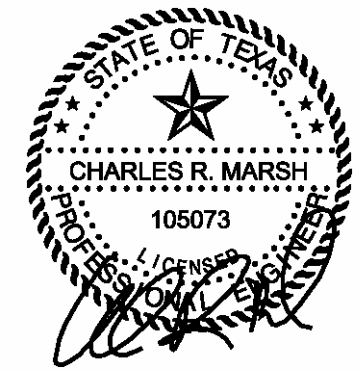


12/12/2024

<input type="checkbox"/> DRAFT <input checked="" type="checkbox"/> FOR PERMITTING PURPOSES ONLY <input type="checkbox"/> ISSUED FOR CONSTRUCTION	PREPARED FOR <b>MCCARTY ROAD LANDFILL TX, LP</b>	MAJOR PERMIT AMENDMENT SOUTHEAST POND
DATE: 03/2004 FILE: 0120-439-11 CAD: 6A24-SE-POND.DWG	DRAWN BY: JOW DESIGN BY: SAN/ALD REVIEWED BY: JPY	McCARTY ROAD LANDFILL HARRIS COUNTY, TEXAS
<b>Weaver Consultants Group</b> TBPE REGISTRATION NO. F-3727	REVISIONS NO. DATE DESCRIPTION 1 12/2024 PERMIT MODIFICATION	WWW.WCGRP.COM ATTACHMENT 6A.24


O:\0120\439\FLIP MOD 2024\ATT 6\6A\CLEAN\6A.24-SE-POND.dwg, vguzman, 1:2



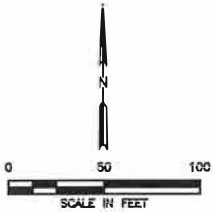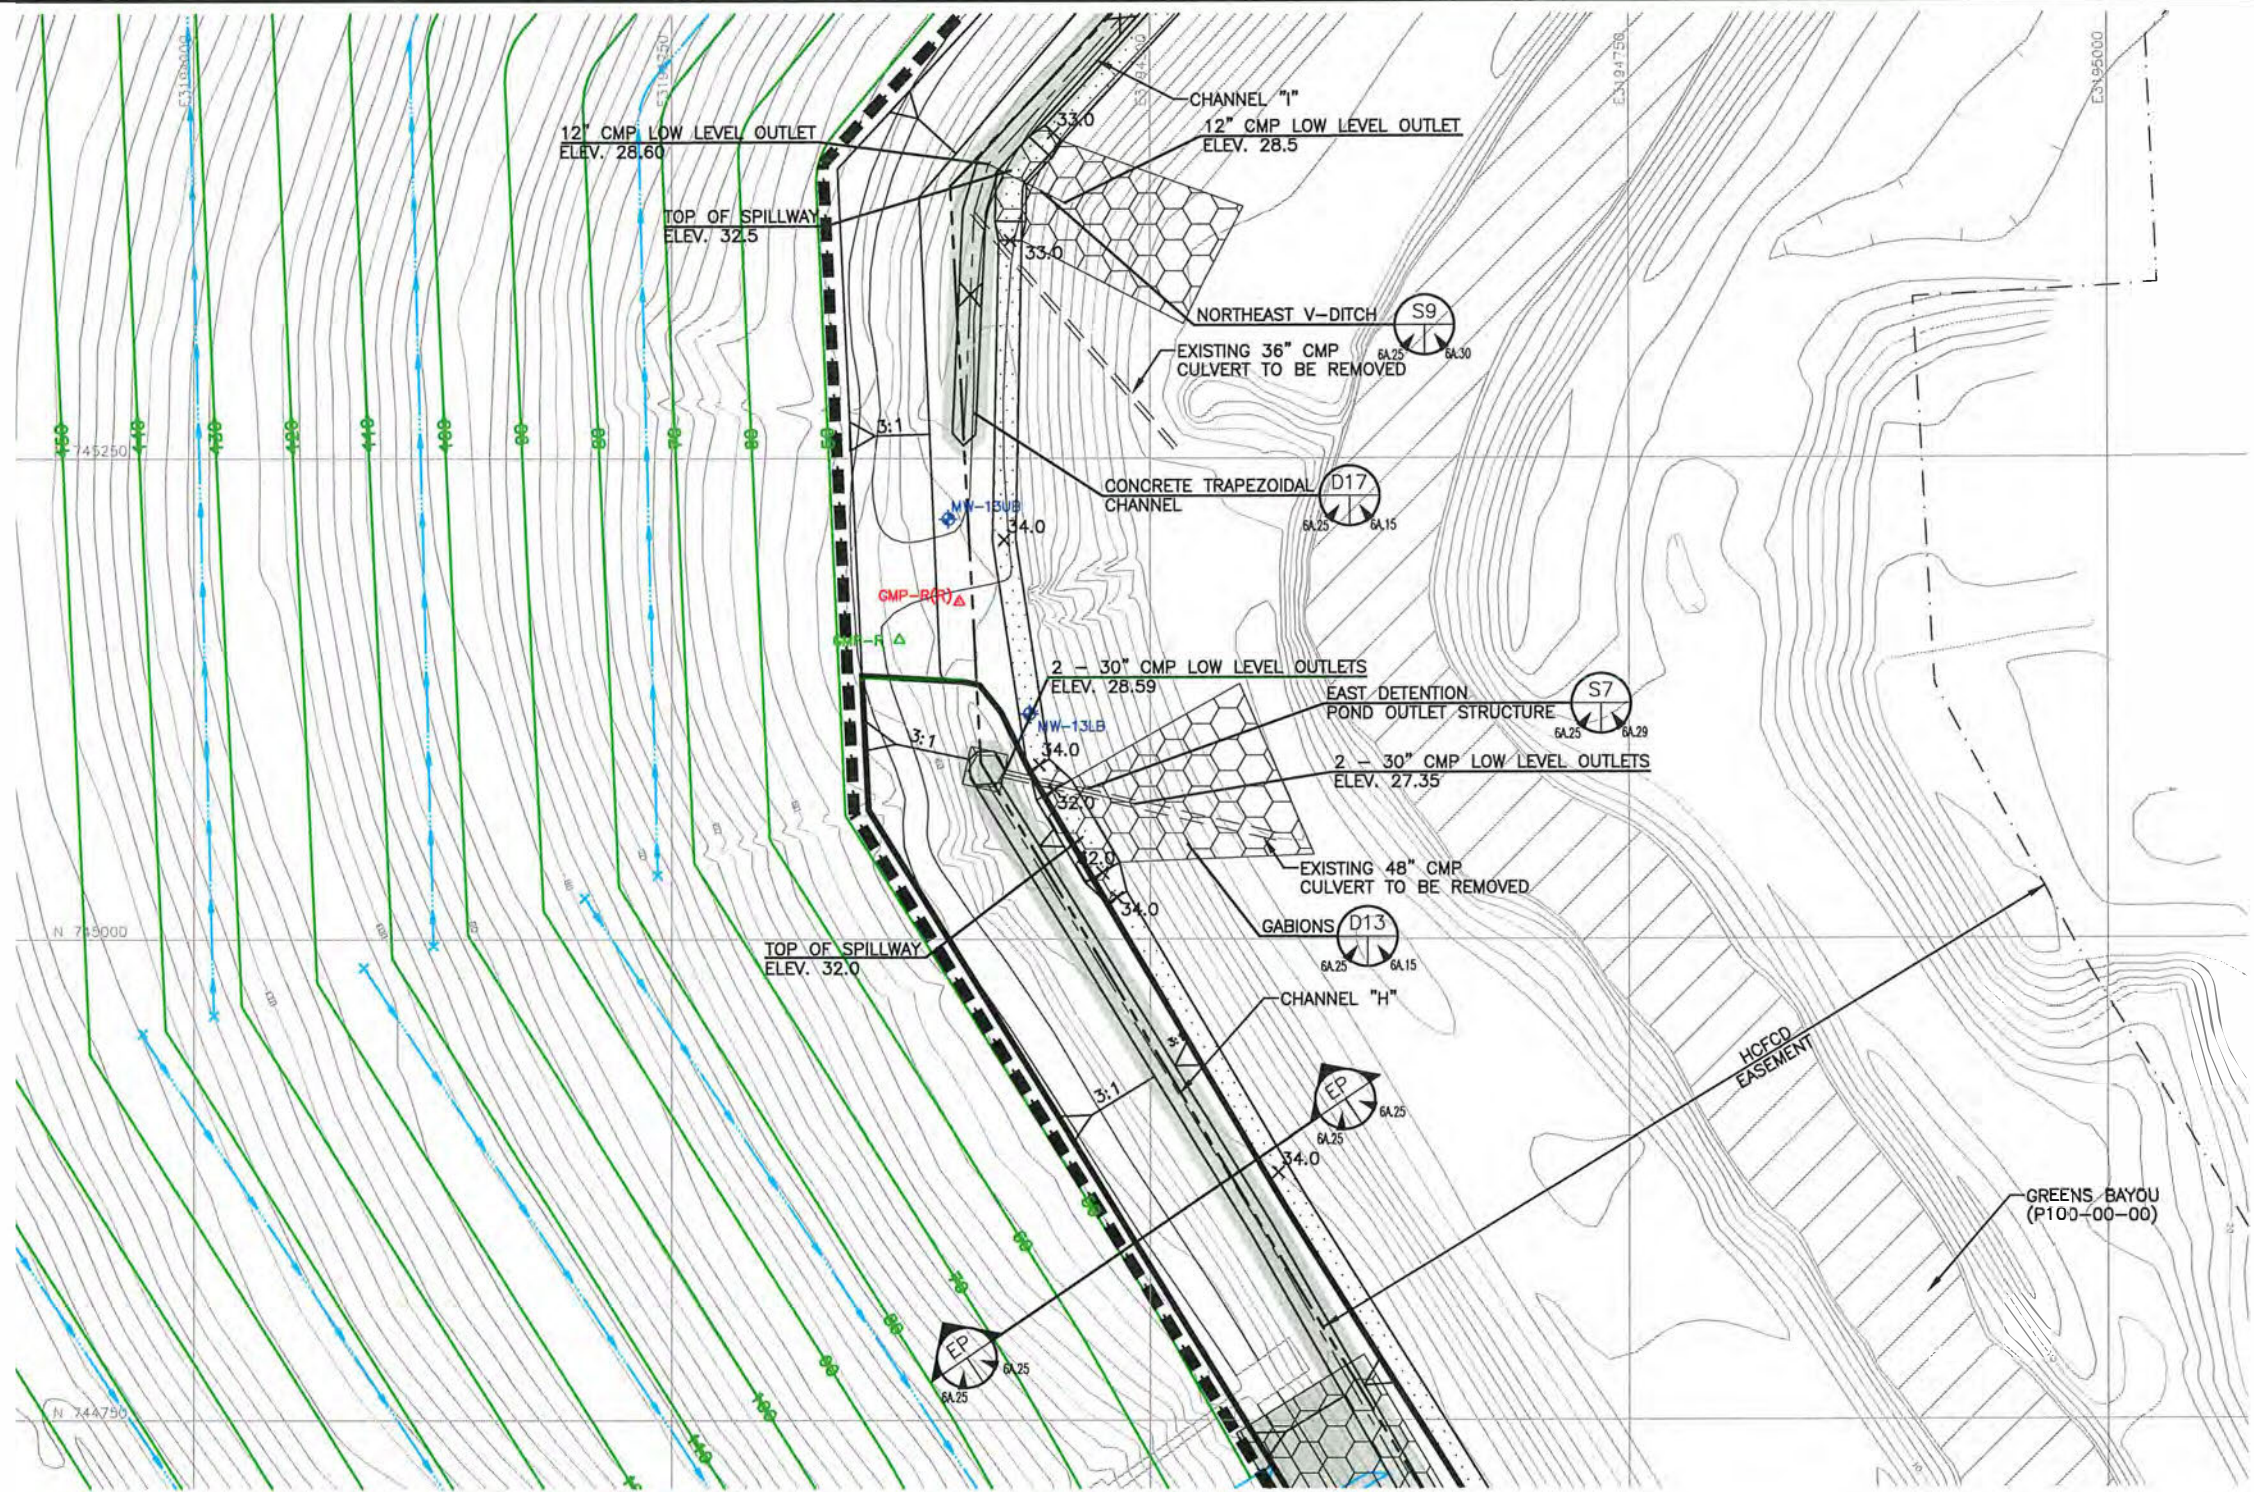

LEGEND

- PERMIT BOUNDARY
- EXISTING CONTOUR
- STATE PLANE COORDINATE SYSTEM
- FINAL CONTOUR
- LIMITS OF WASTE
- EASEMENT BOUNDARY
- GABIONS
- CONCRETE
- PROPOSED DRAINAGE SWALE
- EXISTING DETECTION GROUNDWATER MONITORING WELL
- EXISTING LANDFILL GAS MONITORING PROBE
- EXISTING LANDFILL GAS MONITORING PROBE TO BE DECOMMISSIONED (SEE NOTE 1)
- PROPOSED REPLACEMENT LANDFILL GAS MONITORING PROBE (SEE NOTE 1)
- POND LIMITS

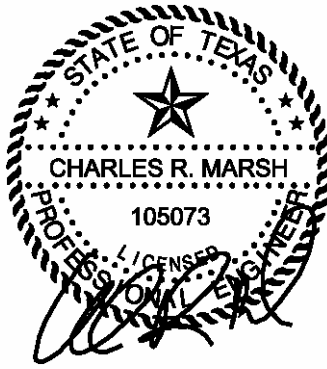


EAST DETENTION POND	
ELEVATION (FT-MSL)	SURFACE AREA (AC)
28.6	0.0061
29.0	0.1531
30.0	0.2422
31.0	0.3672
32.0	0.4937
33.0	0.6217

\* BOLD OUTLINE OF THE POND REPRESENTS THE LIMITS OF THE POND.


NOTE:

1. GAS MONITORING PROBE GMP-R WILL BE DECOMMISSIONED AND RELOCATED AS DOCUMENTED IN A PERMIT MODIFICATION SUBMITTED BY WEAVER BOOS CONSULTANTS IN APRIL 2004. REFER TO ATTACHMENT 14 FOR ADDITIONAL INFORMATION.

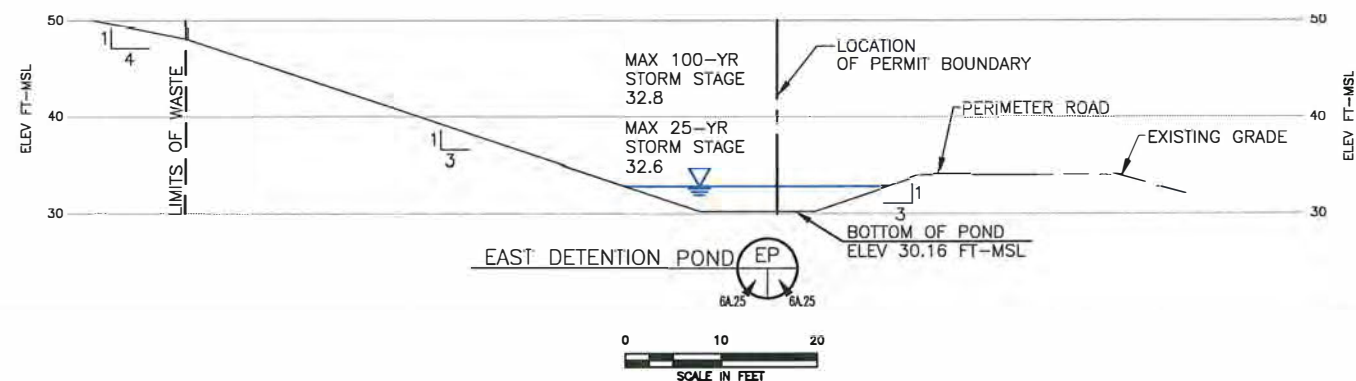

<input type="checkbox"/> DRAFT <input checked="" type="checkbox"/> FOR PERMITTING PURPOSES ONLY <input type="checkbox"/> ISSUED FOR CONSTRUCTION	PREPARED FOR <b>MCCARTY ROAD LANDFILL TX, LP</b>	MAJOR PERMIT AMENDMENT EAST POND	
DATE: 03/2004 FILE: 0120-439-11 CAD: 6A.14-SW-POND.DWG	DRAWN BY: JDW DESIGN BY: SAN/ALD REVIEWED BY: JPY	McCARTY ROAD LANDFILL HARRIS COUNTY, TEXAS	
Weaver Consultants Group TBPE REGISTRATION NO. F-3727		WWW.WCGRP.COM	
REVISIONS		ATTACHMENT 6A.25	
NO. DATE DESCRIPTION			
1 12/2024 PERMIT MODIFICATION			





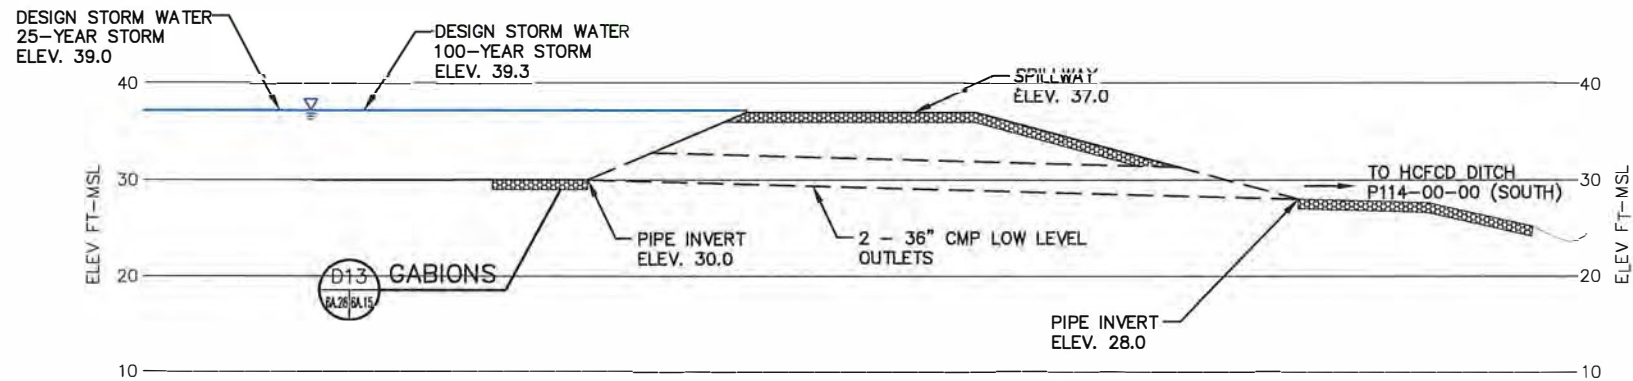

SOUTH DETENTION POND-1  
OUTLET STRUCTURE





SOUTH DETENTION POND-1	
BOTTOM ELEVATION	30.0 FT.
SPILLWAY ELEVATION	37.0 FT.
SPILLWAY LENGTH	80.0 FT.
PEAK 25-YEAR EVENT INFLOW	452.0 CFS
PEAK 25-YEAR EVENT OUTFLOW	307.0 CFS
PEAK 100-YEAR EVENT INFLOW	649.0 CFS
PEAK 100-YEAR EVENT OUTFLOW	415.0 CFS

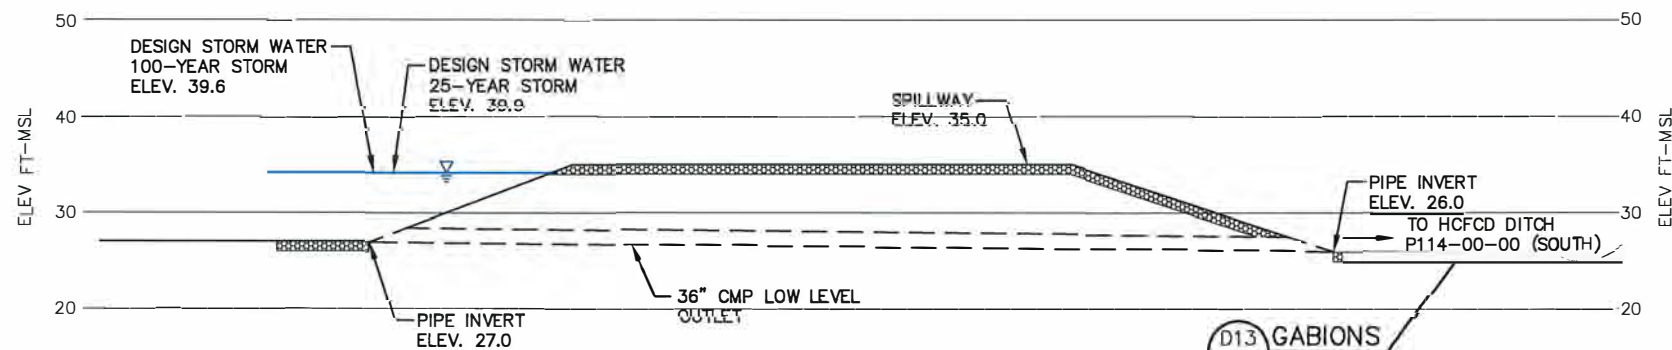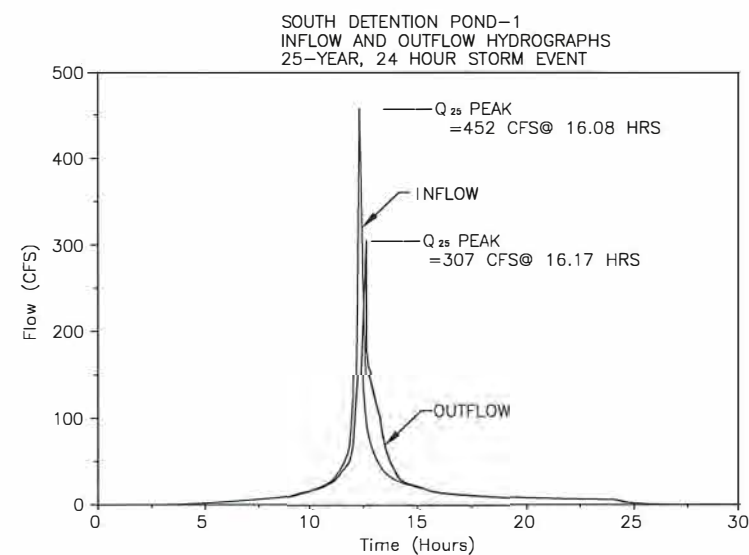

SOUTH DETENTION POND-2  
OUTLET STRUCTURE





SOUTH DETENTION POND-2	
BOTTOM ELEVATION	27.0 FT.
SPILLWAY ELEVATION	35.0 FT.
SPILLWAY LENGTH	75.0 FT.
PEAK 25-YEAR EVENT INFLOW	318.0 CFS
PEAK 25-YEAR EVENT OUTFLOW	18.0 CFS
PEAK 100-YEAR EVENT INFLOW	442.0 CFS
PEAK 100-YEAR EVENT OUTFLOW	75.0 CFS

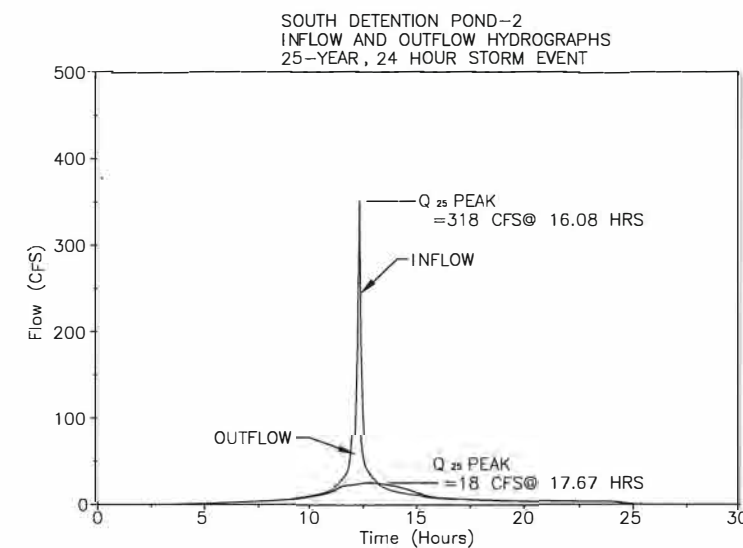
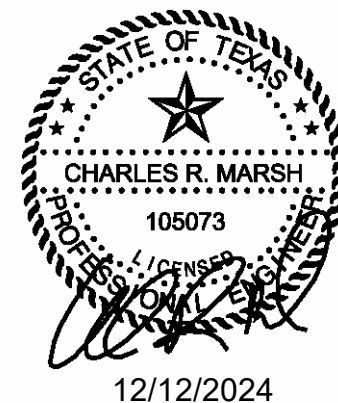


<input type="checkbox"/> DRAFT <input checked="" type="checkbox"/> FOR PERMITTING PURPOSES ONLY <input type="checkbox"/> ISSUED FOR CONSTRUCTION	PREPARED FOR <b>McCARTY ROAD LANDFILL TX, LP</b>	MAJOR PERMIT AMENDMENT POND OUTLET STRUCTURE DETAILS
DATE: 03/2004 FILE: 0120-439-11 CAD: 6A-28 OUTLET SP1&SP2.DWG	DRAWN BY: JDW DESIGN BY: SAM/ALD REVIEWED BY: JPY	REVISIONS NO. DATE DESCRIPTION 1 12/2024 PERMIT MODIFICATION
Weaver Consultants Group TBPE REGISTRATION NO. F-3727		McCARTY ROAD LANDFILL HARRIS COUNTY, TEXAS
		WWW.WCGRP.COM ATTACHMENT 6A.28

EAST DETENTION POND	
BOTTOM ELEVATION	28.59 FT.
SPILLWAY ELEVATION	32.0 FT.
SPILLWAY LENGTH	80.0 FT.
PEAK 25-YEAR EVENT INFLOW	270.0 CFS
PEAK 25-YEAR EVENT OUTFLOW	147.0 CFS
PEAK 100-YEAR EVENT INFLOW	374.0 CFS
PEAK 100-YEAR EVENT OUTFLOW	203.0 CFS

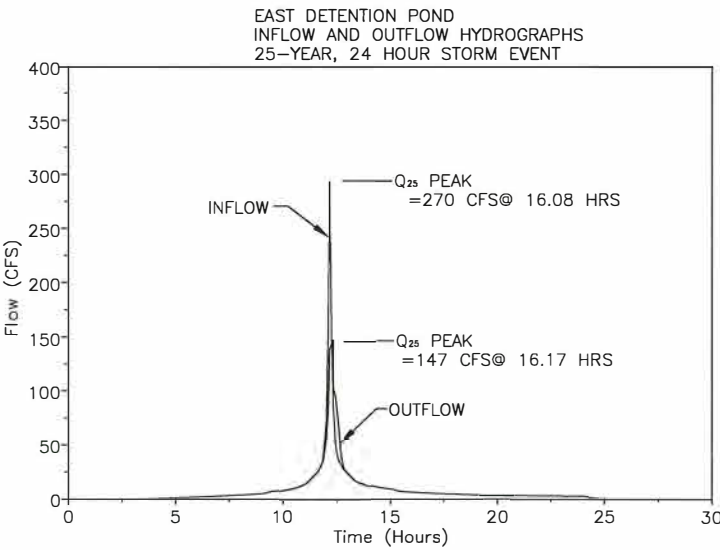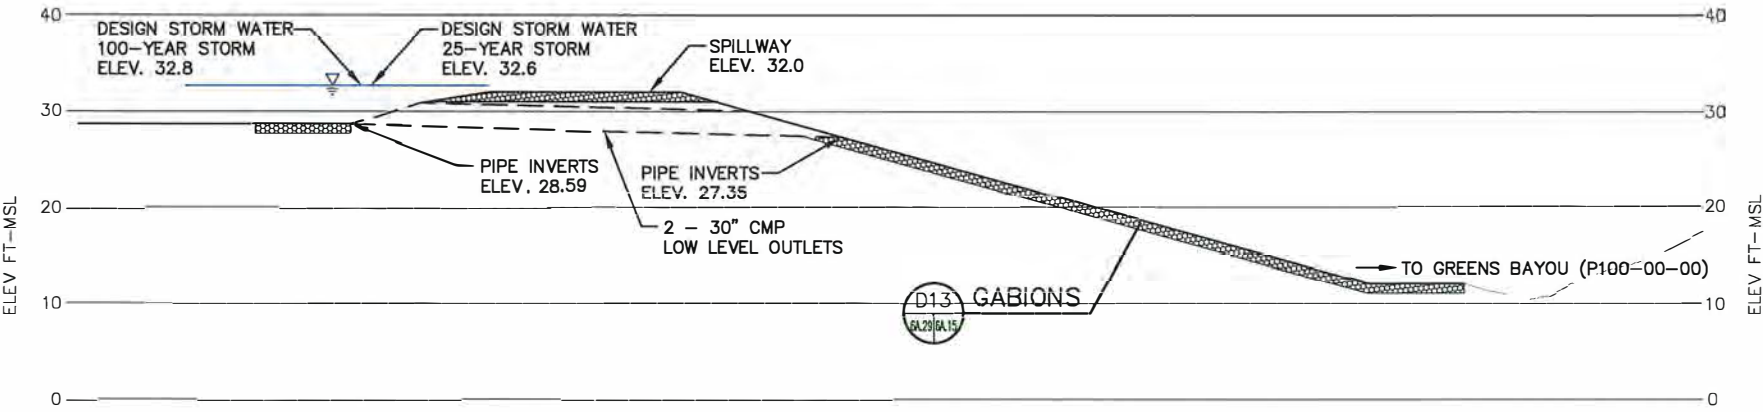


EAST DETENTION POND  
OUTLET STRUCTURE

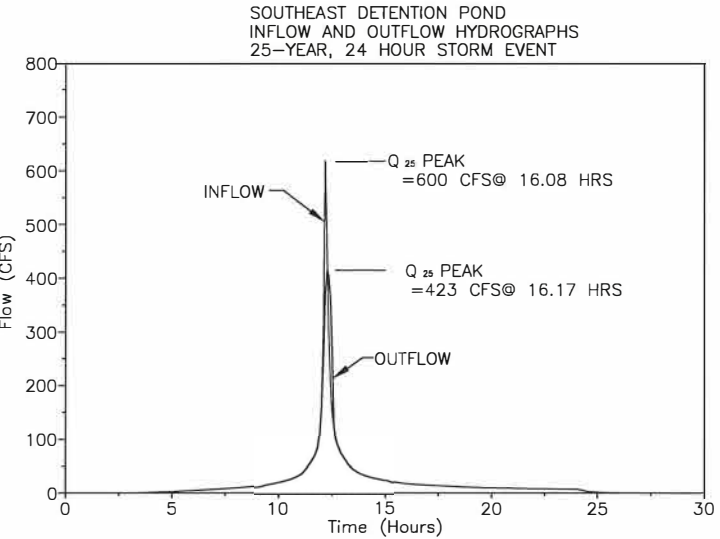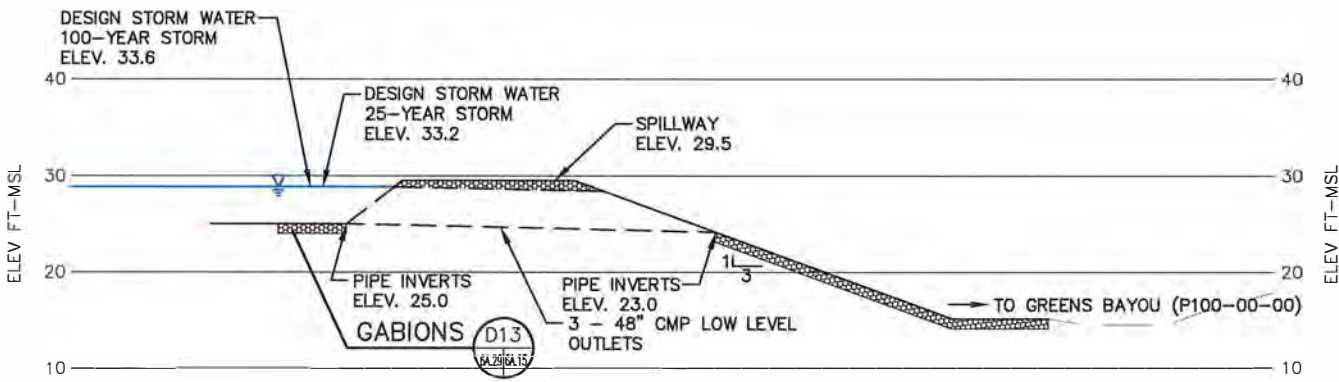

SOUTHEAST DETENTION POND  
OUTLET STRUCTURE

SOUTHEAST DETENTION POND	
BOTTOM ELEVATION	25.0 FT.
SPILLWAY ELEVATION	29.5 FT.
SPILLWAY LENGTH	60.0 FT.
PEAK 25-YEAR EVENT INFLOW	600.0 CFS
PEAK 25-YEAR EVENT OUTFLOW	423.0 CFS
PEAK 100-YEAR EVENT INFLOW	817.0 CFS
PEAK 100-YEAR EVENT OUTFLOW	564.0 CFS

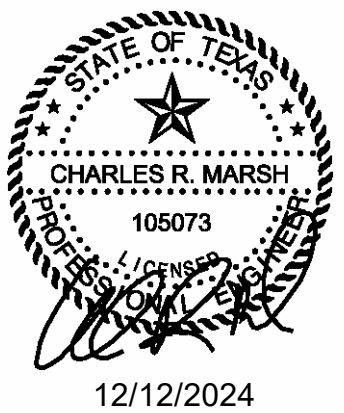

☐ DRAFT

☒ FOR PERMITTING PURPOSES ONLY

☐ ISSUED FOR CONSTRUCTION

DATE: 03/2004  
FILE: 0120-439-11  
CAD: 6A-29 OUTLET E&SE.DWG

DRAWN BY: JDW  
DESIGN BY: SAN/ALD  
REVIEWED BY: JPY

Weaver Consultants Group  
TBPE REGISTRATION NO. F-3727

PREPARED FOR

McCARTY ROAD LANDFILL TX, LP

REVISIONS

NO.	DATE	DESCRIPTION
1	12/2024	PERMIT MODIFICATION

MAJOR PERMIT AMENDMENT  
POND OUTLET STRUCTURE DETAILS


McCARTY ROAD LANDFILL  
HARRIS COUNTY, TEXAS

WWW.WCGRP.COM



ATTACHMENT 6A.29

O:\0120\439\FILE MOD 2024\ATT 6\6A\CLEAN\6A.29OUTLET E&SE.DWG, yeguzman, 1:2



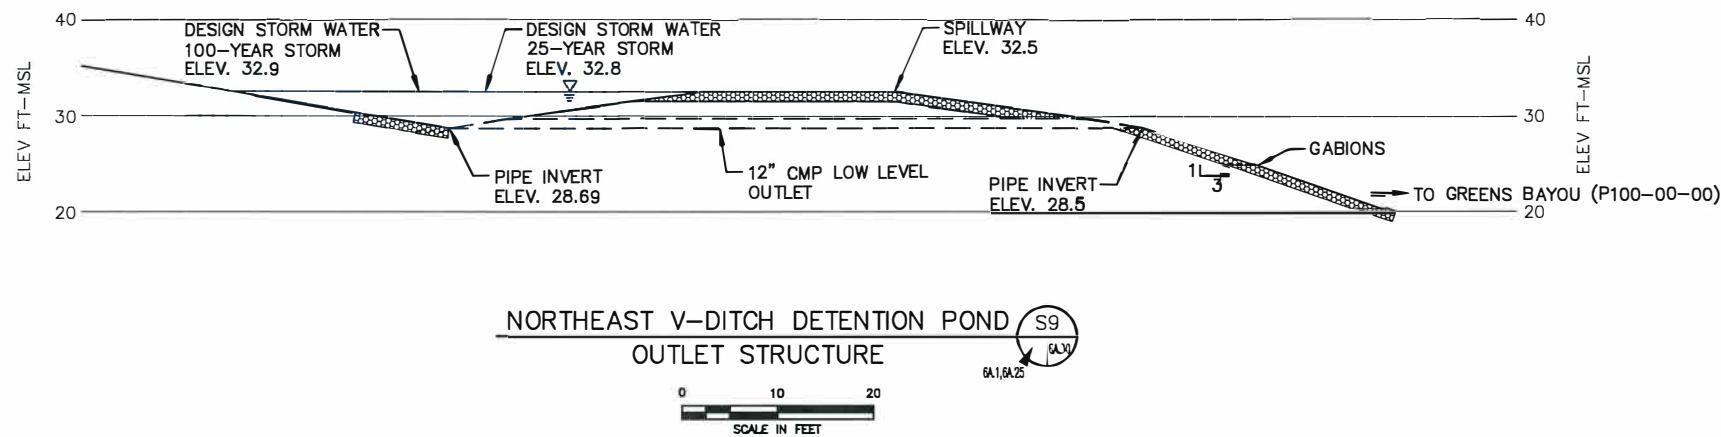

NORTHEAST V-DITCH	
BOTTOM ELEVATION	28.7 FT.
SPILLWAY ELEVATION	32 FT.
SPILLWAY LENGTH	50 FT.
PEAK 25-YEAR EVENT INFLOW	41 CFS
PEAK 25-YEAR EVENT OUTFLOW	32 CFS
PEAK 100-YEAR EVENT INFLOW	50 CFS
PEAK 100-YEAR EVENT OUTFLOW	42 CFS

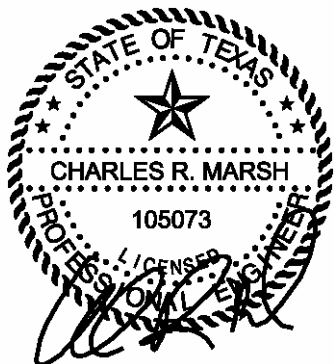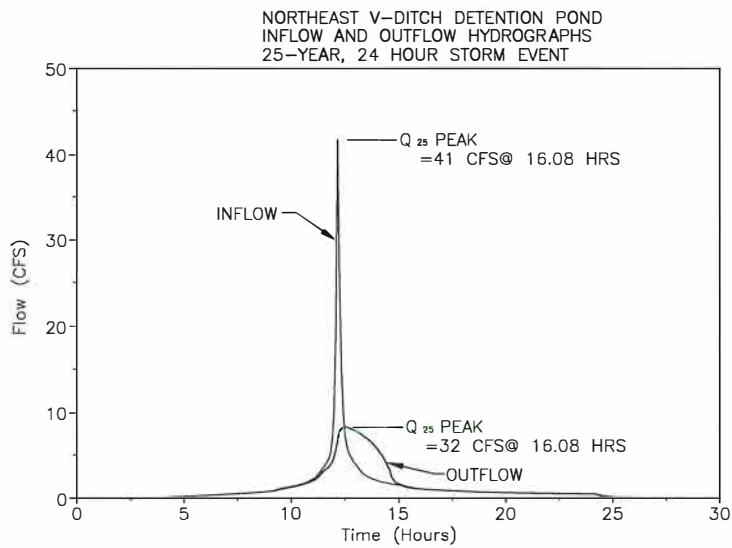


12/12/2024

<input type="checkbox"/> DRAFT <input checked="" type="checkbox"/> FOR PERMITTING PURPOSES ONLY <input type="checkbox"/> ISSUED FOR CONSTRUCTION	PREPARED FOR <b>McCARTY ROAD LANDFILL TX, LP</b>	MAJOR PERMIT AMENDMENT POND OUTLET STRUCTURE DETAILS	
DATE: 03/2004 FILE: 0120-439-11 CAD: 6A-30COUTLET NEV.DWG	DRAWN BY: JOW DESIGN BY: SAN/ALD REVIEWED BY: JPY	McCARTY ROAD LANDFILL HARRIS COUNTY, TEXAS	
Weaver Consultants Group TBPE REGISTRATION NO. F-3727		WWW.WCGRP.COM ATTACHMENT 6A.30	

C:\0120\439\FLIP MOD 2024\ATT 6\6A\CLEAN\6A-30COUTLET NEV.DWG, vguzman, 1:2

**ATTACHMENT 6A**  
**APPENDIX 6A-B**  
**PERIMETER CHANNEL AND DETENTION POND DESIGN**

Includes pages 6A-B.1-1 through 6A-B.2B2-20

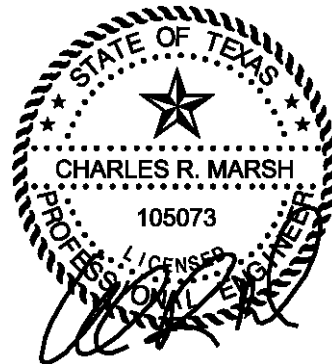

12/12/2024



McCARTY ROAD LANDFILL  
0120-439-11-03-11  
PERIMETER CHANNEL HYDRAULIC ANALYSIS  
100-YEAR NORMAL DEPTH CALCULATIONS

**Example Calculation:** Calculate the normal depth for Channel C between stations 2+59.2 and 9+02.7.

List of Symbols

$Q_d$  = design flow rate for channel, cfs  
 $R$  = hydraulic radius, ft  
 $n$  = Manning's roughness coefficient  
 $S$  = channel slope, ft/ft  
 $b$  = bottom width of channel, ft  
 $z$  = z-ratio (ratio of run to rise for channel sideslope)  
 $A_f$  = flow area, sf  
 $g$  = gravitational acceleration = 32.2 ft/s<sup>2</sup>  
 $T$  = top width of flow, ft  
 $d$  = normal depth of channel, ft

The program uses an iterative process to calculate the normal depth of the channel to satisfy Manning's Equation

$$Q = \frac{1.486}{n} A R^{0.67} S^{0.5}$$

Design Inputs:

$Q_d$  = 1551 cfs (from 100-year, 24-hour storm HEC-1 analysis, Attachment 6A-A)  
 $S$  = 0.002 ft/ft  
 $b$  = 25 ft  
 $z$  = 2 (H) : 1 (V)  
 $n$  = 0.04

Step 1 - Based on the geometry of the channel cross-section, solve for  $R$  and  $A_f$

$$R = \frac{bd + zd^2}{b + 2d(z^2 + 1)^{0.5}}$$

$$A_f = bd + zd^2$$

assume:  $d$  = 7.68 ft

$R$  = 5.223 ft

$A_f$  = 310.10 sf

solve for  $Q$   $Q$  = 1551

if  $Q$  is not equal to  $Q_d$ , select a new  $d$  and repeat calculations

McCARTY ROAD LANDFILL  
0120-439-11-03-11  
PERIMETER CHANNEL HYDRAULIC ANALYSIS  
100-YEAR NORMAL DEPTH CALCULATIONS

Step 2 - solve for velocity, T, Froude number, velocity head, and energy head

$$Q = VA \Rightarrow V = Q/A$$

$$V = 5.00 \text{ ft/s}$$

$$T = b + 2(z \times d)$$

$$T = 55.73 \text{ ft}$$

$$F_r = \frac{V}{(gA/T)^{0.5}}$$

$$F_r = 0.374$$

$$\text{Velocity Head} = \frac{V^2}{2g}$$

$$\text{Velocity Head} = 0.39 \text{ ft}$$


Energy Head = water elevation + velocity head

$$\text{Energy Head} = 8.07 \text{ ft}$$



**ATTACHMENT 6A**  
**APPENDIX 6A-C**  
**FINAL COVER EROSION CONTROL STRUCTURE DESIGN**

Includes pages 6A-C-1 through 6A-C-32

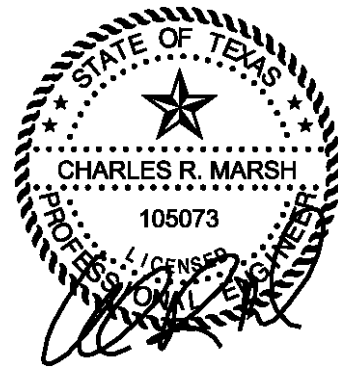

12/12/2024

Prep By: VG  
Date: 12/10/2024

McCARTY ROAD LANDFILL  
0120-439-11-03-11  
EROSION CONTROL STRUCTURE DESIGN  
GABION-LINED CHUTE DESIGN  
100-YEAR, 24 HOUR STORM

Chkd By: CRM  
Date: 12/10/2024

Chute	Q <sup>1</sup>	W	q	Y <sub>C</sub>	Y <sub>O</sub>	y <sub>1</sub>	K <sub>1</sub>	K <sub>2</sub>
1	345	30	11.50	1.60	0.75	1.78	3.52	0.98
2	301	30	10.03	1.46	0.69	1.63	3.20	0.90
3	210	25	8.40	1.30	0.62	1.45	2.82	0.80
4	252	25	10.08	1.47	0.69	1.63	3.21	0.90
5	92	20	4.60	0.87	0.43	0.97	1.84	0.53
6	341	40	8.53	1.31	0.62	1.46	2.85	0.81
7	365	40	9.13	1.37	0.65	1.53	2.99	0.84
8	342	35	9.77	1.44	0.68	1.60	3.14	0.88
9	250	30	8.34	1.29	0.62	1.44	2.81	0.79
10	292	30	9.72	1.43	0.67	1.59	3.13	0.88
11	176	20	8.80	1.34	0.64	1.49	2.92	0.82
12	257	30	8.56	1.31	0.62	1.46	2.86	0.81
13	394	40	9.85	1.44	0.68	1.61	3.16	0.89
14	306	35	8.75	1.33	0.63	1.49	2.90	0.82
15	272	30	9.07	1.37	0.65	1.52	2.98	0.84
16	254	30	8.47	1.31	0.62	1.45	2.84	0.80
17	431	40	10.78	1.53	0.72	1.71	3.37	0.94



McCARTY ROAD LANDFILL  
0120-439-11-03-11  
CHUTE ANALYSIS  
NORMAL DEPTH CALCULATIONS  
25-YEAR, 24 HOUR STORM

Drainage Area	Flow Rate (cfs)	Bottom Slope (ft/ft)	Manning's n	Side Slope (left)	Side Slope (right)	Bottom Width (ft)	Normal Depth (ft)	Flow Vel. (fps)	Froude Number	Velocity Head (ft)	Energy Head (ft)	Flow Area (sf)	Flow Top Width (ft)
DA1	227	0.25	0.04	4.0	4.0	24.0	0.65	13.09	3.00	2.66	3.31	17.34	29.21
DA2	214	0.25	0.04	4.0	4.0	24.0	0.63	12.82	2.980	2.55	3.18	16.69	29.04
DA3	162	0.25	0.04	4.0	4.0	24.0	0.53	11.60	2.909	2.09	2.62	13.97	28.28
DA4	169	0.25	0.04	4.0	4.0	24.0	0.55	11.78	2.920	2.16	2.70	14.35	28.38
DA5	66	0.25	0.04	4.0	4.0	12.0	0.47	10.23	2.815	1.63	2.09	6.45	15.72
DA5	66	0.25	0.04	4.0	4.0	24.0	0.31	8.31	2.675	1.07	1.39	7.95	26.52
DA6	247	0.25	0.04	4.0	4.0	12.0	0.98	15.74	3.123	3.85	4.84	15.69	19.88
DA6	247	0.25	0.04	4.0	4.0	24.0	0.68	13.49	3.017	2.83	3.51	18.31	29.48
DA7	273	0.25	0.04	4.0	4.0	12.0	1.04	16.23	3.145	4.09	5.13	16.82	20.33
DA7	273	0.25	0.04	4.0	4.0	24.0	0.73	13.97	3.043	3.03	3.76	19.54	29.81
DA8	246	0.25	0.04	4.0	4.0	12.0	0.98	15.72	3.122	3.84	4.82	15.65	19.86
DA8	246	0.25	0.04	4.0	4.0	24.0	0.68	13.47	3.016	2.82	3.50	18.26	29.47
DA9	180	0.25	0.04	4.0	4.0	12.0	0.83	14.25	3.049	3.16	3.98	12.63	18.60
DA9	180	0.25	0.04	4.0	4.0	24.0	0.57	12.05	2.936	2.26	2.82	14.94	28.55
DA10	211	0.25	0.04	4.0	4.0	12.0	0.90	15.00	3.090	3.50	4.40	14.07	19.21
DA10	211	0.25	0.04	4.0	4.0	24.0	0.62	12.75	2.977	2.53	3.15	16.54	28.99
DA11	127	0.25	0.04	4.0	4.0	12.0	0.68	12.73	2.967	2.52	3.20	9.97	17.42
DA11	127	0.25	0.04	4.0	4.0	24.0	0.46	10.60	2.841	1.75	2.21	11.98	27.71
DA12	185	0.25	0.04	4.0	4.0	12.0	0.84	14.37	3.055	3.21	4.05	12.87	18.71
DA12	185	0.25	0.04	4.0	4.0	24.0	0.58	12.17	2.943	2.30	2.88	15.20	28.62
DA13	285	0.25	0.04	4.0	4.0	12.0	1.07	16.44	3.154	4.20	5.27	17.33	20.53
DA13	285	0.25	0.04	4.0	4.0	24.0	0.74	14.19	3.054	3.13	3.87	20.09	29.96
DA14	220	0.25	0.04	4.0	4.0	12.0	0.92	15.19	3.098	3.59	4.51	14.48	19.38
DA14	220	0.25	0.04	4.0	4.0	24.0	0.64	12.95	2.987	2.60	3.24	16.99	29.12
DA15	196	0.25	0.04	4.0	4.0	12.0	0.87	14.64	3.069	3.33	4.20	13.39	18.93
DA15	196	0.25	0.04	4.0	4.0	24.0	0.60	12.42	2.958	2.40	3.00	15.78	28.78
DA16	187	0.25	0.04	4.0	4.0	12.0	0.84	14.42	3.058	3.23	4.08	12.97	18.75
DA16	187	0.25	0.04	4.0	4.0	24.0	0.58	12.21	2.946	2.32	2.90	15.31	28.65
DA17	308	0.25	0.04	4.0	4.0	12.0	1.11	16.83	3.171	4.40	5.51	18.30	20.90
DA17	308	0.25	0.04	4.0	4.0	24.0	0.78	14.58	3.074	3.30	4.08	21.13	30.23

Note: Calculations were performed using the HYDROCALC HYDRAULICS program developed by Dodson and Associates (Version 2.0.1, 1996).

McCARTY ROAD LANDFILL  
0120-439-11-03-11  
CHUTE ANALYSIS  
NORMAL DEPTH CALCULATIONS  
25-YEAR, 24 HOUR STORM

**Example Calculation:** Calculate the normal depth for the chute for DA10.

List of Symbols

$Q_d$  = design flow rate for channel, cfs  
 $R$  = hydraulic radius, ft  
 $n$  = Manning's roughness coefficient  
 $S$  = channel slope, ft/ft  
 $b$  = bottom width of channel, ft  
 $z$  = z-ratio (ratio of run to rise for channel sideslope)  
 $A_f$  = flow area, sf  
 $g$  = gravitational acceleration = 32.2 ft/s<sup>2</sup>  
 $T$  = top width of flow, ft  
 $d$  = normal depth of chute, ft

The program uses an iterative process to calculate the normal depth of the chute to satisfy Manning's Equation

$$Q = \frac{1.486}{n} A R^{0.67} S^{0.5}$$

Design Inputs:

$Q_d$ =	211	cfs (from HEC-HMS analysis, Attachment 6A-A)
$S$ =	0.25	ft/ft
$b$ =	12	ft
$z$ =	4	(H) : 1 (V)
$n$ =	0.04	

Step 1 - Based on the geometry of the chute cross-section, solve for  $R$  and  $A_f$

$$R = \frac{bd + zd^2}{b + 2d(z^2 + 1)^{0.5}}$$

$$A_f = bd + zd^2$$

assume:  $d$  = 0.90 ft

$R$  = 0.724 ft

$A_f$  = 14.07 sf

solve for  $Q$ :  $Q$  = 211 cfs



McCARTY ROAD LANDFILL  
0120-439-11-03-11  
CHUTE ANALYSIS  
NORMAL DEPTH CALCULATIONS  
25-YEAR, 24 HOUR STORM

if  $Q$  is not equal to  $Q_d$ , select a new  $d$  and repeat calculations

Step 2 - solve for velocity,  $T$ , Froude number, velocity head, and energy head

$$Q = VA \Rightarrow$$

$$V = Q/A$$

$$V = 15.00 \text{ ft/s}$$

$$T = b + 2(z \times d)$$

$$T = 19.21 \text{ ft}$$

$$F_r = \frac{V}{(gA/T)^{0.5}}$$

$$F_r = 3.090 \text{ ft}$$

$$\text{Velocity Head} = \frac{V^2}{2g}$$


$$\text{Velocity Head} = 3.50 \text{ ft}$$

Energy Head = water elevation + velocity head

$$\text{Energy Head} = 4.40 \text{ ft}$$


**ATTACHMENT 6A**  
**APPENDIX 6A-G**  
**EROSION CONTROL PLAN FOR ALL PHASES  
OF LANDFILL OPERATION**

Includes Pages 6A-G-1 through 6A-G-7

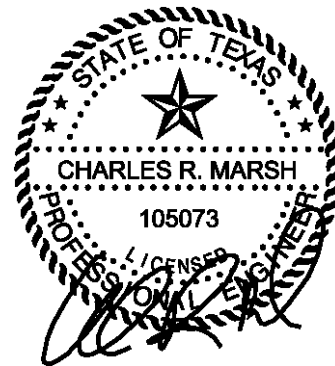


12/12/2024



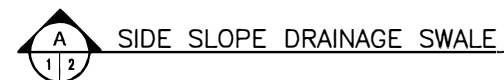

- 1 REFER TO APPENDIX 6A-G-1 FOR SUPPORTING CALCULATIONS.
- 2 IF SITE SPECIFIC CONDITIONS YIELD A MAXIMUM HORIZONTAL DISTANCE BETWEEN THE TOE OF THE SLOPE AND GRADE BREAK OF LESS THAN 300 FEET FOR SIDE SLOPES AND A DISTANCE OF 500 FEET FROM THE GRADE BREAK TO THE PEAK OF THE TOP SLOPES, ESTABLISHMENT OF 60% VEGETATION WILL BE SUFFICIENT MEANS OF EROSION CONTROL WITHOUT THE ADDITION OF TEMPORARY SWALES AND LETDOWNS GIVEN THAT THE TOTAL SOIL LOSS FOR THE SIDE SLOPE IS LESS THAN 50 TONS/ACRE/YEAR AND THE TOP SLOPE IS LESS THAN 50 TONS/ACRE/YEAR.

MAXIMUM DRAINAGE AREA x (43,560 SF/ACRE)/MINIMUM SWALE SPACING

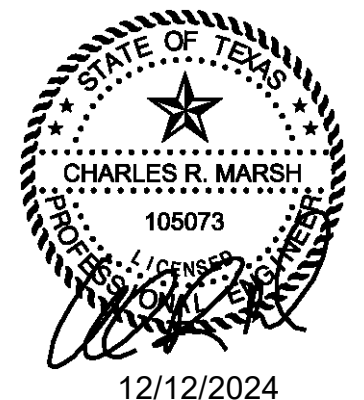

OPEN CHANNEL GEOMEMBRANE LETDOWN DESIGN SUMMARY

DESIGN IS APPLICABLE FOR A DRAINAGE AREA UP TO 35 ACRES (TOP DECK AND SIDE SLOPE).  
25% SLOPE  
MAXIMUM FLOW DEPTH = 0.62 FT.  
BOTTOM WIDTH = 8 FT.  
3.5% SLOPE  
MAXIMUM FLOW DEPTH = 1.08 FT.  
BOTTOM WIDTH = 8 FT.

OPEN CHANNEL GABION LETDOWN DESIGN SUMMARY

DESIGN IS APPLICABLE FOR A DRAINAGE AREA UP TO 25 ACRES (TOP DECK AND SIDE SLOPE).  
25% SLOPE  
MAXIMUM FLOW DEPTH = 1.36 FT.  
BOTTOM WIDTH = 8 FT.  
3.5% SLOPE  
MAXIMUM FLOW DEPTH = 1.94 FT.  
BOTTOM WIDTH = 8 FT.

OPEN CHANNEL ROCK RIPRAP LETDOWN DESIGN SUMMARY


DESIGN IS APPLICABLE FOR A DRAINAGE AREA UP TO 25 ACRES (TOP DECK ONLY).  
3.5% SLOPE  
MAXIMUM FLOW DEPTH = 1.94 FT.  
BOTTOM WIDTH = 8 FT.

OPEN CHANNEL GROUTED RIPRAP LETDOWN DESIGN SUMMARY

DESIGN IS APPLICABLE FOR A DRAINAGE AREA UP TO 25 ACRES (TOP DECK) AND 35 ACRES (SIDE SLOPE).  
25% SLOPE  
MAXIMUM FLOW DEPTH = 1.36 FT.  
BOTTOM WIDTH = 8 FT.  
3.5% SLOPE  
MAXIMUM FLOW DEPTH = 1.94 FT.  
BOTTOM WIDTH = 8 FT.

OPEN CHANNEL TURF REINFORCEMENT LETDOWN DESIGN SUMMARY




DESIGN IS APPLICABLE FOR A DRAINAGE AREA UP TO 35 ACRES (TOP DECK AND SIDE SLOPE).  
25% SLOPE  
MAXIMUM FLOW DEPTH = 1.36 FT.  
BOTTOM WIDTH = 8 FT.  
3.5% SLOPE  
MAXIMUM FLOW DEPTH = 1.99 FT.  
BOTTOM WIDTH = 8 FT.

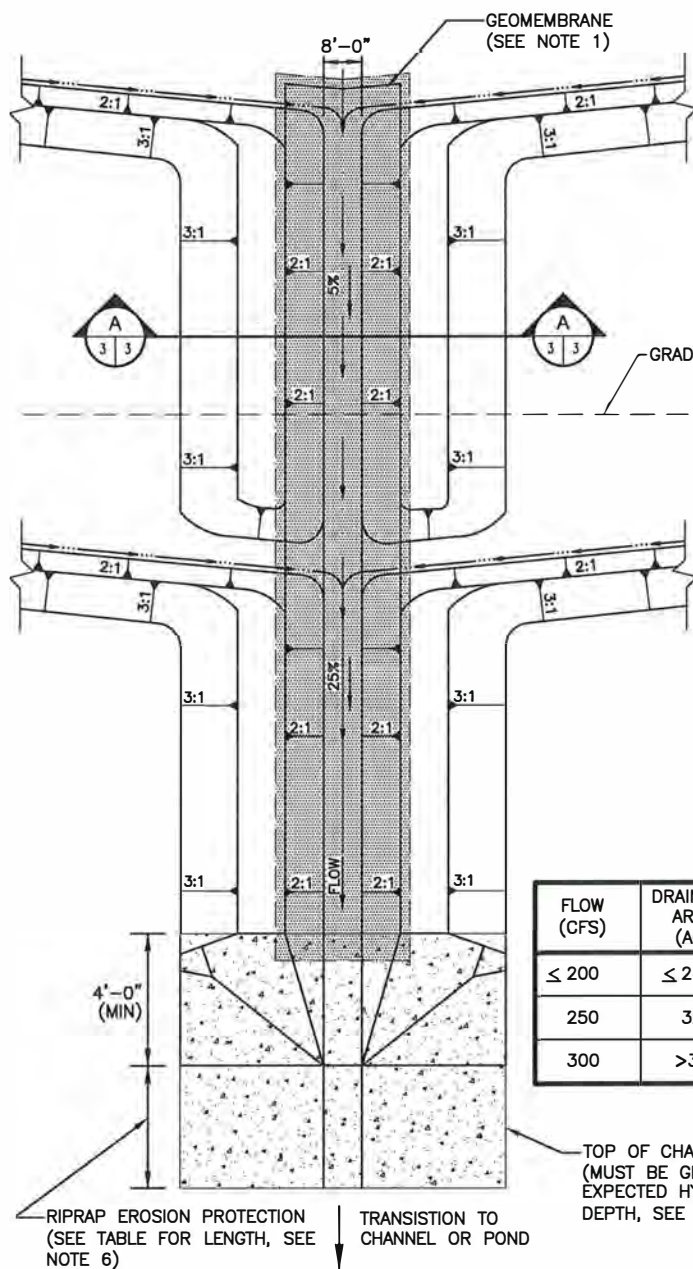

FLOW (CFS)	DRAINAGE AREA (AC)	HYDRAULIC JUMP DEPTH (FT)	RIPRAP LENGTH (FT)
≤ 200	≤ 24	10	10
250	32	16	16
300	>35	25	25


TEMPORARY OPEN CHANNEL LETDOWN

0 20 40  
SCALE IN FEET

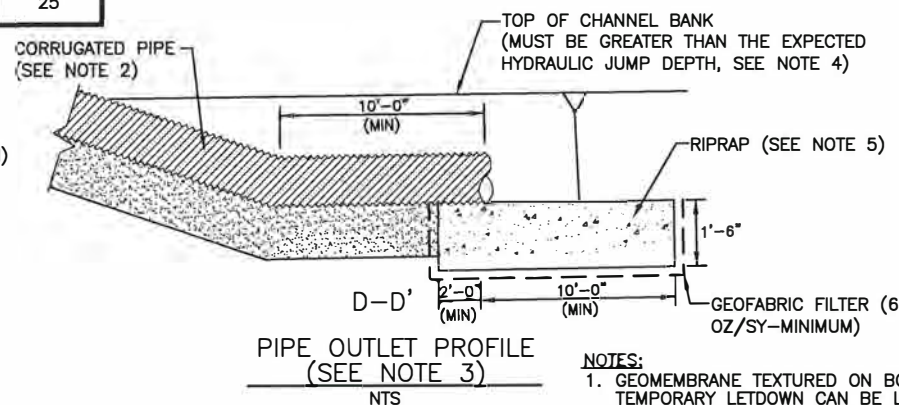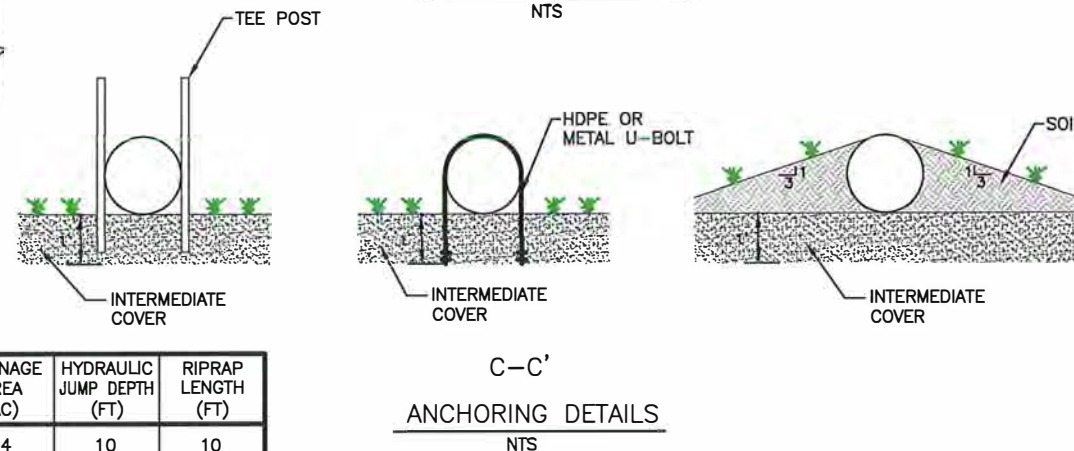
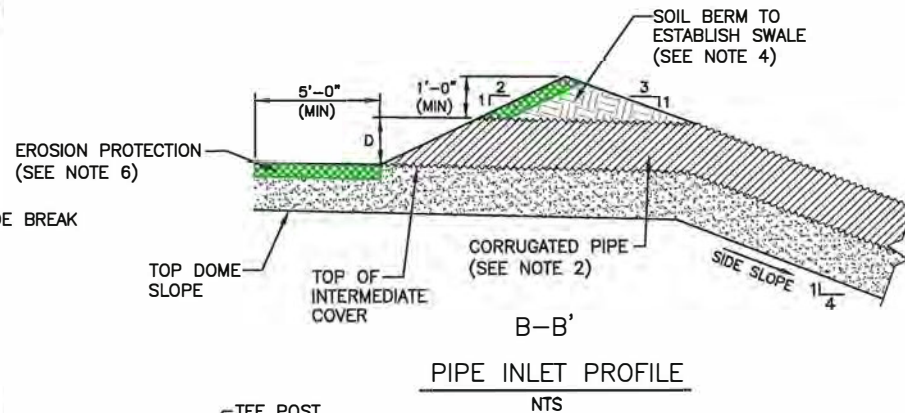


PIPE LETDOWN DESIGN SUMMARY* (USE OF PIPE LETDOWN IS LIMITED TO 1-INLET)		
DRAINAGE AREA (ACRE)	DESIGN FLOW RATE (CFS)	REQUIRED PIPE DIAMETER (FT)
2.0	16.0	2
2.7	21.0	3

\* SEE NOTE 4

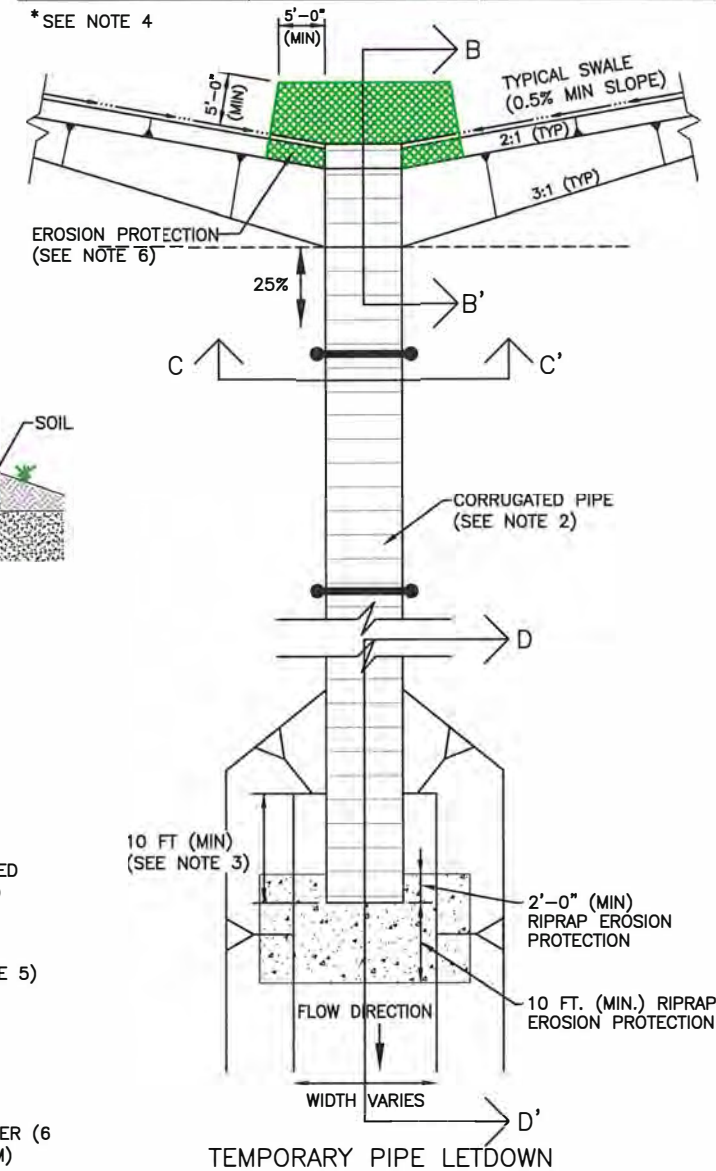

- NOTES:
1. GEOMEMBRANE TEXTURED ON BOTH SIDES WILL BE USED FOR GEOMEMBRANE LETDOWN LINING. AS AN ALTERNATIVE, TEMPORARY LETDOWN CAN BE LINED WITH GABIONS, GROUTED CONCRETE RIPRAP, TURF REINFORCEMENT MAT, OR ROCK RIPRAP.
  2. PIPE DRAINAGE LETDOWN WILL BE ANCHORED BY USING SOIL BERM AT THE INLET LOCATED WITHIN THE SWALE. ADDITIONAL ANCHORING ON THE SIDE SLOPE MAY BE PROVIDED USING SOIL, HDPE, METAL U-BOLTS, T-POSTS OR EQUIVALENT MATERIALS.
  3. PIPE WILL BE EXTENDED INTO THE CHANNEL TO MINIMIZE EROSION.
  4. PIPE LETDOWNS WILL BE LIMITED TO 1 INLET PER LETDOWN. SOIL BERMS AROUND THE PIPE INLET WILL BE EXTENDED A MINIMUM 1-FOOT ABOVE THE LETDOWN PIPE INLET. REFER TO PAGE 6A-G-2-9 FOR HYDRAULIC ANALYSIS.
  5. RIPRAP APRON DESIGN IS PROVIDED ON PAGES 6A-G-2-19 AND 20. D<sub>50</sub> FOR RIPRAP IS 5-INCHES MINIMUM.
  6. RIPRAP, GROUTED RIPRAP, GABIONS, GEOMEMBRANE, EXISTING VEGETATION, OR TURF REINFORCEMENT MAY BE USED FOR INLET EROSION PROTECTION.
  7. REFER TO PAGE 6A-G-2-5A FOR EROSION PROTECTION DESIGN. IF LETDOWN DISCHARGES TO A POND, 10 FEET OF RIPRAP WILL BE SUFFICIENT.

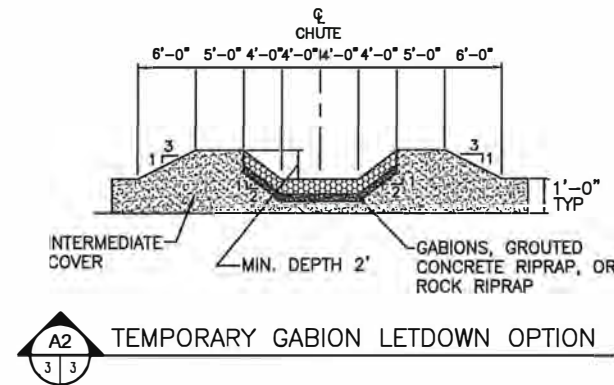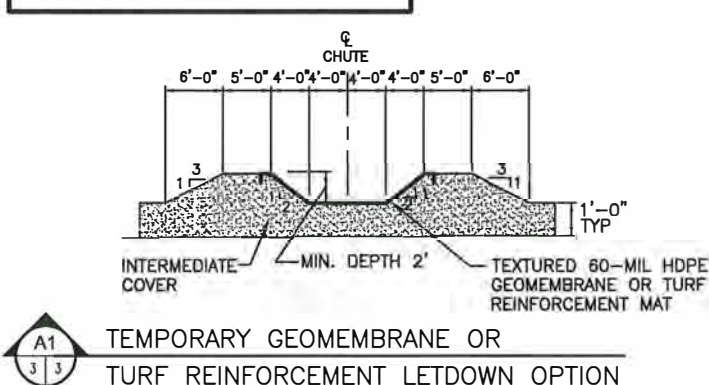

- ☐ DRAFT  
☒ FOR PERMITTING PURPOSES ONLY  
☐ ISSUED FOR CONSTRUCTION

DATE: 05/2010  
FILE: 0120-439-11  
CAD: FIG 3-LETDOWN DESIGN.OWG

DRAWN BY: SRF  
DESIGN BY: BJL  
REVIEWED BY: JPY

Weaver Consultants Group  
T&E REGISTRATION NO. F-3727

PREPARED FOR McCARTY ROAD LANDFILL TX, LP		
REVISIONS		
NO.	DATE	DESCRIPTION
1	01/2010	1ST TCEQ COMMENT RESPONSE
2	05/2010	PERMIT MODIFICATION
3	12/2024	PERMIT MODIFICATION

EROSION CONTROL PLAN  
LETDOWN DESIGN SUMMARY




McCARTY ROAD LANDFILL  
HARRIS COUNTY, TEXAS

WWW.WCGRP.COM

FIGURE 3



O:\0120\439\FLIP MOD 2024\ECF\CLEAN\FIG 4-SED CAPTURE DET POND DESIGN.dwg, vguzman, 1:2

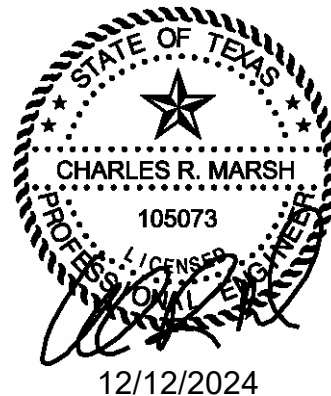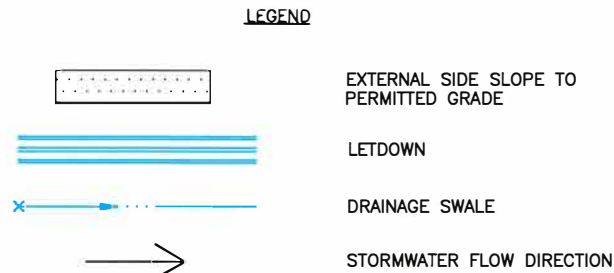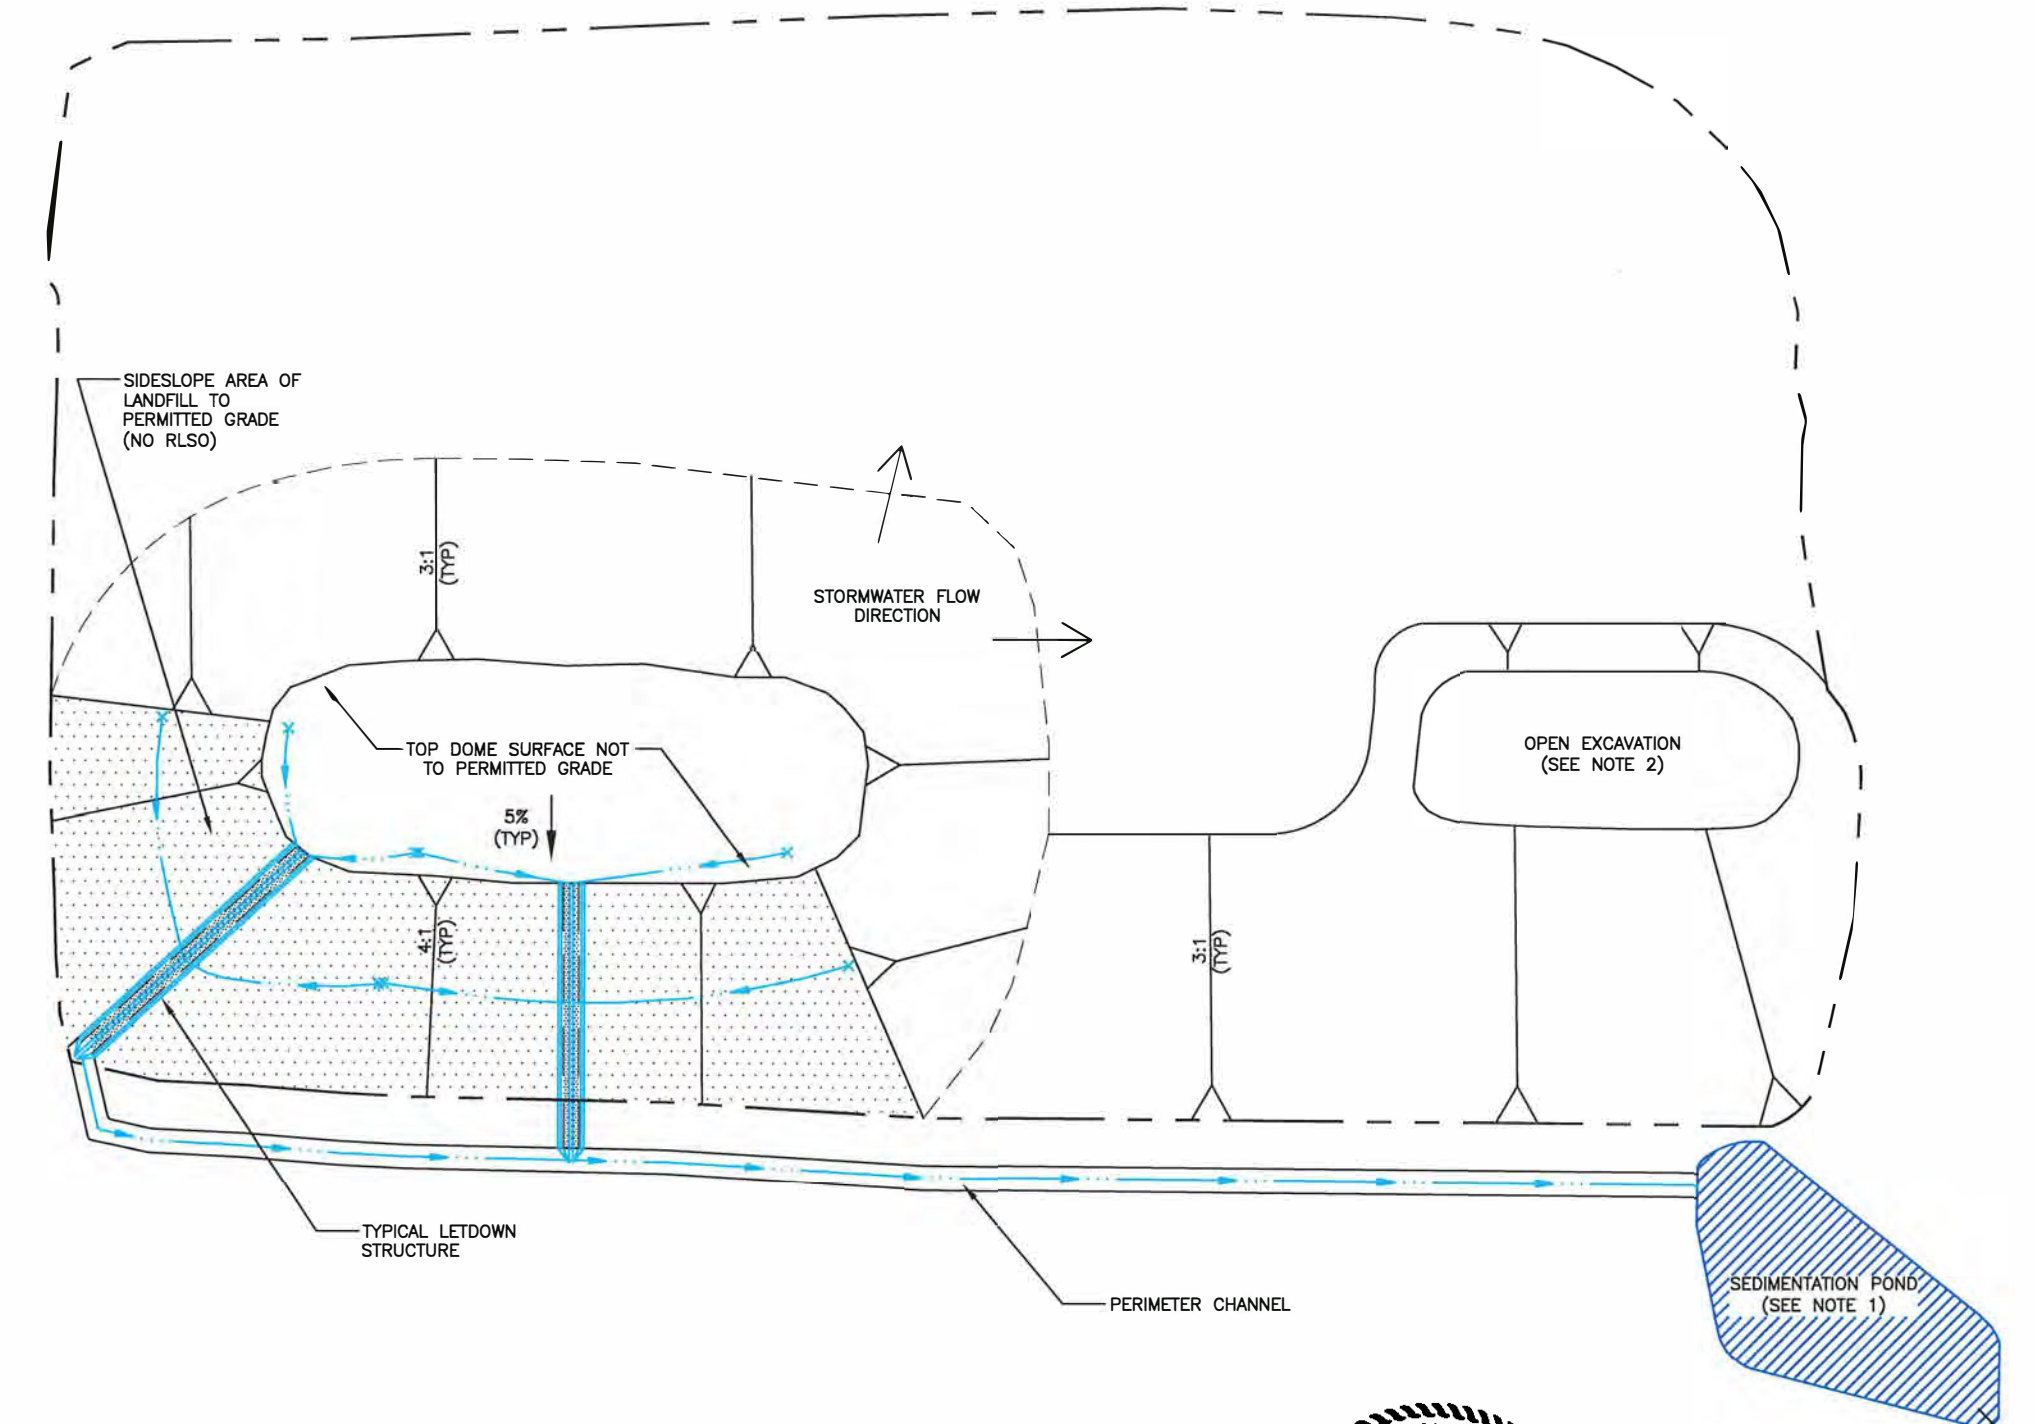

### EXAMPLE CALCULATION

REQUIRED POND SIZE = EXTERNAL EMBANKMENT AREA X POND AREA REQUIRED/  
(ACRES) UNIT DRAINAGE AREA FACTOR

EXTERNAL EMBANKMENT AREA DRAINING TO POND = 50 ACRES

ADDITIONAL UPLAND AREA DRAINING TO POND = 0 ACRES (SEE NOTE 1)

REQUIRED SEDIMENT REMOVAL FROM = 80 TONS/ACRE/YEAR TO 50 TONS/ACRE/YEAR  
EXTERNAL SIDE SLOPE AREA

POND AREA REQUIRED/UNIT DRAINAGE AREA FACTOR = 0.105  
(FROM TABLE BELOW)

REQUIRED POND SIZE = 50 ACRES X 0.105 = 5.25 ACRES

SIZE OF POND REQUIRED <sup>1</sup>		
REQUIRED SEDIMENT REMOVAL (TONS/ACRE/YEAR)	POND AREA REQUIRED/UNIT DRAINAGE AREA FACTOR	EFFICIENCY OF POND (DYNAMIC AND QUIESCENT)
60 TO 50	0.040	18.0%
70 TO 50	0.070	29.3%
80 TO 50	0.105	37.3%
90 TO 50	0.125	43.8%
100 TO 50	0.140	51.9%
200 TO 50	0.375	75.3%

<sup>1</sup> REFER TO APPENDIX 6A-G-3 FOR MORE INFORMATION. THE POND DESIGN AND DEMONSTRATION ARE PROVIDED TO ENSURE THAT SEDIMENT DISCHARGE FROM THE SITE WILL BE PREVENTED DURING INITIAL ESTABLISHMENT OF VEGETATION OVER THE SIDESLOPES AND TOP DOME SURFACES.

### NOTES:

- EXAMPLE POND CONFIGURATION IS SHOWN. THE POND WILL BE LOCATED WITHIN THE PERMIT BOUNDARY. A DEMONSTRATION WILL BE INCLUDED IN THE SITE OPERATING RECORD TO SHOW THAT THE POND HAS THE CAPABILITY TO CAPTURE SEDIMENT SUCH THAT DISCHARGE IS LESS THAN OR EQUAL TO 50 TONS/ACRE/YEAR FROM THE EXTERNAL SIDE SLOPE AND TOP DOME AREA. THE DEMONSTRATION WILL ACCOUNT FOR THE ADDITIONAL SEDIMENT CREATED BY THE UPLAND AREA THAT FLOWS TO THE POND. FOR DEMONSTRATION PURPOSES, THE POND DEPTH WILL BE AN AVERAGE OF 4 FEET. OVERALL SEDIMENT DISCHARGE FROM THE SITE MUST COMPLY WITH THE CURRENT TPDES PERMIT FOR THE SITE.
- EXCAVATED FUTURE CELL AREAS OR SOIL BORROW AREAS CAN ALSO BE USED AS SEDIMENTATION PONDS. IF THESE AREAS ARE USED FOR PONDS, A DEMONSTRATION NOTING THAT THE EXCAVATED FUTURE CELL AREA OR SOIL BORROW AREA HAS MORE CAPACITY THAN THE VOLUME PRODUCED BY THE 25-YEAR, 24-HOUR STORM WILL BE DOCUMENTED AND MAINTAINED IN THE SITE OPERATING RECORD.
- AS STATED IN SECTION 2.2, A STATEMENT WILL BE ADDED TO THE SITE OPERATING RECORD EACH TIME A SEDIMENTATION POND IS INSTALLED TO NOTE HOW THE TEMPORARY SEDIMENTATION POND AND THE POND OUTLET WERE CONSTRUCTED CONSISTENT WITH THE REQUIREMENTS OF THE SITE DEVELOPMENT PLAN.

<input type="checkbox"/> DRAFT <input checked="" type="checkbox"/> FOR PERMITTING PURPOSES ONLY <input type="checkbox"/> ISSUED FOR CONSTRUCTION	PREPARED FOR <b>McCARTY ROAD LANDFILL TX, LP</b>	<b>EROSION CONTROL PLAN SEDIMENT CONTROL POND PLAN</b>		
DATE: 05/2010 FILE: 0120-439-11 CAD: FIG 4-RETENTION POND PLAN.DWG	DRAWN BY: SRF DESIGN BY: B.J.L. REVIEWED BY: JPY	REVISIONS		
<b>Weaver Consultants Group</b> TBPE REGISTRATION NO. F-3727		NO.	DATE	DESCRIPTION
		1	01/2010	1ST TCEQ COMMENT RESPONSE
		2	05/2010	PERMIT MODIFICATION
		3	12/2024	PERMIT MODIFICATION
		WWW.WCGRP.COM		FIGURE 4

**McCARTY ROAD LANDFILL  
CITY OF HOUSTON, HARRIS COUNTY, TEXAS  
TCEQ PERMIT NO. MSW-261B**

**PART III – SITE DEVELOPMENT PLAN  
ATTACHMENT 7  
LANDFILL COMPLETION PLAN**

Prepared for

McCarty Road Landfill TX, LP


Approved Site Development Plan  
August 2008

Revised October 2008

Revised December 2010

Revised January 2012

Revised December 2024

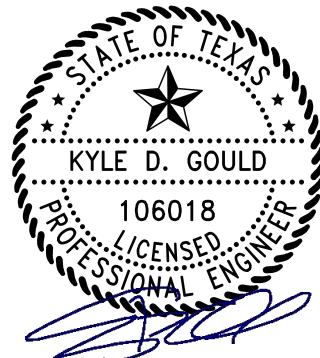


12/12/2024

Prepared by


**Weaver Consultants Group, LLC**  
TBPE Registration No. F-3727  
6420 Southwest Boulevard, Suite 206  
Fort Worth, Texas 76109  
817-735-9770

WCG Project No. 0120-439-11-259



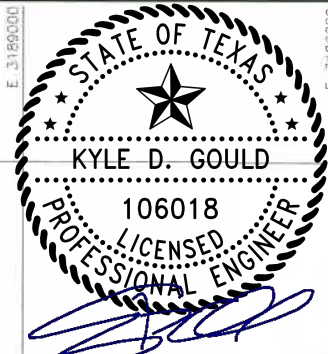

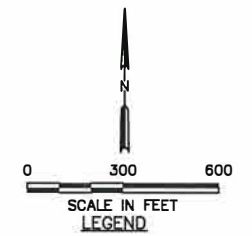


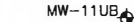
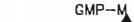










12/12/2024

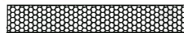


POND LABELS	
NP	NORTH POND
NWP	NORTHWEST POND
NEP	NORTHEAST POND
EP	EAST POND
SEP	SOUTHEAST POND
SWP	SOUTHWEST POND
SP-1	SOUTH POND 1
SP-2	SOUTH POND 2

- |   |  |
|---|--|
|  | PERMIT BOUNDARY                            |
|  | LIMITS OF WASTE                            |
|  | DEED RESTRICTION BOUNDARY (SEE NOTE 10)    |
|  | FINAL CONTOURS                             |
|  | STATE PLANE COORDINATE SYSTEM              |
|  | GEODETIC COORDINATE SYSTEM                 |
|  | EXISTING CONTOUR                           |
|  | GROUNDWATER MONITORING WELL                |
|  | LANDFILL GAS MONITORING PROBE              |
|  | EASEMENT BOUNDARY                          |
|  | 100-YR FLOODPLAIN (REFER TO ATTACHMENT 6C) |
|  | GABIONS                                    |
|  | PROPOSED DRAINAGE SWALE                    |
|  | PROPOSED DRAINAGE LETDOWN                  |
|  | CONSTRUCTED FINAL COVER                    |

NOTES:

1. TOPOGRAPHIC MAPPING PREPARED BY FIRMATEK FROM AERIAL PHOTOGRAPHY FLOWN 11-17-2023. THE GRID SYSTEM IS TIED TO THE TEXAS STATE PLANE COORDINATE SYSTEM SOUTH CENTRAL ZONE NAD 1927.
2. PERMIT BOUNDARY AND EASEMENTS WERE REPRODUCED FROM COSTELLO, INC. STANDARD LAND SURVEY DRAWING, DATED MARCH 2004.
3. REFER TO ATTACHMENT 7B FOR POST DEVELOPMENT DRAINAGE INFORMATION.
4. FINAL COVER DETAILS ARE PROVIDED IN ATTACHMENT 6D-FINAL COVER DETAILS.
5. MAXIMUM FINAL COVER ELEVATION: 314.5 FT-MSL  
MAXIMUM WASTE ELEVATION: 313.5 FT-MSL.
6. REFER TO ATTACHMENT 2 FOR TYPICAL CROSS SECTION INFORMATION.
7. DRAINAGE DESIGN INFORMATION INCLUDED IN ATTACHMENT 6A.
8. THE TOP DECK WILL BE MARKED AND LIGHTED. CONSISTENT WITH FAA REQUIREMENTS. REFER TO PARTS I/II, APPENDIX I/IIA FOR MORE INFORMATION.
9. REFER TO ATTACHMENT 14 FOR DETAILS OF THE LANDFILL GAS MANAGEMENT PLAN.
10. REFER TO ATTACHMENT 6, APPENDIX 6A-F FOR DEED RESTRICTION INFORMATION.

<input type="checkbox"/> DRAFT <input checked="" type="checkbox"/> FOR PERMITTING PURPOSES ONLY <input type="checkbox"/> ISSUED FOR CONSTRUCTION		PREPARED FOR <b>McCARTY ROAD LANDFILL TX, LP</b>		
DATE: 03/2004 FILE: 0120-439-11 CAD: 5.04-PRO-DR.DWG		DRAWN BY: JGW DESIGN BY: SAN/ALD REVIEWED BY: JPY		
 <b>Weaver Consultants Group</b> TBPE REGISTRATION NO. F-3727		REVISIONS		
		NO.	DATE	DESCRIPTION
		1	09/2008	UPDATED GROUNDWATER OBSERVATION WELL AND LANDFILL GAS MONITORING PROBES
		2	12/2010	PERMIT MODIFICATION
		3	01/2012	PERMIT MODIFICATION
		4	12/2024	PERMIT MODIFICATION

MAJOR PERMIT AMENDMENT  
LANDFILL COMPLETION PLAN

McCARTY ROAD LANDFILL  
HARRIS COUNTY, TEXAS

WWW.WCGRP.COM

ATTACHMENT 7A



**McCARTY ROAD LANDFILL  
CITY OF HOUSTON, HARRIS COUNTY, TEXAS  
TCEQ PERMIT NO. MSW-261B**

**PART III – SITE DEVELOPMENT PLAN  
ATTACHMENT 12  
FINAL CLOSURE PLAN**

Prepared for

McCarty Road Landfill TX, LP

Approved Site Development Plan  
August 2008


Revised October 2009

Revised September 2011

Revised February 2013

Revised August 2020

Revised December 2024

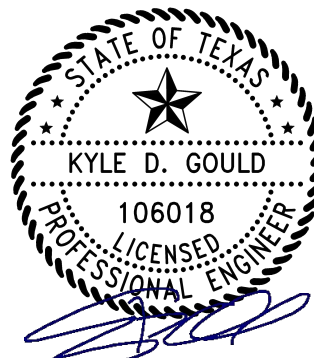

Prepared by

**Weaver Consultants Group, LLC**  
TBPE Registration No. F-3727  
6420 Southwest Boulevard, Suite 206  
Fort Worth, Texas 76109  
817-735-9770

12/12/2024

WCG Project No. 0120-439-11-259



**McCARTY ROAD LANDFILL  
CITY OF HOUSTON, HARRIS COUNTY, TEXAS  
TCEQ PERMIT NO. MSW-261B**

**MAJOR PERMIT AMENDMENT APPLICATION**

**PART III – SITE DEVELOPMENT PLAN  
APPENDIX 12A  
FINAL COVER SYSTEM QUALITY CONTROL PLAN**

Prepared for

McCarty Road Landfill TX, LP


Approved Site Development Plan August 2008

Revised March 2011

Revised December 2024

Prepared by

**Weaver Consultants Group, LLC**  
TBPE Registration No. F-3727  
6420 Southwest Boulevard, Suite 206  
Fort Worth, Texas 76109  
817-735-9770

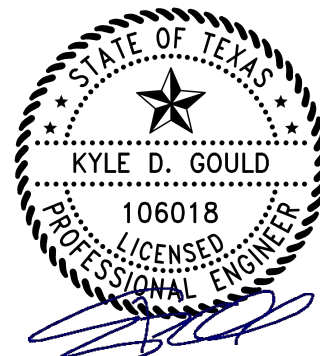


12/12/2024

WCG Project No. 0120-439-11-259

**APPENDIX 12A-A**  
**FINAL COVER DRAINAGE LAYER DESIGN**

Includes pages 12A-A.1 through 12A-A.7

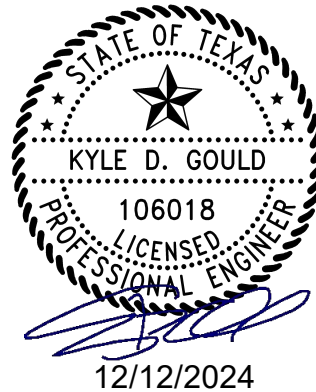



**ATTACHMENT 3**  
**TCEQ-20650 FORM**



**Texas Commission on Environmental Quality**  
**Application Form for Municipal Solid Waste**  
**Permit or Registration Modification**  
**or Temporary Authorization**

**Application Tracking Information**

Facility Name: McCarty Road Landfill  
Permittee or Registrant Name: McCarty Road Landfill TX, LP  
MSW Authorization Number: 261B  
Initial Submission Date: 09/2024  
Revision Date: 12/2024

Instructions for completing this form are provided in [form TCEQ-20650-instr<sup>1</sup>](#). If you have questions, contact the Municipal Solid Waste Permits Section by email to [REDACTED] or by phone at 512-239-2335.

**Application Data**

**1. Submission Type**

☐ Initial Submission ☒ Notice of Deficiency (NOD) Response

**2. Authorization Type**

☒ Permit ☐ Registration

**3. Application Type**

☒ Modification with Public Notice ☐ Modification without Public Notice  
☐ Temporary Authorization (TA) ☐ Modification for Name Change or Transfer

**4. Application Fee**

**Amount**

The application fee for a modification or temporary authorization is \$150.

**Payment Method**

☐ Check  
☒ Online through ePay portal [www3.tceq.texas.gov/epay/](http://www3.tceq.texas.gov/epay/)

If paid online, enter ePay Trace Number: [REDACTED]

<sup>1</sup> [www.tceq.texas.gov/downloads/permitting/waste-permits/msw/forms/20650-instr.pdf](http://www.tceq.texas.gov/downloads/permitting/waste-permits/msw/forms/20650-instr.pdf)



## Signature Page

### Site Operator or Authorized Signatory

I certify under penalty of law that this document and all attachments were prepared under my direction or supervision in accordance with a system designed to assure that qualified personnel properly gather and evaluate the information submitted. Based on my inquiry of the person or persons who manage the system, or those persons directly responsible for gathering the information, the information submitted is, to the best of my knowledge and belief, true, accurate, and complete. I am aware there are significant penalties for submitting false information, including the possibility of fine and imprisonment for knowing violations.

Name: Raymond Whitlock Title: Environmental Manager

Email: [REDACTED]

Signature: Raymond P. Whitlock Date: 12/12/2024

### Operator or Principal Executive Officer Designation of Authorized Signatory

*To be completed by the operator if the application is signed by an authorized representative for the operator.*

I hereby designate \_\_\_\_\_ as my representative and hereby authorize said representative to sign any application, submit additional information as may be requested by the Commission; and/or appear for me at any hearing or before the Texas Commission on Environmental Quality in conjunction with this request for a Texas Water Code or Texas Solid Waste Disposal Act permit. I further understand that I am responsible for the contents of this application, for oral statements given by my authorized representative in support of the application, and for compliance with the terms and conditions of any permit which might be issued based upon this application.

Operator or Principal Executive Officer Name: \_\_\_\_\_

Email Address: \_\_\_\_\_

Signature: \_\_\_\_\_ Date: \_\_\_\_\_

### Notary

SUBSCRIBED AND SWORN to before me by the said Raymond Whitlock


On this 12<sup>th</sup> day of December, 2024

My commission expires on the 11<sup>th</sup> day of August, 2026

Stacy M. Wilson

Notary Public in and for

Tarrant County, Texas

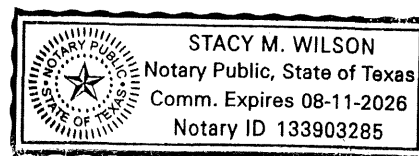

Note: Application Must Bear Signature and Seal of Notary Public

MCCARTY ROAD LANDFILL TX  
PO BOX 29246  
PHOENIX AZ 85038-9246

BFI  
PO BOX 29246  
PHOENIX AZ 85038-9246

JUAN M GONZALEZ &  
PEDRO M GALLON  
11530 SPICEWOOD LN  
HOUSTON TX 77044-2610

BROWNING FERRIS  
PO BOX 29246  
PHOENIX AZ 85038-9246

F L GILL  
PO BOX 1369  
MUSKOGEE OK 74402-1369

DANIEL A QUINTANILLA LEAL  
2430 CROMWELL ST  
HOUSTON TX 77093-2420

SHANTIONE JACKSON  
3414 KNOTTY OAKS TRAIL  
HOUSTON TX 77045

ESTATE OF SAMUEL D KEEPER  
2929 BUFFALO SPEEDWAY  
UNIT 203  
HOUSTON TX 77098-1719

HECTOR ARIAS & NORMA  
MEDINA NAVA  
11538 S SPICEWOOD LN  
HOUSTON TX 77044-2610

CURRENT OWNER  
ADDRESS UNKNOWN  
HOUSTON TX 77001

ALBERT B LUM  
1010 LAMAR ST  
SUITE 350  
HOUSTON TX 77002-6343

FRANCISCO PEREZ  
11542 S SPICEWOOD LN  
HOUSTON TX 77044-2610

MARY ALICE COOPER  
ADDRESS UNKNOWN

HARRIS COUNTY FLOOD CONTROL  
DISTRICT  
9900 NORTHWEST FREEWAY  
HOUSTON TX 77092-8601

RAFAEL HERIBERTO COBOS  
19119 TIMBER WAY DR  
HUMBLE TX 77346-5053

REUBEN J FINE  
2236 BARTLETT ST  
HOUSTON TX 77098-5202

YAHIA ZARIR  
1805 GRAND VISTA HILL LN  
RICHMOND TX 77407-1056

HERRERA GUILLERMO  
7815 JOHN RALSTON RD  
HOUSTON TX 77044-2635

MARY HERNANDEZ  
5504 HILLMAN ST  
HOUSTON TX 77023-3807

MARTIN DELGADO HERNANDEZ  
606 E WELLINGTON  
HOUSTON TX 77076-3427

KELLY BOWLING  
2623 HAZELNUT CT  
HEBRON KY 41048-6721

MRS ANNIE F BUCK  
602 E 15TH ST  
HOUSTON TX 77008-4517

ANTONIO VILLEDA  
11514 S SPICEWOOD LN  
HOUSTON TX 77044

MARK E ENTERPRISES  
PO BOX 9945  
HOUSTON TX 77213-0945

EDGAR E MURPHY  
PO BOX 2544  
DALLAS TX 75221

JOSE & LETICIA GAMBOA  
11518 SPICEWOOD LN  
HOUSTON TX 77044-2610

JUAN H & ROSE H JAUREGUI  
8514 KILLENE ST  
HOUSTON TX 77029-1034

E O FONDREN  
PO BOX 935  
MONT BELVIEU TX 77580-0935

MARCOS GARCIA & MATILDE N  
MARTINEZ  
11526 S SPICEWOOD LN  
HOUSTON TX 77044-2610

VERONICA M GARZA  
7526 JOHN RALSTON RD  
HOUSTON TX 77044-2630



ELZA GONZALES  
C/O ESTATE OF RAFAEL GONZALES  
11811 DANVERS DR  
HOUSTON TX 77044-2615

RAUL GARCIA  
7125 JOHN RALSTON RD  
HOUSTON TX 77044-2621

WASTE CORP TEXAS OF LP  
ATTN TAX DEPARTMENT  
100 NEW PARK PL  
SUITE 500  
VAUGHN ON L4K 0H9 CANADA

RAUDEL S SOTO  
7601 JOHN RALSTON RD  
HOUSTON TX 77044-2631

ARTURO & ROSA ALAS  
773 TEAKWOOD LN  
SAN DIMAS CA 91773-3634

ARNOLDO J RODAS  
13126 ROSEMOUNT PARK LN  
HOUSTON TX 77044-6552

JOSE A & NOHEMY A FLORES  
7521 JOHN RALSTON RD  
HOUSTON TX 77044-2629

J&M HOMES4GOOD TRANSITIONAL  
LIVING LLC  
PO BOX 96603  
HOUSTON TX 77213-6603

JOSE I RODRIGUEZ  
2214 FORREST RANCH DR  
HOUSTON TX 77049-3132

JAMES BERNARD MCCULLUM  
7417 JOHN RALSTON RD  
HOUSTON TX 77044-2640

MZM REAL ESTATE LLC  
PO BOX 741903  
HOUSTON TX 77274-1903

DUMITRU HURGOIU  
11831 LYNDA DR  
HOUSTON TX 77038-3431

ROBERT L & PEGGY A STANLEY  
7409 JOHN RALSTON RD  
HOUSTON TX 77044-2641

JEMCO SERVICES INC  
14703 BRINDLE TRAIL  
HOUSTON TX 77044-4306

EQUIPMENT CARE CENTER OF  
HOUSTON LLC  
200 ESSEX AVE E  
AVENEL NJ 07001-2045

RALPH S & DINAH L STANLEY  
7409 JOHN RALSTON RD  
HOUSTON TX 77044-2641

LUIS GUILLEN  
1411 TEALSTONE FALLS CT  
HOUSTON TX 77044-4956

HOUSTON PARKS BOARD LGC INC  
300 N POST OAK LN  
HOUSTON TX 77024-5904

WE MATCH GROUP LLC  
7307 JOHN RALSTON RD  
HOUSTON TX 77044-2625

JOSE EDGAR HERNANDEZ  
20611 APACHE TRL  
CROSBY TX 77523-3463

CONSOLIDATED TRUCK PARKING LLC  
5050 QUORUM DR  
DALLAS TX 75254-7564

VICTORIA N GONZALES  
13810 BRIGHTON PARK DR  
HOUSTON TX 77044-4996

SOUTHERN PACIFIC RAILROAD COMPANY  
UNION PACIFIC RAILROAD COMPANY  
1400 DOUGLAS ST  
STOP 1640  
OMAHA NE 68179-1001

TANIA O & ATENAS GONZALES  
11300 BEAUMONT HWY  
HOUSTON TX 77078-4814

ANAYA HIPPOLITO  
307 BENNINGTON ST  
HOUSTON TX 77022

MELITON A DELEON  
13909 FOREST ACRES DR  
HOUSTON TX 77050-3501

CITY OF HOUSTON  
PO BOX 1562  
HOUSTON TX 77251-1562

ALFREDO C JR & MARCIELA MEDELLIN  
7209 JOHN RALSTON RD  
HOUSTON TX 77044-2623

TEXAS DEPARTMENT OF  
TRANSPORTATION  
PO BOX 1386  
HOUSTON TX 77251-1386

AHP INVESTMENTS LLC  
23171 MILLS RD  
PORTER TX 77365-4289

ISOCHEM LOGISTICS LLC  
11000 BEAUMONT HWY  
HOUSTON TX 77078-4806

EAST HOUSTON INDUSTRIAL  
INVESTORES LLC  
5728 LBJ FREEWAY  
SUITE 225  
DALLAS TX 75240-1200

ST JOHNS SCHOOL  
2401 CLAREMONT LN  
HOUSTON TX 77019-5811

RAP BEAUMONT PROPERTIES LP  
% MATLACK LEASING LLC  
163 HOOTON RD  
MOUNT LAUREL NJ 08054-1353

RANGER H TX LP  
C/O DRA ADVISORS LLC  
220 E 42ND ST 27TH FLOOR  
NEW YORK NY 10017-5819

CAROLYN C TAUB INTERESTS II LLC  
PO BOX 27423  
HOUSTON TX 77227-7423

MUNICIPAL CORRECTIONS FINANCE LP  
ATTN TAX DEPARTMENT  
4955 TECHNOLOGY WAY  
BOCA RATON FL 33431-3367

SAIA MOTOR FREIGHT LINE INC  
11465 JOHNS CREEK PARKWAY  
DULUTH GA 30097-1574

METHODIST HOSPITAL SYSTEMS  
75550 GREENBRIAR ST RB5-124  
HOUSTON TX 77030

WBP LEASING INC  
ATTN TAX DEPARTMENT  
621 NW 53RD ST  
SUITE 700  
BOCA RATON FL 33487-8242

RANGER II RAILWOOD INDUSTRIAL LP  
505 SANSOME ST  
SUITE 1975  
SAN FRANCISCO CA 9411-3140

SALTMINE INVESTMENT PARTNER  
PO BOX 22227  
HOUSTON TX 77227-2227

COUNTY OF HARRIS  
PO BOX 1525  
HOUSTON TX 77251

GSF ENERGY LLC  
FOSTER PLAZA #10 5TH FLOOR  
PITTSBURGH PA 15220-2740

YOLANDA & JESUS JR HERRERA  
7433 DENISON ST  
HOUSTON TX 77020-5509

TERESA GONZALES LUIS ARGUETA  
% TRIPLE 7 PROPERTIES INC  
3622 PARKSHIRE DR  
PEARLAND TX 77584-9451

STAG TX HOLDINGS LP  
ONE FEDERAL ST 23RD FLOOR  
BOSTON MA 02110-2031

HOUSTON ISD  
4400 W 18TH ST  
HOUSTON TX 77092-8501

HOUSTON INDUSTRIAL YARD LLC  
3657 BRIARPARK DR  
SUITE 300  
HOUSTON TX 77042-5266

DILIGENT DEALS LLC  
9430 LEY RD  
HOUSTON TX 77078-4416

EUGENIO & REBECCA PENA  
9410 PALO BLANCO RD  
HOUSTON TX 77078-4426

CCP LTD  
PO BOX 42262  
HOUSTON TX 77242-2262

C519 AT LEY RD LLC  
PO BOX 20197  
ATLANTA GA 30325-0197

MARVIN HUGHES  
9406 PALO BLANCO RD  
HOUSTON TX 77078-4426

RAILSPIKE LLC  
2118 LAMAR ST  
SUITE 105  
HOUSTON TX 77003-3521

TEXAN LAND AND CATTLE II LTD  
PO BOX 130979  
HOUSTON TX 77219-0979

CHARLOTTE R & BENJAMIN JOHNSON  
7901 PALO ALTO ST  
HOUSTON TX 77078-4117

LINEAGE PFS TX HOUSTON RE LLC  
ATTN TAX DEPARTMENT  
46500 HUMBOLDT DR  
NOVI MI 48377-2434

BAYLOR COLLEGE OF MEDICINE  
ONE BAYLOR PLAZA BCM 200  
HOUSTON TX 77030

BIG TEX AIR CONDITIONING LP  
PO BOX 23296  
HOUSTON TX 77228-3296



YOUNG MENS CHRISTIAN ASSOCIATES  
PO BOX 3007  
HOUSTON TX 77253-3007

ST LUKES UNITED METHODIST CHURCH  
PO BOX 22013  
HOUSTON TX 77227-2013

DEBAKEY MEDICAL FOUNDATION  
C/O TRIPLETT & ASSOCIATES  
PO BOX 55444  
HOUSTON TX 77255-5444

EAST HOUSTON BAPTIST  
9425 N GREEN RIVER DR  
HOUSTON TX 77078-4125

NORMA L VALDEZ  
11643 FILAREE TRL  
HOUSTON TX 77044-1759

PIACIDO & ANGELITA GONZALEZ  
4725 CLAY ST  
HOUSTON TX 77023-1213

BLUE BIRD FOUNDATION  
615 W ALABAMA ST  
HOUSTON TX 77006-5003

ESTATE OF DORIS MOONEYHAM  
9401 N GREEN RIVER DR  
HOUSTON TX 77078-4125

SAM HOUSTON AREA COUNCIL  
BOY SCOUTS OF AMERICA  
PO BOX 924528  
HOUSTON TX 77292-4528

JOSE A RODRIGUEZ  
13527 DURBRIDGE TRAIL DR  
HOUSTON TX 77065-5096

ST THOMAS UNIVERSITY  
3812 MONTROSE BLVD  
HOUSTON TX 77006-4626

HOUSTON PARKS BOARD  
300 N POST OAK LN  
HOUSTON TX 77024-5904

HERMENEGILDO & MARIA G LOPEZ  
9234 N GREEN RIVER DR  
HOUSTON TX 77078-4230

SOUTHERN METHODIST UNIVERSITY  
PO BOX 750193  
DALLAS TX 75275-0193

MENIL FOUNDATION  
1519 BRANDARD ST  
HOUSTON TX 77006-4721

FIRST UNITED METHODIST CHURCH  
1320 MAIN ST  
HOUSTON TX 7702-6803